


TYPE "DM2" DROP INLET SECTION
SCALE 3/4"=1'

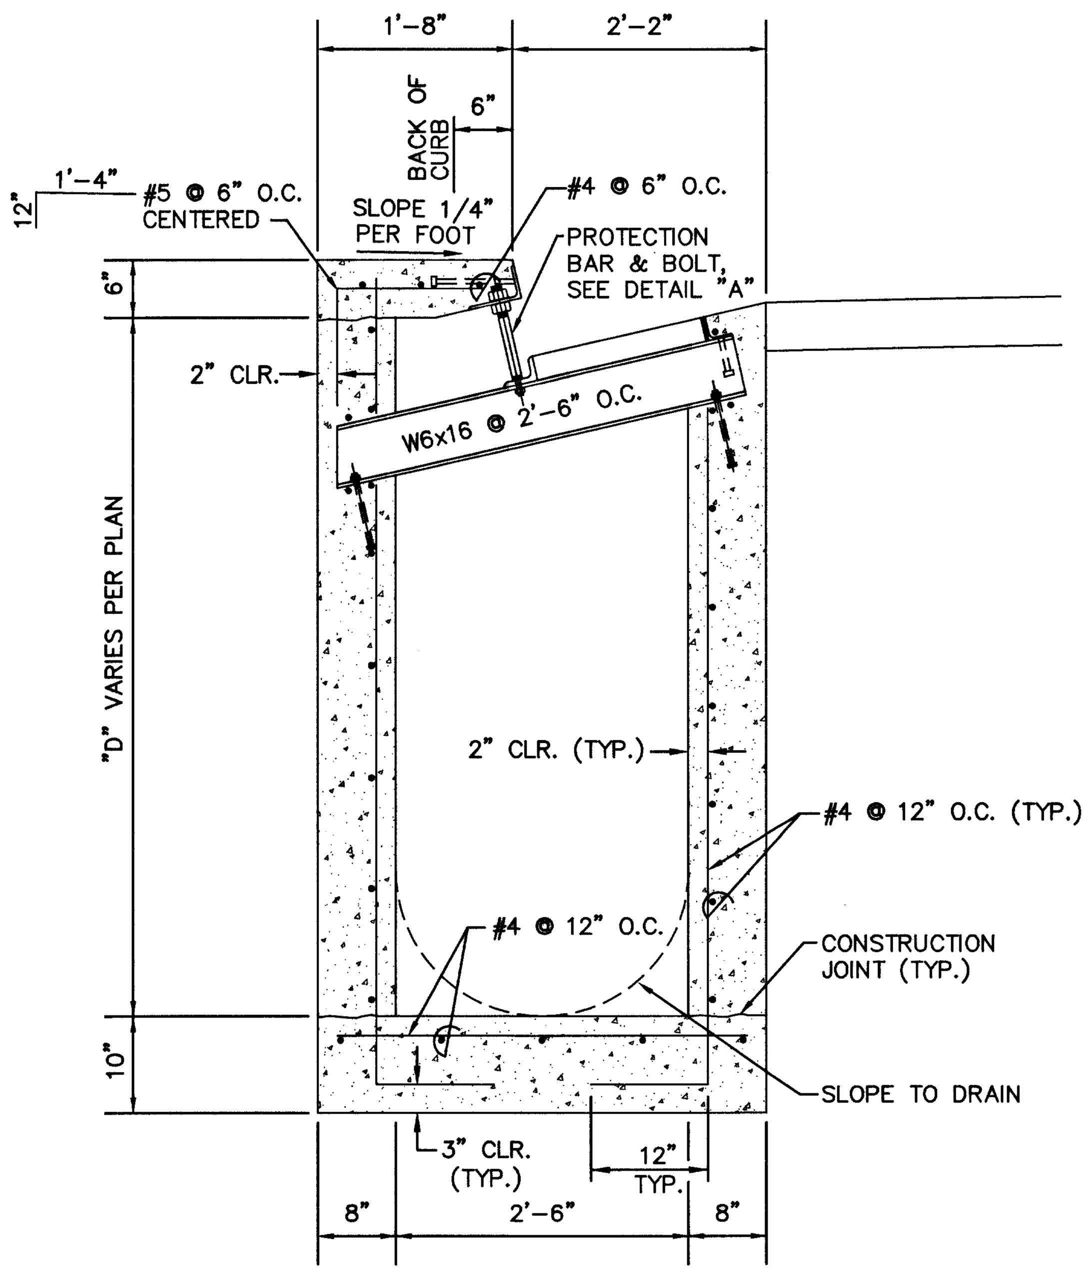


SECTION "A"
SCALE 3/4"=1'




DETAIL "B"
SCALE 3"=1'

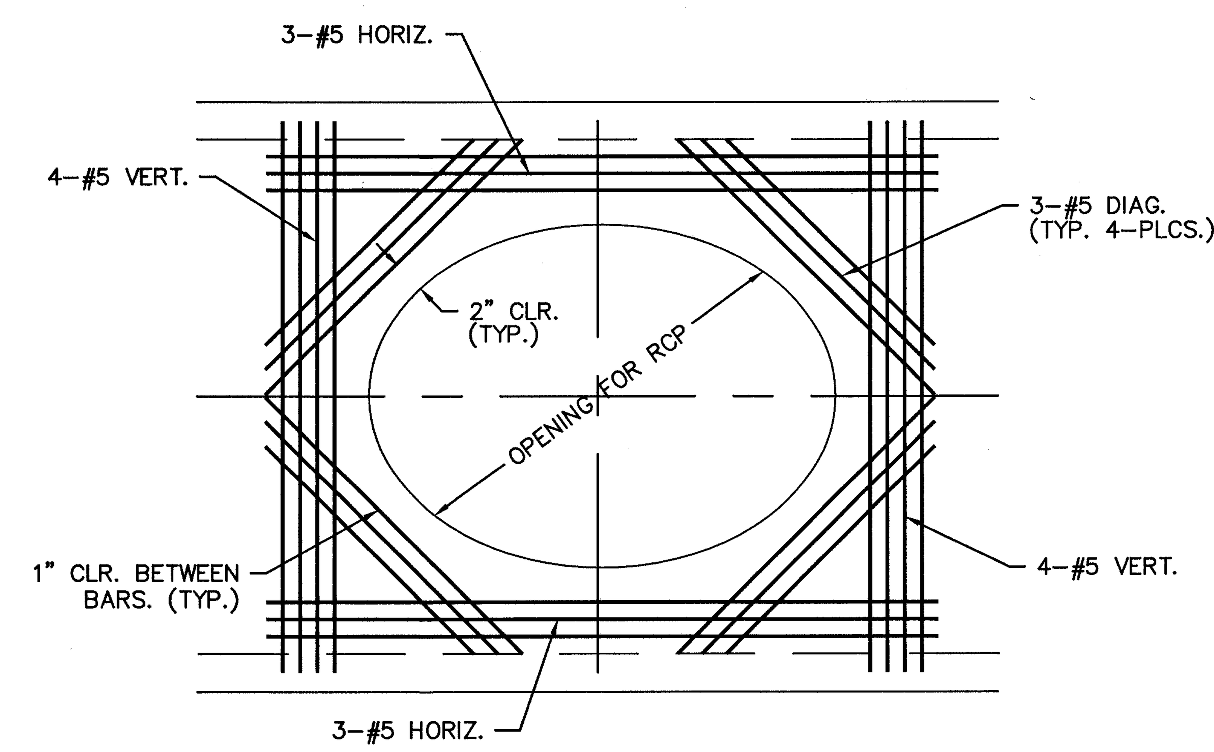


DROP INLET LAYOUT PLAN
SCALE 3/8"=1'

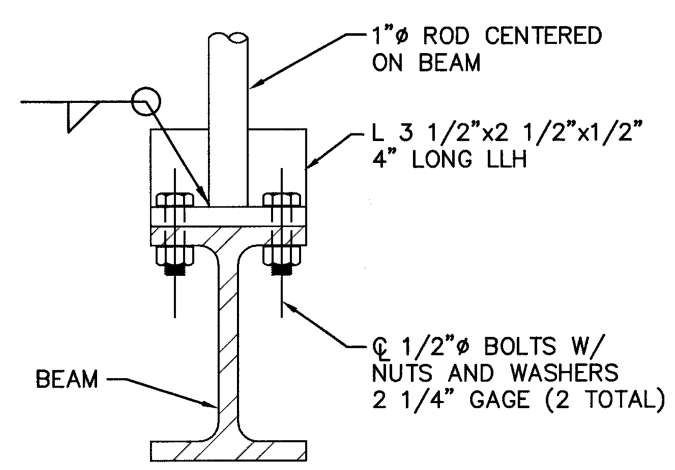


SECTION "B"
SCALE 1-1/2"=1'

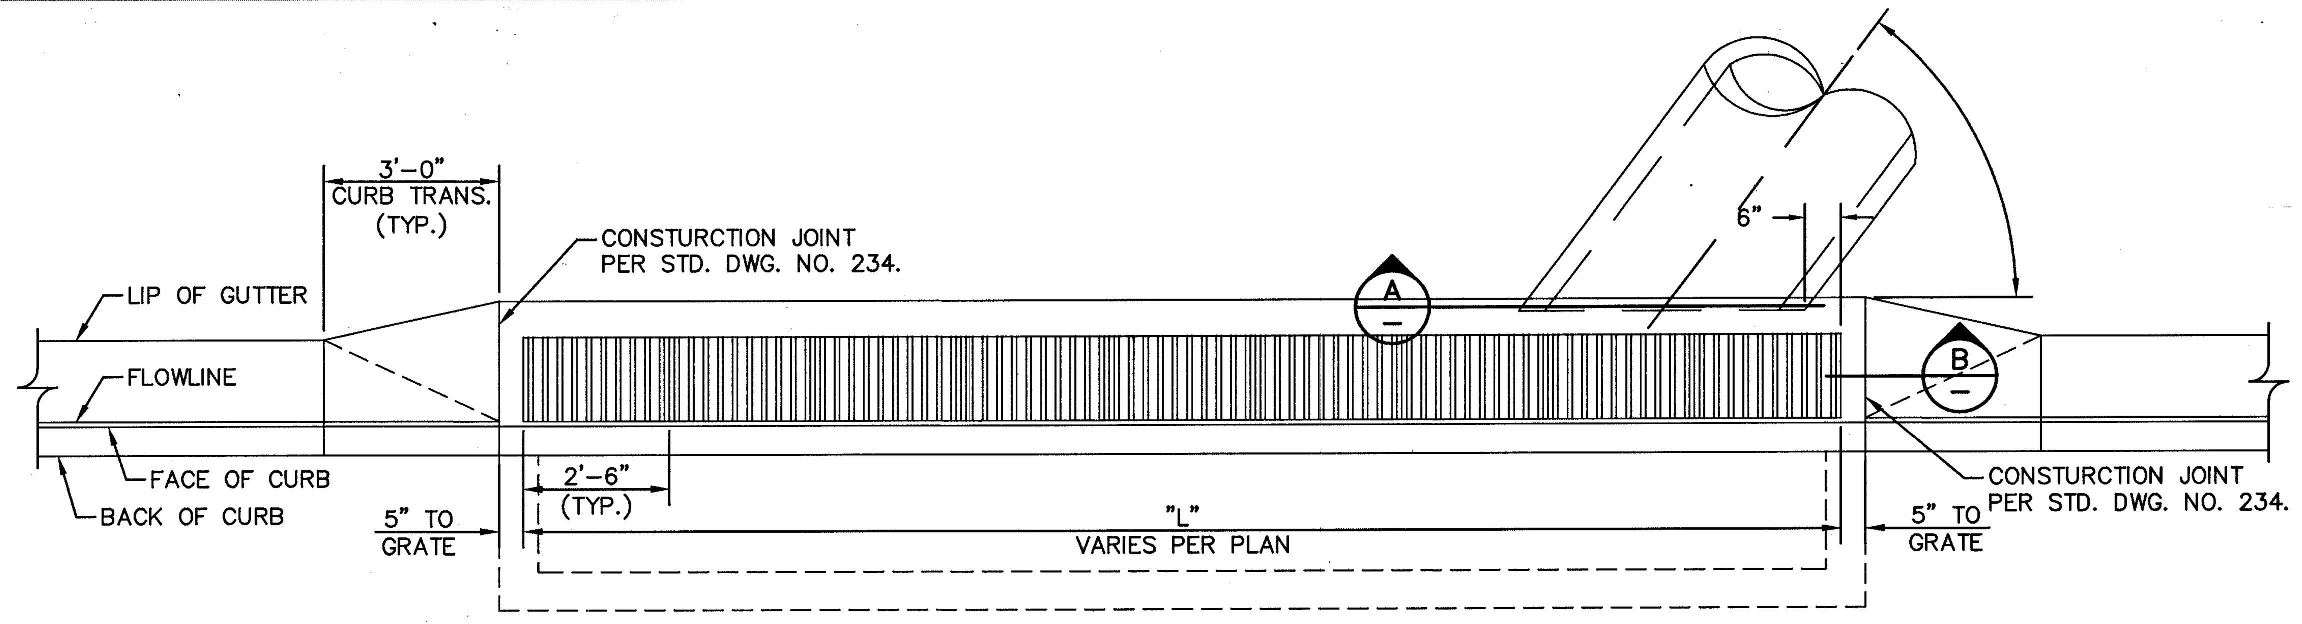


ALTERNATE CONNECTION DETAIL
SCALE 3/8"=1'

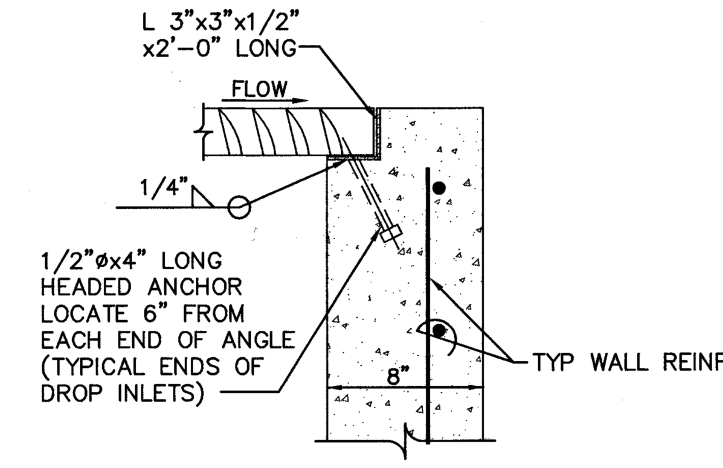


PROTECTIVE FACE & ROD - DETAIL "A"
SCALE 3"=1'

## NOTES:

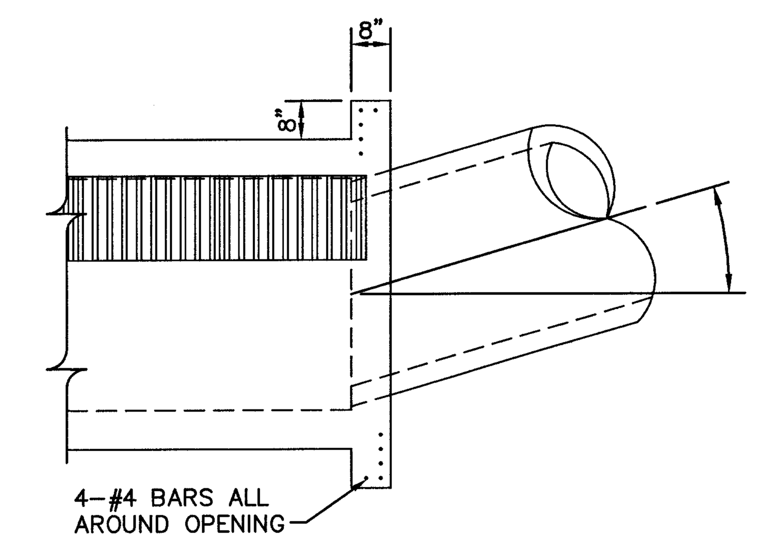1. ALL EXPOSED METALS SHALL BE HOT DIP GALVANIZED AFTER FABRICATION.
2. PROVIDE 1/2" (MIN.) CLEARANCE ALL AROUND THE STEEL BEAM, DRY PACK AFTER INSTALLATION.
3. WHEN REQUIRED BY LENGTH OF OPENING, PLATE ANGLE MAYBE DELIVERED IN SECTIONS AND BUTT WELDED IN PLACE.
4. ALL GALVANIZING DAMAGED BY WELDING SHALL RECEIVE TWO COATS OF GALVALLOY OR EQUAL.
5. CONCRETE SHALL BE MODIFIED CLASS DA, SEE SPECIAL PROVISIONS SECTION 501.
6. SEE GENERAL NOTES FOR STRUCTURES ON DWG D8.
7. ANGLE ANCHORS SHALL BE EMBEDDED MIDPOINT IN EACH ENDWALL AND EVENLY SPACED. (MAXIMUM SPACING OF 2')

AS BUILT

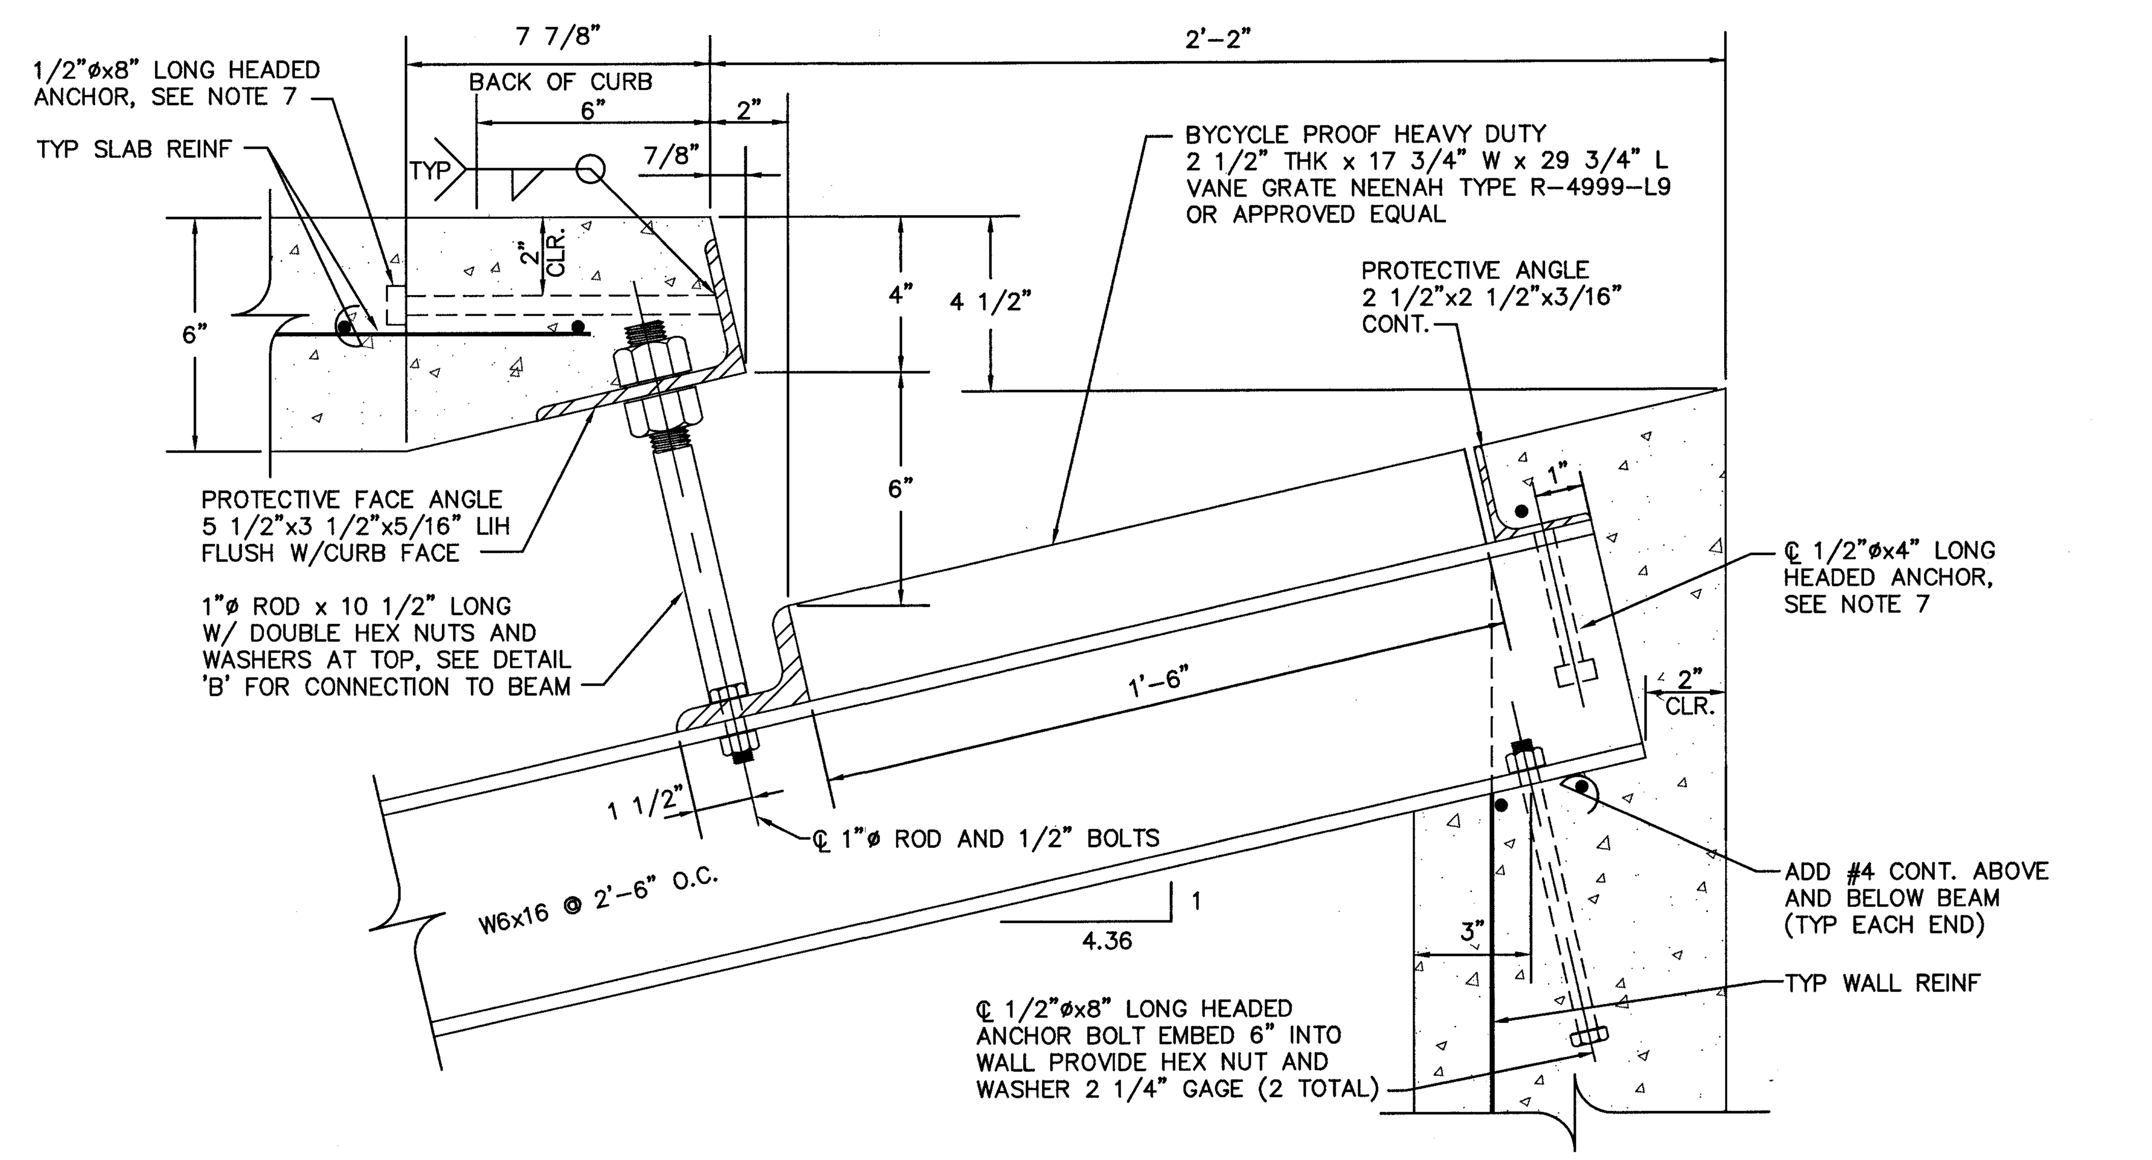52057 73447

REVISIONS

| NO. | DATE: | DESCRIPTION | APP'D |
| --- | --- | --- | --- |

DEPARTMENT OF PUBLIC WORKS
ENGINEERING DESIGN SECTION

CITY ENGINEER: CHARLES KAJKOWSKI JR, P.E.
PROGRAM MANAGER: TOM HAYES, P.E.

DESIGNED BY: MAS
DRAWN BY: MAS
CHECKED BY: ECN

HORIZONTAL SCALE: N/A
VERTICAL SCALE: N/A
DATE: 04-04-03

TITLE: CRYSTAL WATER WAY NOMINAL STORM DRAIN

SHEET: DM2 - DETAILS

REGISTERED PROFESSIONAL ENGINEER CIVIL No. 8078 EXP 12-31-03

Sheet D-1
10 of 10
DRAWING NO. 327-V119