

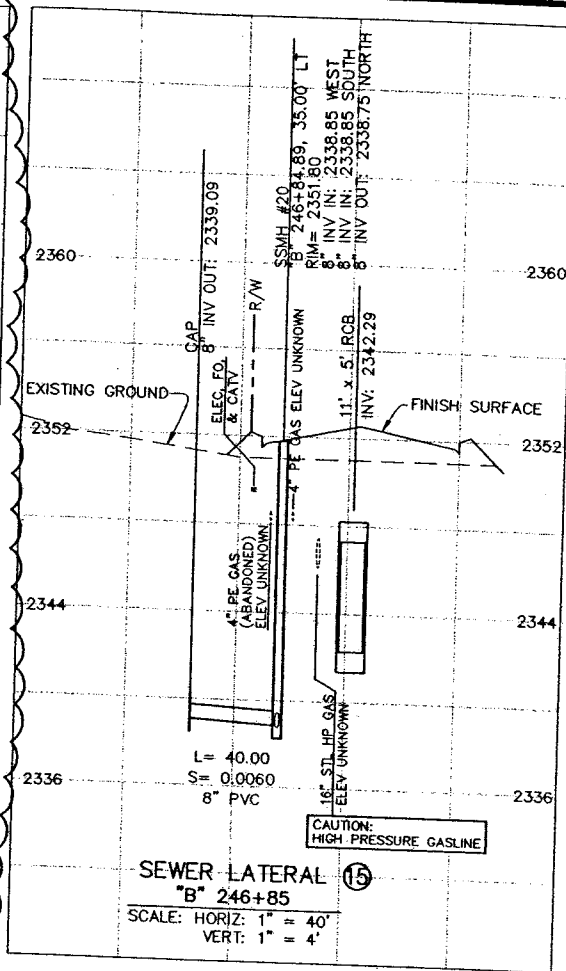
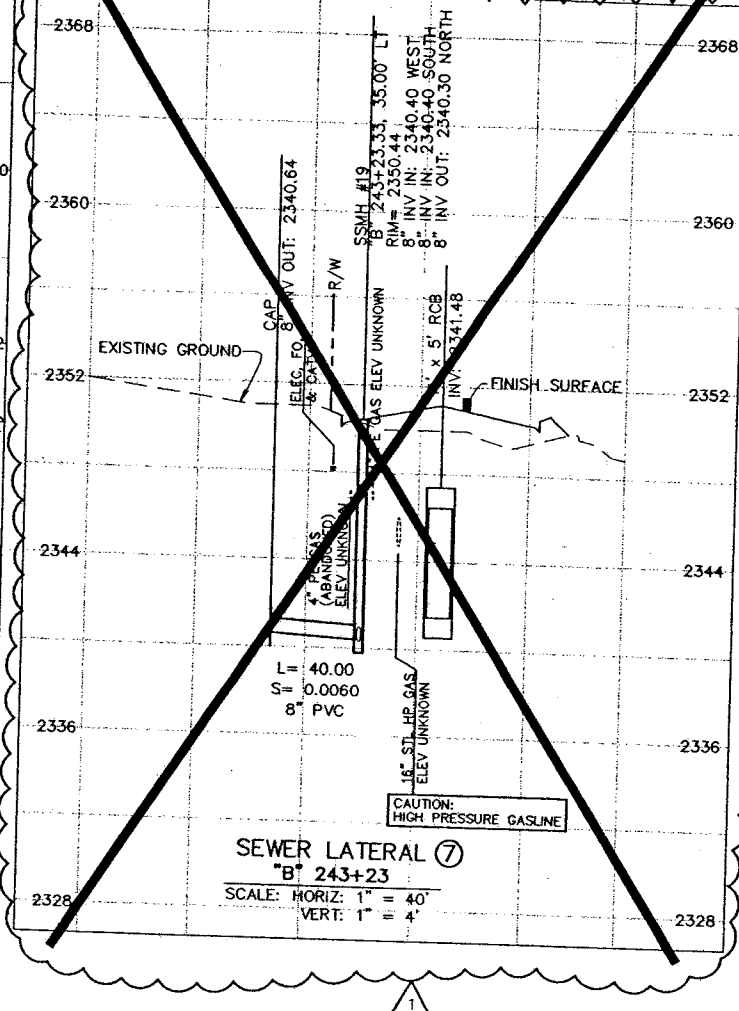
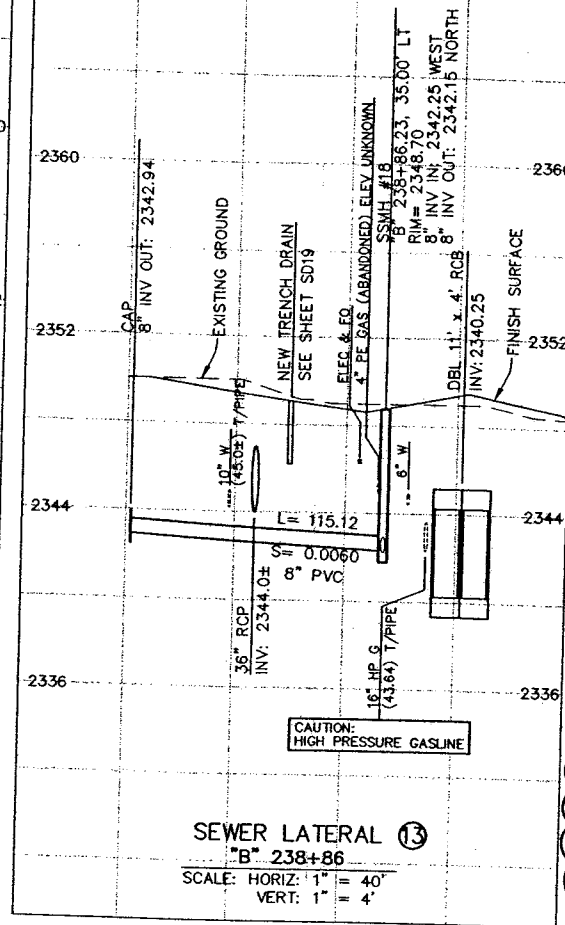


75992

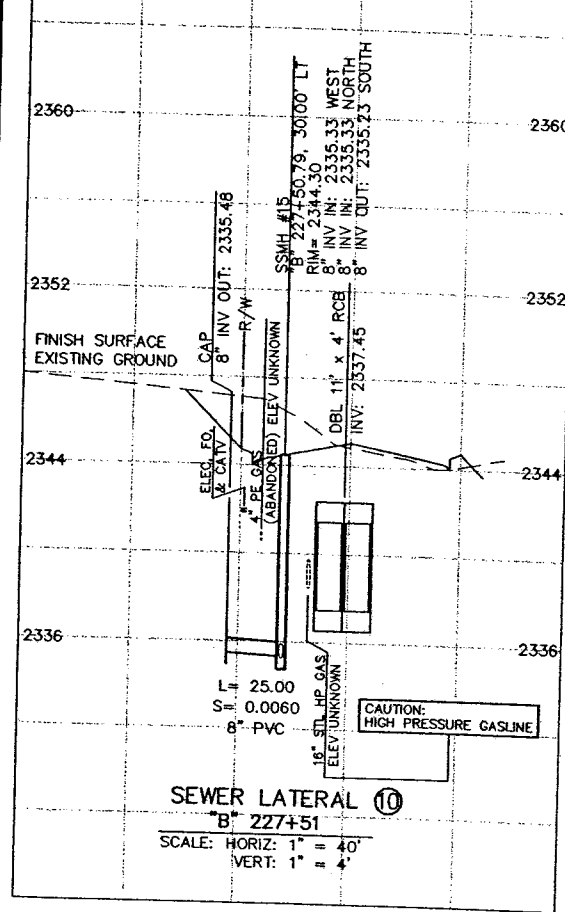

APPROVED FOR CONSTRUCTION

LAS VEGAS VALLEY WATER DISTRICT

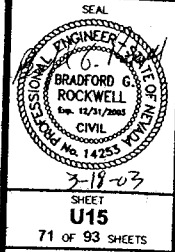

DRAWN BY: 2/10/03
 DESIGNED BY: 2/10/03
 CHECKED BY: 2/10/03
 PROJECT NO: 412.405
 SCALE: 1" = 40' HORIZ
 1" = 4' VERT

**BUFFALO DRIVE
 SANITARY SEWER
 LATERAL PROFILES**

**BUFFALO DRIVE
 CHEYENNE TO LONE MOUNTAIN**

DEPARTMENT OF PUBLIC WORKS
 400 EAST STEWART
 LAS VEGAS, NEVADA, NV 89101
 (702) 229-8276

G.C. WALLACE, INC.
 Engineers/Planners/Surveyors
 1505 S. MOON BLVD., LAS VEGAS, NEVADA 89146
 (702) 254-2000

REV	DATE	BY	DESCRIPTION
1	2/10/03	BR	DELETE SEWER LATERAL

71 OF 93 SHEETS