
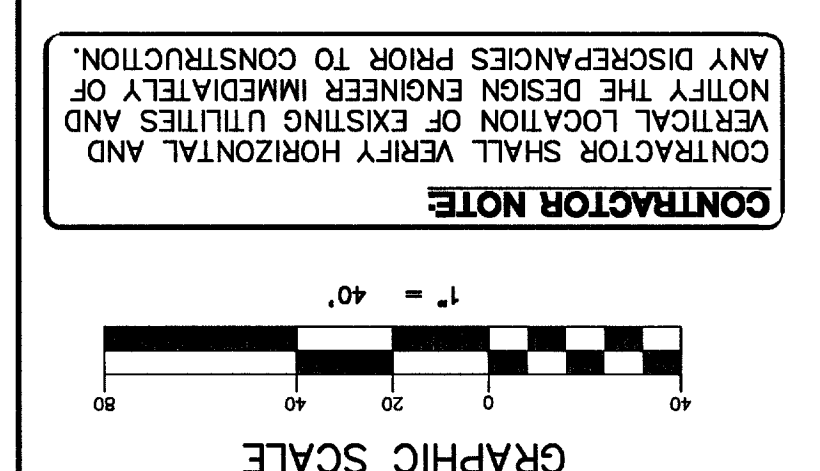
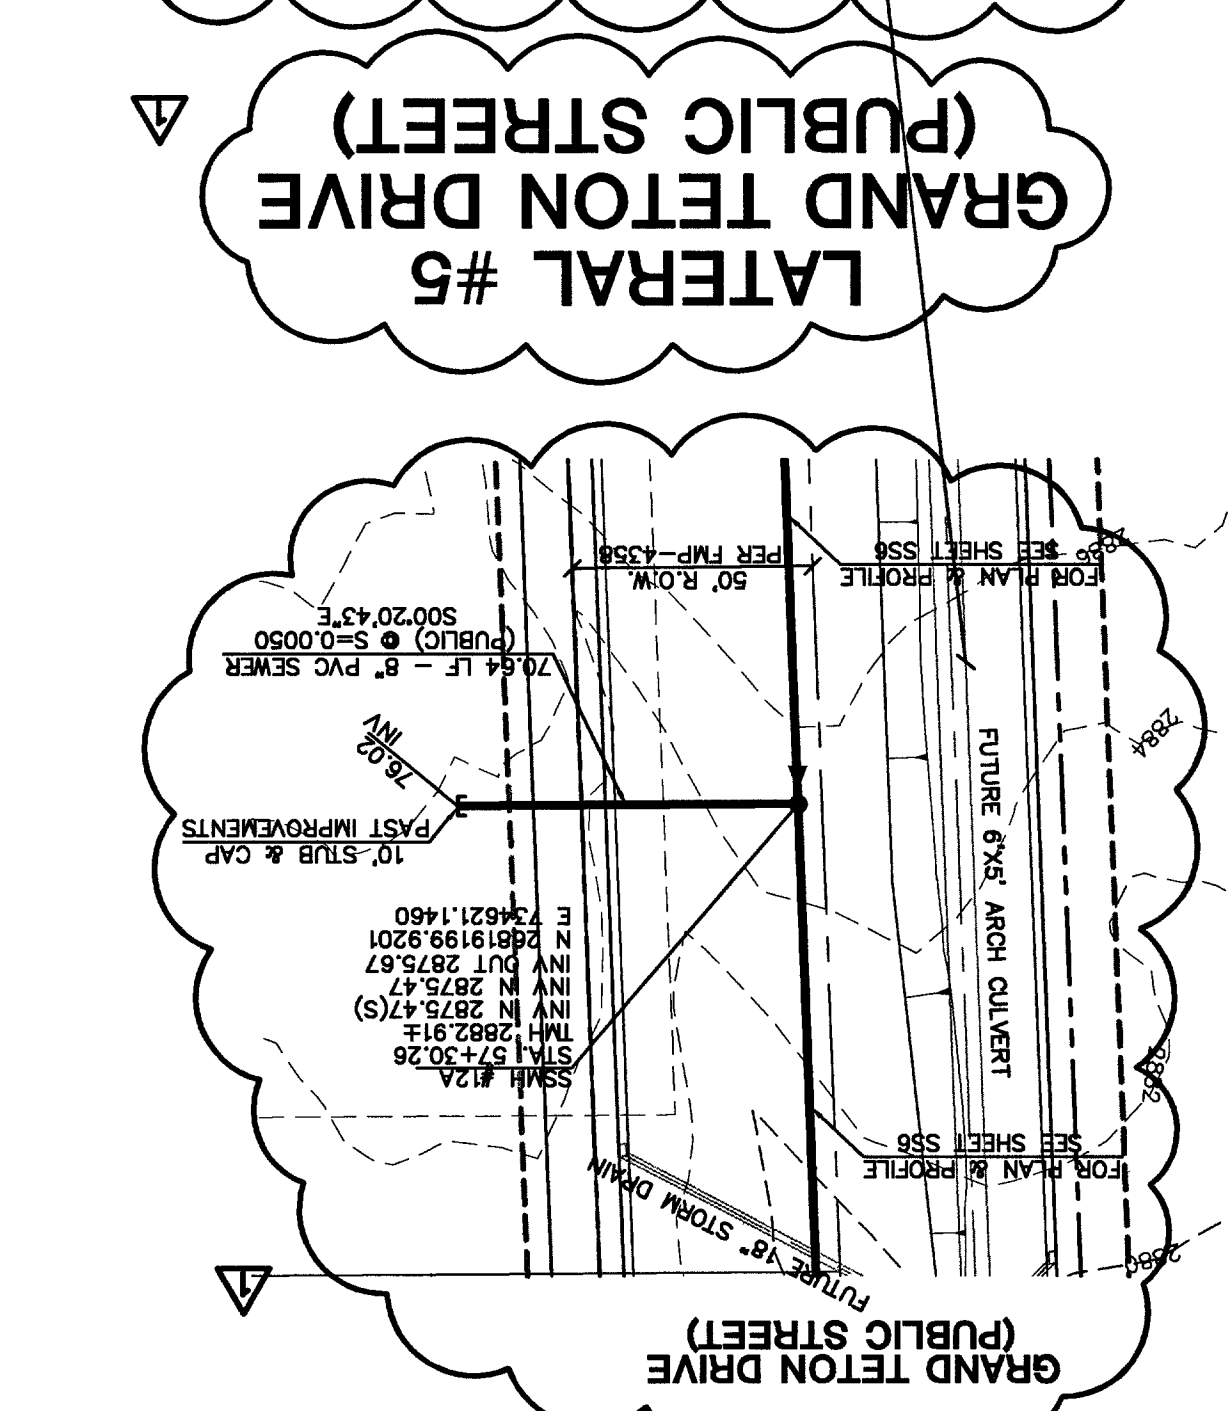
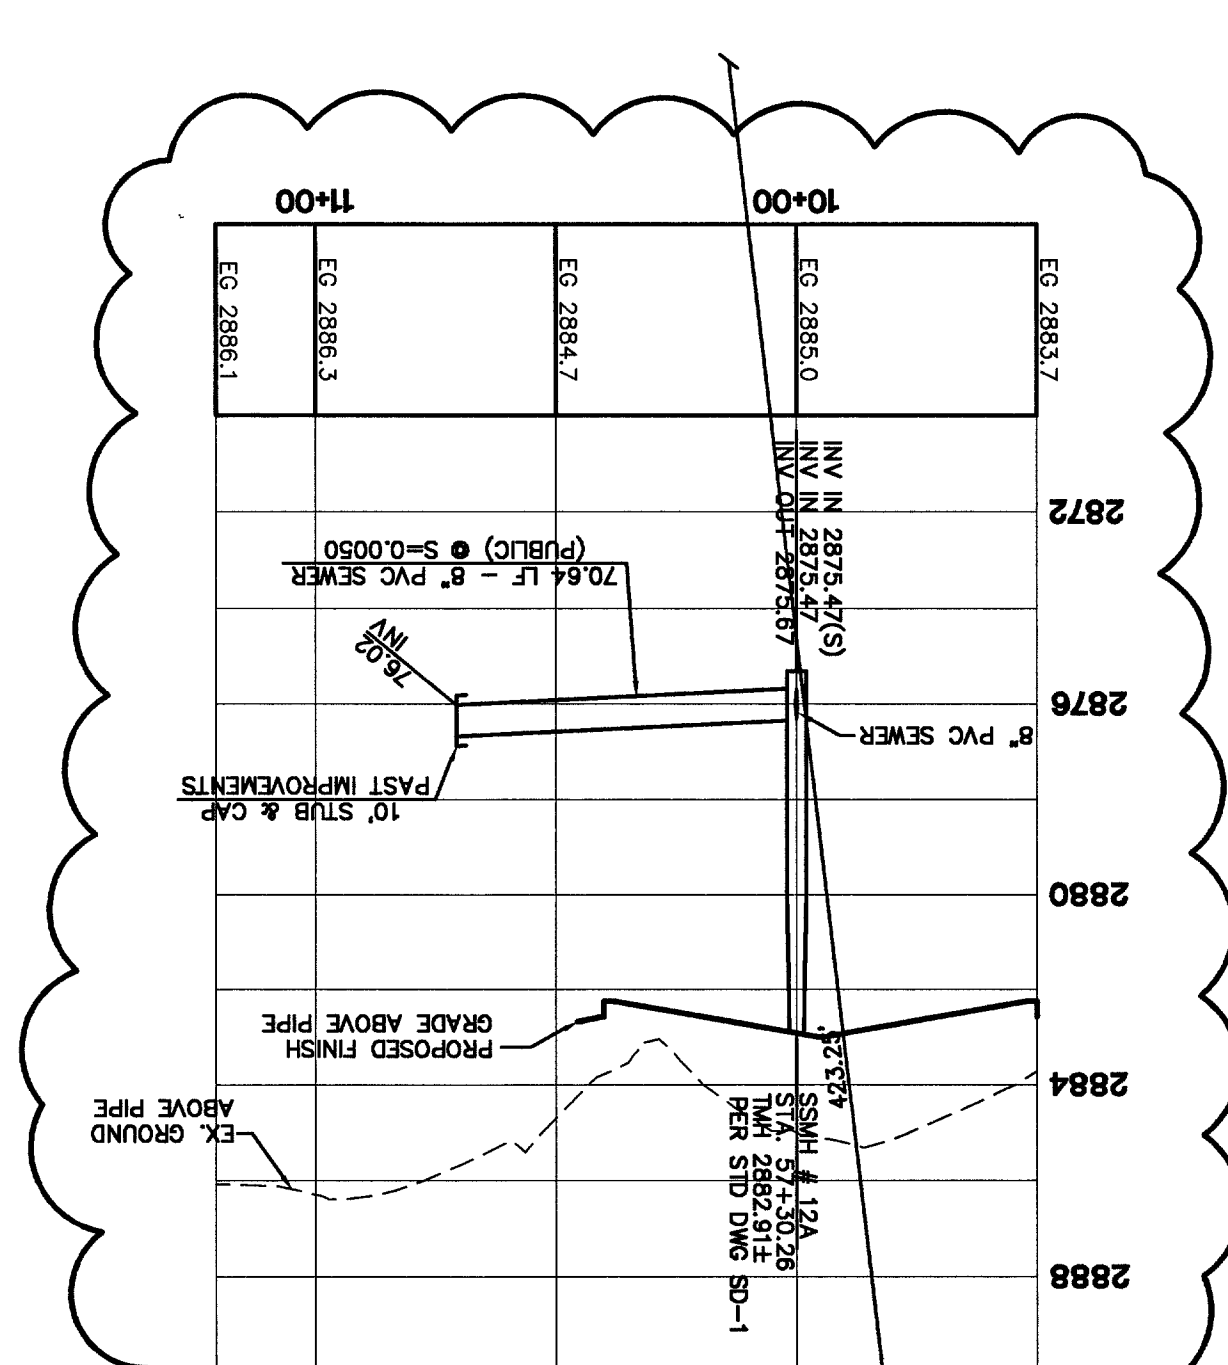
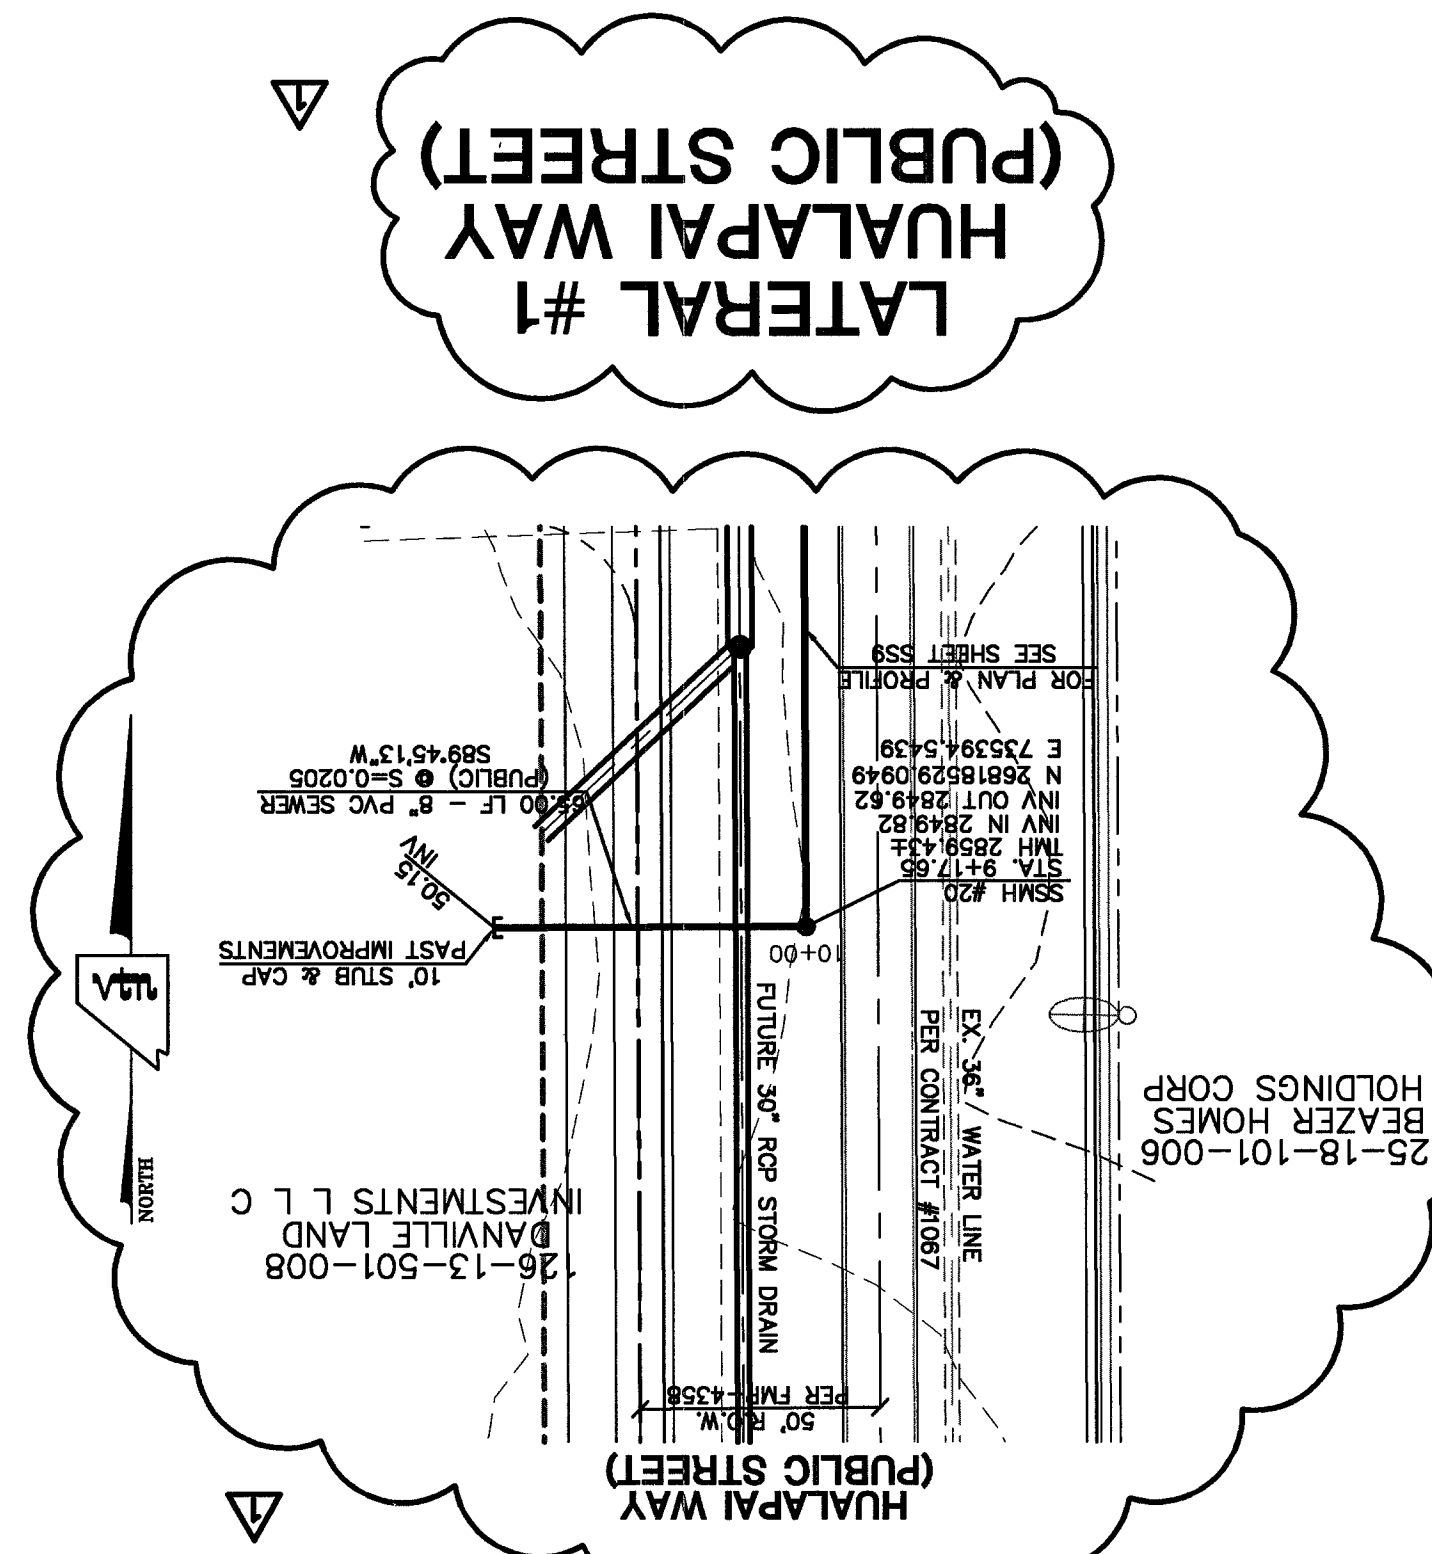
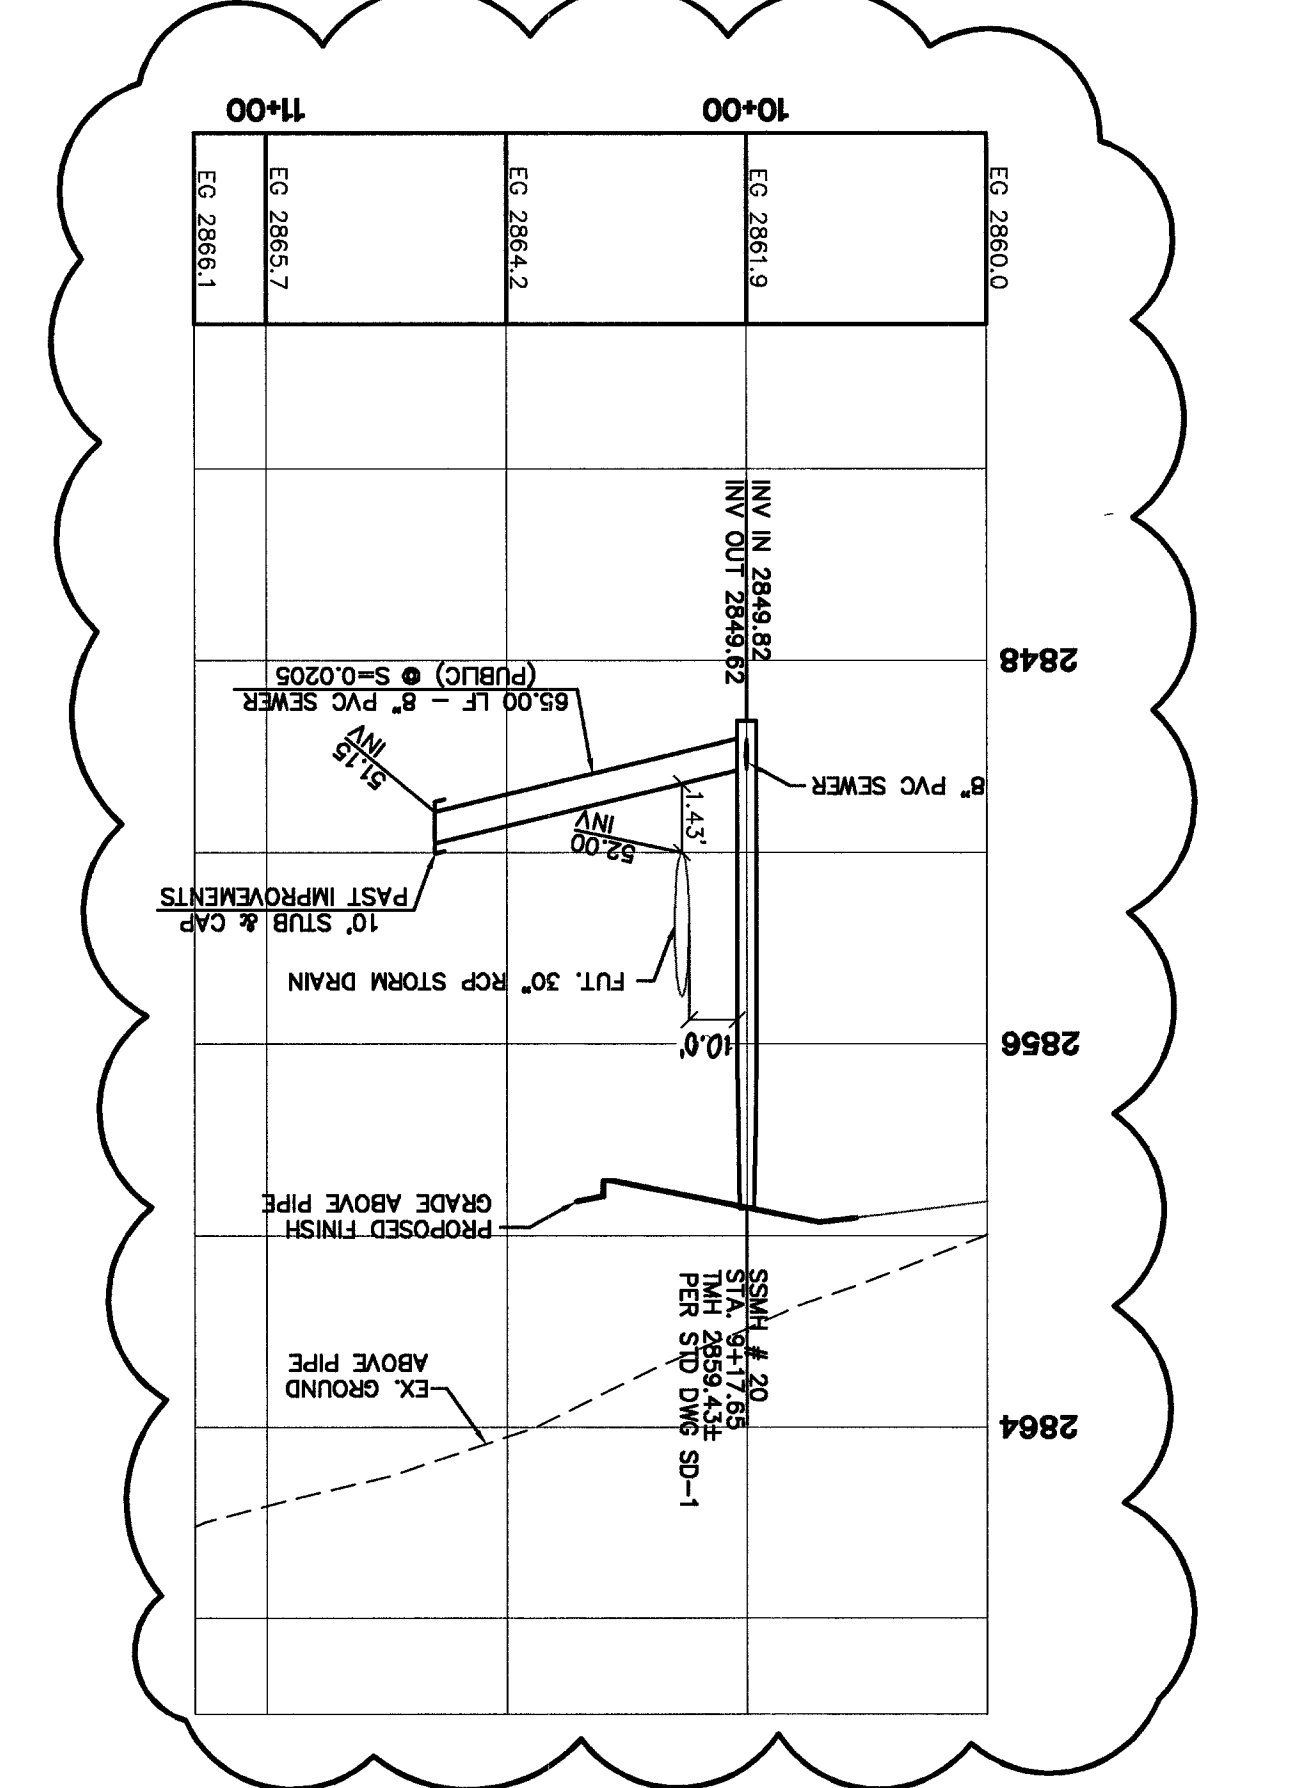
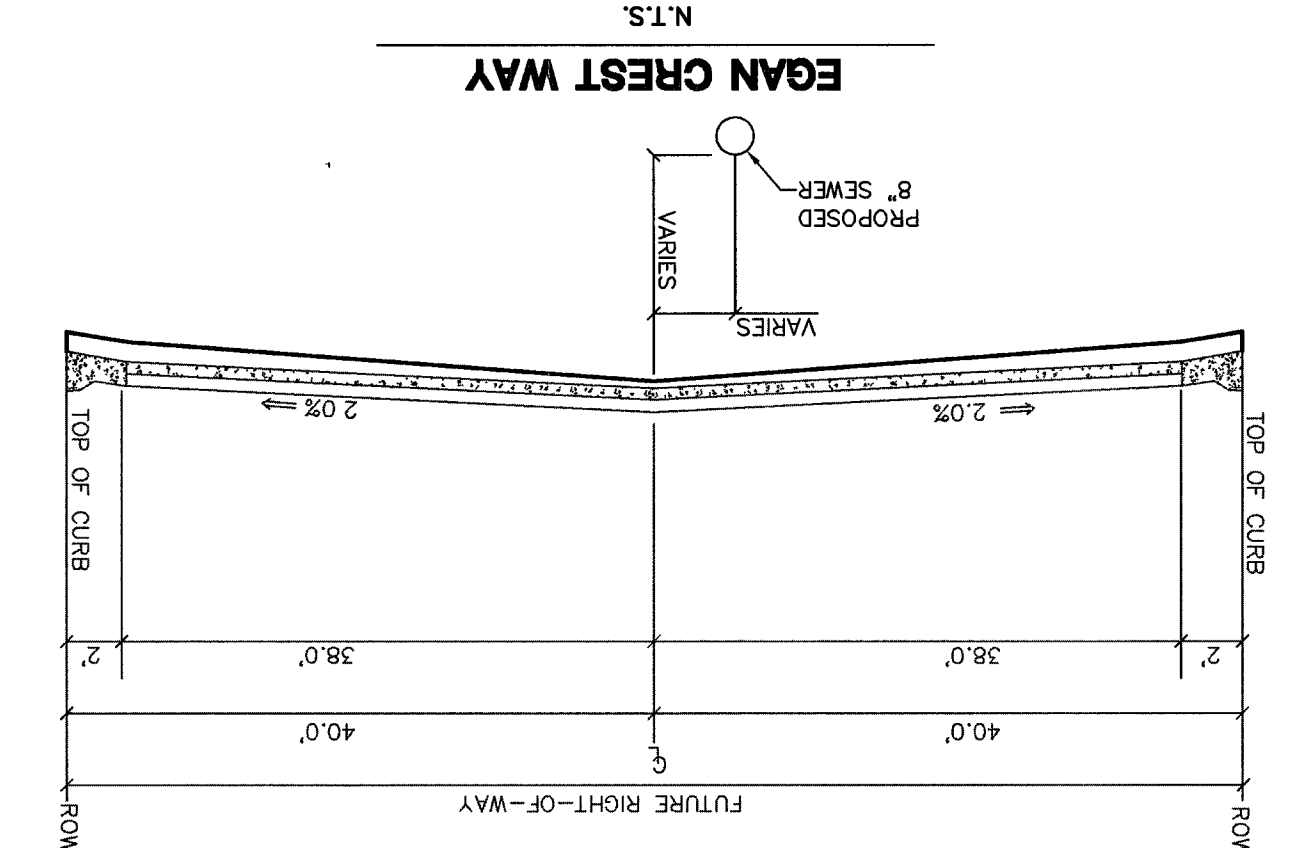
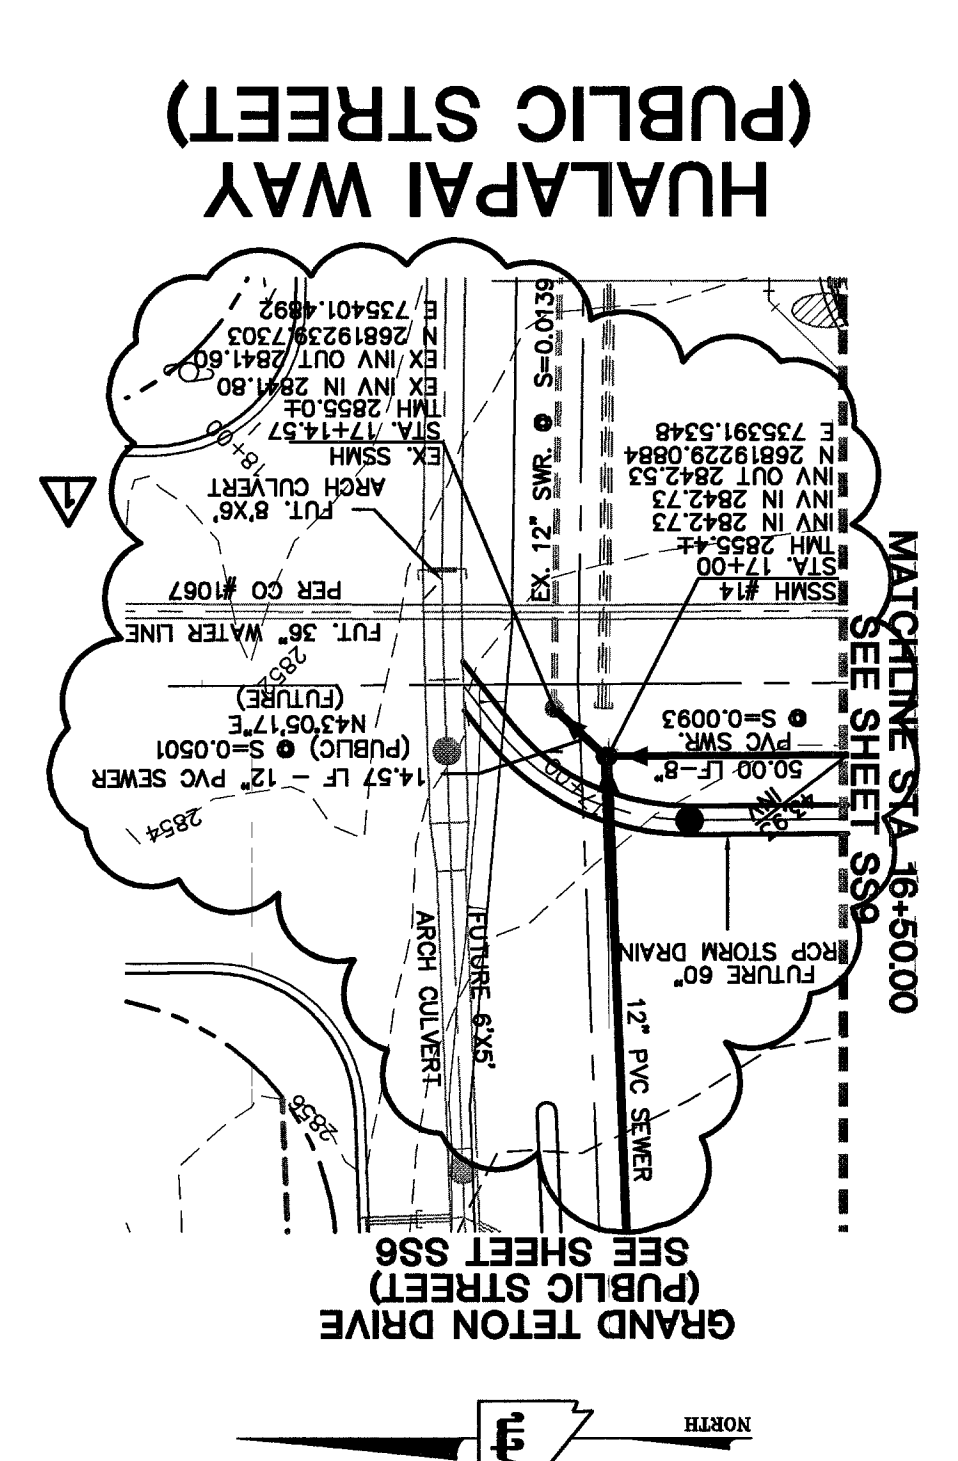
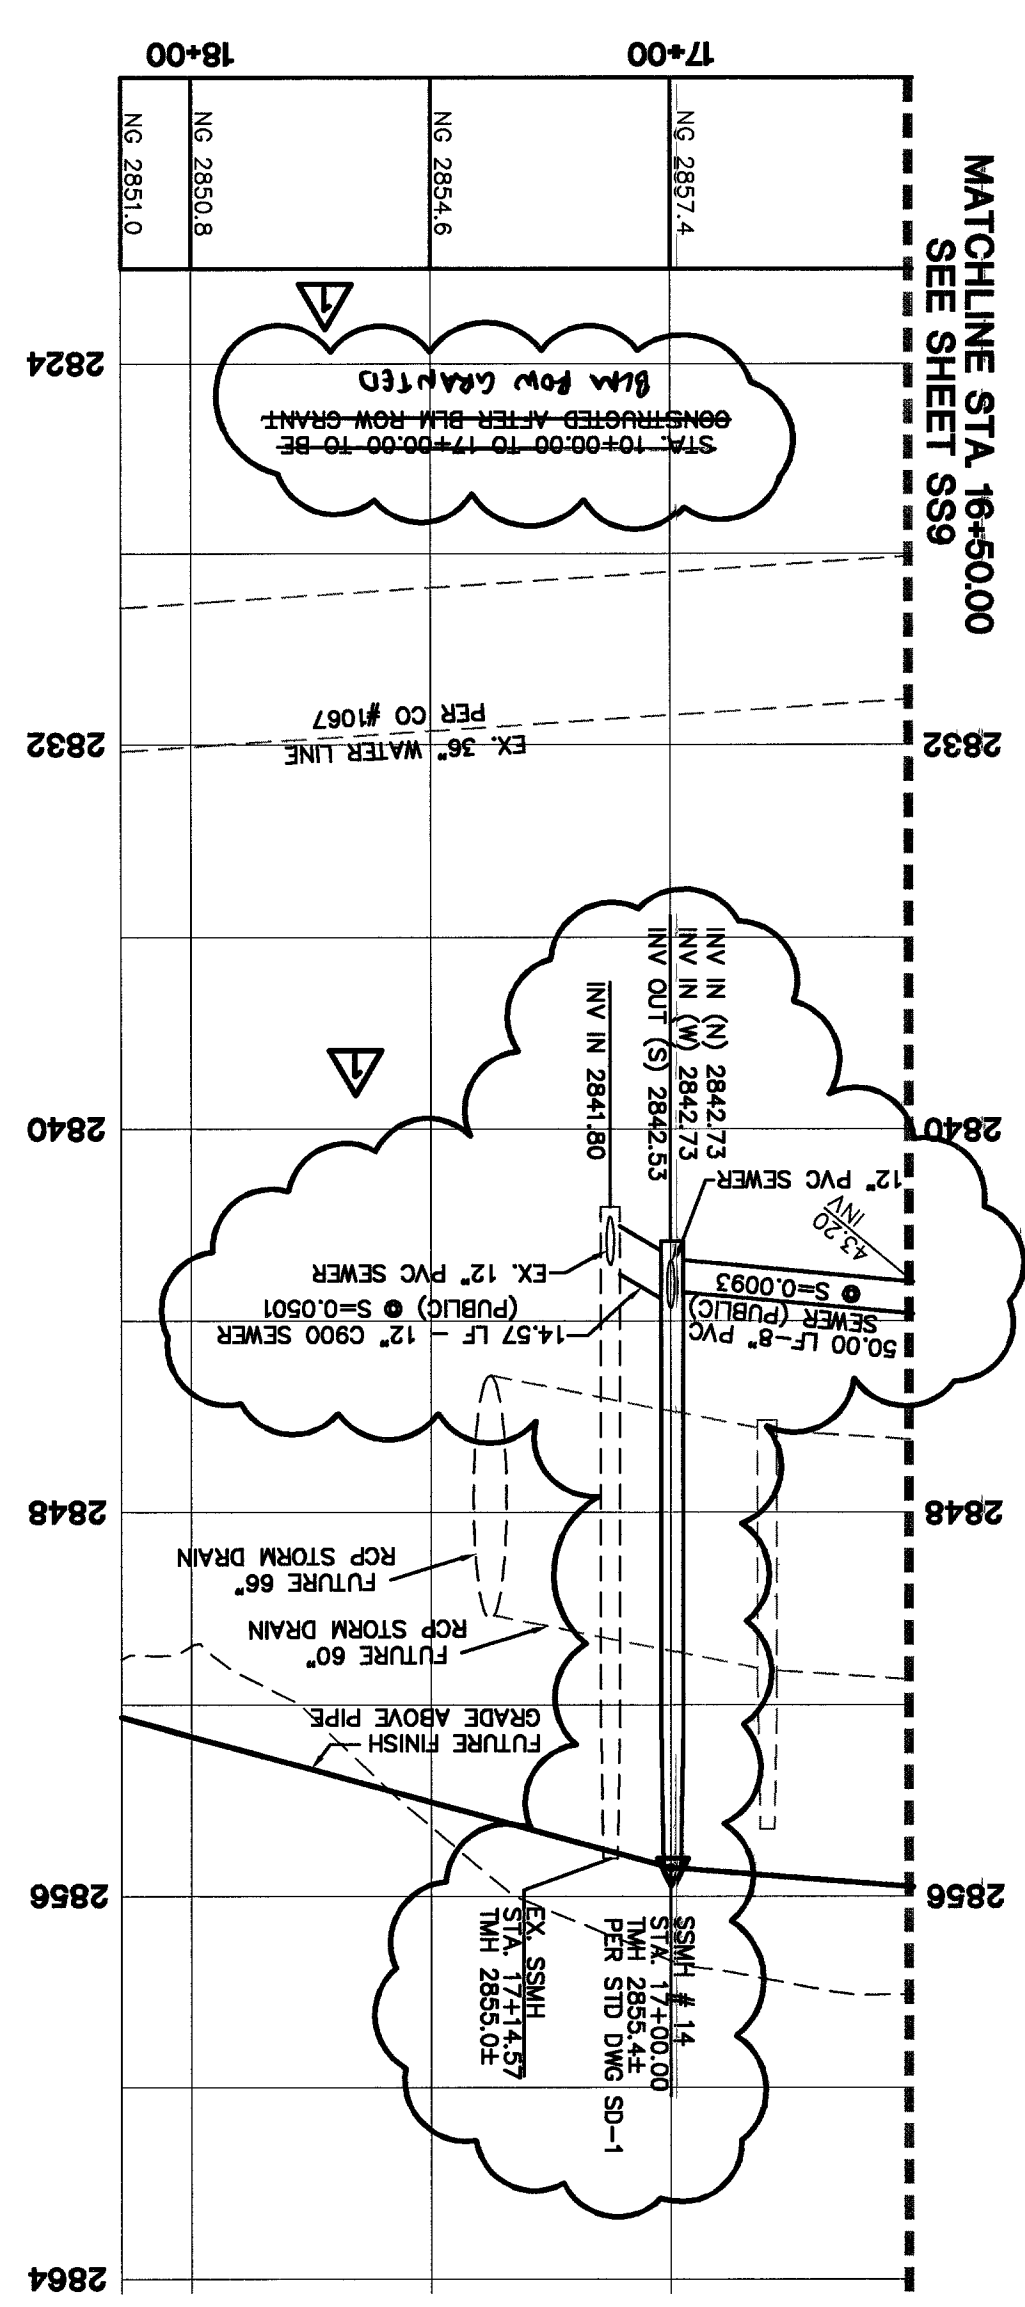


CITY OF LAS VEGAS BENCHMARK
PROJECT DATUM: NORTH AMERICAN VERTICAL DATUM OF 1988 (NAV88)
CLARK COUNTY VERTICAL CONTROL: 1000-696
NAV88 ELEVATION: 787.794 METERS (2584.62 FEET)
RIGHT AND SQUARE ALUMINUM PLATE IN A CONCRETE CYPINDER, LOCATED 25 SOUTH & 50' EAST OF GRAND CANYON DRIVE AND RED COACH AVENUE, 1' WEST OF ELECTRICAL VAULT.

Underground
Call before you dig
1-702-451-1511
LAS VEGAS AREA COMPUTERIZED TRAFFIC SYSTEM
CLARK COUNTY TRAFFIC OPERATIONS
AND
1-702-229-6611
CALL BEFORE YOU DIG
1-800-227-2600

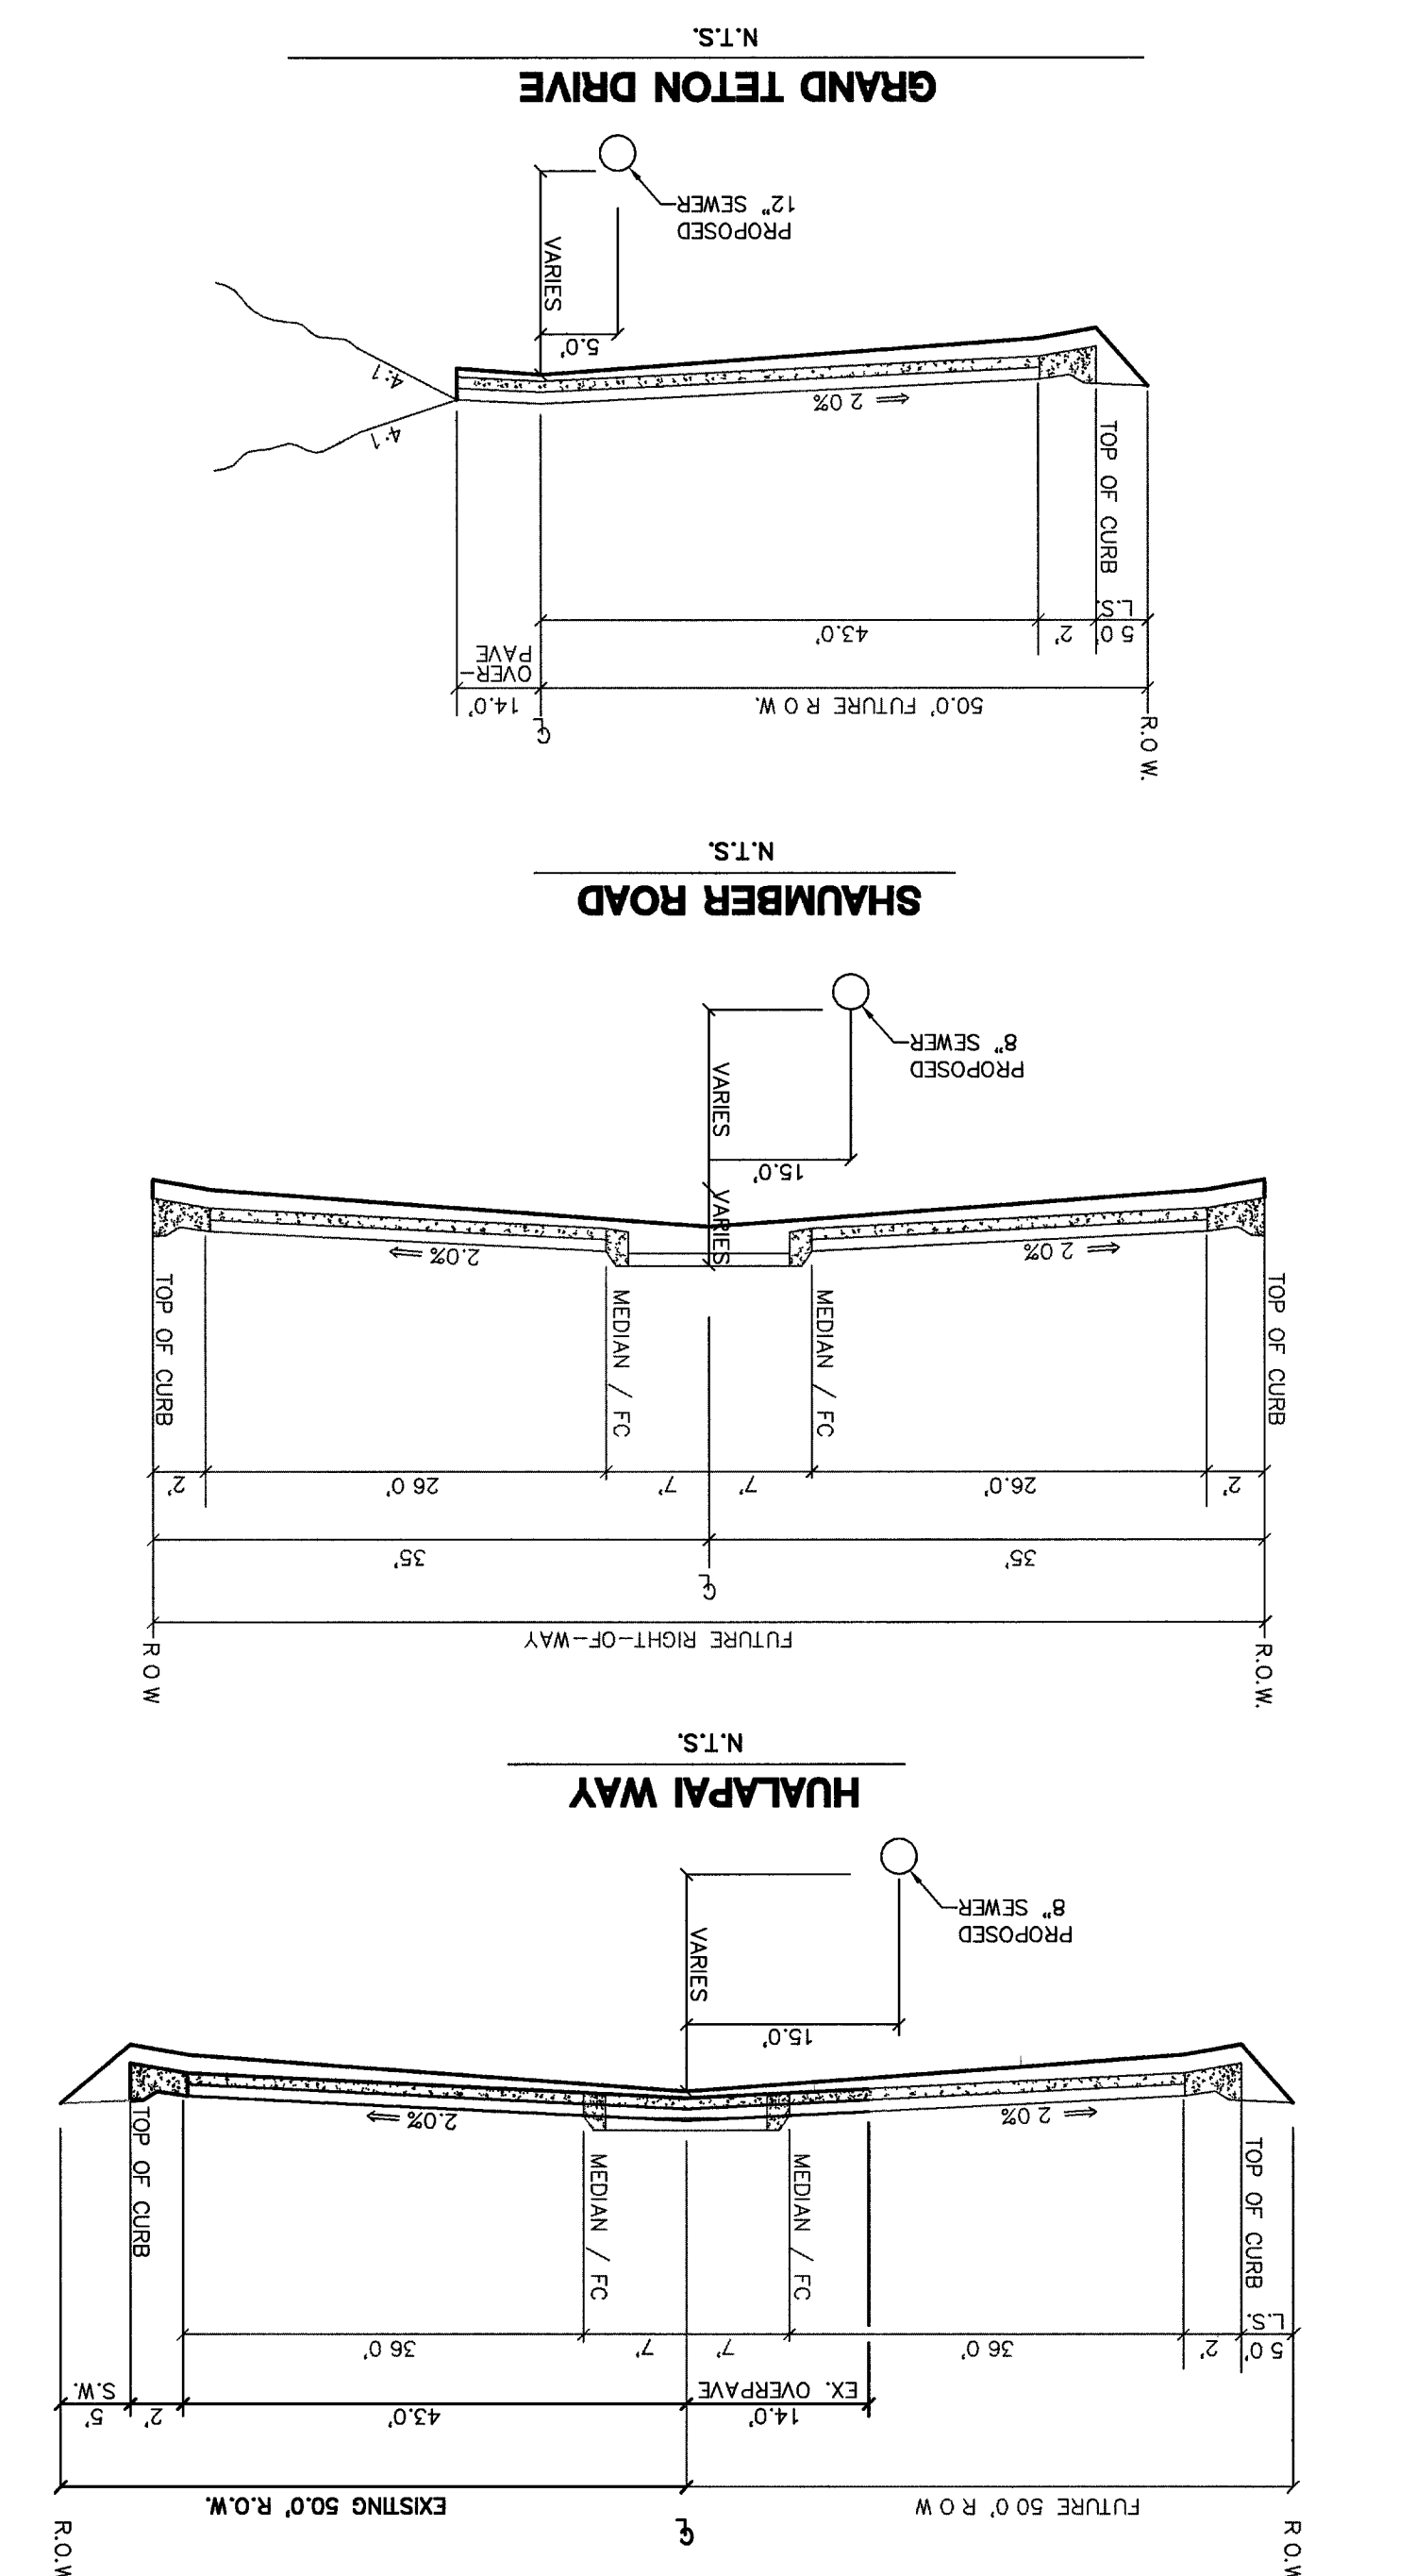

CONTRACTOR NOTE
CONTRACTOR SHALL VERIFY HORIZONTAL AND VERTICAL LOCATION OF EXISTING UTILITIES AND NOTIFY THE DESIGN ENGINEER IMMEDIATELY OF ANY DISCREPANCIES PRIOR TO CONSTRUCTION.

CLIFFS EDGE LLC
3455 CLIFF SHADOWS PARKWAY, SUITE 200
LAS VEGAS, NEVADA 89129
(702) 777-1221

CITY OF LAS VEGAS, NEVADA
2727 SOUTH RAINBOW BOULEVARD LAS VEGAS, NEVADA 89146-5148
PH: (702) 873-7550 FAX: (702) 362-2597

SEWER PLAN AND PROFILE
HUALAPAI WAY
STA. 16+50.00 TO 18+14.57 & LAT. #1

CLIFFS EDGE GRAND TETON DRIVE SEWER IMPROVEMENTS

DESIGNED BY: APRIL '04
CHECKED BY: APRIL '04
SCALE: 1"=40' HORIZ.
1"=4' VERT.

PROJECT NO: 9989

EXPANDED BY: APRIL '04


