


THIS PLAN DRAWING AND THE LAND NOT BE REPRODUCED OR TRANSMITTED IN ANY FORM OR BY ANY MEANS, ELECTRONIC OR MECHANICAL, INCLUDING PHOTOCOPYING, RECORDING, OR BY ANY INFORMATION STORAGE AND RETRIEVAL SYSTEM, WITHOUT THE WRITTEN PERMISSION OF THE ENGINEER OF RECORD.

82056

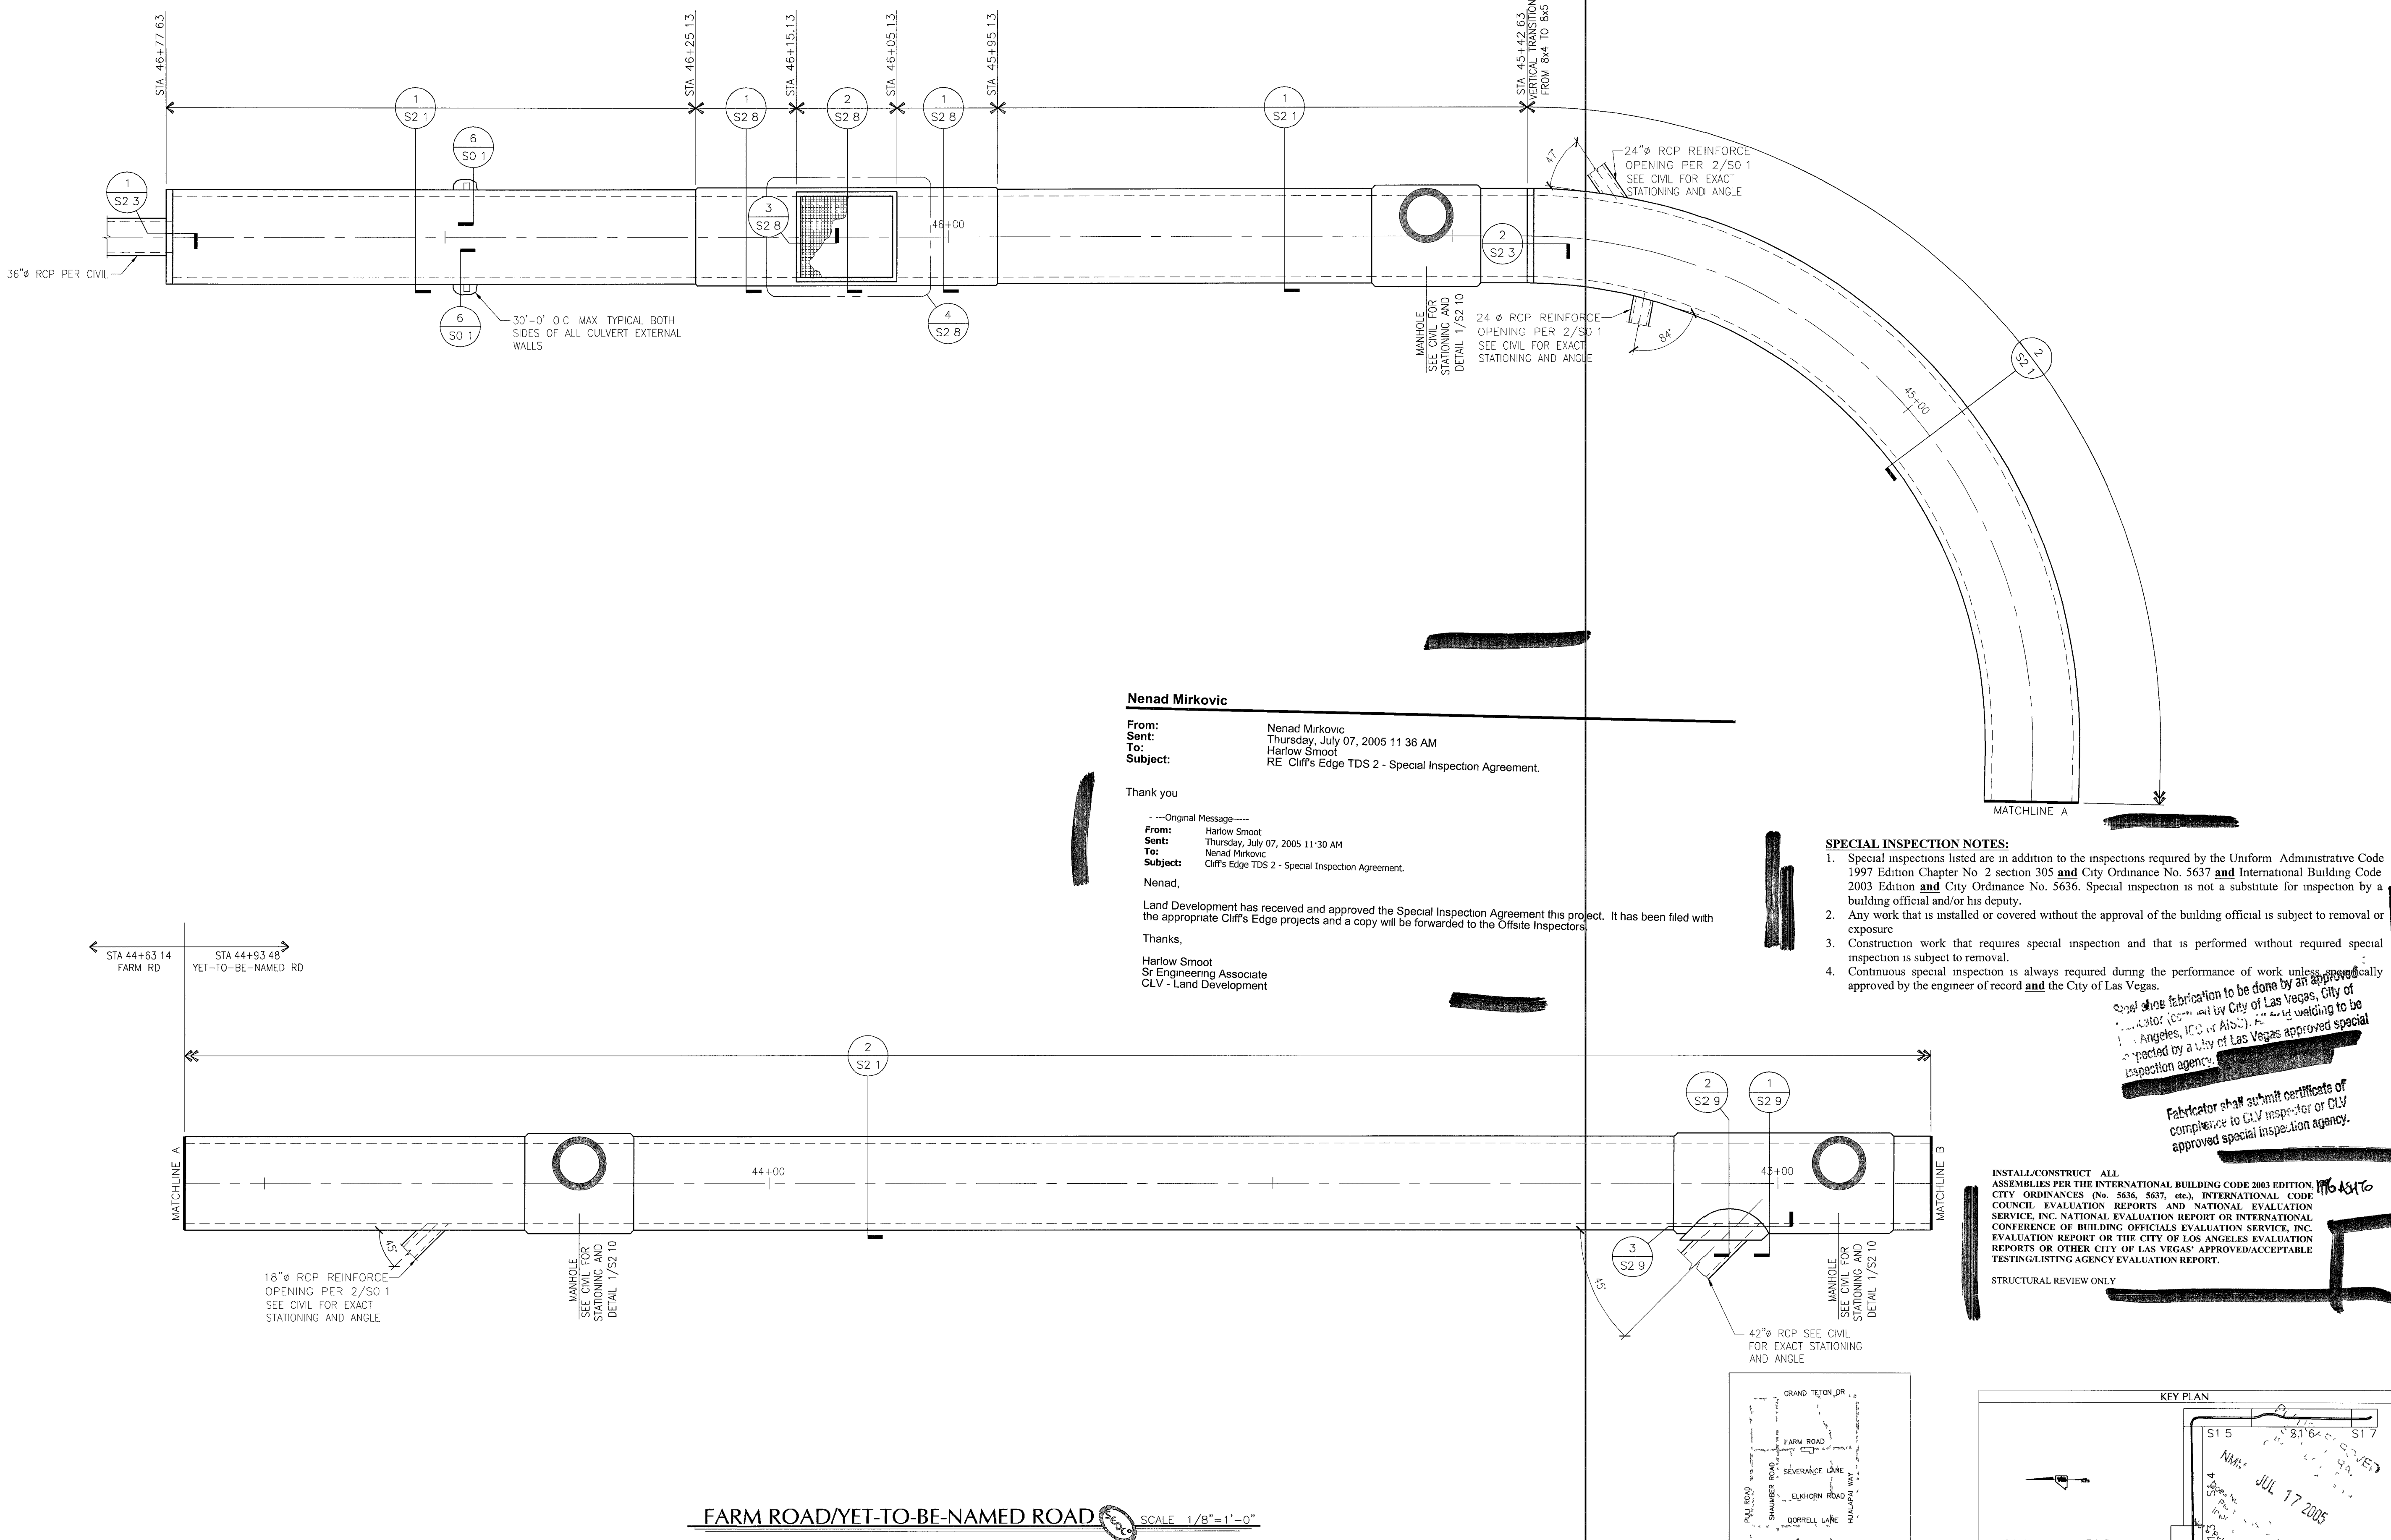

Nenad Mirkovic

From: Nenad Mirkovic
Sent: Thursday, July 07, 2005 11:36 AM
To: Harlow Smoot
Subject: RE: Cliff's Edge TDS 2 - Special Inspection Agreement.

Thank you

-----Original Message-----
From: Harlow Smoot
Sent: Thursday, July 07, 2005 11:30 AM
To: Nenad Mirkovic
Subject: Cliff's Edge TDS 2 - Special Inspection Agreement.

Nenad,

Land Development has received and approved the Special Inspection Agreement this project. It has been filed with the appropriate Cliff's Edge projects and a copy will be forwarded to the Offsite Inspectors.

Thanks,

Harlow Smoot
Sr Engineering Associate
CLV - Land Development

SPECIAL INSPECTION NOTES:



1. Special inspections listed are in addition to the inspections required by the Uniform Administrative Code 1997 Edition Chapter No. 2 section 305 and City Ordinance No. 5637 and International Building Code 2003 Edition and City Ordinance No. 5636. Special inspection is not a substitute for inspection by a building official and/or his deputy.
2. Any work that is installed or covered without the approval of the building official is subject to removal or exposure.
3. Construction work that requires special inspection and that is performed without required special inspection is subject to removal.
4. Continuous special inspection is always required during the performance of work unless approved by the engineer of record and the City of Las Vegas.

Special fabrication to be done by an approved fabricator (see list by City of Las Vegas, City of Los Angeles, ICC or AISC). All welded welding to be inspected by a City of Las Vegas approved special inspection agency.

Fabricator shall submit certificate of compliance to CLV inspector or CLV approved special inspection agency.

INSTALL/CONSTRUCT ALL ASSEMBLIES PER THE INTERNATIONAL BUILDING CODE 2003 EDITION, CITY ORDINANCES (No. 5636, 5637, etc), INTERNATIONAL CODE COUNCIL EVALUATION REPORTS AND NATIONAL EVALUATION SERVICE, INC. NATIONAL EVALUATION REPORT OR INTERNATIONAL CONFERENCE OF BUILDING OFFICIALS EVALUATION SERVICE, INC. EVALUATION REPORT OR THE CITY OF LOS ANGELES EVALUATION REPORTS OR OTHER CITY OF LAS VEGAS' APPROVED/ACCEPTABLE TESTING/LISTING AGENCY EVALUATION REPORT.

STRUCTURAL REVIEW ONLY

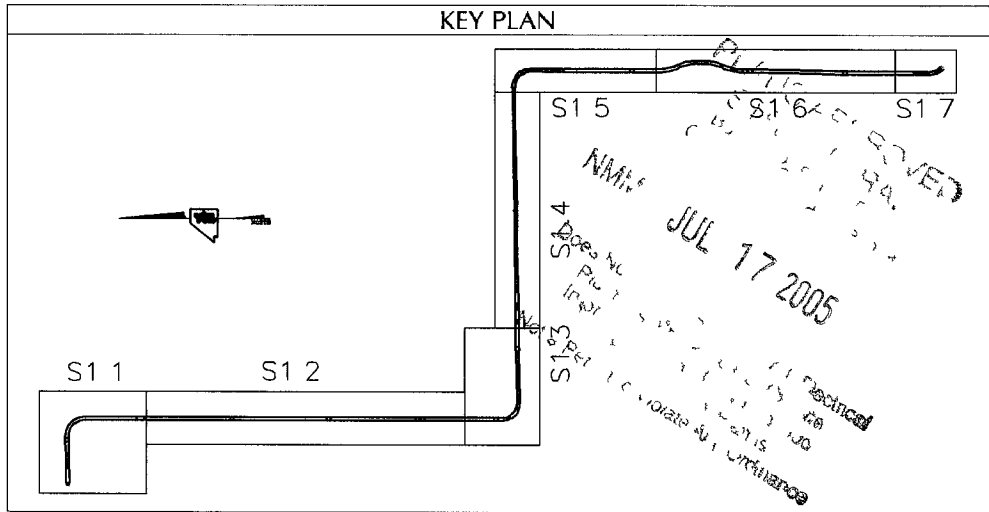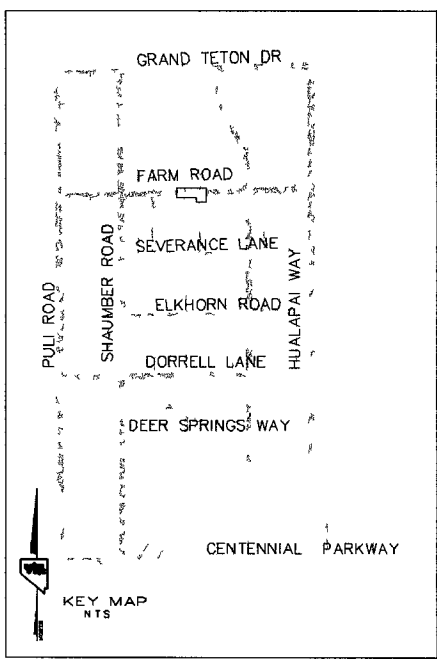

PLAN VIEW

SCALE 1/8"=1'-0"

CLIFF'S EDGE PHASE II
SEVERENCE LN, EGAN CREST RD, FARM RD, CENTENNIAL PKWY
NORTH LAS VEGAS, NV
FOR
CLIFF'S EDGE, LLC


04368

REV	DATE	SUBMITTED FOR APPROVAL	SUBMITTED FOR APPROVAL	DESCRIPTION
1	11/27/05	6/2/05		

DATE: NOVEMBER 16, 2004
PROJECT NUMBER: 04368
SHEET NUMBER:


S1.1

2

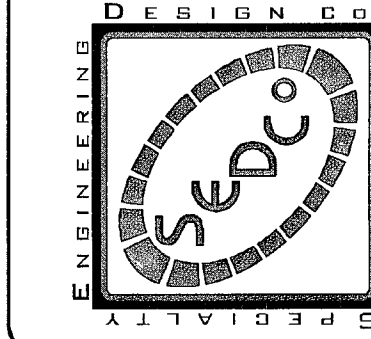

4943 NORTH 29TH EAST, STE A
IDAHO FALLS, IDAHO 83401
Phone: (208) 524-0800
Fax: (208) 552-9302

DESIGNED: JW
DRAWN: EAD
CHECKED: JS
APPROVED: JS

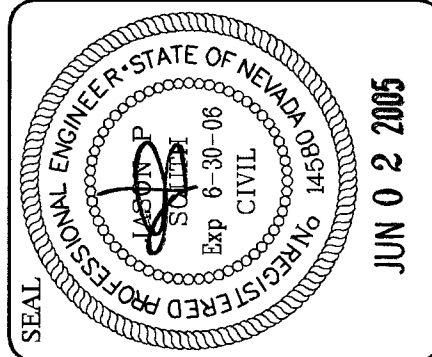

JUN 02 2005