



SECTION - FARM ROAD
PER CLARK COUNTY AREA USD #205
(NOT TO SCALE)

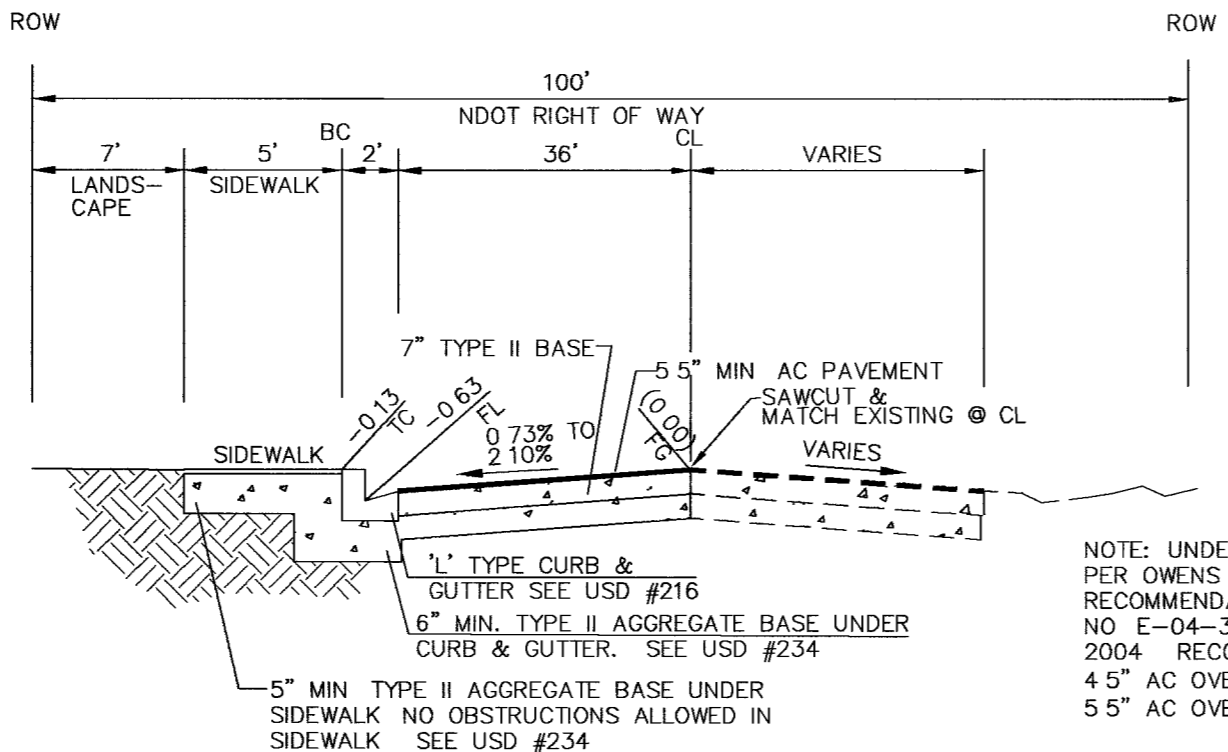


SECTION - TULE SPRINGS ROAD
PER CLARK COUNTY AREA USD #205
(NOT TO SCALE)

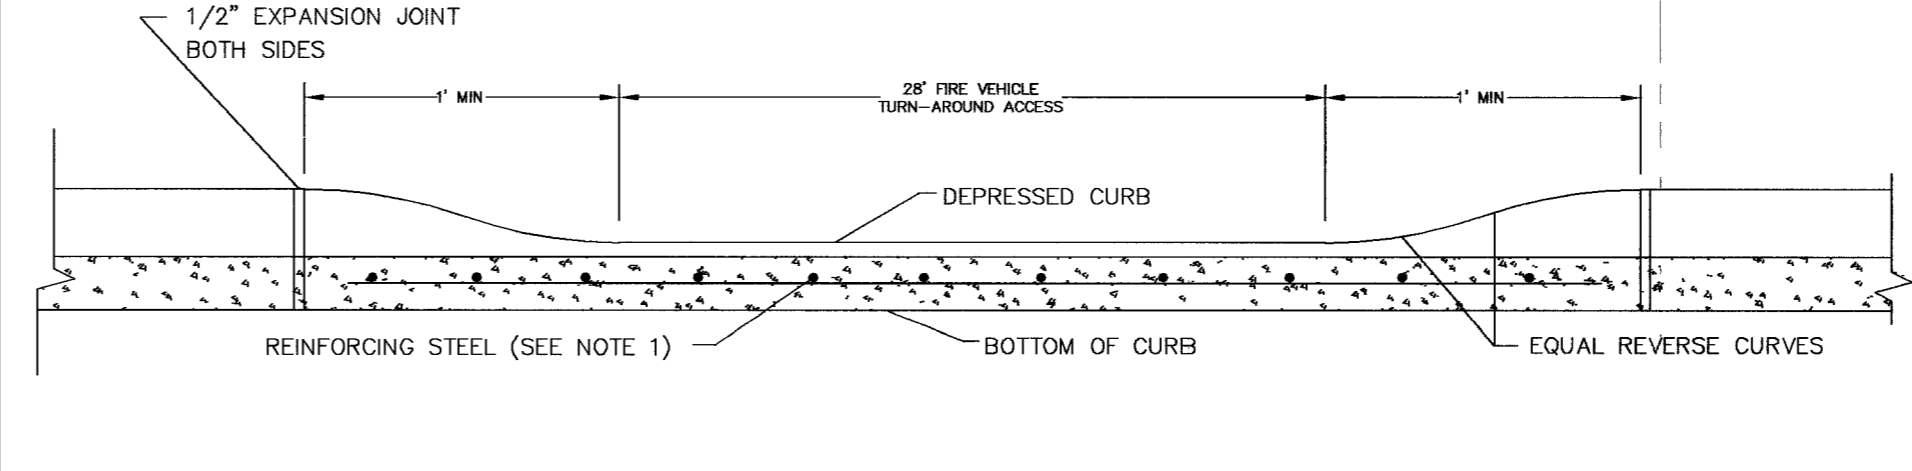


DETAIL E - DEPRESSED CURB DETAIL
(NOT TO SCALE)


- NOTES:
- No 4 BARS @ 16" O.C BOTH WAYS CONTINUOUS THROUGH GUTTER
 - No 4 BARS SHALL BE PLACED 3" ABOVE BOTTOM OF CONCRETE
 - CONCRETE SHALL BE CLASS B
 - DRIVEWAY THICKNESS SHALL BE 8" MIN.

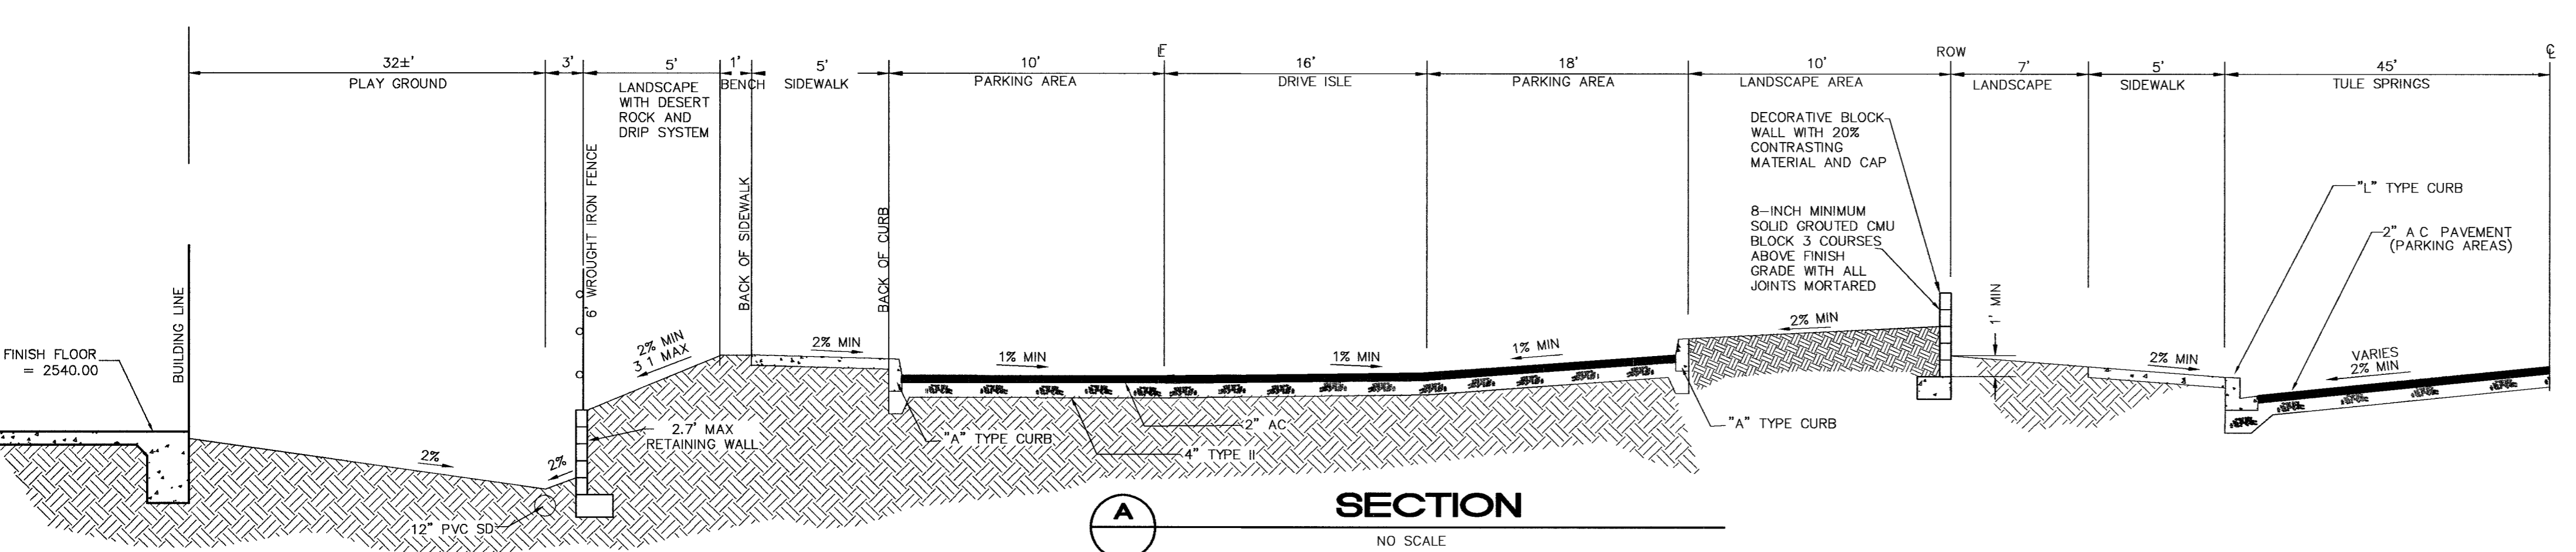


SECTION A
NO SCALE

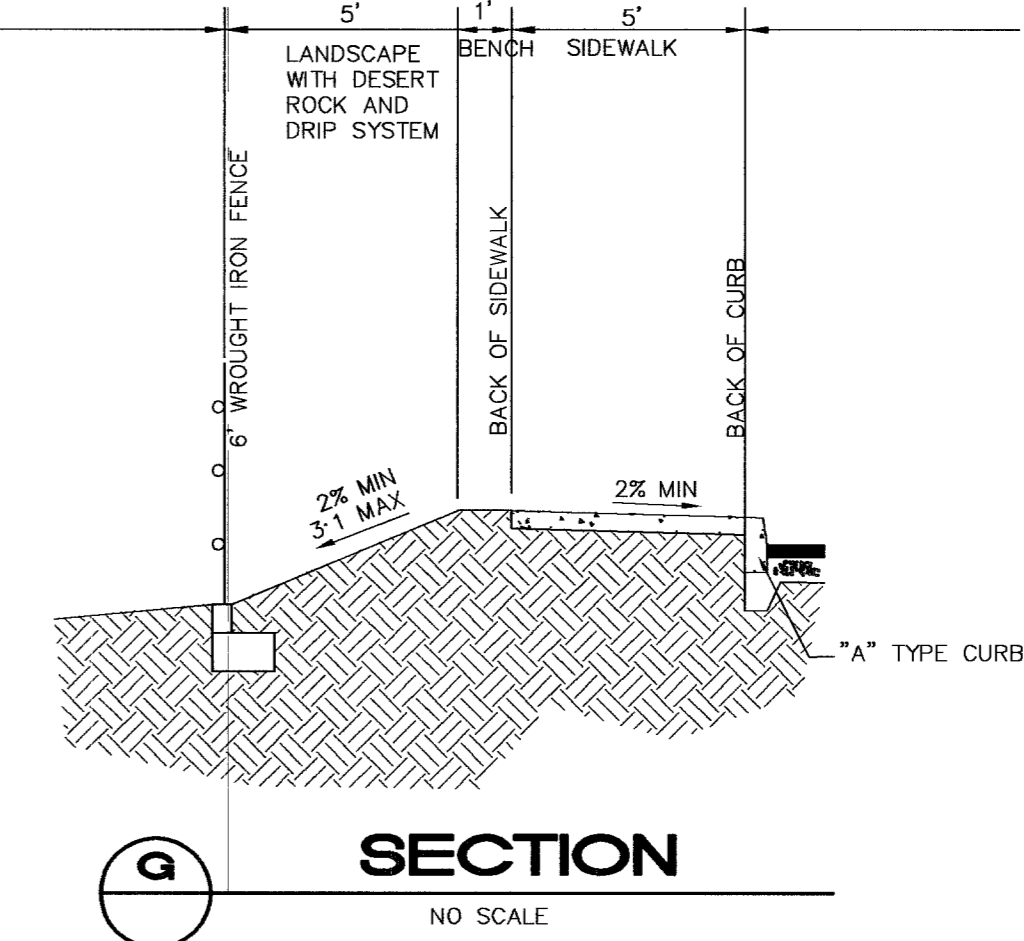


SECTION G
NO SCALE

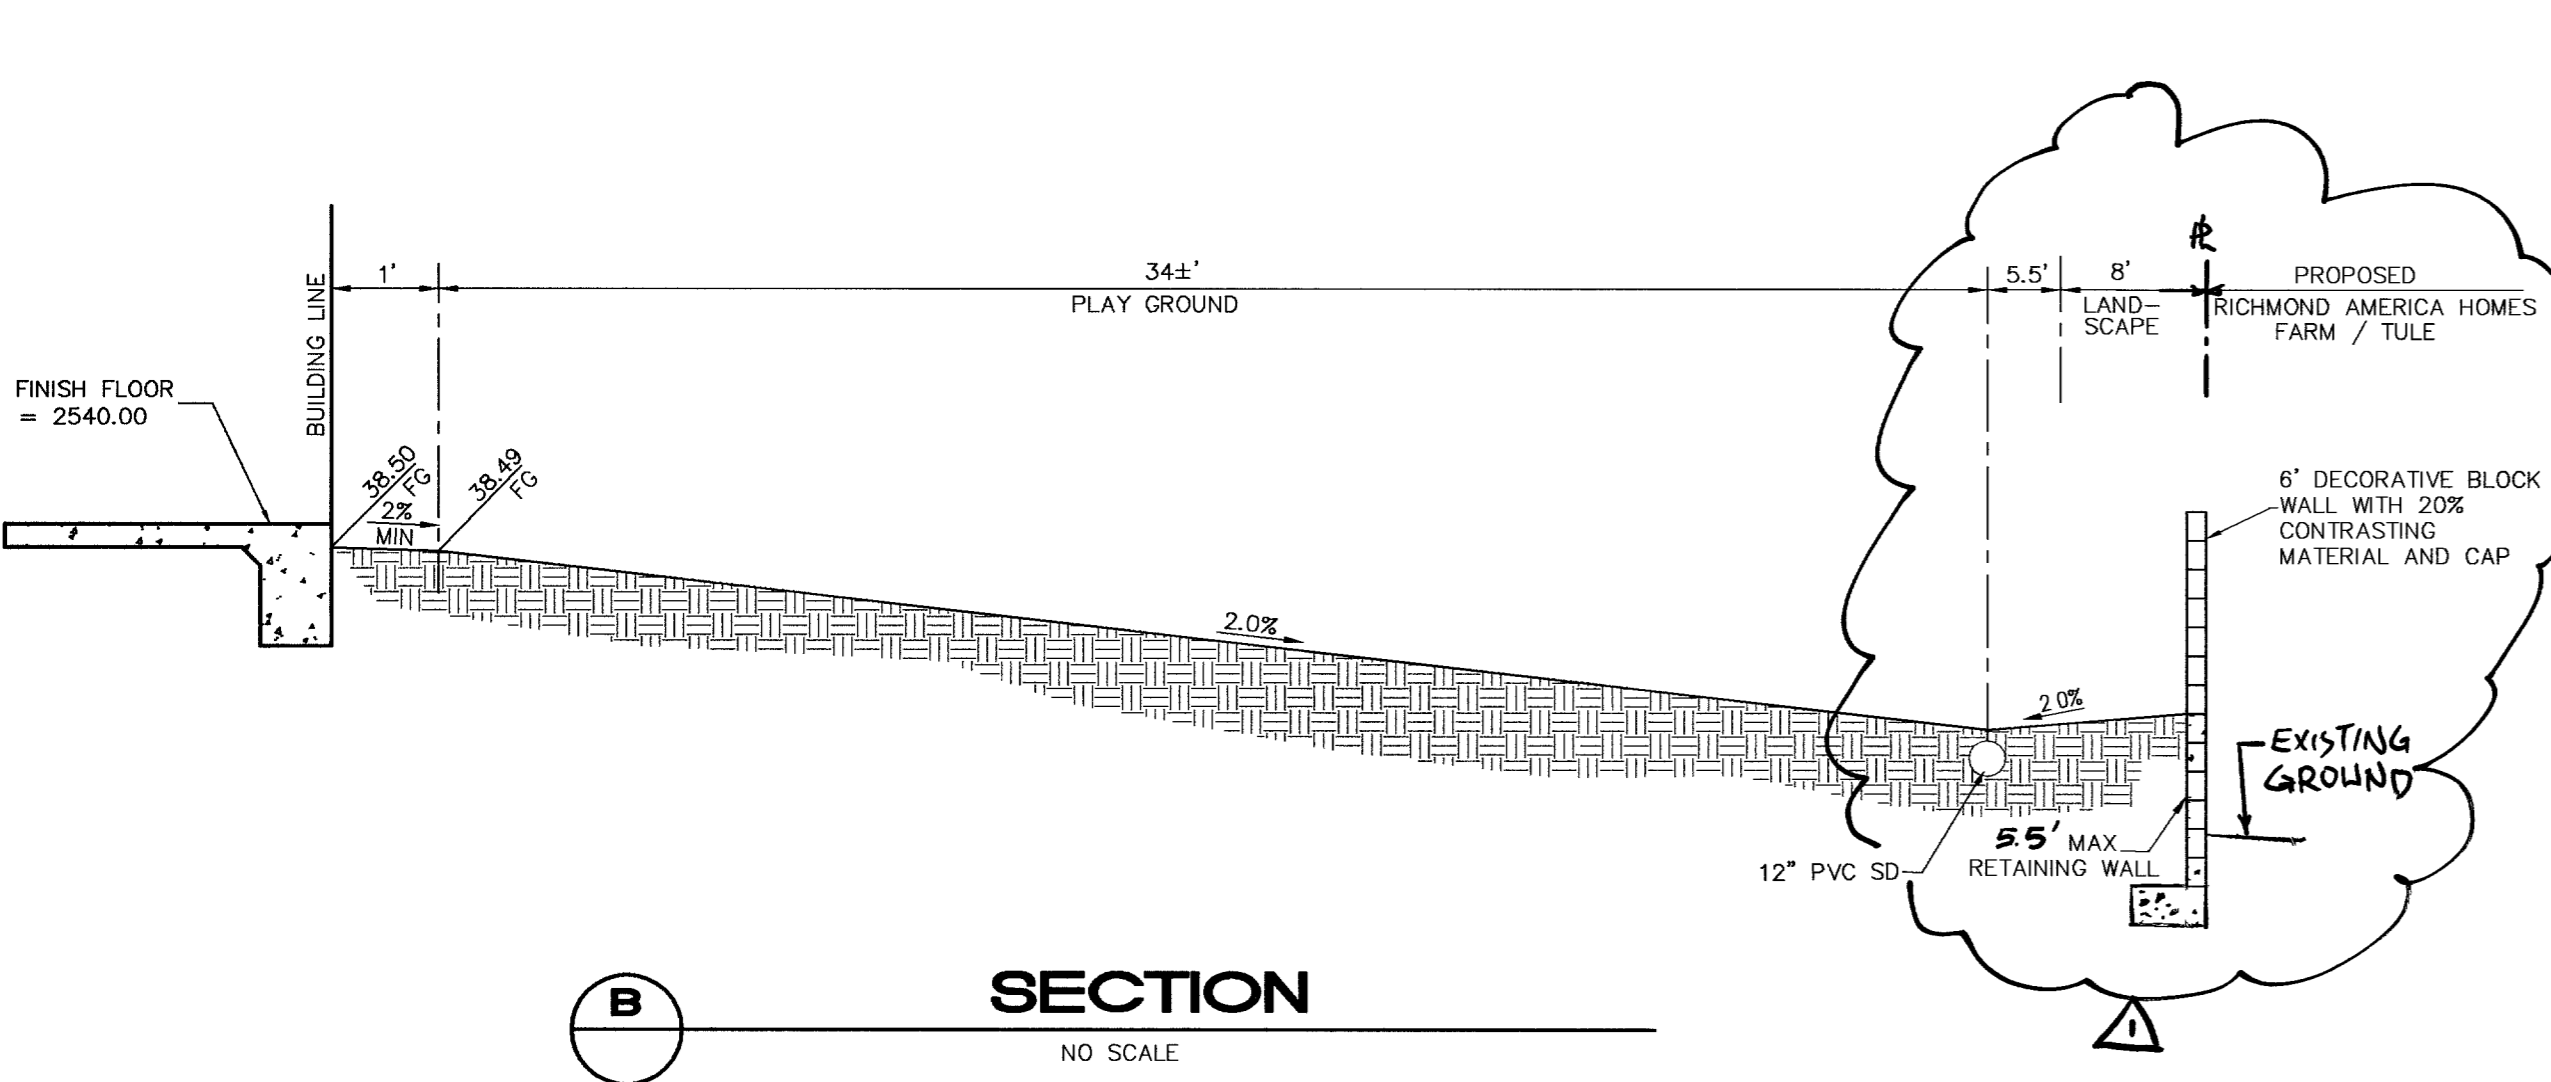


SECTION B
NO SCALE

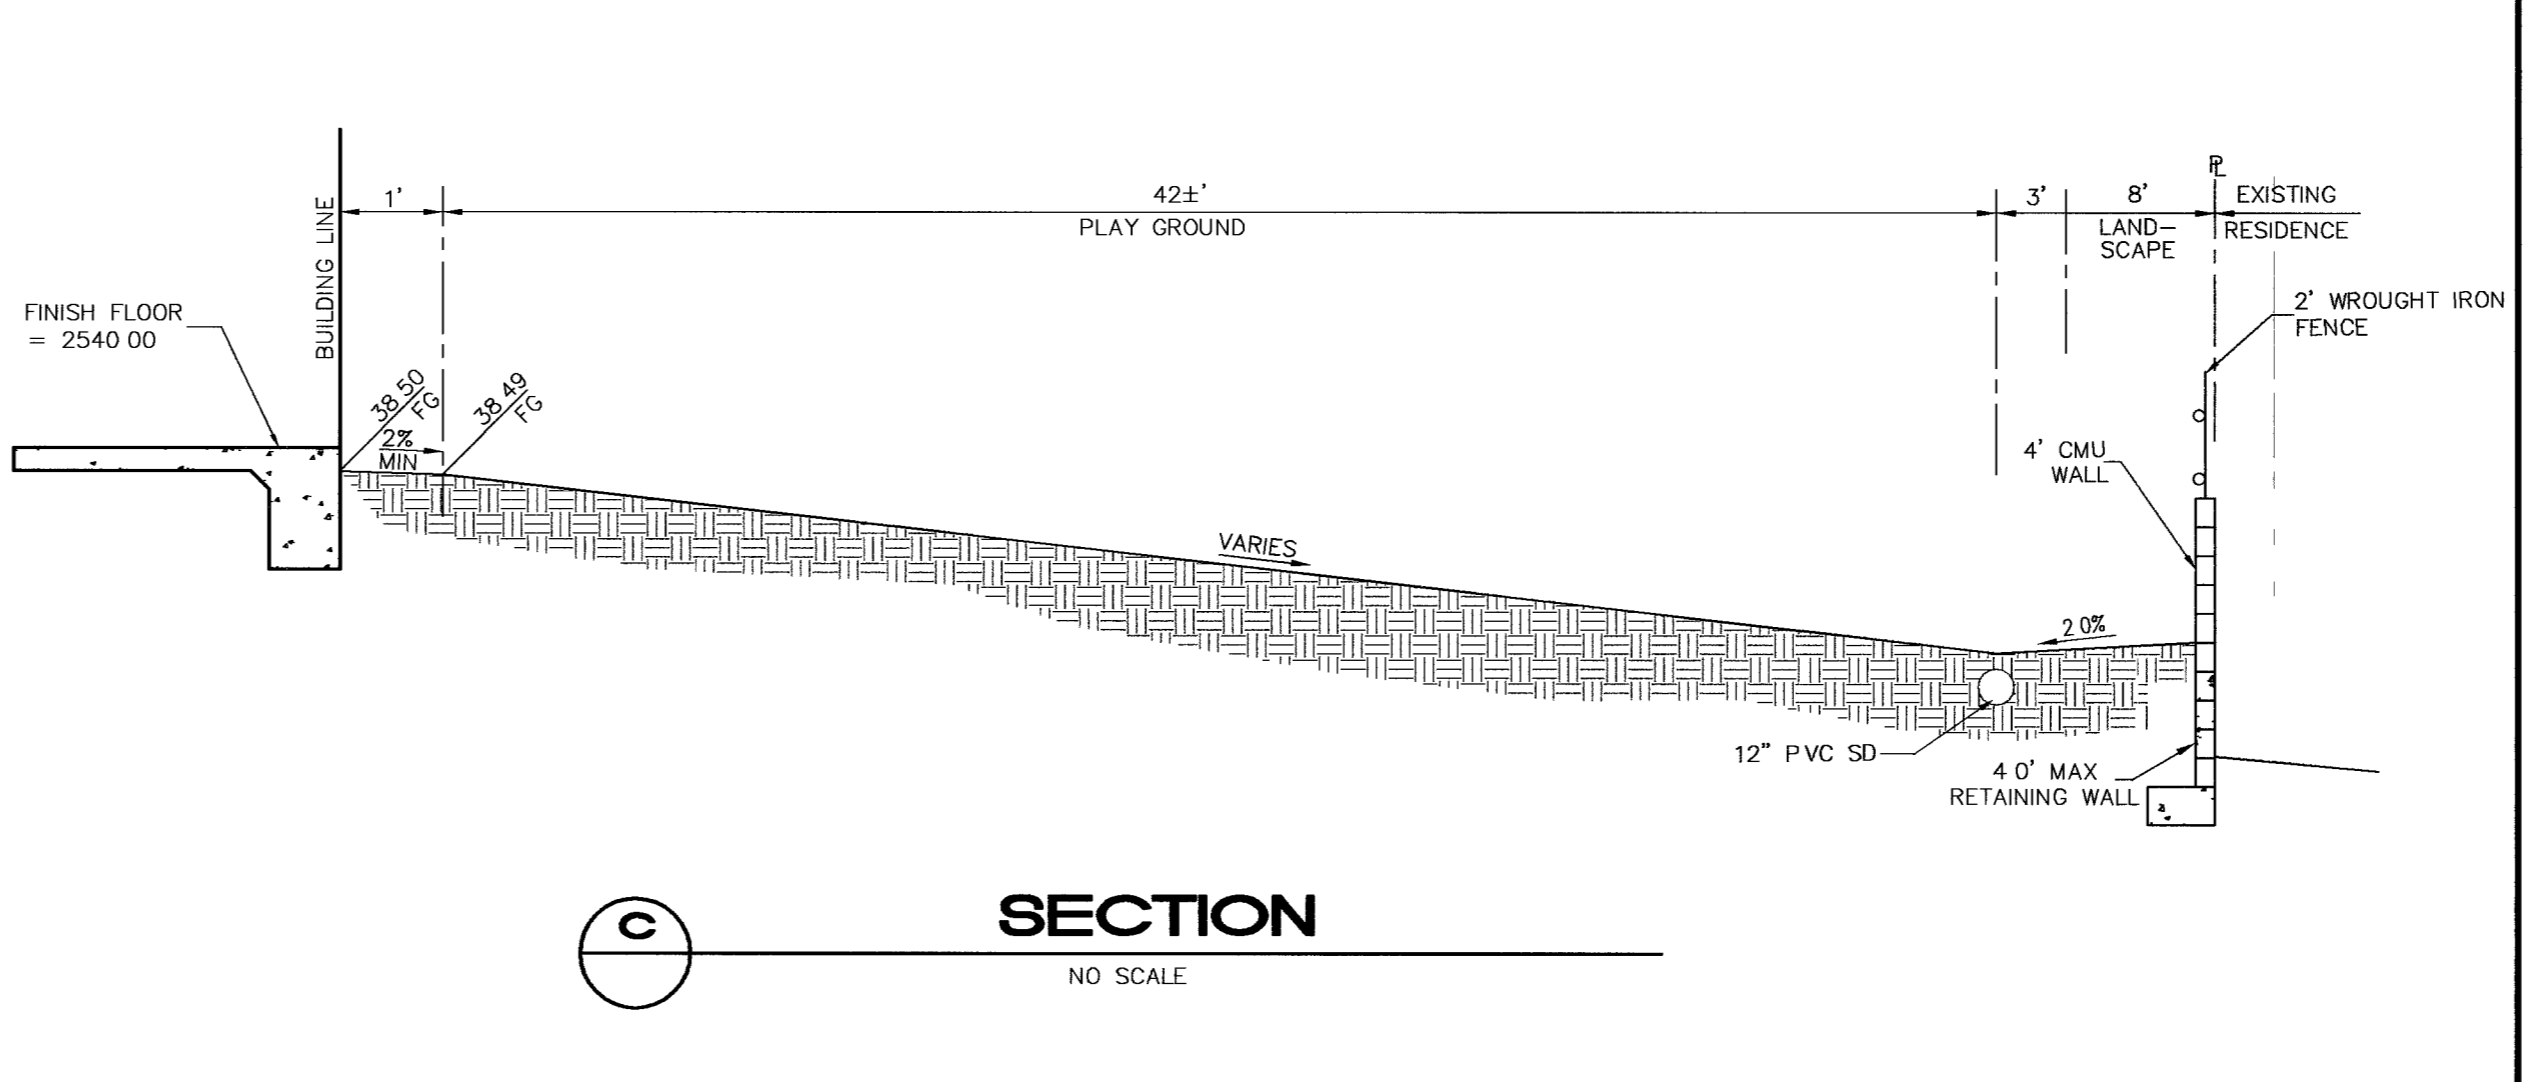


SECTION C
NO SCALE

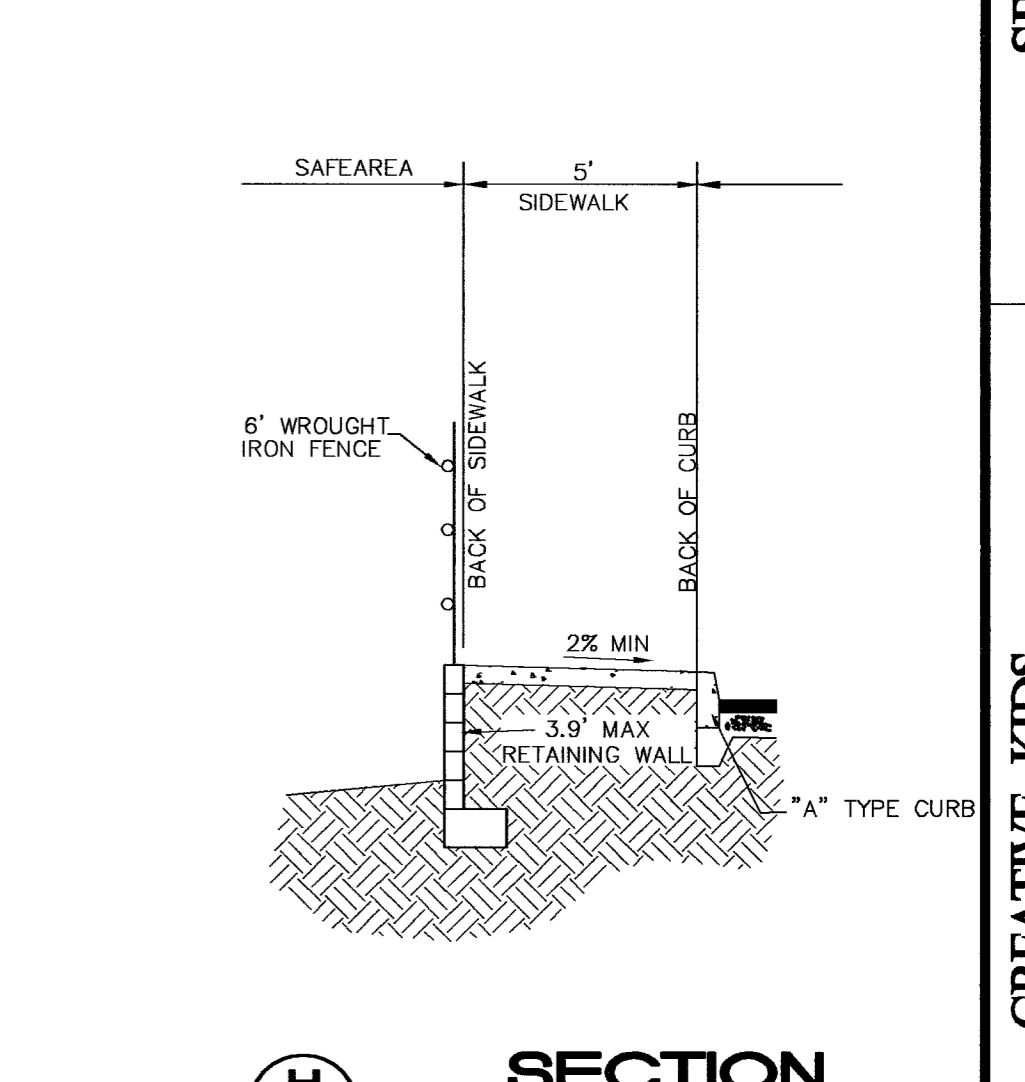


SECTION H
NO SCALE

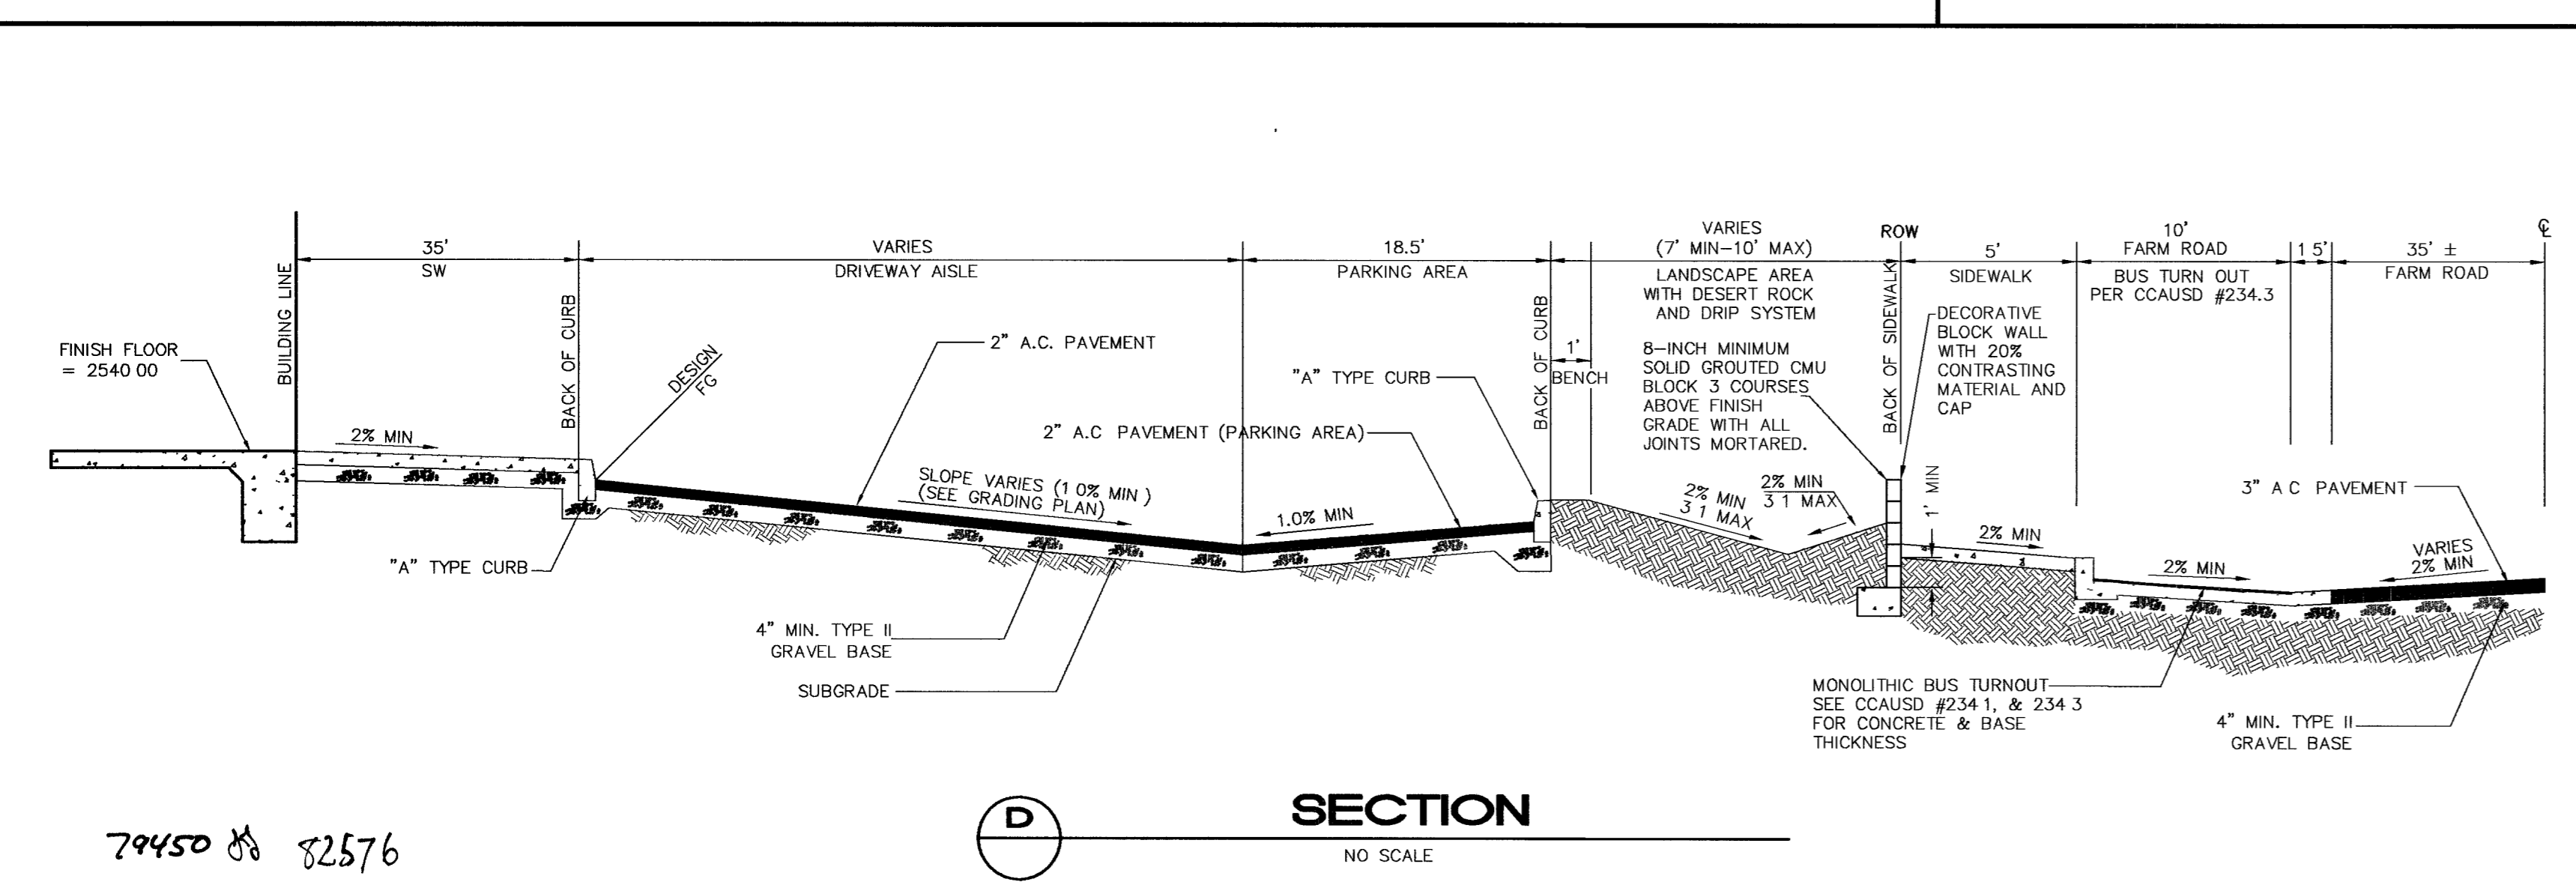


SECTION D
NO SCALE

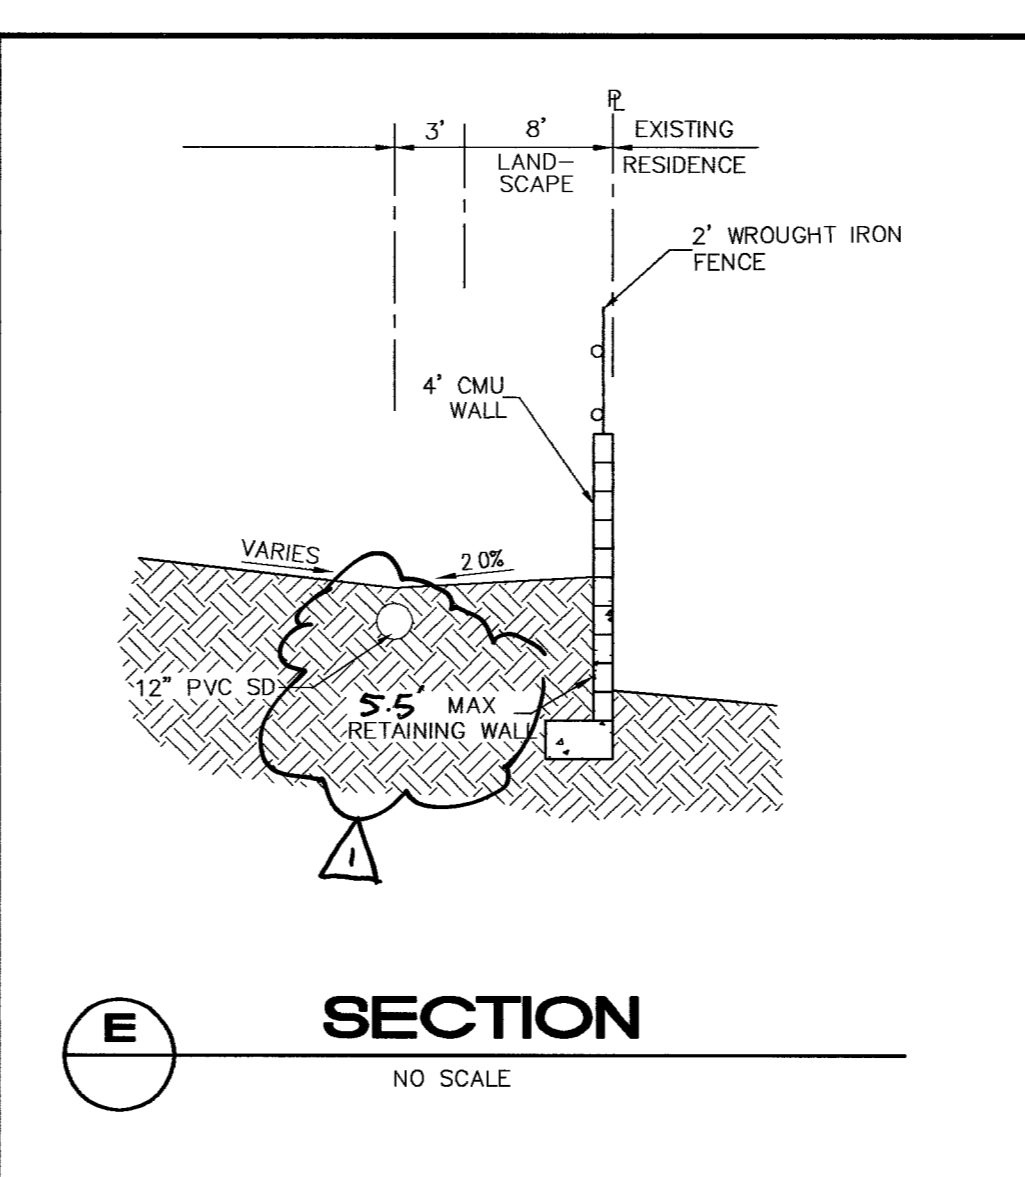

SECTION E
NO SCALE

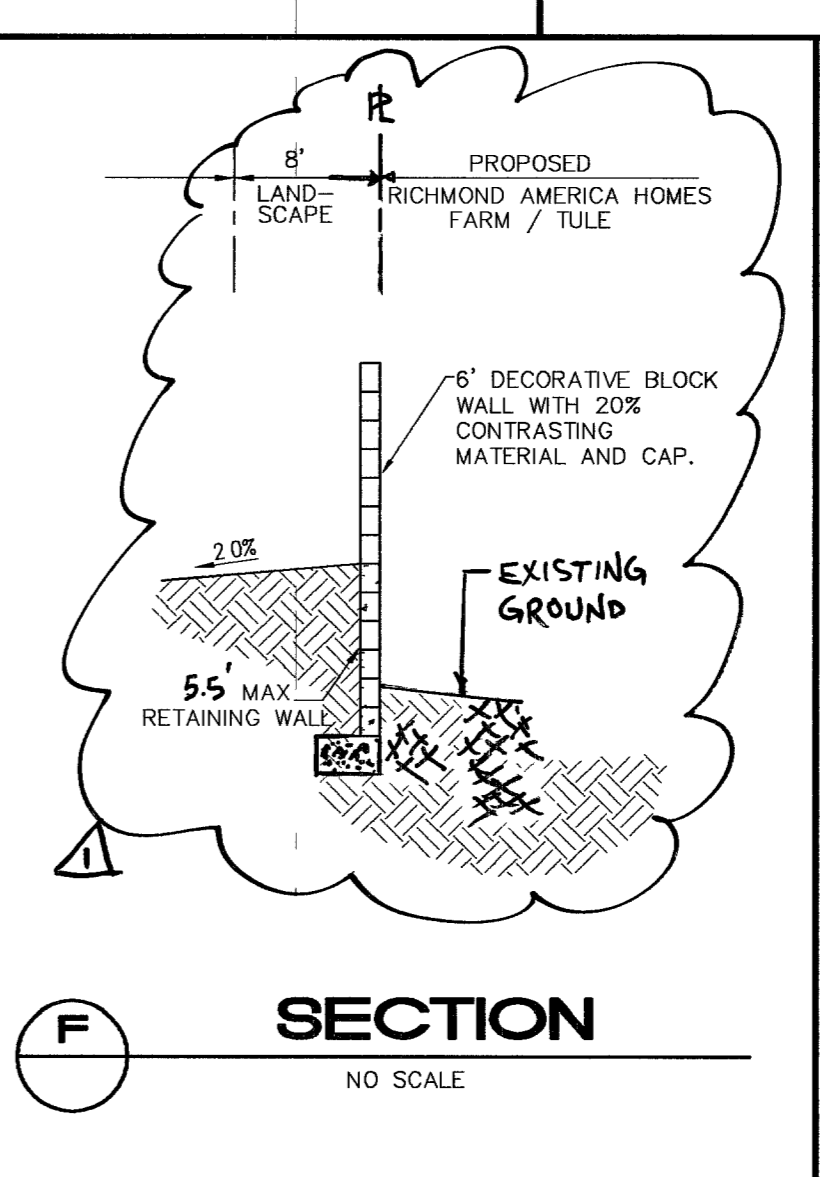

SECTION F
NO SCALE

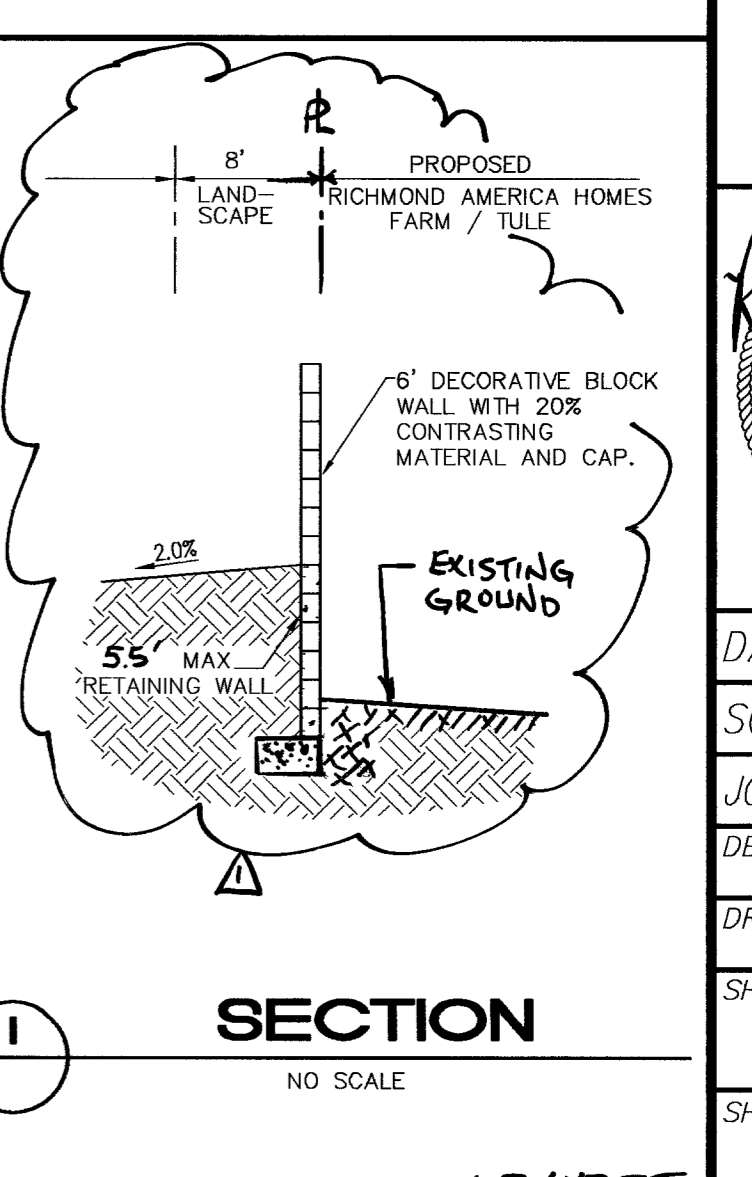

SECTION I
NO SCALE

NO.	DESCRIPTION	DATE	BY	APPR.
1	REV. DETAILS B.E.F.I. TO EUM WALL & HOME WALL Loc.	8-17-06		

SR CONSTRUCTION
3579 RED ROCK STREET
LAS VEGAS, NV 89103
(702) 877-6111 FAX: (702) 258-6326

T. TANNEY ENGINEERING
4448 S. JONES BLVD. SUITE #1
LAS VEGAS, NV 89103
(702) 362-8844 FAX: (702) 362-5233

CREATIVE KIDS AT FARM RD AND TULE SPRINGS RD

GRADING DETAILS & CROSS SECTIONS

ENGINEER'S SEAL
ROBERT D. CUNNINGHAM
Exp. 12-31-06
No. 15726
CIVIL

DATE: 4-20-05
SCALE: NO SCALE
JOB NO: SRC-04-004
DESIGNED BY: BDE
DRAWN BY: BDE
SHEET NAME: GDI
SHEET: 4 OF 8

FILE NAME: SRC0400AMP.DWG

79450 8 82576

107V4355