

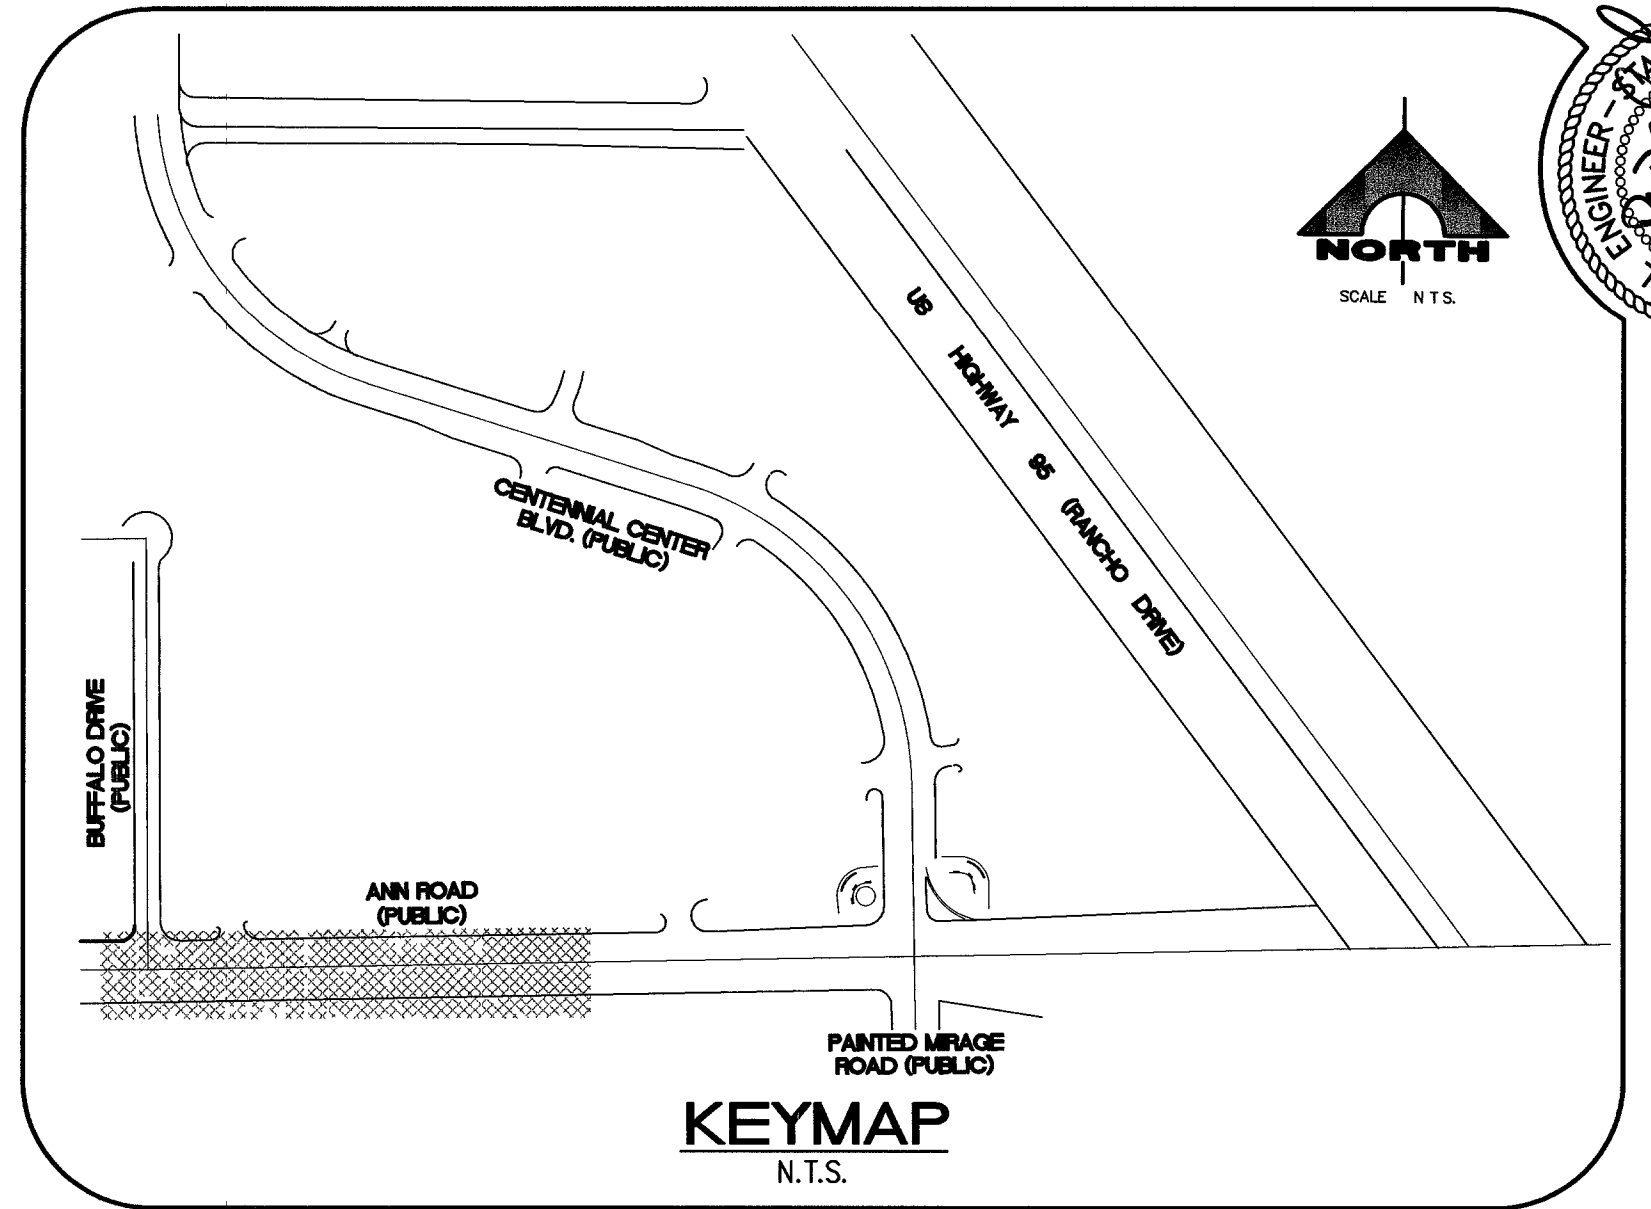
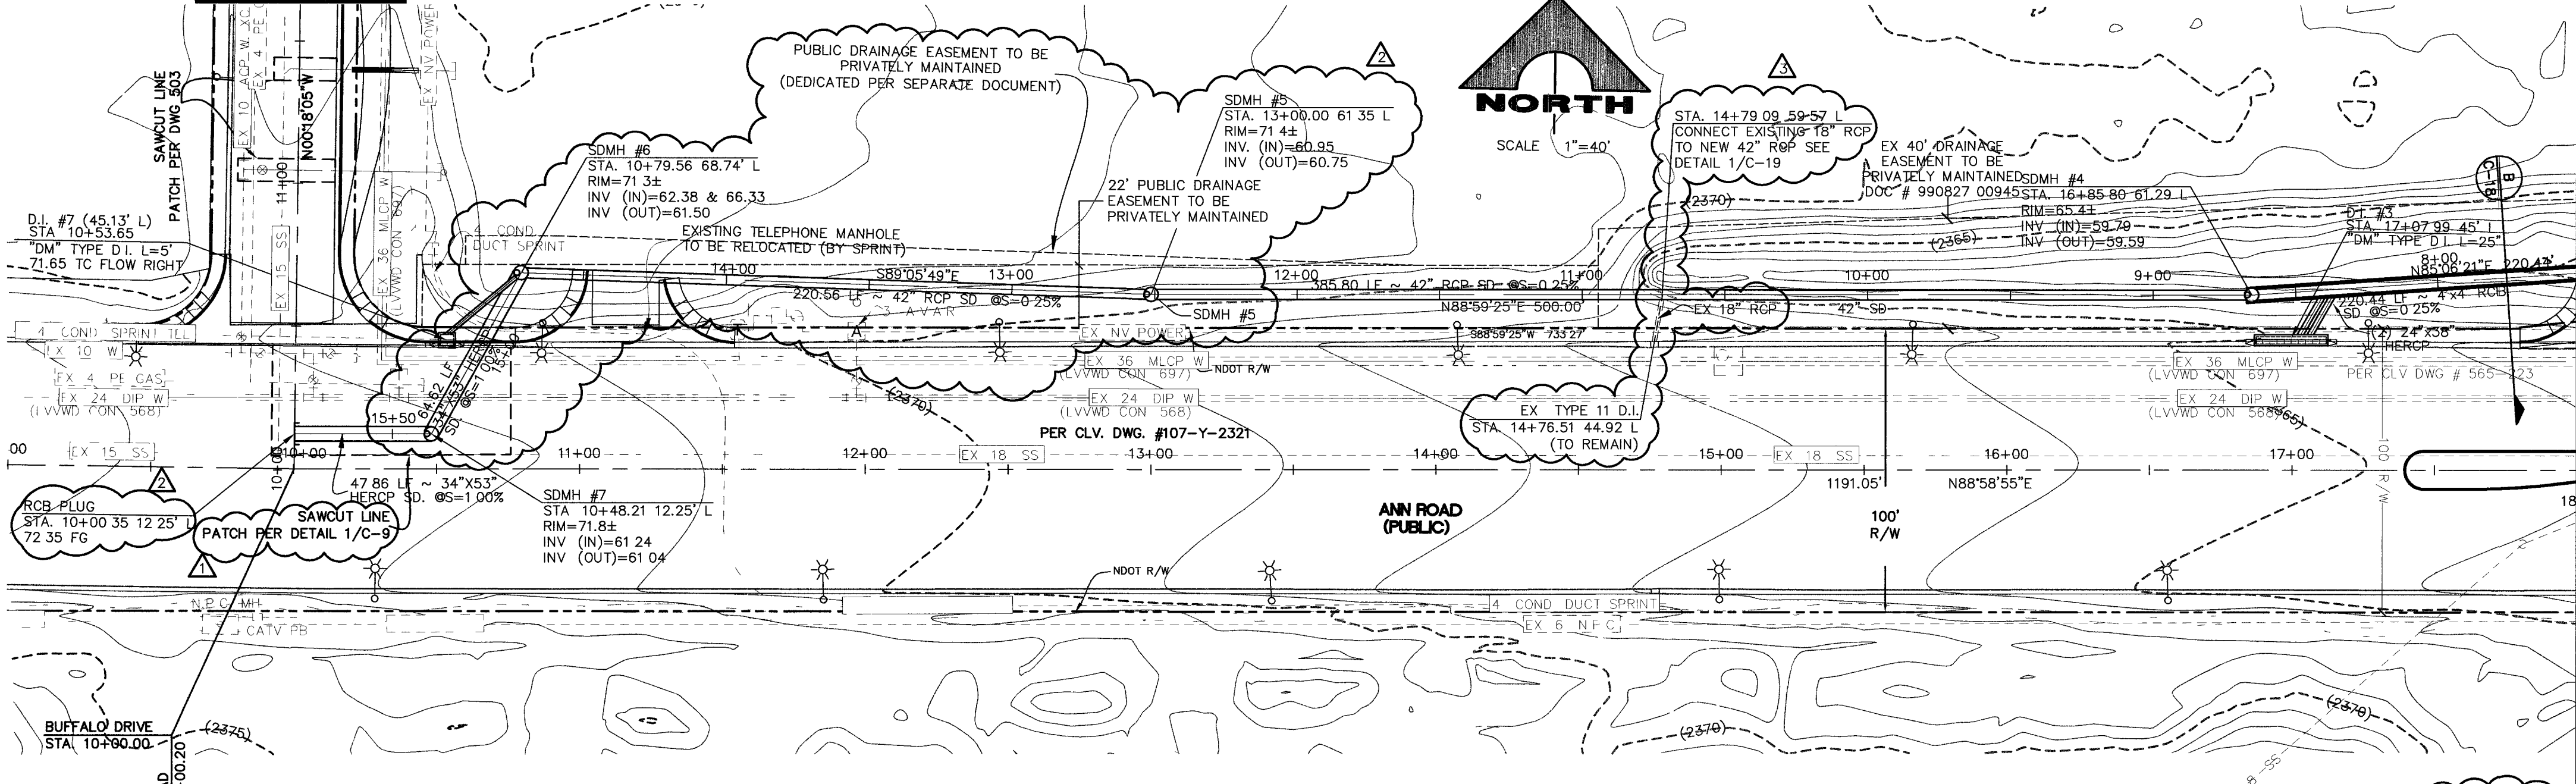
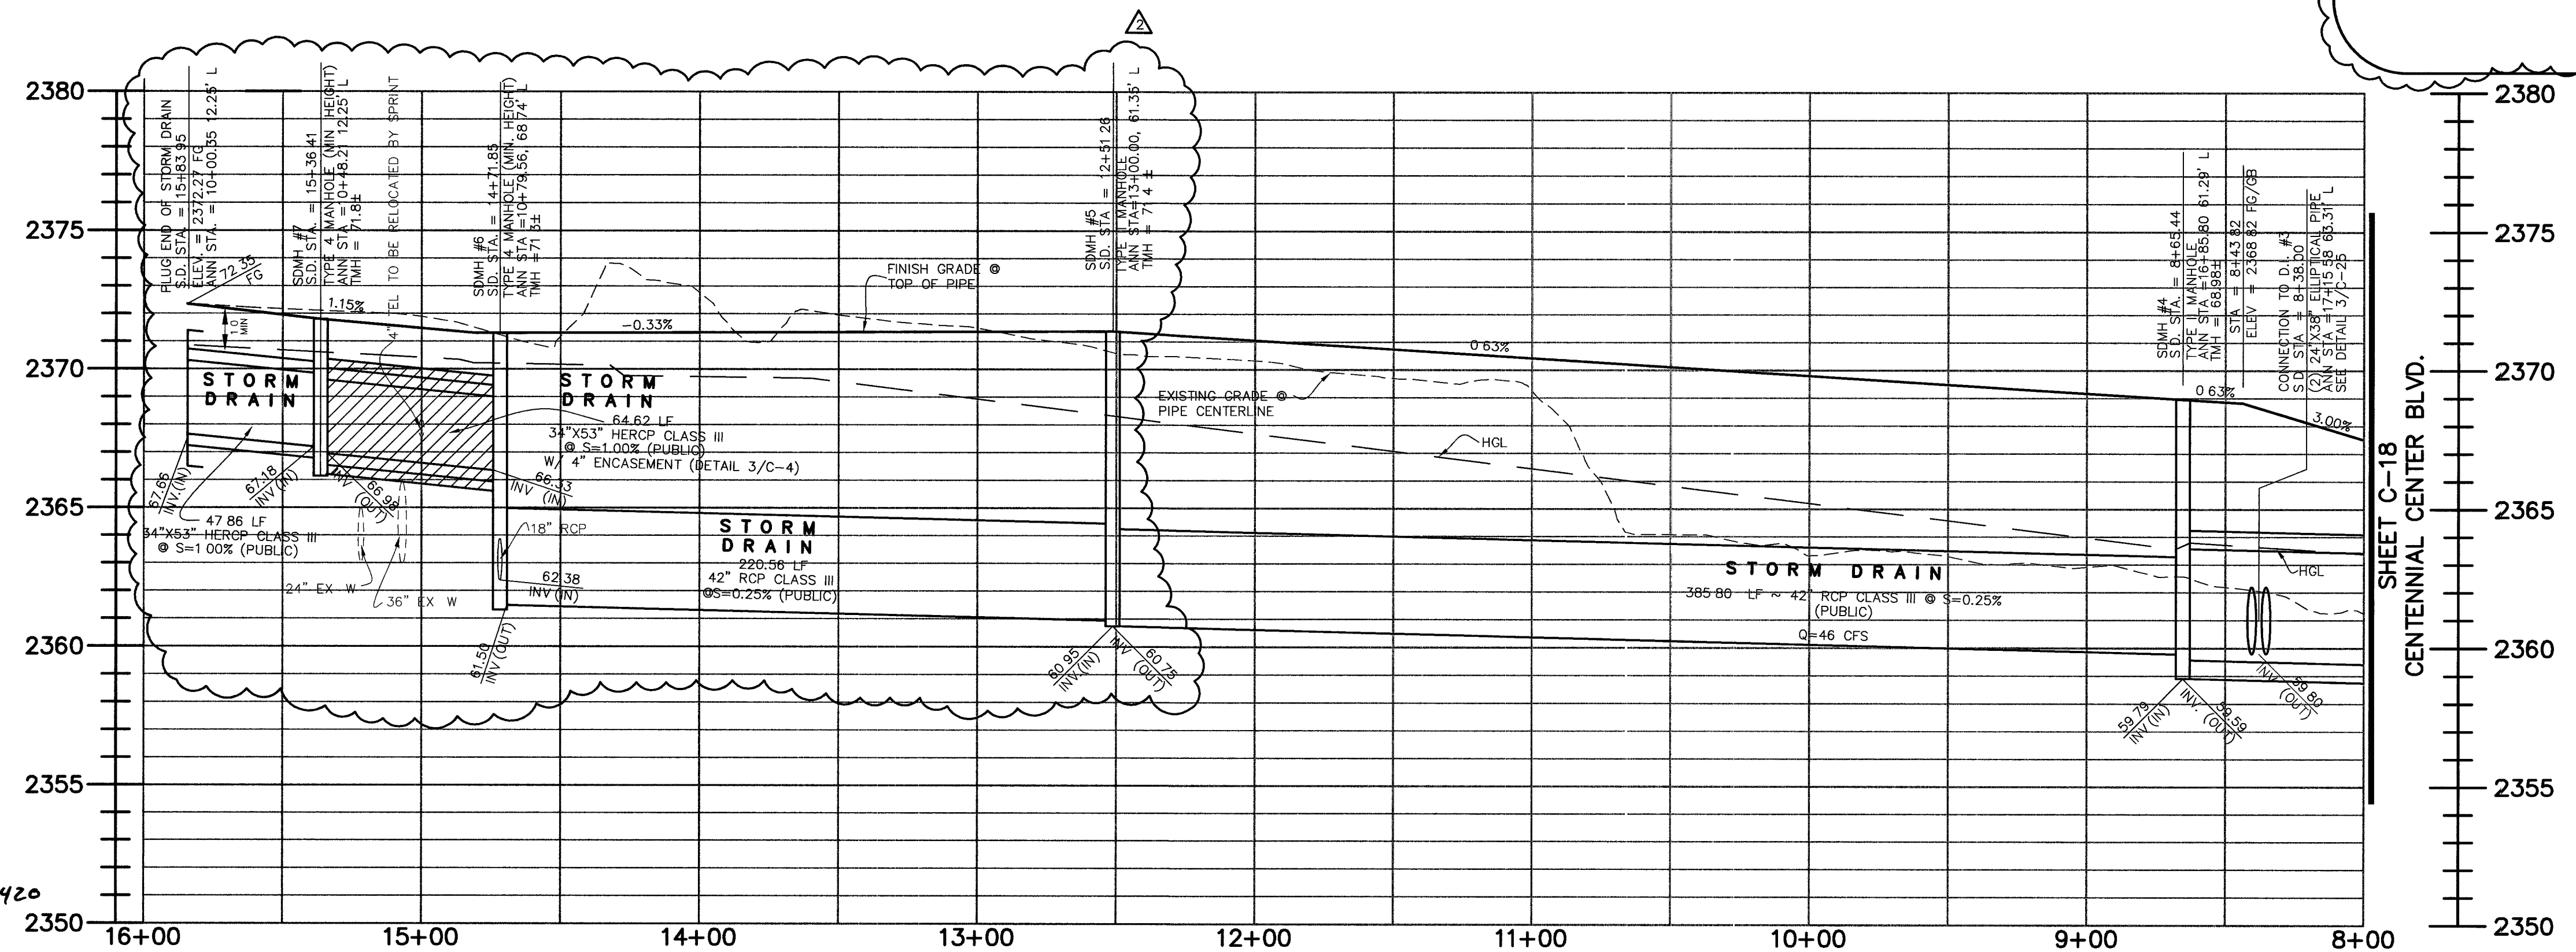
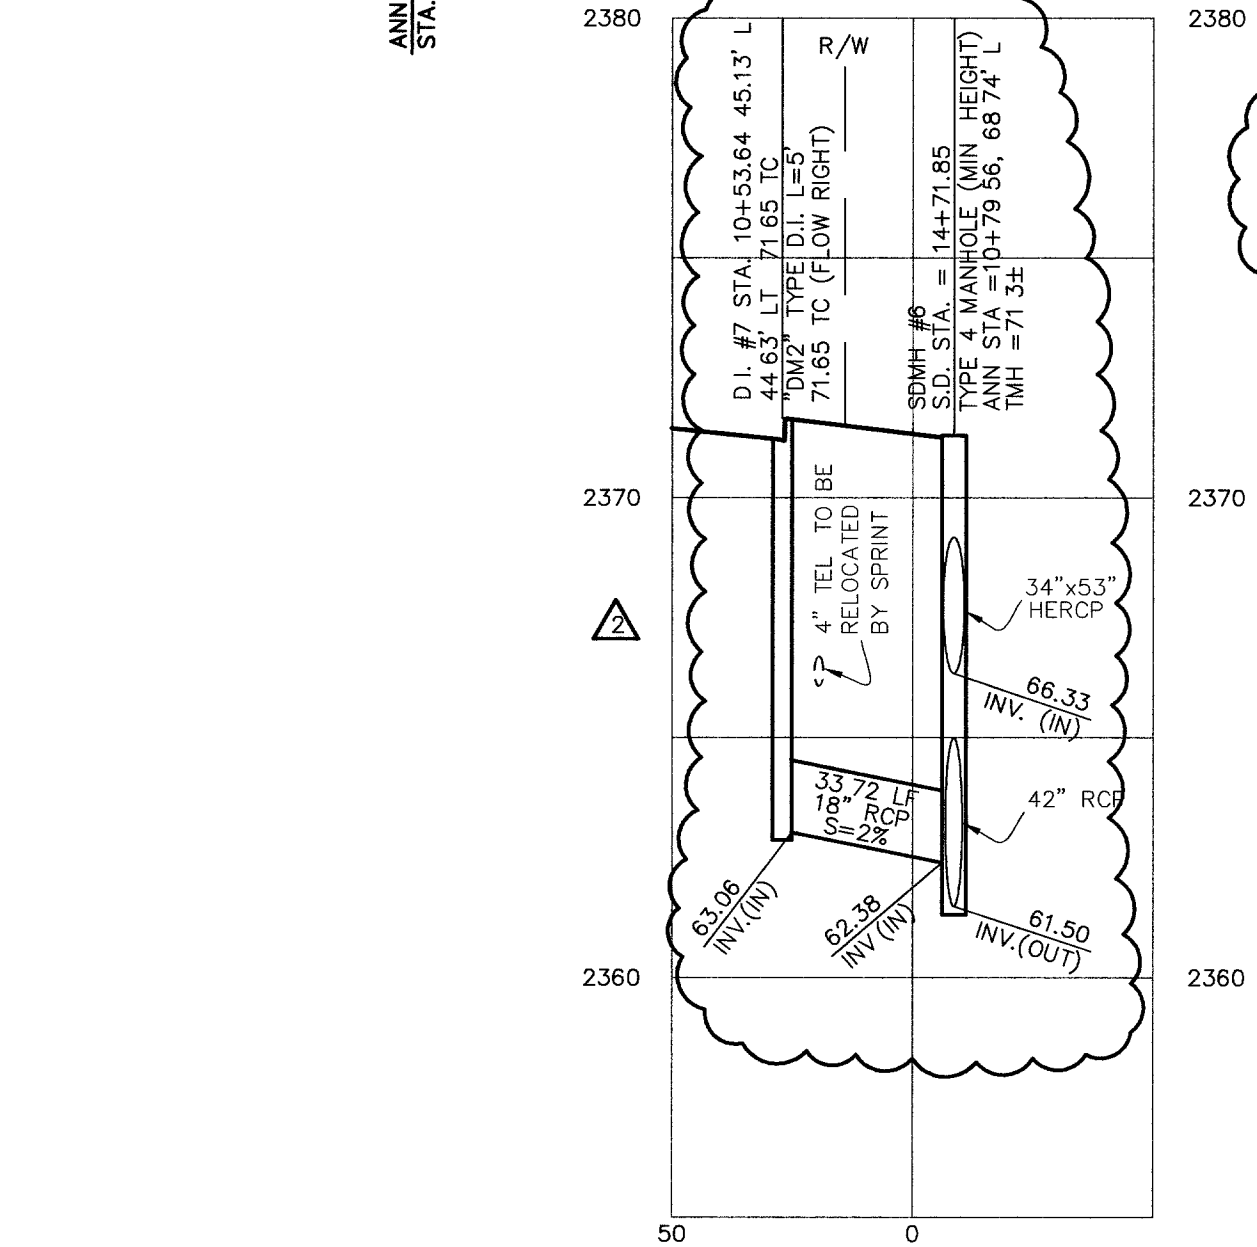


BUFFALO DRIVE
SEE SHEET C-20

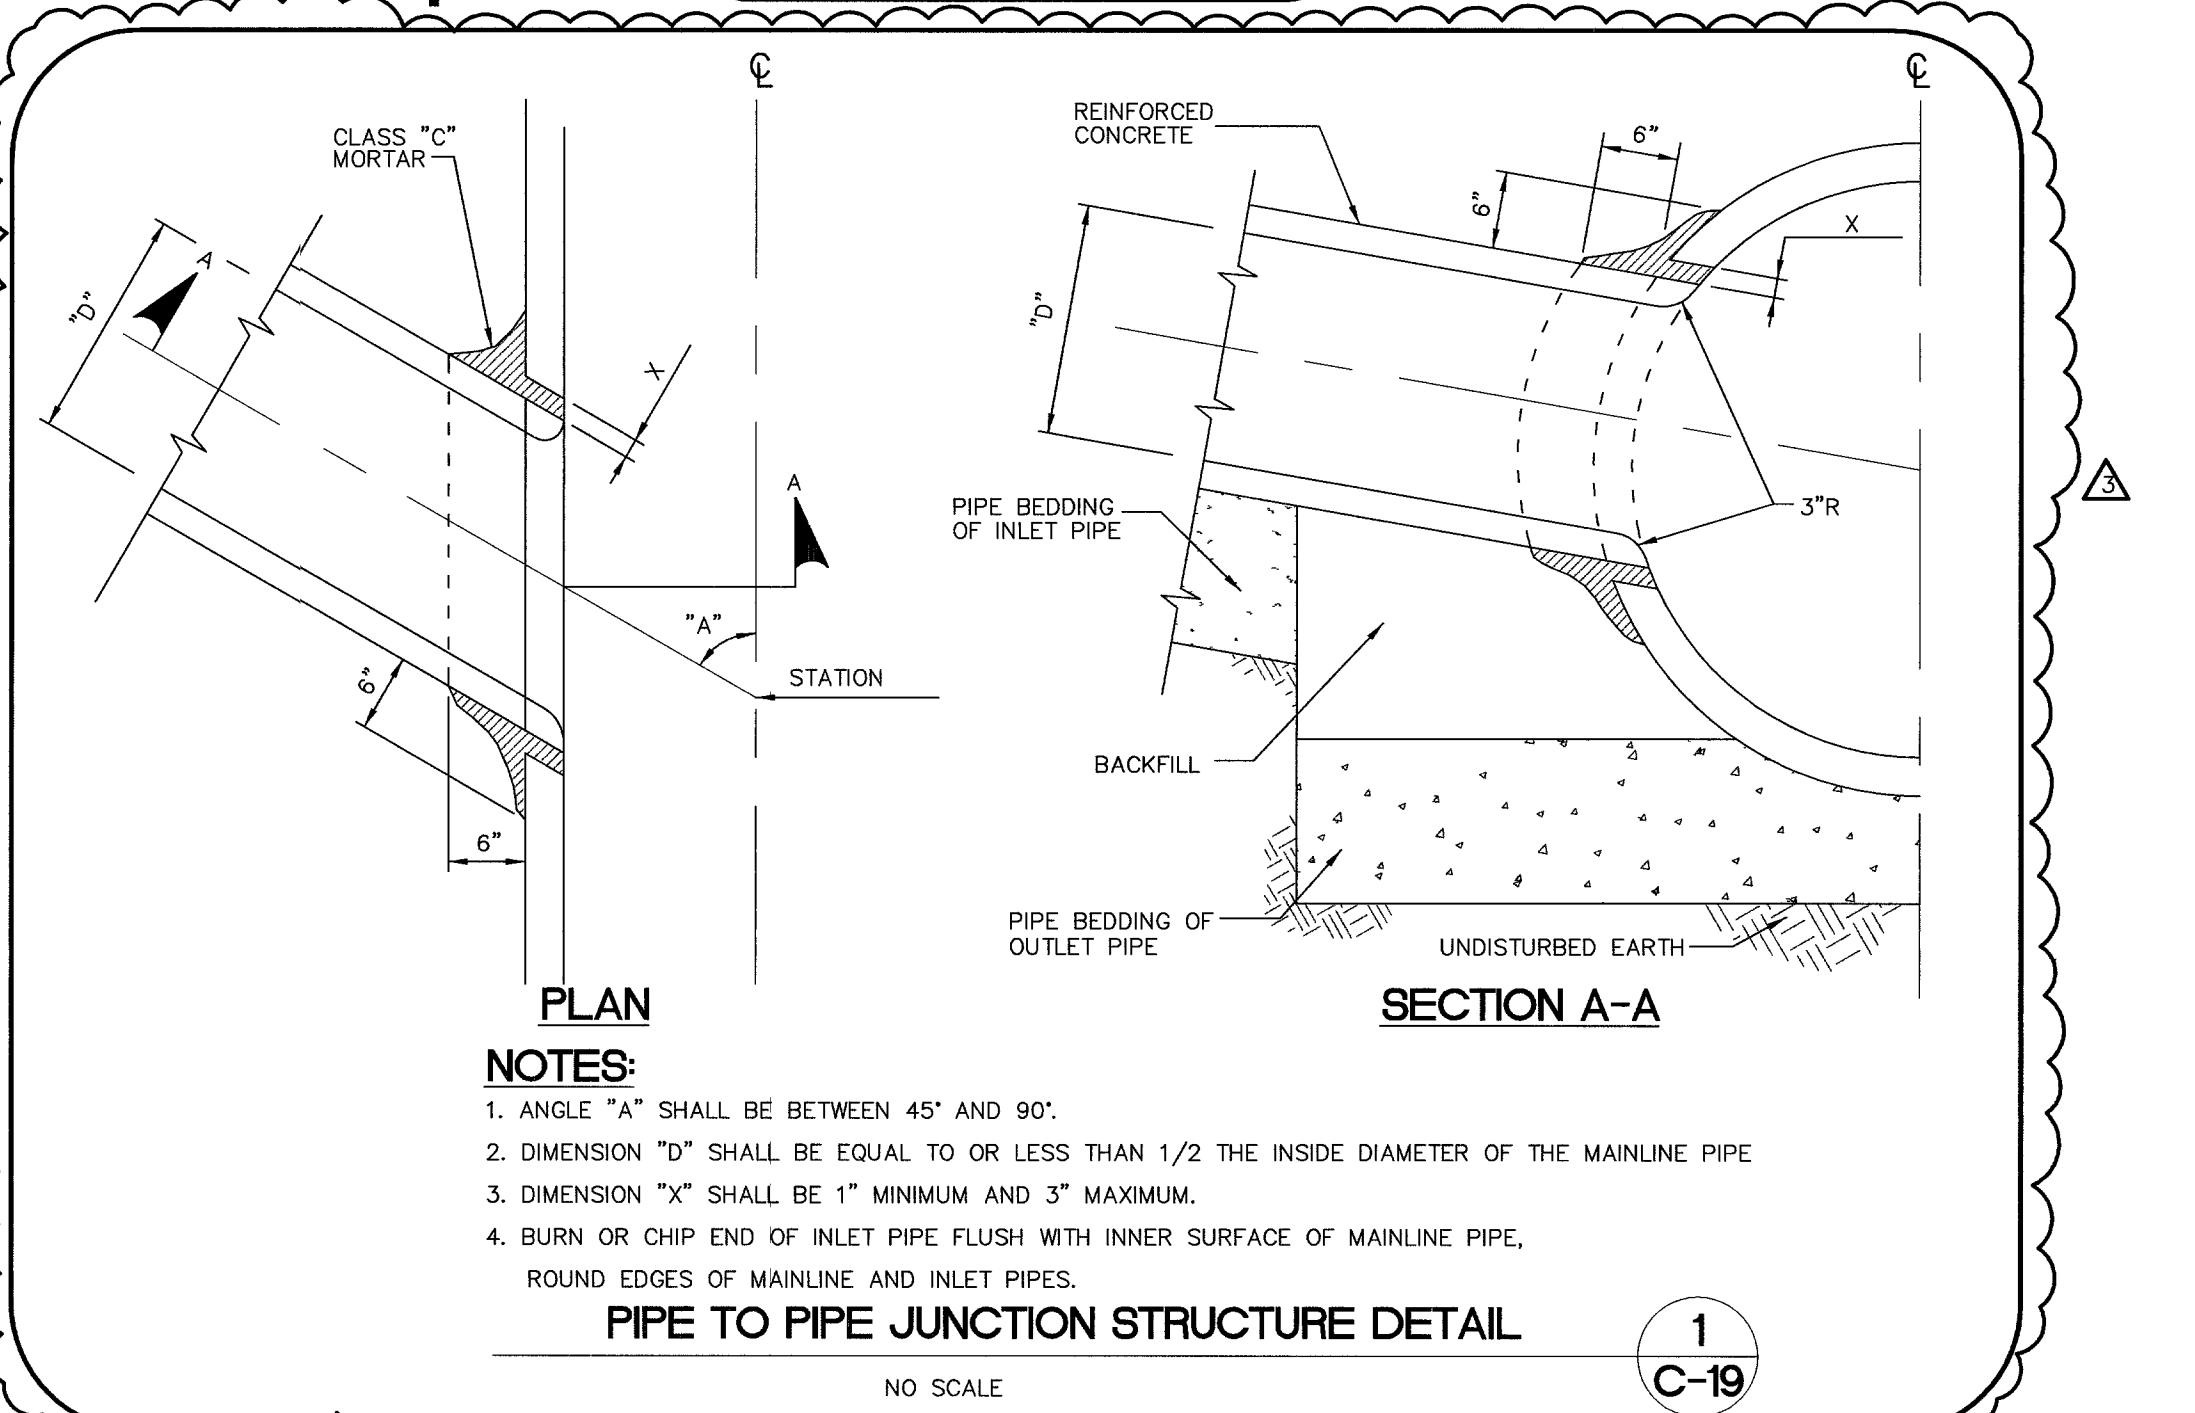

NOTE
NDOT PERMIT IS REQUIRED FOR ALL WORK
LOCATED IN NDOT R/W.

ANN ROAD (PUBLIC)
PLAN AND PROFILE

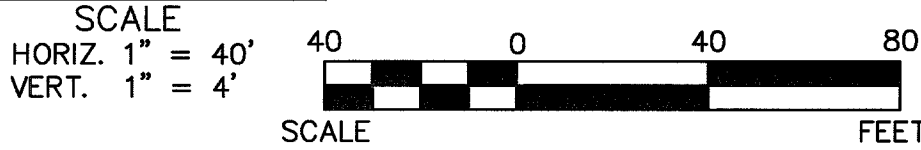

BASIS OF BEARING
NORTH 88°42'47" EAST FROM THE NORTHWEST CORNER OF SECTION 28, TOWNSHIP 19 SOUTH, RANGE 60 EAST, M.D.M., MARKED WITH A 3" BLM BRASS CAP, STAMPED "1956" TO THE NORTH QUARTER CORNER OF SAID SECTION 28, MARKED WITH A 1-1/2" ALUMINUM CAP, PER RECORD MAP OF SURVEY FOR NORTHWEST/WESTERN SEGMENT OF THE LAS VEGAS BELTWAY, RECORDED IN FILE 89, PAGE 3, OF SURVEYS, CLARK COUNTY, NEVADA

PROJECT BENCHMARK:
STATION 1LV90 33NES
RIVET & PLATE IN TOP OF CURB, ANN ROAD & BUFFALO DRIVE, SOUTH CURB LINE
ELEV. = 722.9855 (METERS) NAVD88 DATUM
3 28083333 U.S. SURVEY FEET = 1 METER
ELEVATION = 2371.99 FEET

NOTE:
ADD 0.27 FEET TO CURRENT C.L.V. BENCHMARK
PUBLISHED VALUES TO MATCH PROJECT ELEVATIONS.

CURRENT NAVD 88 VALUES:
722.9855 METERS
2371.99 FEET

Avoid cutting underground utility lines. It's costly.
Call before you Dig.
1-800-227-2600
UNDERGROUND SERVICE (USA)

AVOID HITTING OVERHEAD POWER LINES. IT'S COSTLY.
CALL BEFORE YOU DO OVERHEAD
1-702-227-2929

AVOID HITTING UNDERGROUND POWER LINES. IT'S COSTLY.
CALL BEFORE YOU DO UNDERGROUND
1-702-455-7511
1-702-229-6611
CLV DRAWING #107V-4179

ENGINEER
G. C. WALLACE, INC.
Engineers/Planners/Surveyors
1555 SOUTH HAWGOW BLVD., LAS VEGAS, NEVADA 89146
TEL: (702) 804-7229
FAX: (702) 804-7229
G:\1822-0033.dwg IMPROV-GT-SITE REVISION 4 C-19/05/09 DWG

DESIGN
DRAWN: []
CHECK: []
ISSUE DATE: []
PLOT DATE: 08-24-05
PLOT TIME: 08:20:32

REVISION

DATE **ASGN** **APP** **DATE** **CSW** **APP**

19 OF 28 SHTS