


CONTRACTOR NOTE
 CONTRACTOR SHALL VERIFY HORIZONTAL AND VERTICAL LOCATION OF EXISTING UTILITIES AND NOTIFY THE DESIGN ENGINEER IMMEDIATELY OF ANY DISCREPANCIES PRIOR TO CONSTRUCTION.

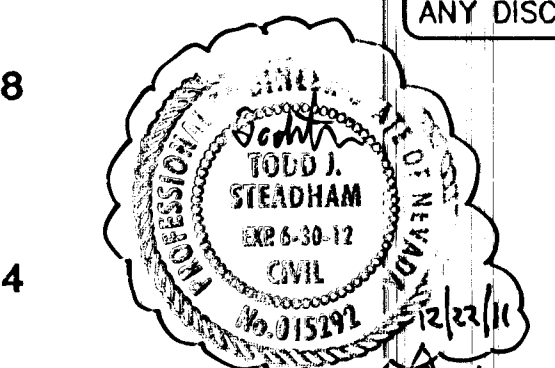

I CERTIFY THAT THIS PLAN IS IN CONFORMANCE WITH THE APPROVED DRAINAGE STUDY ON FILE AT CITY OF LAS VEGAS FOR THIS PROJECT. PROJECT NO. 15-3617
 DANIEL J. HOOD NO. 12811 DATE 12-14-05

CLARK COUNTY DEPARTMENT OF DEVELOPMENT SERVICES
 Acceptance of plans for filing
 By *Josh B. Brown* 12-14-05
 Acceptance of these plans for filing shall not be construed to be a permit for or an approval of any violation of any of the provisions of the state or county laws and/or specifications. Clark County shall be held free from damages which may result from the construction of the improvements from the engineering design depicted herein.
 NOTE: Power poles and/or other existing facilities not in proper location based on proposed improvements shown herein will be re-located at no expense to Clark County.

Call before you Dig
 1-702-455-7511
 CLARK COUNTY TRAFFIC OPERATIONS
 1-702-229-6611
 FREEWAY AND ARTERIAL SYSTEM OF TRANSPORTATION

Call before you Overhead
 1-800-227-2600
 1-702-227-2929

BASIS OF BEARINGS
 THE BASIS OF BEARINGS FOR THIS PROJECT IS NORTH 00°08'16" EAST BEING THE EAST LINE OF THE NORTHWEST QUARTER (NE 1/4) OF THE SECTION 24, TOWNSHIP 19 SOUTH, RANGE 59 EAST, M.D.M., CLARK COUNTY, NEVADA, AS SHOWN ON A RECORD OF SURVEY ON FILE IN THE CLARK COUNTY, NEVADA, RECORDER'S OFFICE IN FILE 123 AT PAGE 32.

PROJECT BENCHMARK
 PROJECT DATUM: NORTH AMERICAN VERTICAL DATUM OF 1988 (NAVD88)
 CLARK COUNTY VERTICAL CONTROL: 1000-6N6
 NAVD88 ELEVATION: 787.794 METERS (2584.62 FEET)

RIVET AND SQUARE ALUMINUM PLATE IN A CONCRETE CYLINDER, LOCATED 25' SOUTH & 50' EAST OF GRAND CANYON DRIVE AND RED COACH AVENUE, 1' WEST OF ELECTRICAL VAULT.

CITY OF LAS VEGAS BENCHMARK
 DATUM: NORTH AMERICAN VERTICAL DATUM OF 1988 (NAVD88)
 CITY OF LAS VEGAS BENCHMARK: BLV99-13SES
 NAVD88 ELEVATION: 889.606 METERS (2918.03 FEET)

RIVET AND PLATE IN CONCRETE CYLINDER NW CORNER OF HUALAPAI AND ELKHORN

NOTE: ADD 0.34' ABOVE CITY OF LAS VEGAS BENCHMARK BLV99-13SES TO MATCH ORIGINAL PROJECT BENCHMARK, CLARK COUNTY BENCHMARK 1000-6N6 (2584.62 FEET) AS SHOWN ON RECORD OF SURVEY FILE 124 PAGE 34.

CLIFFS EDGE LLC 3000 S. SANDS BLVD., SUITE 280 LAS VEGAS, NEVADA 89128 (702) 771-1211		CITY OF LAS VEGAS, NEVADA 2727 SOUTH RAINBOW BOULEVARD LAS VEGAS, NEVADA 89146-5148 PH. (702) 873-7550 FAX (702) 382-2897	
STORM DRAIN PLAN & PROFILE PULI ROAD STA. 10+20.00 TO 18+50.00		CLIFFS EDGE / PROVIDENCE PULI ROAD - PHASE I	
DRAWN BY: N.A.	JULY_04	DESIGNED BY: N.H.	JULY_04
CHECKED BY: D.J.H.	JULY_04	PROJECT NO.:	5868
EXPIRES 06-30-07		SCALE: 1"=40' HORIZ. 1"=4' VERT.	
PROFESSIONAL ENGINEER STATE OF NEVADA DANIEL J. HOOD NO. 12811 CIVIL		SHEET SD1 16 OF 40 SHEETS	
DRAWING NO. 1574216-1B-1		DATE 12/14/05	

85733 2012-224

HTE# 05-42792