


CONTRACTOR NOTE:
 CONTRACTOR SHALL VERIFY HORIZONTAL AND VERTICAL LOCATION OF EXISTING UTILITIES AND NOTIFY THE DESIGN ENGINEER IMMEDIATELY OF ANY DISCREPANCIES PRIOR TO CONSTRUCTION.

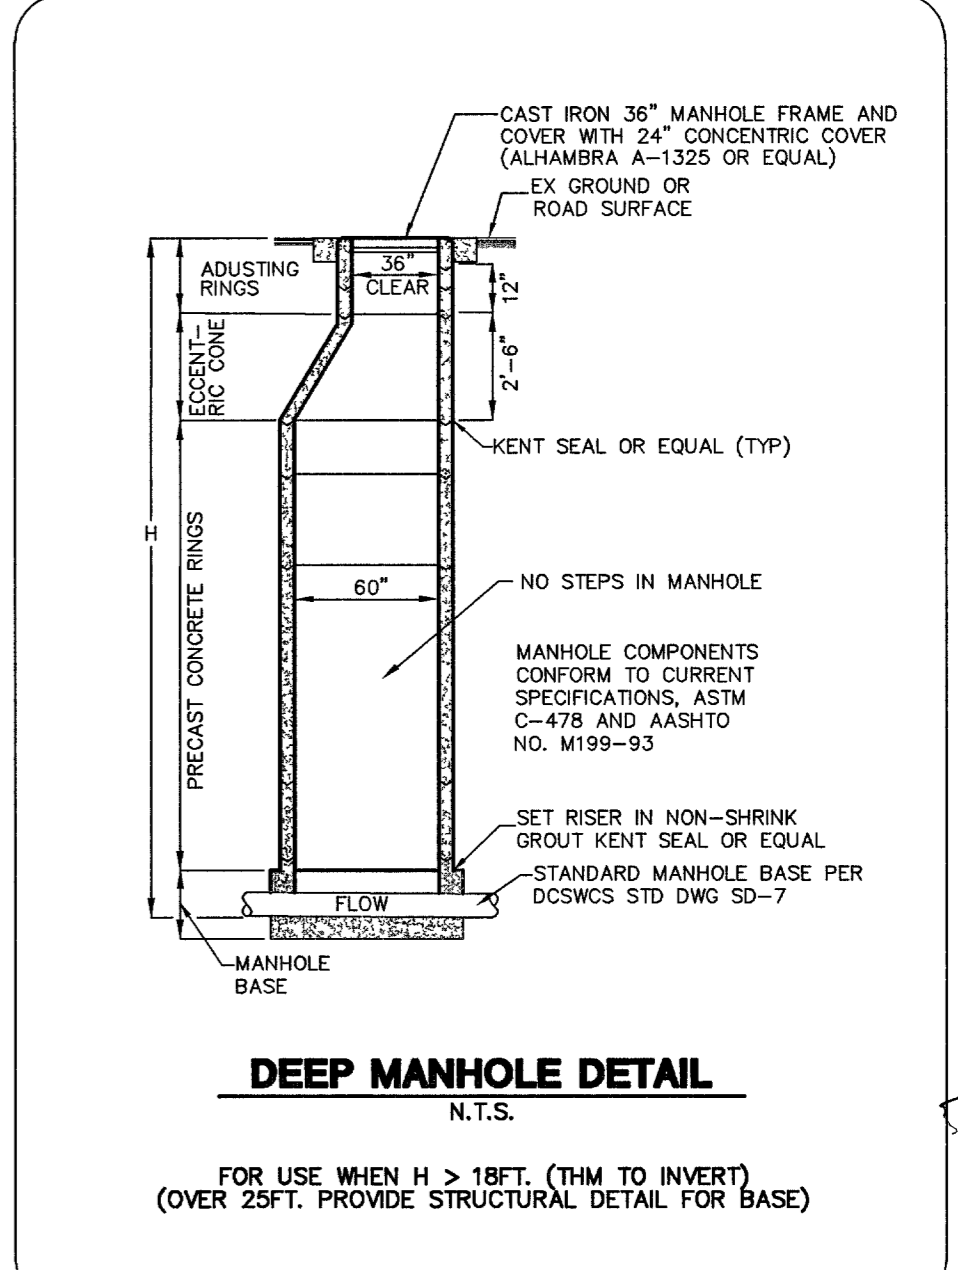

BASIS OF BEARINGS
 THE BASIS OF BEARINGS FOR THIS PROJECT IS NORTH 00°08'16" EAST BEING THE EAST LINE OF THE NORTHWEST QUARTER (NE 1/4) OF THE SECTION 24, TOWNSHIP 19 SOUTH, RANGE 59 EAST, M.D.M., CLARK COUNTY, NEVADA, AS SHOWN ON A RECORD OF SURVEY ON FILE IN THE CLARK COUNTY, NEVADA, RECORDER'S OFFICE IN FILE 123 AT PAGE 32.

PROJECT BENCHMARK
 PROJECT DATUM: NORTH AMERICAN VERTICAL DATUM OF 1988 (NAVD88)
 CLARK COUNTY VERTICAL CONTROL: 1000-6N6
 NAVD88 ELEVATION: 787.794 METERS (2584.62 FEET)

RIVET & SQUARE ALUMINUM PLATE IN 6" CONCRETE CYLINDER, LOCATED 25' SOUTH AND 50' EAST OF GRAND CANYON DRIVE AND RED COACH AVENUE, 1' WEST OF ELECTRICAL VAULT.

CITY OF LAS VEGAS BENCHMARK
 DATUM: NORTH AMERICAN VERTICAL DATUM OF 1988 (NAVD88)
 CITY OF LAS VEGAS BENCHMARK: BLV99-13SES
 NAVD88 ELEVATION: 869.806 METERS (2853.03 FEET)


RIVET AND PLATE IN CONCRETE CYLINDER NW CORNER OF HUALAPAI AND ELKHORN

NOTE: ADD 0.34' TO ABOVE CITY OF LAS VEGAS BENCHMARK BLV99-13SES TO MATCH ORIGINAL PROJECT BENCHMARK, CLARK COUNTY BENCHMARK 1000-6N6 (2584.62 FEET) AS SHOWN ON RECORD OF SURVEY FILE 124 PAGE 94.

Call before you Dig
 1-702-455-7511
 CLARK COUNTY TRAFFIC OPERATIONS
 1-702-229-6611
 LAS VEGAS AREA COMPUTERIZED TRAFFIC SYSTEM

Avoid cutting underground utility lines it's costly.
Call before you Dig
 1-800-227-2600

Avoid overhead power line contact it's costly.
Call before you Overhead
 1-702-593-6111

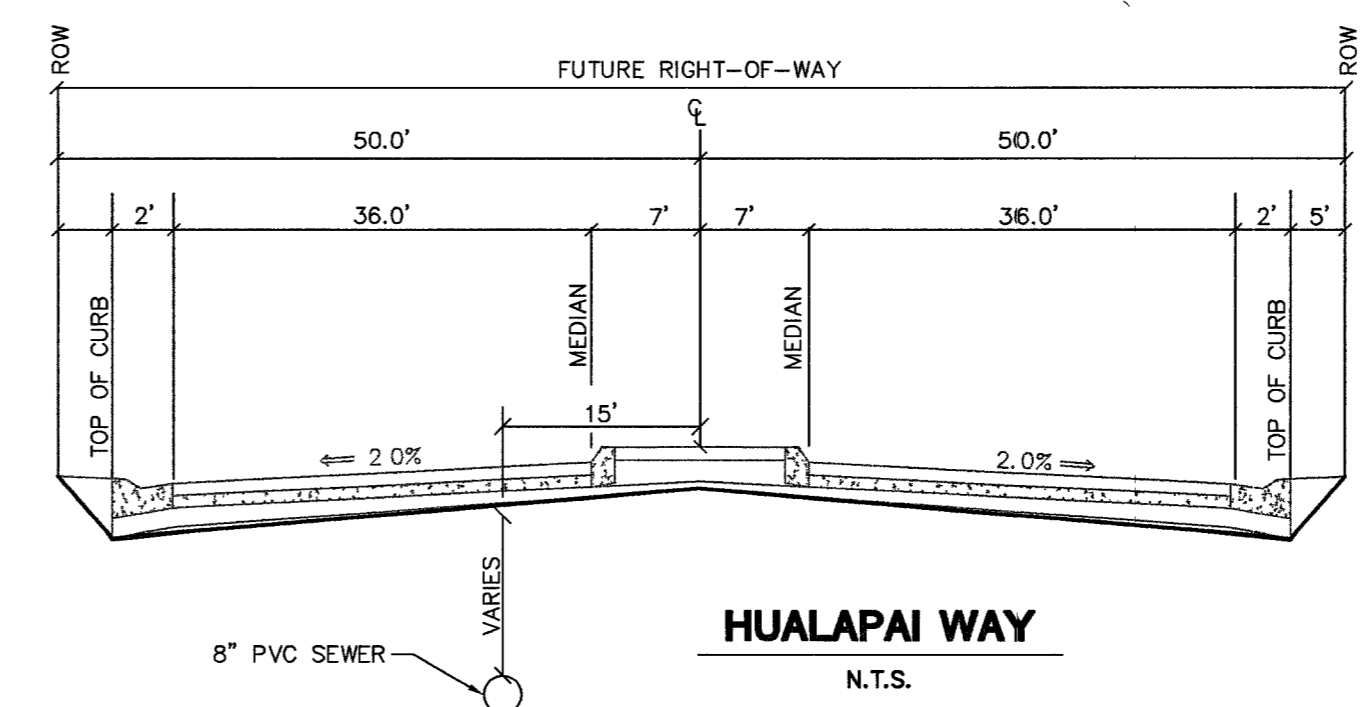

CLIFFS EDGE LLC 3455 CLIFF SHADOWS PARKWAY, SUITE 280 LAS VEGAS, NEVADA 89129 (702) 771-1221	CITY OF LAS VEGAS, NEVADA	SEWER PLAN AND PROFILE HUALAPAI WAY STA 32+89.34 TO 23+50.00	CLIFFS EDGE / PROVIDENCE FARM ROAD SEWER IMPROVEMENTS	REVISION NO. DATE BY 1 12/15/21 L.A.M. REVISE TO RAISE SEWER 2 1/2/22 J.P. REVISE TO RAISE SEWER
DRAWN BY: MARCH '04 DESIGNED BY: MARCH '04 CHECKED BY: MARCH '04 PROJECT NO.: 5959		SCALE: 1"=40' HORIZ. 1"=4' VERT.		EXPIRES 06-30-05
SHEET 11 OF 13 SHEETS DRAWING NO. 1074-4816-03-7			17/1/20 REVISION	