GENERAL TRAFFIC NOTES

1. SEE GENERAL NOTES ON COVER SHEET.
2. EXISTING MARKINGS IN CONFLICT WITH PROPOSED MARKINGS SHALL BE REMOVED BY METHODS APPROVED BY THE ENGINEER.
3. IF THE IMPROVEMENTS NECESSITATE THE OBLITERATION, TEMPORARY OBSTRUCTION, TEMPORARY REMOVAL OR RELOCATION OF ANY EXISTING TRAFFIC MARKINGS, SUCH MARKINGS SHALL BE RESTORED OR REPLACED WITH LIKE MATERIALS TO THE SATISFACTION OF THE ENGINEER.
4. EXISTING SIGNS NOT SHOWN SHALL REMAIN IN PLACE.
5. ALL EXISTING TRAFFIC SIGNS TO BE REMOVED SHALL BE SALVAGED BY THE CONTRACTOR AND DELIVERED TO 3104 E. BONANZA RD.

CONSTRUCTION NOTES

1. 24-INCH STOP LINE (PAVEMENT MARKING FILM – TYPE I)
2. WHITE PAVEMENT ARROW (PAVEMENT MARKING FILM – TYPE I)
3. WHITE PAVEMENT "ONLY" (PAVEMENT MARKING FILM – TYPE I)
4. STORAGE LANE LINE (STD DWG NO. 246) (RAISED PAVEMENT MARKINGS)
5. REMOVE EXISTING MARKINGS
6. CAT TRACKS (NDOT STD. PLAN T-37.1.2)
7. 3/4" COLD MILL AND REPLACE 3/4" OPEN GRADE TO REMOVE EXISTING MARKINGS.

(E) EXISTING SIGN(S) TO REMAIN

3/4" COLD MILL AND REPLACE 3/4" OPEN GRADE

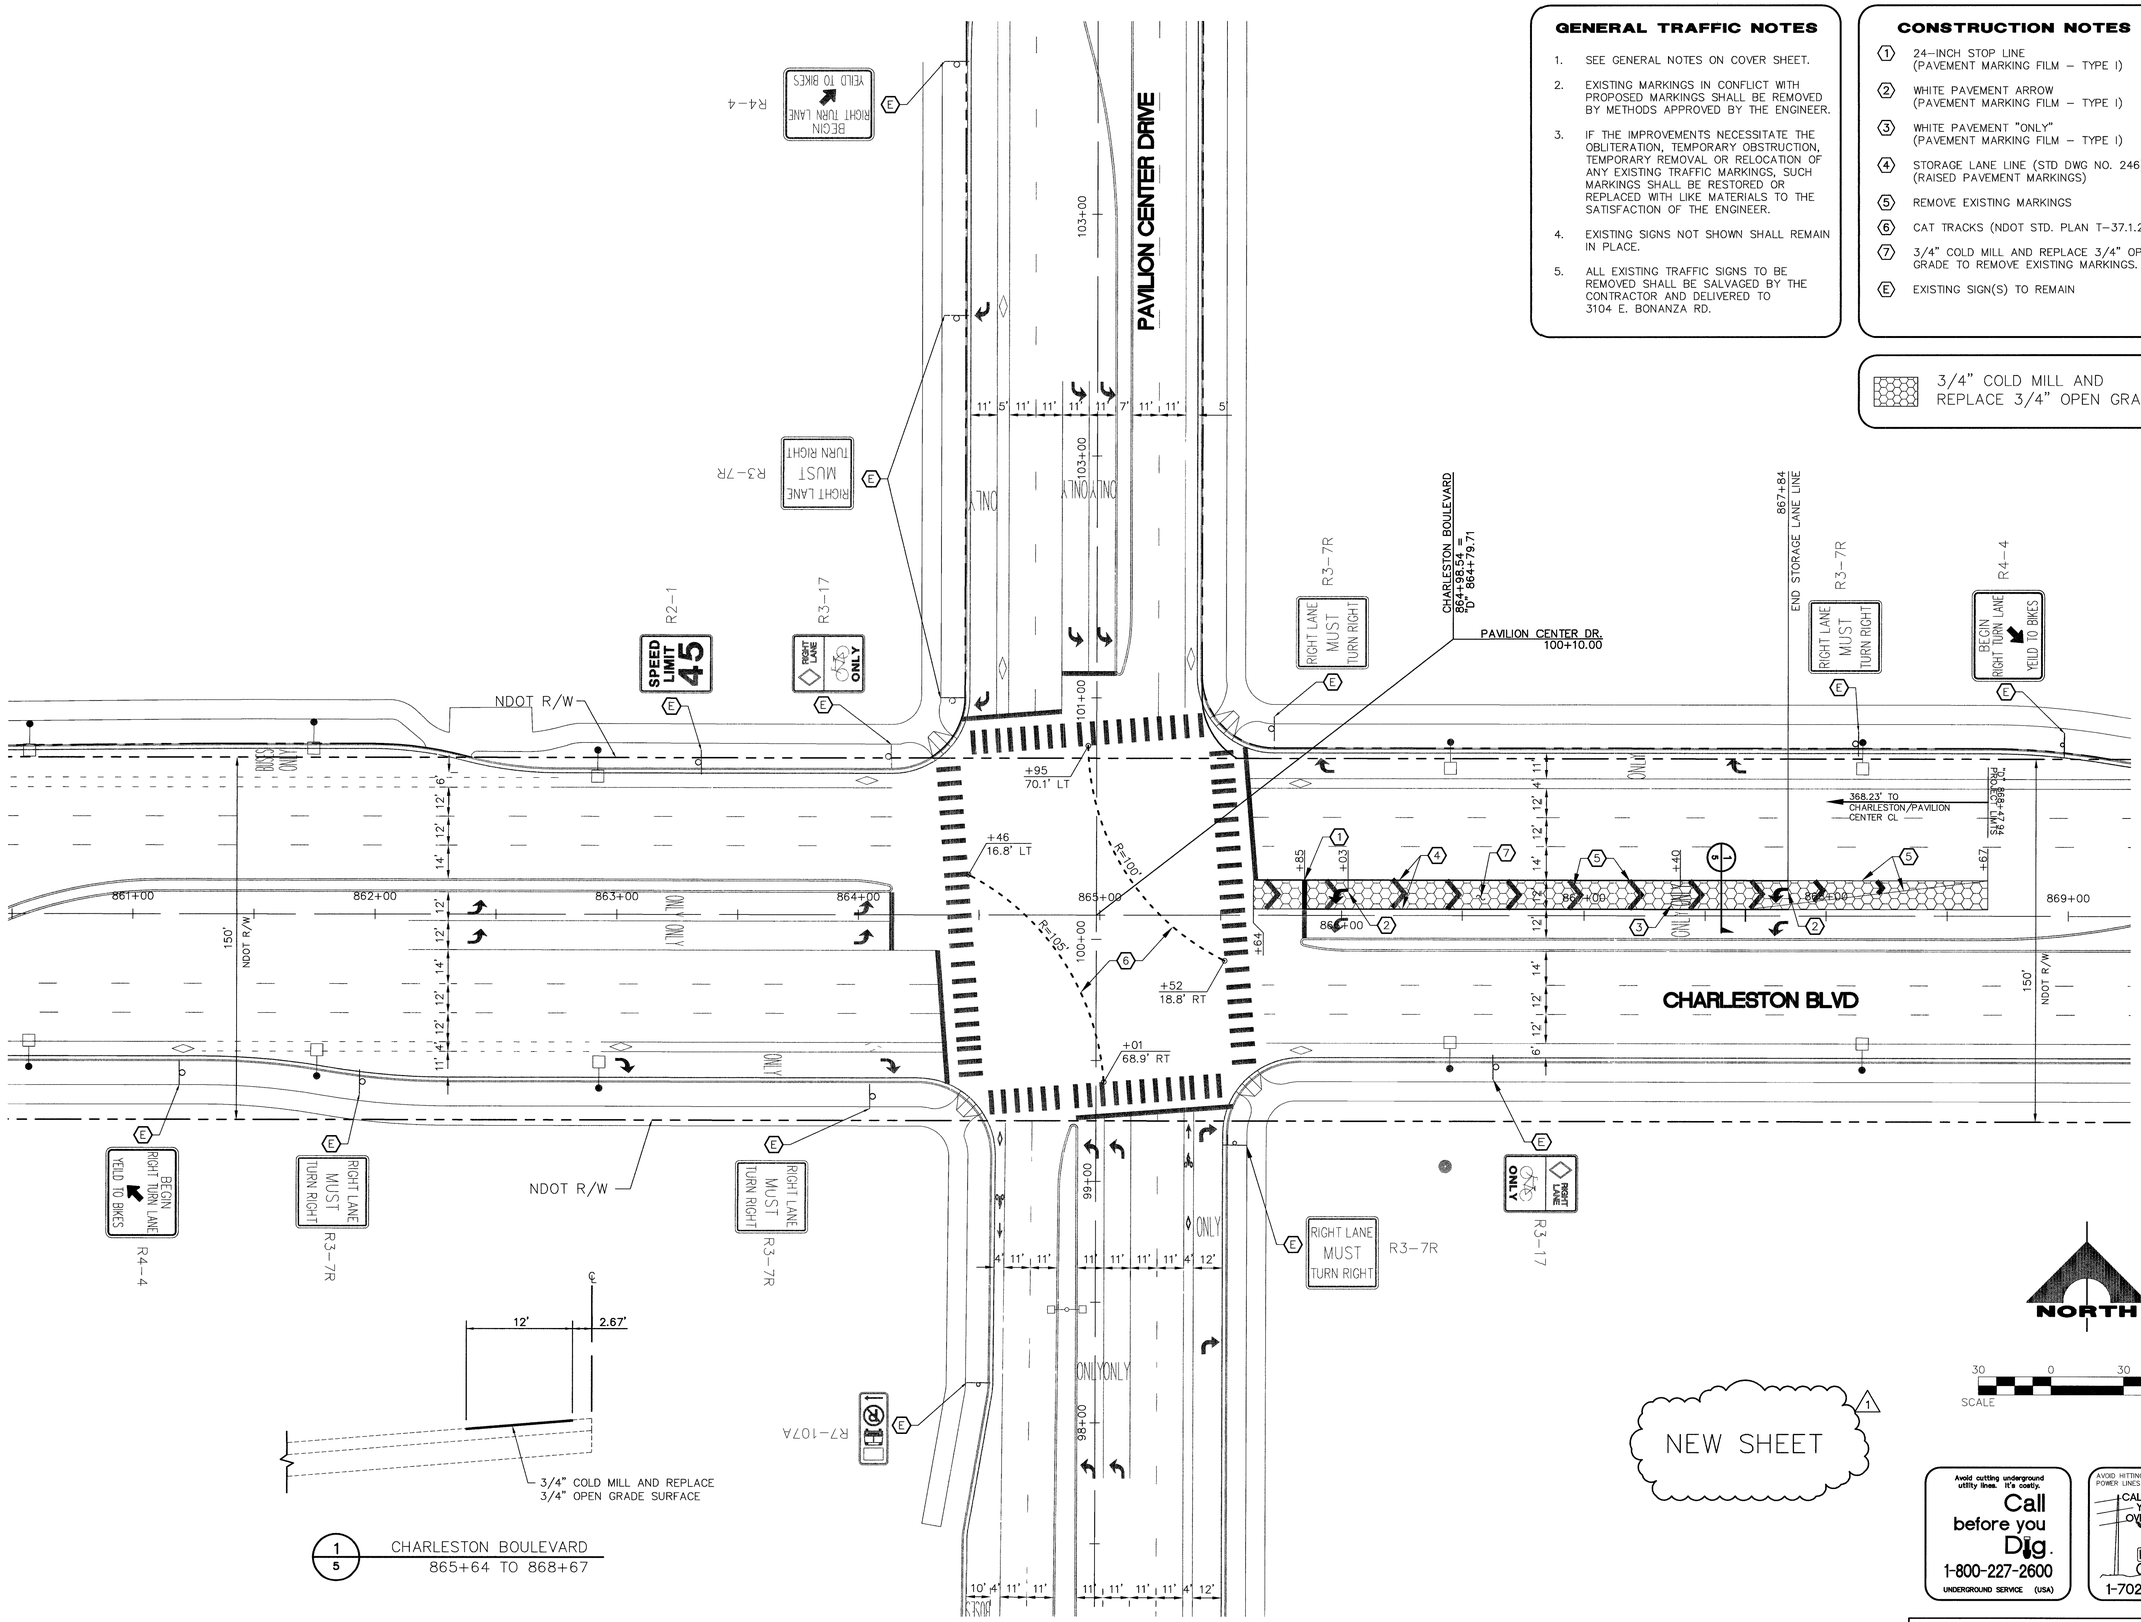

1/5 CHARLESTON BOULEVARD 865+64 TO 868+67

Avoid cutting underground utility lines. It's costly.
Call before you Dig.
1-800-227-2600
UNDERGROUND SERVICE (USA)

AVOID HITTING OVERHEAD POWER LINES IT'S COSTLY
CALL BEFORE YOU DO OVERHEAD
1-702-227-2929

CLV DWG. NO: 208-558 (ADDED SHEET)

REV	DATE	DESCRIPTION	DATE AGEN. APP	DATE BCW. APP	DATE TAM
1	1/20/06	ADD NEW SHEET			

DESIGN: BEE
DRAWN: BEE
CHECK:
ISSUE DATE:
ISSUE EDITOR:
PLOT DATE: 01-26-06
PLOT TIME: 17:04:11

G.C. WALLACE, INC.
Engineers/Planners/Surveyors
1555 SOUTH RAINBOW BLVD./LAS VEGAS, NEVADA 89146
TELEPHONE: (702) 804-2000 • FAX: (702) 804-2299
tmccoy
F:\398-A009\dwg\Improv\C9_05.dwg

STATE OF NEVADA PROFESSIONAL ENGINEER TIMOTHY A. McCOY Exp. 12/31/2007 CIVIL No. 11151

DATE: 1/27/06

STATION CASINOS, INC.
RED ROCK STATION CASINO
CHARLESTON BLVD/PAVILION CENTER DRIVE TRAFFIC STRIPING PLAN

DRAWING 5
5 OF 5 SHTS

87461