


DATE:

HKS JOB NO. 8849

3/9/06

KEY PLAN

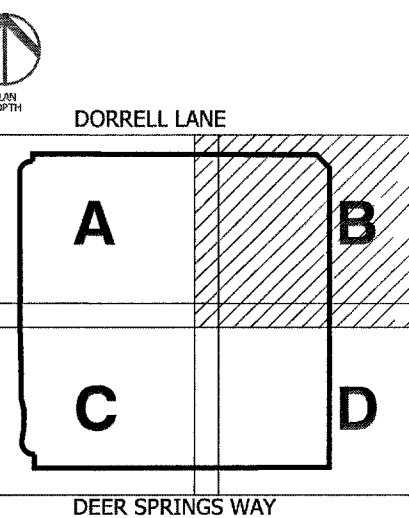

DATE

20 Jun 05

BID/PERMIT ISSUE
20 JUN 05
CITY OF LAS VEGAS - CIVIL REVIEW
15 SEPT. 05
FINAL SUBMITTAL
31 OCT. 05


SHEET TITLE

SWPPP PLAN

SHEET NO.


C7.B

SHEET NO. 38 OF 43

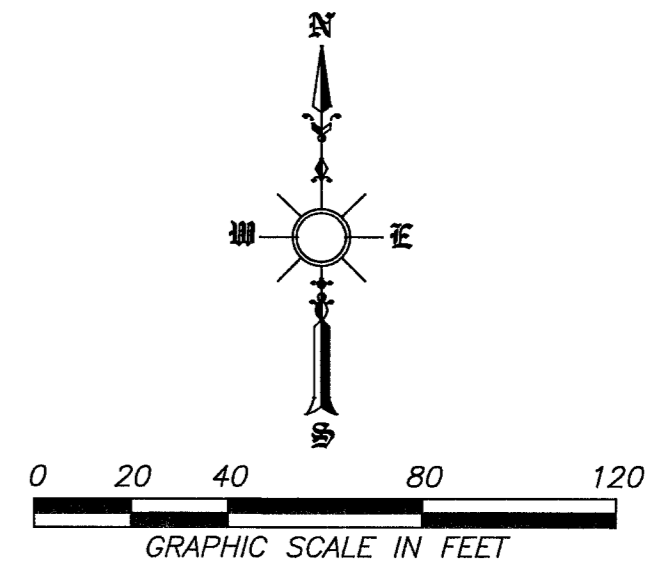

LEGEND

- TEMPORARY SEDIMENT CONTROL FENCE
- ROCK FILTER DAM
- SAND BAG BARRIER
- INLET PROTECTION
- ENERGY DISSIPATOR COMMON STONE RIP-RAP
- SOIL RETENTION BLANKET
- STABILIZED CONSTRUCTION ENTRANCE/EXIT
- PROPOSED MINOR CONTOURS
- PROPOSED MAJOR CONTOURS

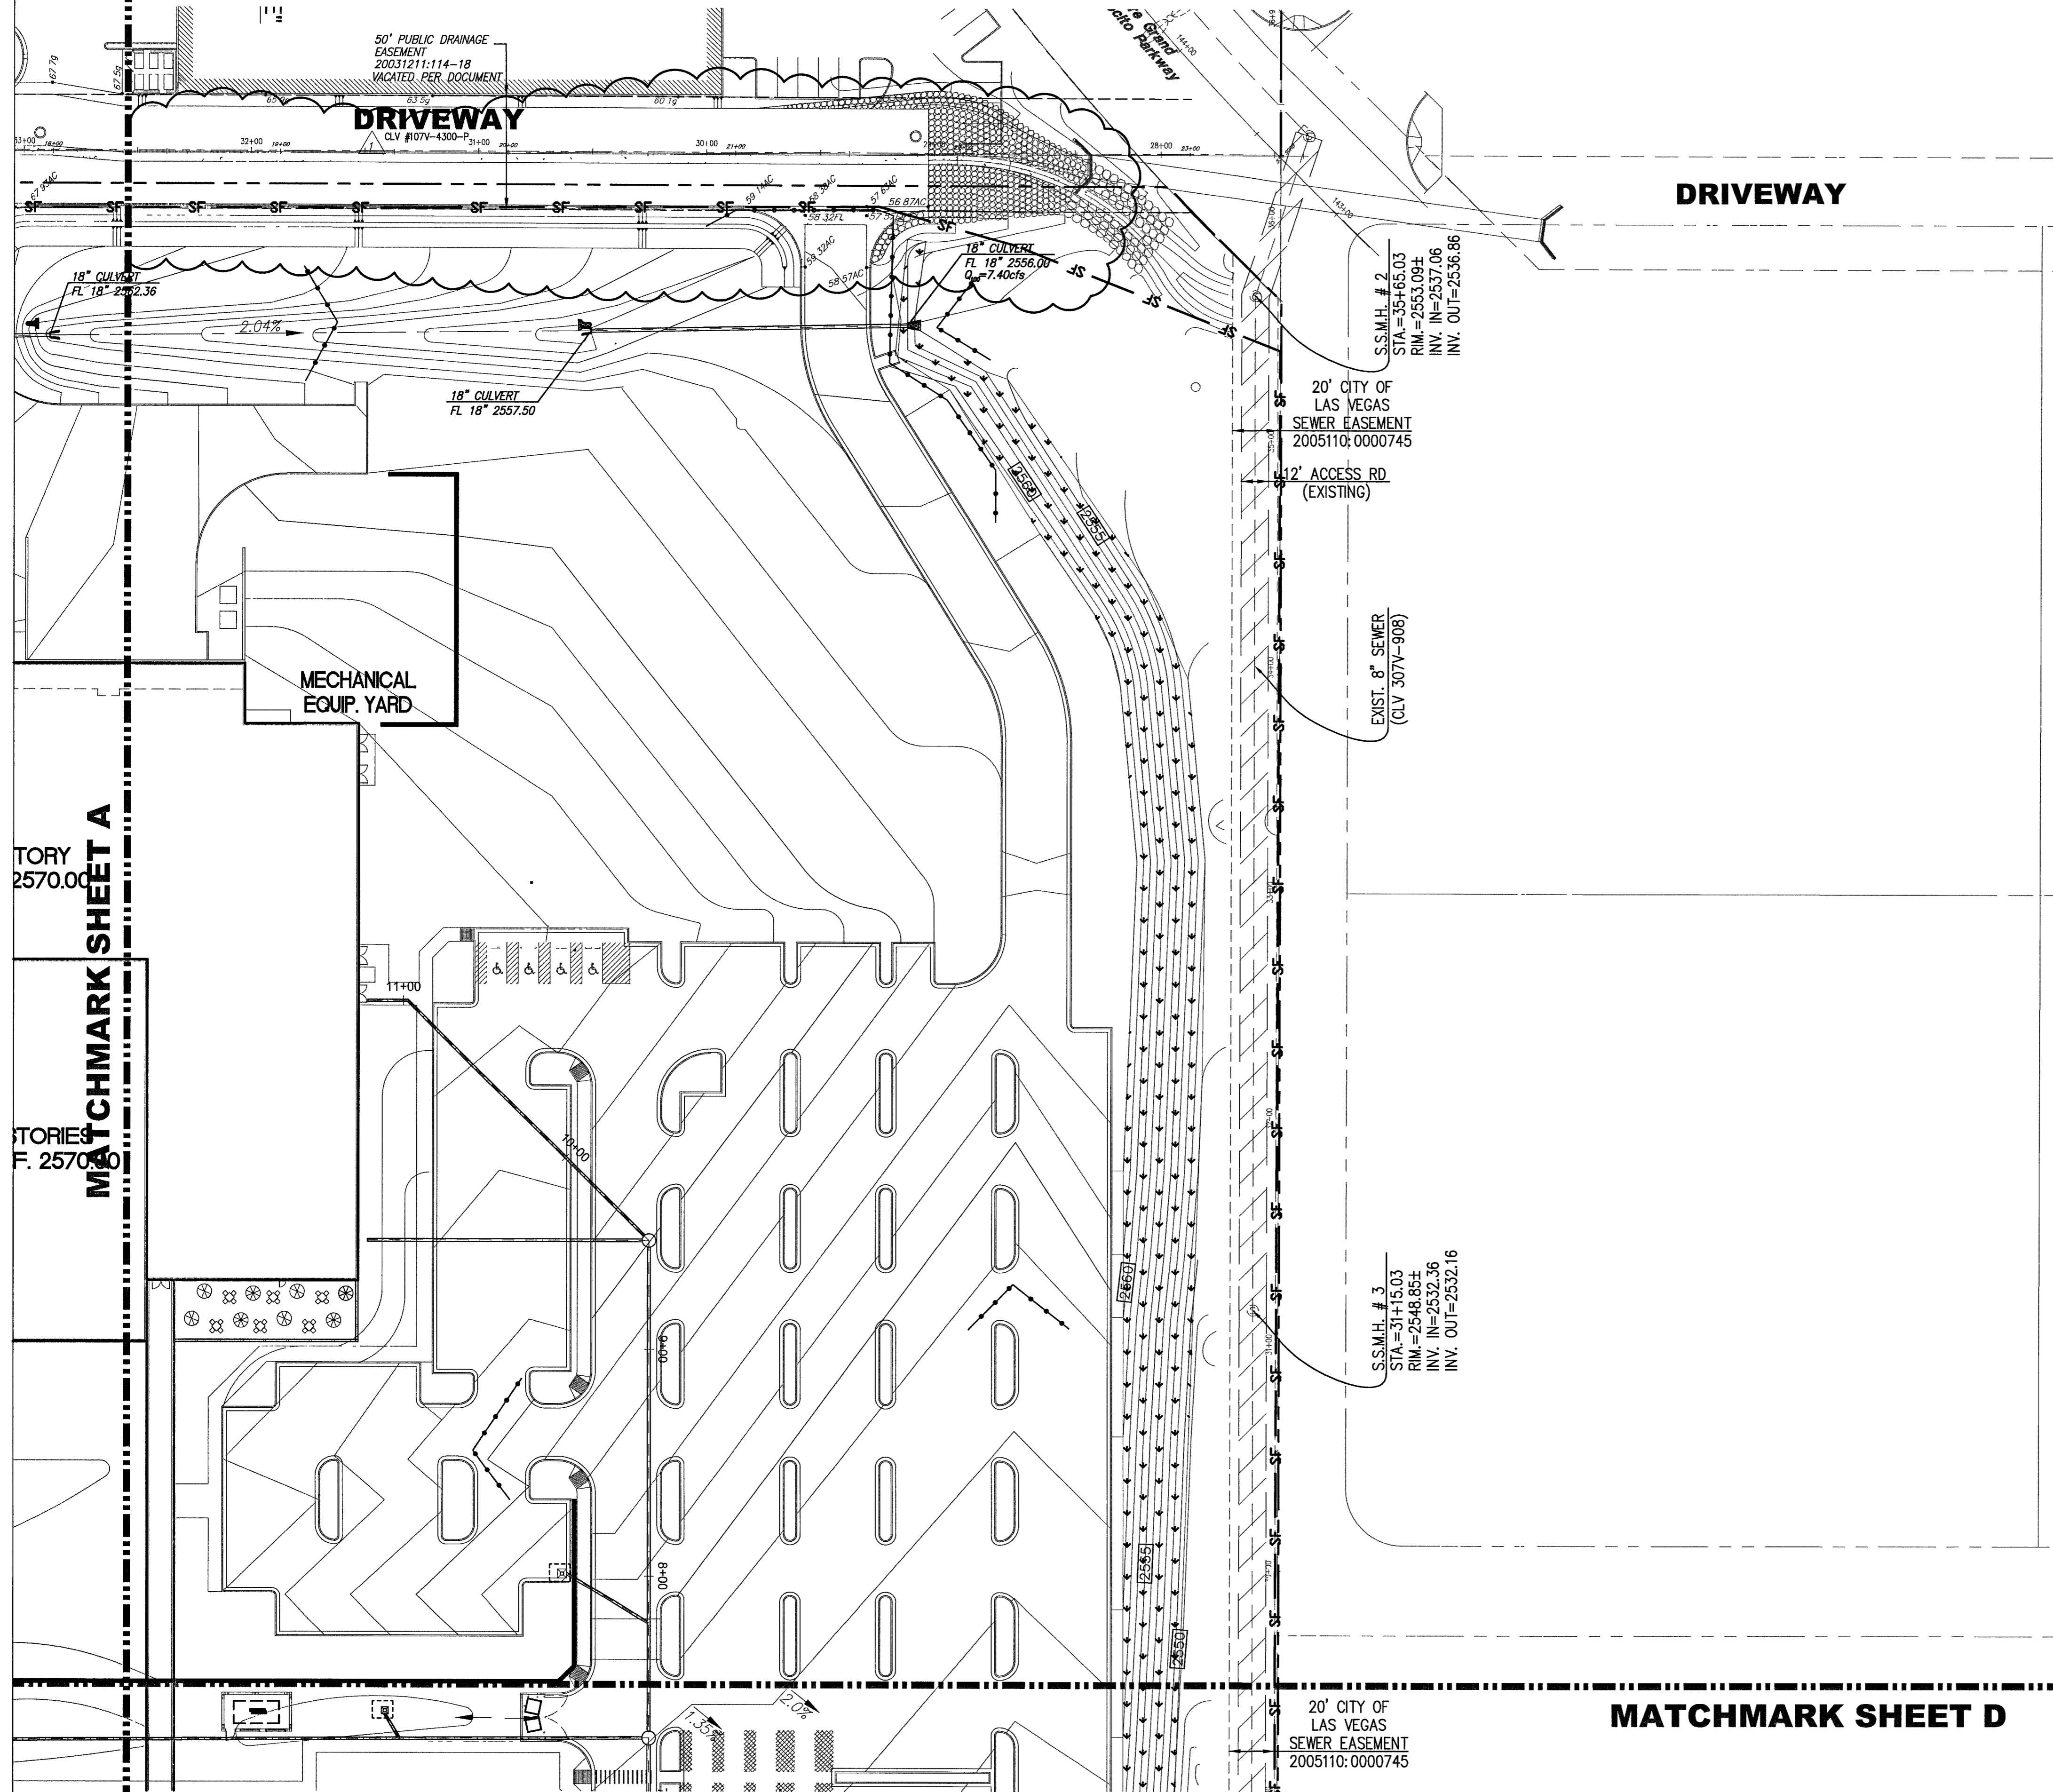

MATCHMARK SHEET D

CAUTION TO CONTRACTOR
THE CONTRACTOR SHALL BE RESPONSIBLE TO INVESTIGATE AND VERIFY THE ACTUAL LOCATION AND DEPTH OF ALL EXISTING UNDERGROUND FACILITIES AT LEAST 48 HOURS IN ADVANCE OF THE PERFORMANCE OF ANY WORK.

Avoid cutting underground utility lines. It's costly.

Call before you Dig
89081
1-800-227-2600

Avoid overhead power line contact. It's costly.

Call before you OVERHEAD
1-702-593-6111


Call before you UnderGround
1-702-455-7511
CLARK COUNTY TRAFFIC OPERATIONS
AND
1-702-229-6611
LAS VEGAS AREA TRANSPORTATION CENTER

REV.	DESCRIPTION:	DATE:	BY:

24128-ERO.DWG