

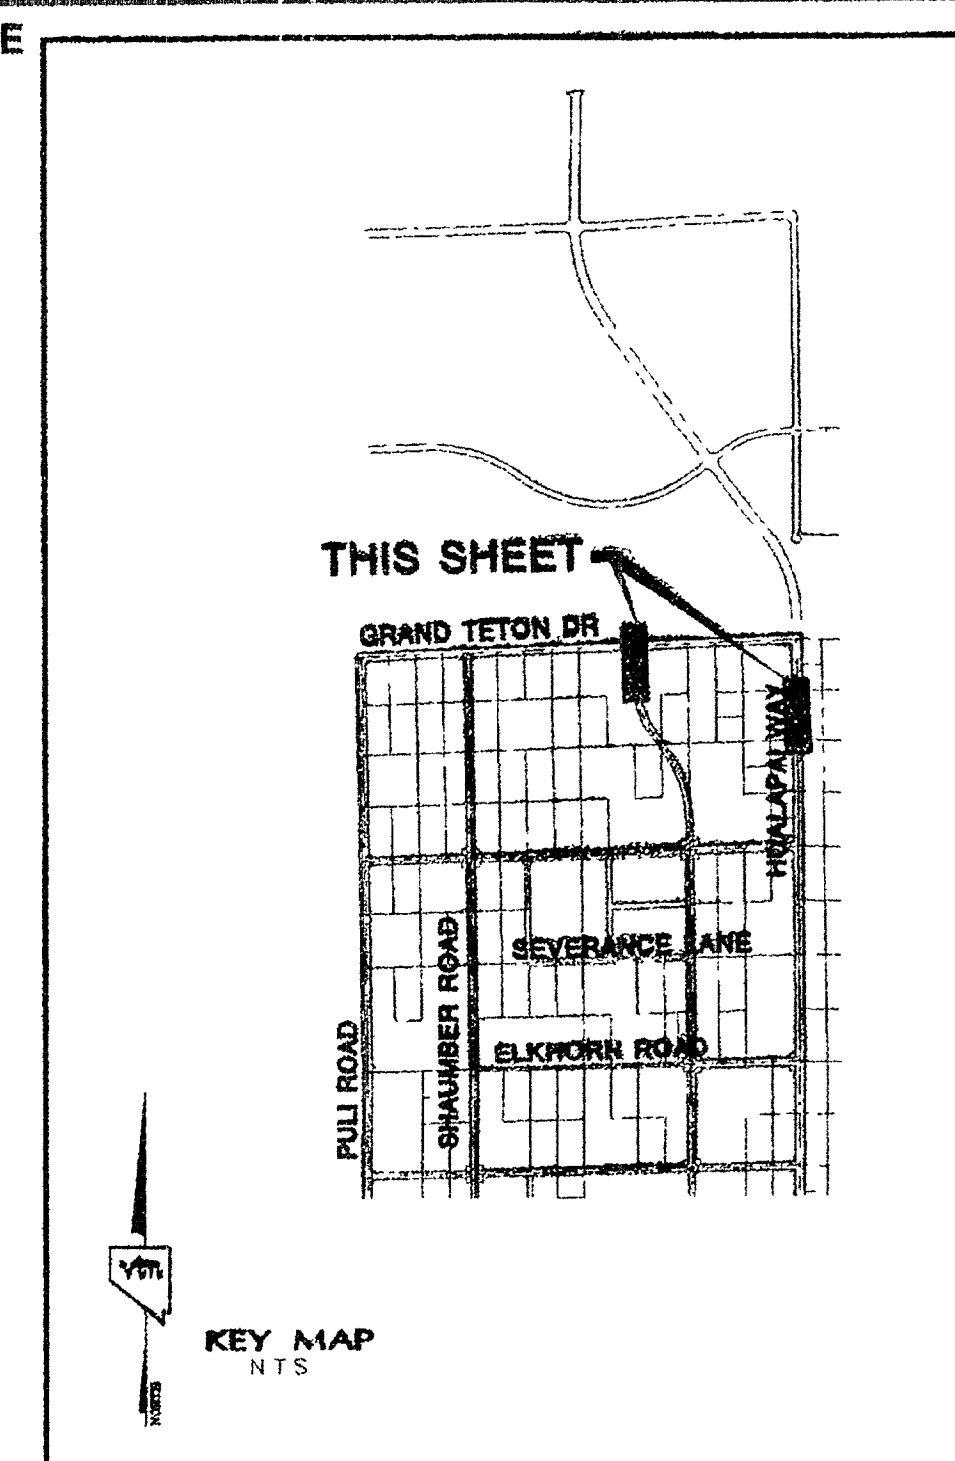
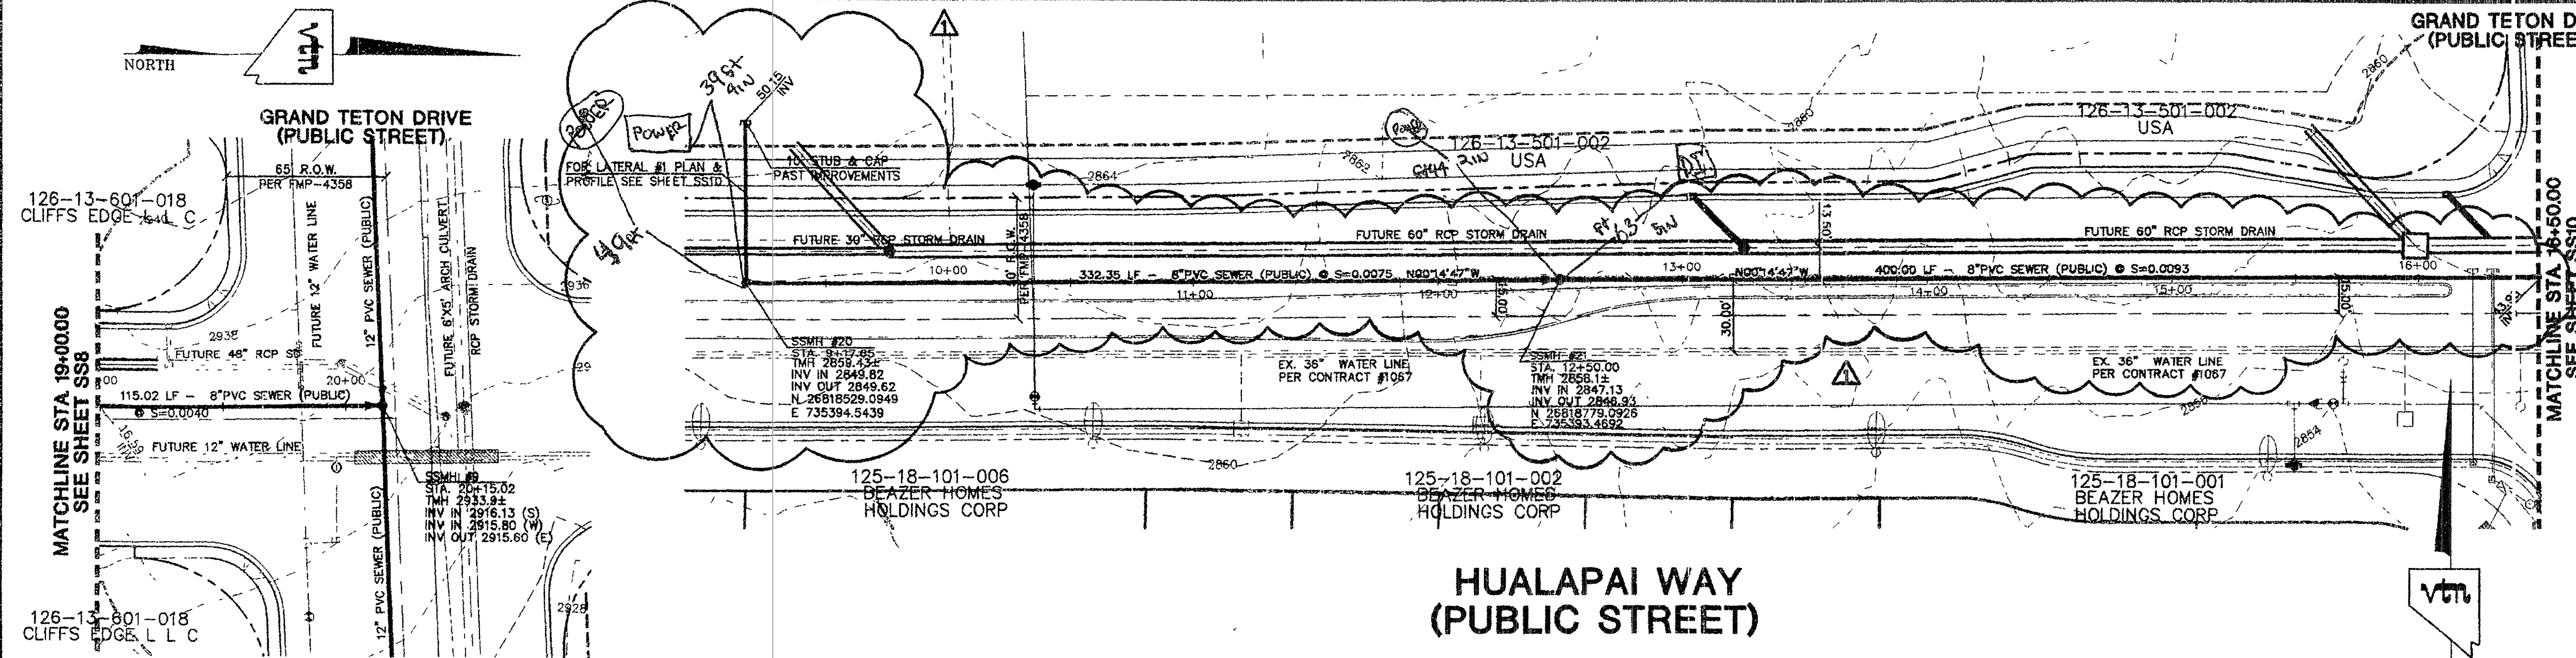


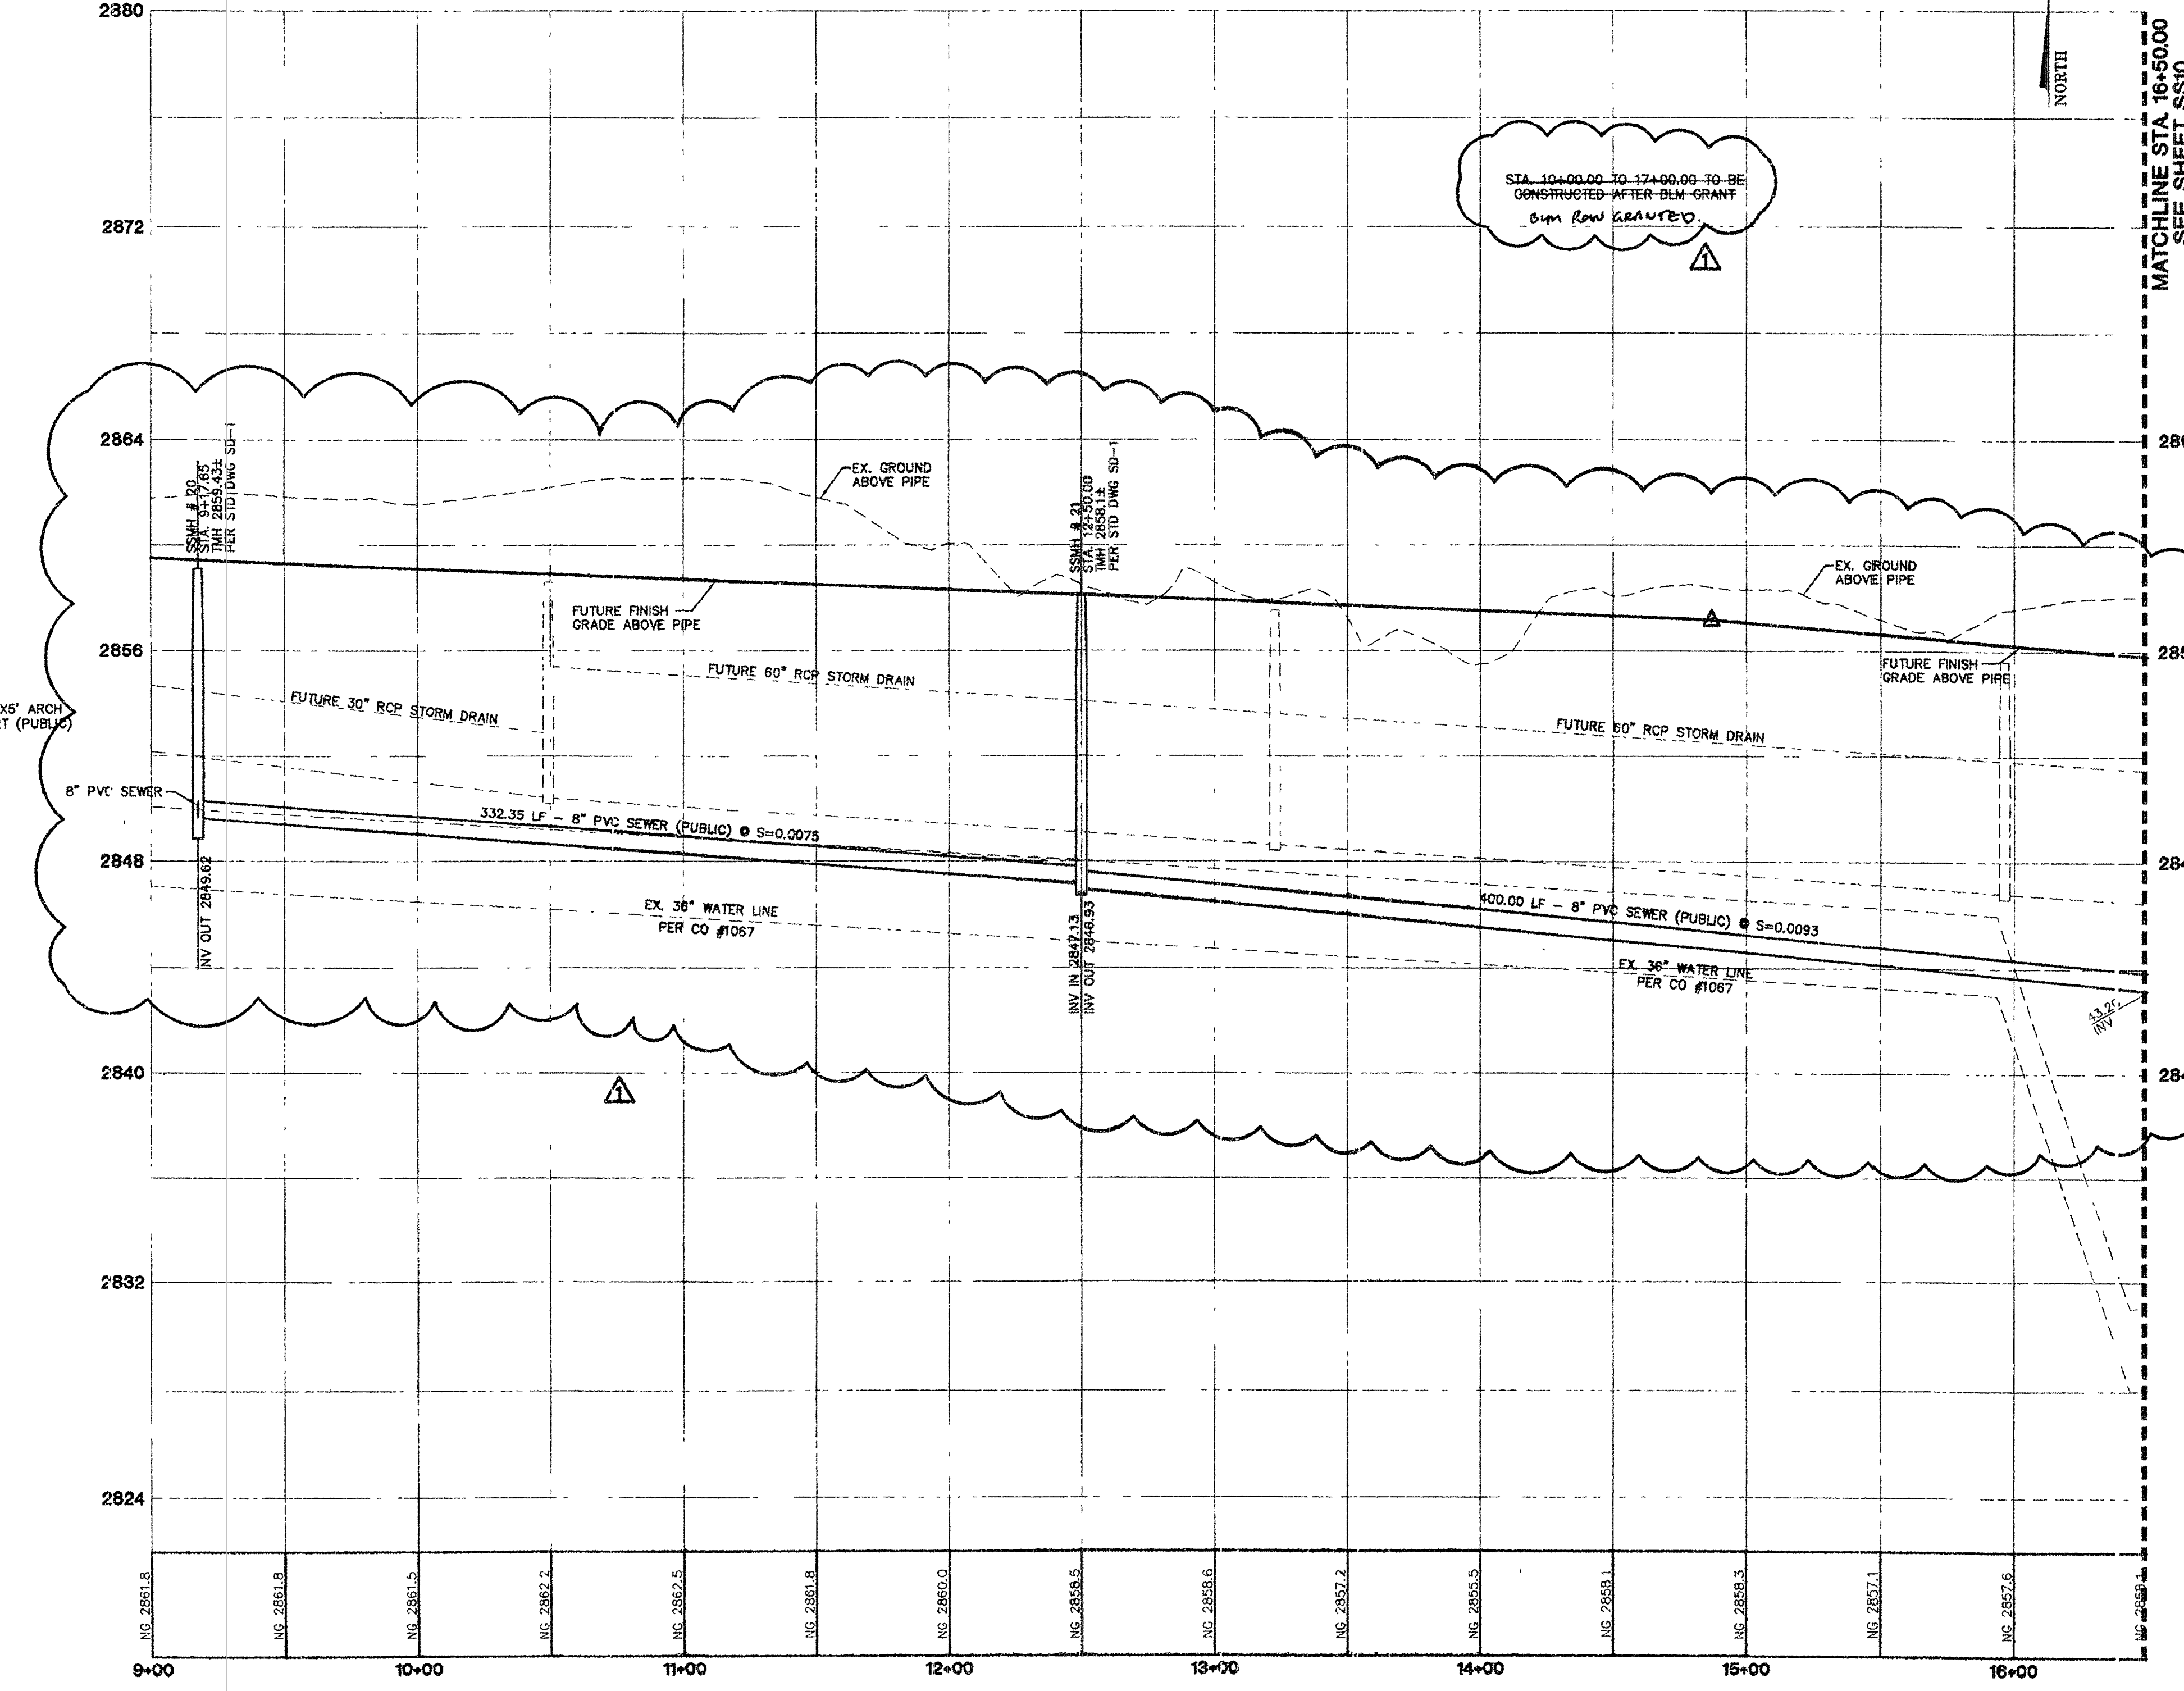

**EGAN CREST WAY
(PUBLIC STREET)**

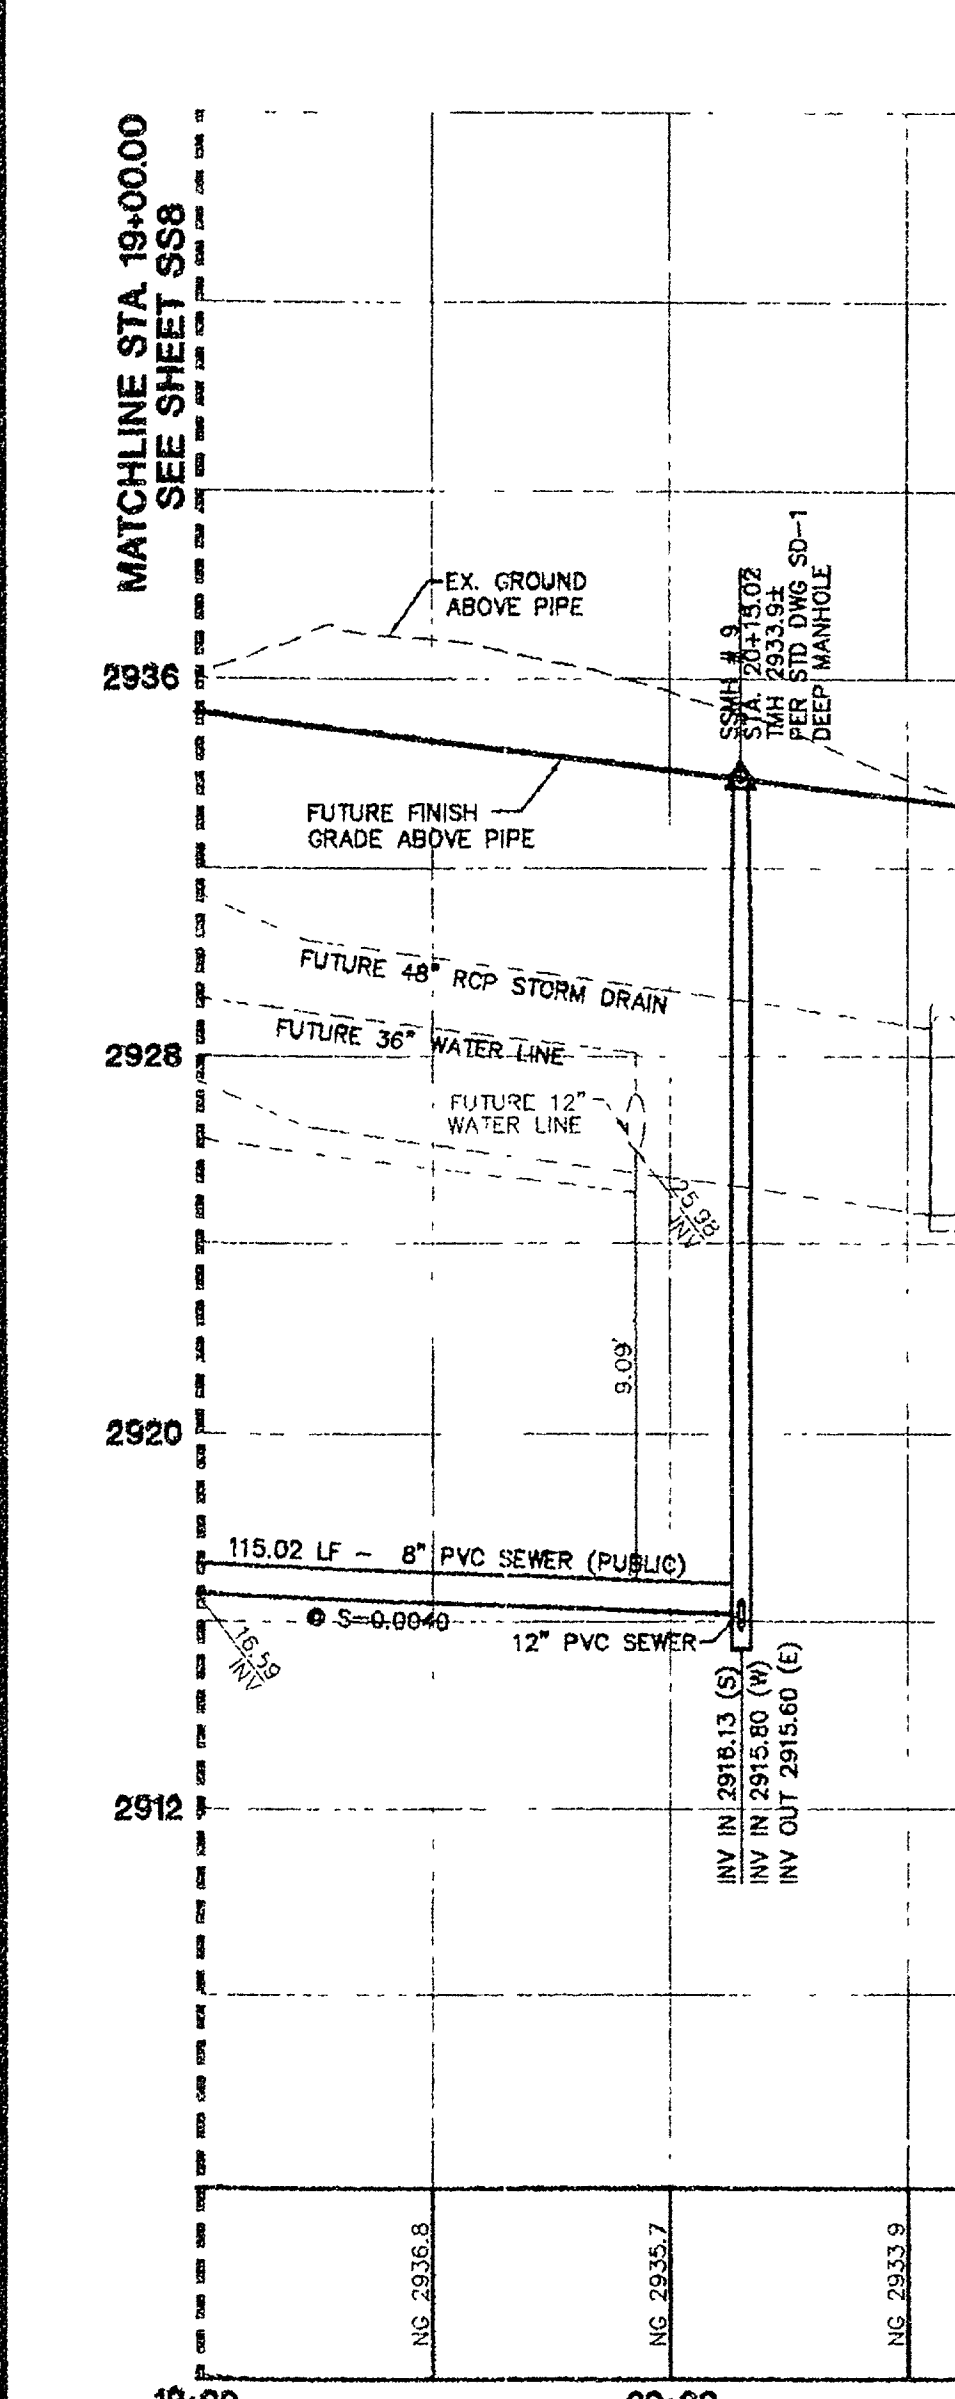

GRAPHIC SCALE
1" = 40'

Call before you Overhead
1-702-227-2929

Call before you Dig
1-800-227-2600

Call before you Underground
1-702-455-7511
CLARK COUNTY TRAFFIC OPERATIONS
1-702-229-6511
LAS VEGAS AREA COMPUTERIZED TRAFFIC SYSTEM

CONTRACTOR NOTE:
CONTRACTOR SHALL VERIFY HORIZONTAL AND VERTICAL LOCATION OF EXISTING UTILITIES AND NOTIFY THE DESIGN ENGINEER IMMEDIATELY OF ANY DISCREPANCIES PRIOR TO CONSTRUCTION.

BASIS OF BEARINGS
THE BASIS OF BEARINGS FOR THIS PROJECT IS NORTH 03°08'16" EAST BEING THE EAST LINE OF THE NORTHWEST QUARTER (NE 1/4) OF THE SECTION 26, TOWNSHIP 19 SOUTH, RANGE 59 EAST, M.D.M., CLARK COUNTY, NEVADA, AS SHOWN ON A RECORD OF SURVEY ON FILE IN THE CLARK COUNTY, NEVADA, RECORDER'S OFFICE IN FILE 123 AT PAGE 32.

PROJECT BENCHMARK
PROJECT DATUM: NORTH AMERICAN VERTICAL DATUM OF 1988 (NAVD88)
CLARK COUNTY VERTICAL CONTROL: 1000.6N6
NAVD88 ELEVATION: 787.794 METERS (2584.62 FEET)
RIVET AND SQUARE ALUMINUM PLATE IN A CONCRETE CYLINDER, LOCATED 25' SOUTH & 50' EAST OF GRAND CANYON DRIVE AND RED COACH AVENUE, 1' WEST OF ELECTRICAL VAULT.

CITY OF LAS VEGAS BENCHMARK
DATUM: NORTH AMERICAN VERTICAL DATUM OF 1988 (NAVD88)
CITY OF LAS VEGAS BENCHMARK: BLV99-135E3
NAVD88 ELEVATION: 863.606 METERS (2833.03 FEET)
RIVET AND PLATE IN CONCRETE CYLINDER NW CORNER OF HUALAPAI AND ELKHORN

NOTE: ADD 0.34' TO ABOVE CITY OF LAS VEGAS BENCHMARK BLV99-135E3 TO MATCH ORIGINAL PROJECT BENCHMARK, CLARK COUNTY BENCHMARK 1000-6N6 (2584.62 FEET) AS SHOWN ON RECORD OF SURVEY FILE 124 PAGE 94.

CLIFFS EDGE LLC 3465 CLIFF SHADOW PARKWAY, SUITE 250 LAS VEGAS, NEVADA 89129 (702) 777-1221		CITY OF LAS VEGAS, NEVADA	
SEWER PLAN AND PROFILE EGAN CREST WAY STA 19+00.00 TO 20+00.00 HUALAPAI WAY STA 10+00.00 TO 16+00.00		CLIFFS EDGE GRAND TETON DRIVE SEWER IMPROVEMENTS	
DRAWN BY: S.P.	APRIL '04	DESIGNED BY: B.F.	APRIL '04
CHECKED BY: L.W.	APRIL '04	PROJECT NO:	9989
SCALE: 1"=40' HORIZ. 1"=4' VERT.		SHEET SS9 12 OF 13 SHEETS DRAWING NO. 107.948/605-8	

REVISION FOR WORK IN BLM ROW GRAND TETON DRIVE AND ADDED SEWER LATERALS KPL/HLP/CS
REV DATE BY

2727 SOUTH RAINBOW BOULEVARD LAS VEGAS, NEVADA 89145-5148
PH. (702) 873-7550 FAX (702) 882-2597

PROFESSIONAL ENGINEER - STATE OF NEVADA
DANIEL J. HODD
CIVIL
No. 128111 POWER
3/1/07