




MATCHLINE - STA. 119+00
SEE DRAWING R-4

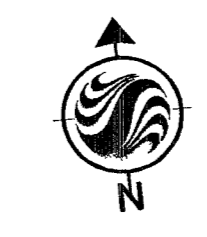

TORREY PINES DRIVE

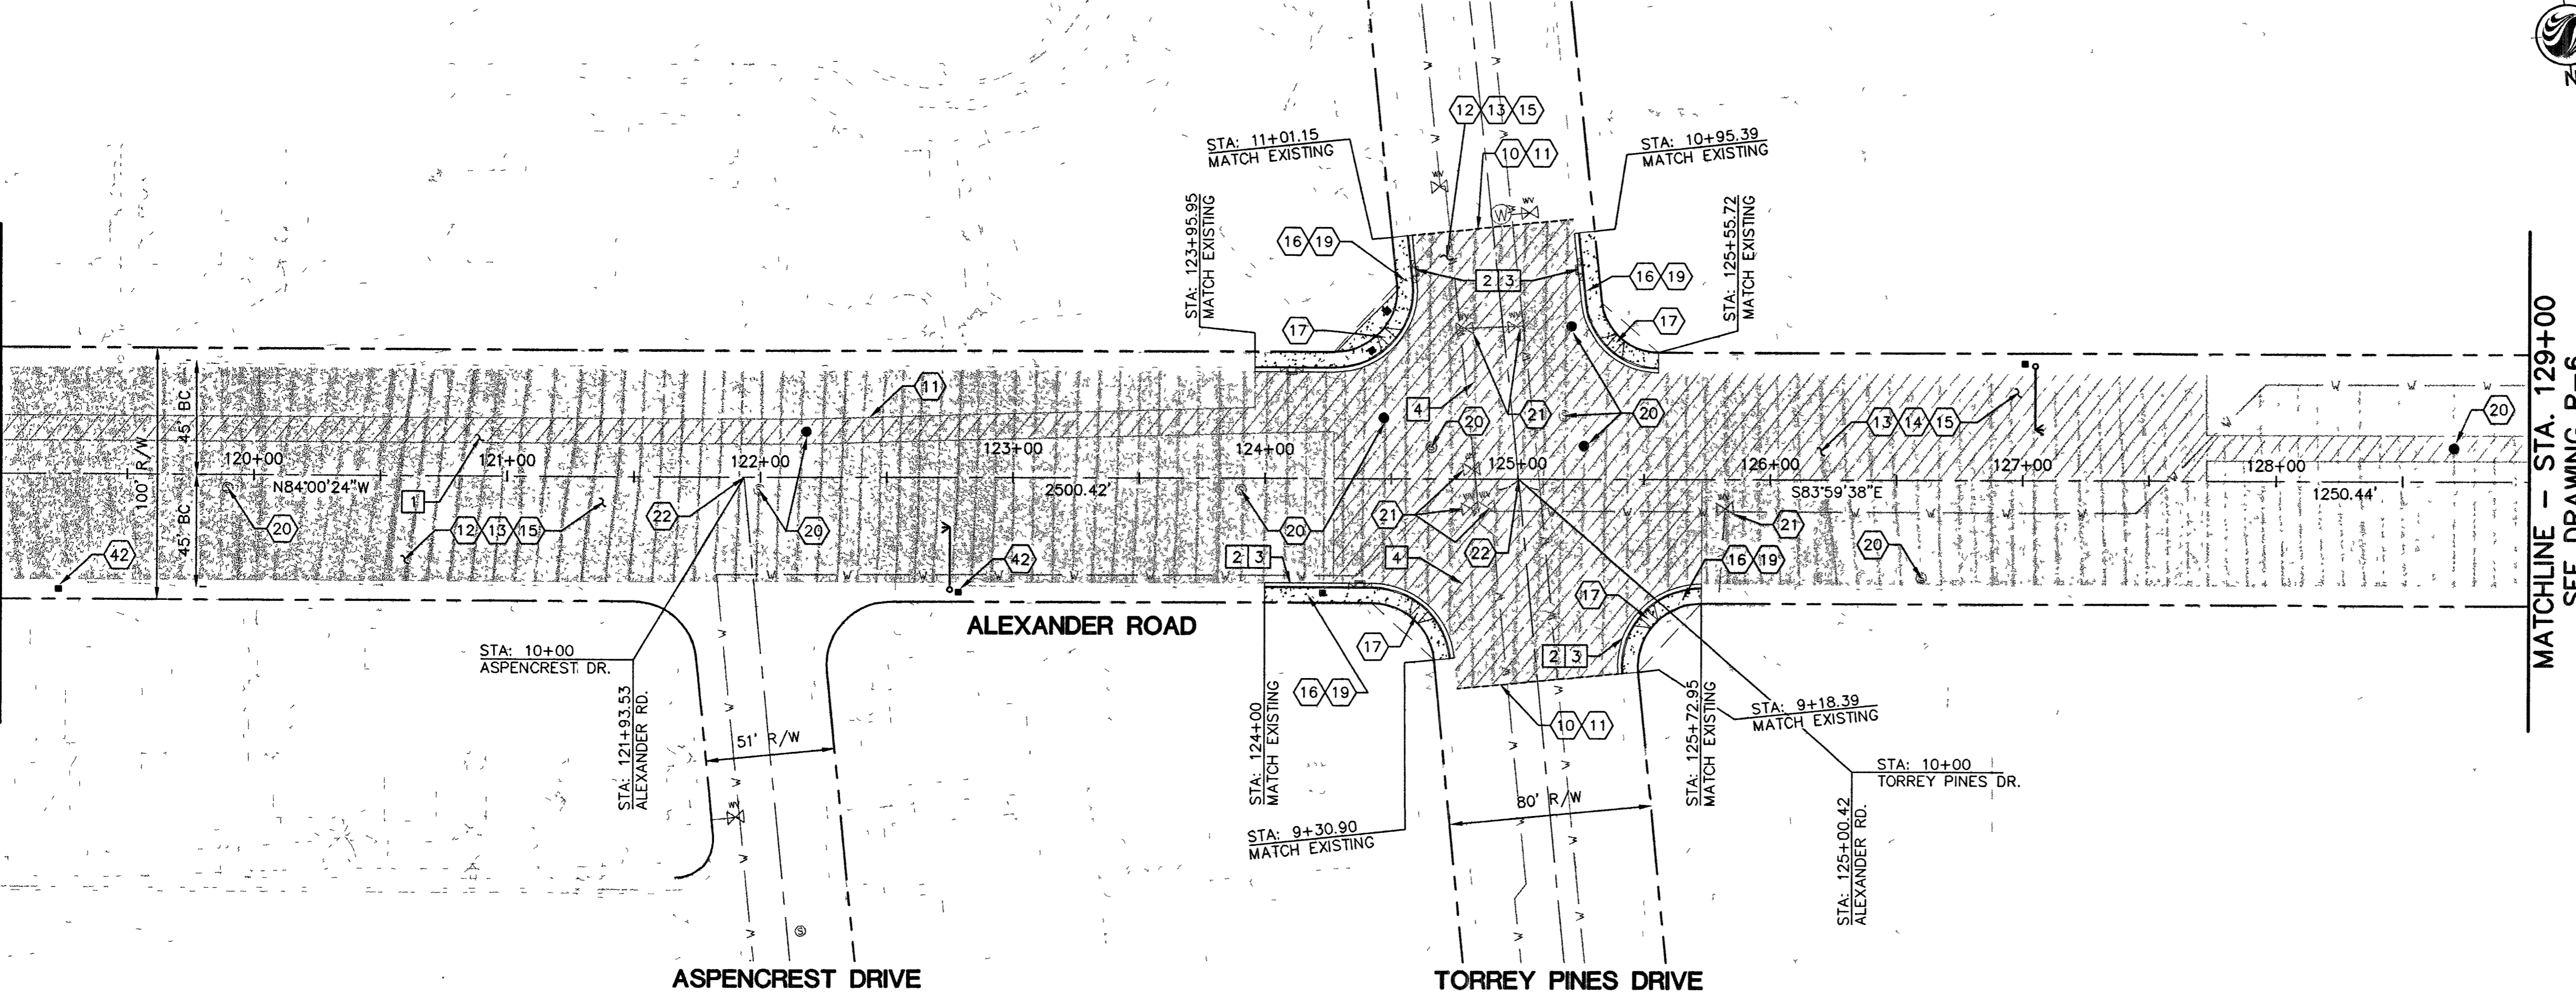

MATCHLINE - STA. 129+00
SEE DRAWING R-6

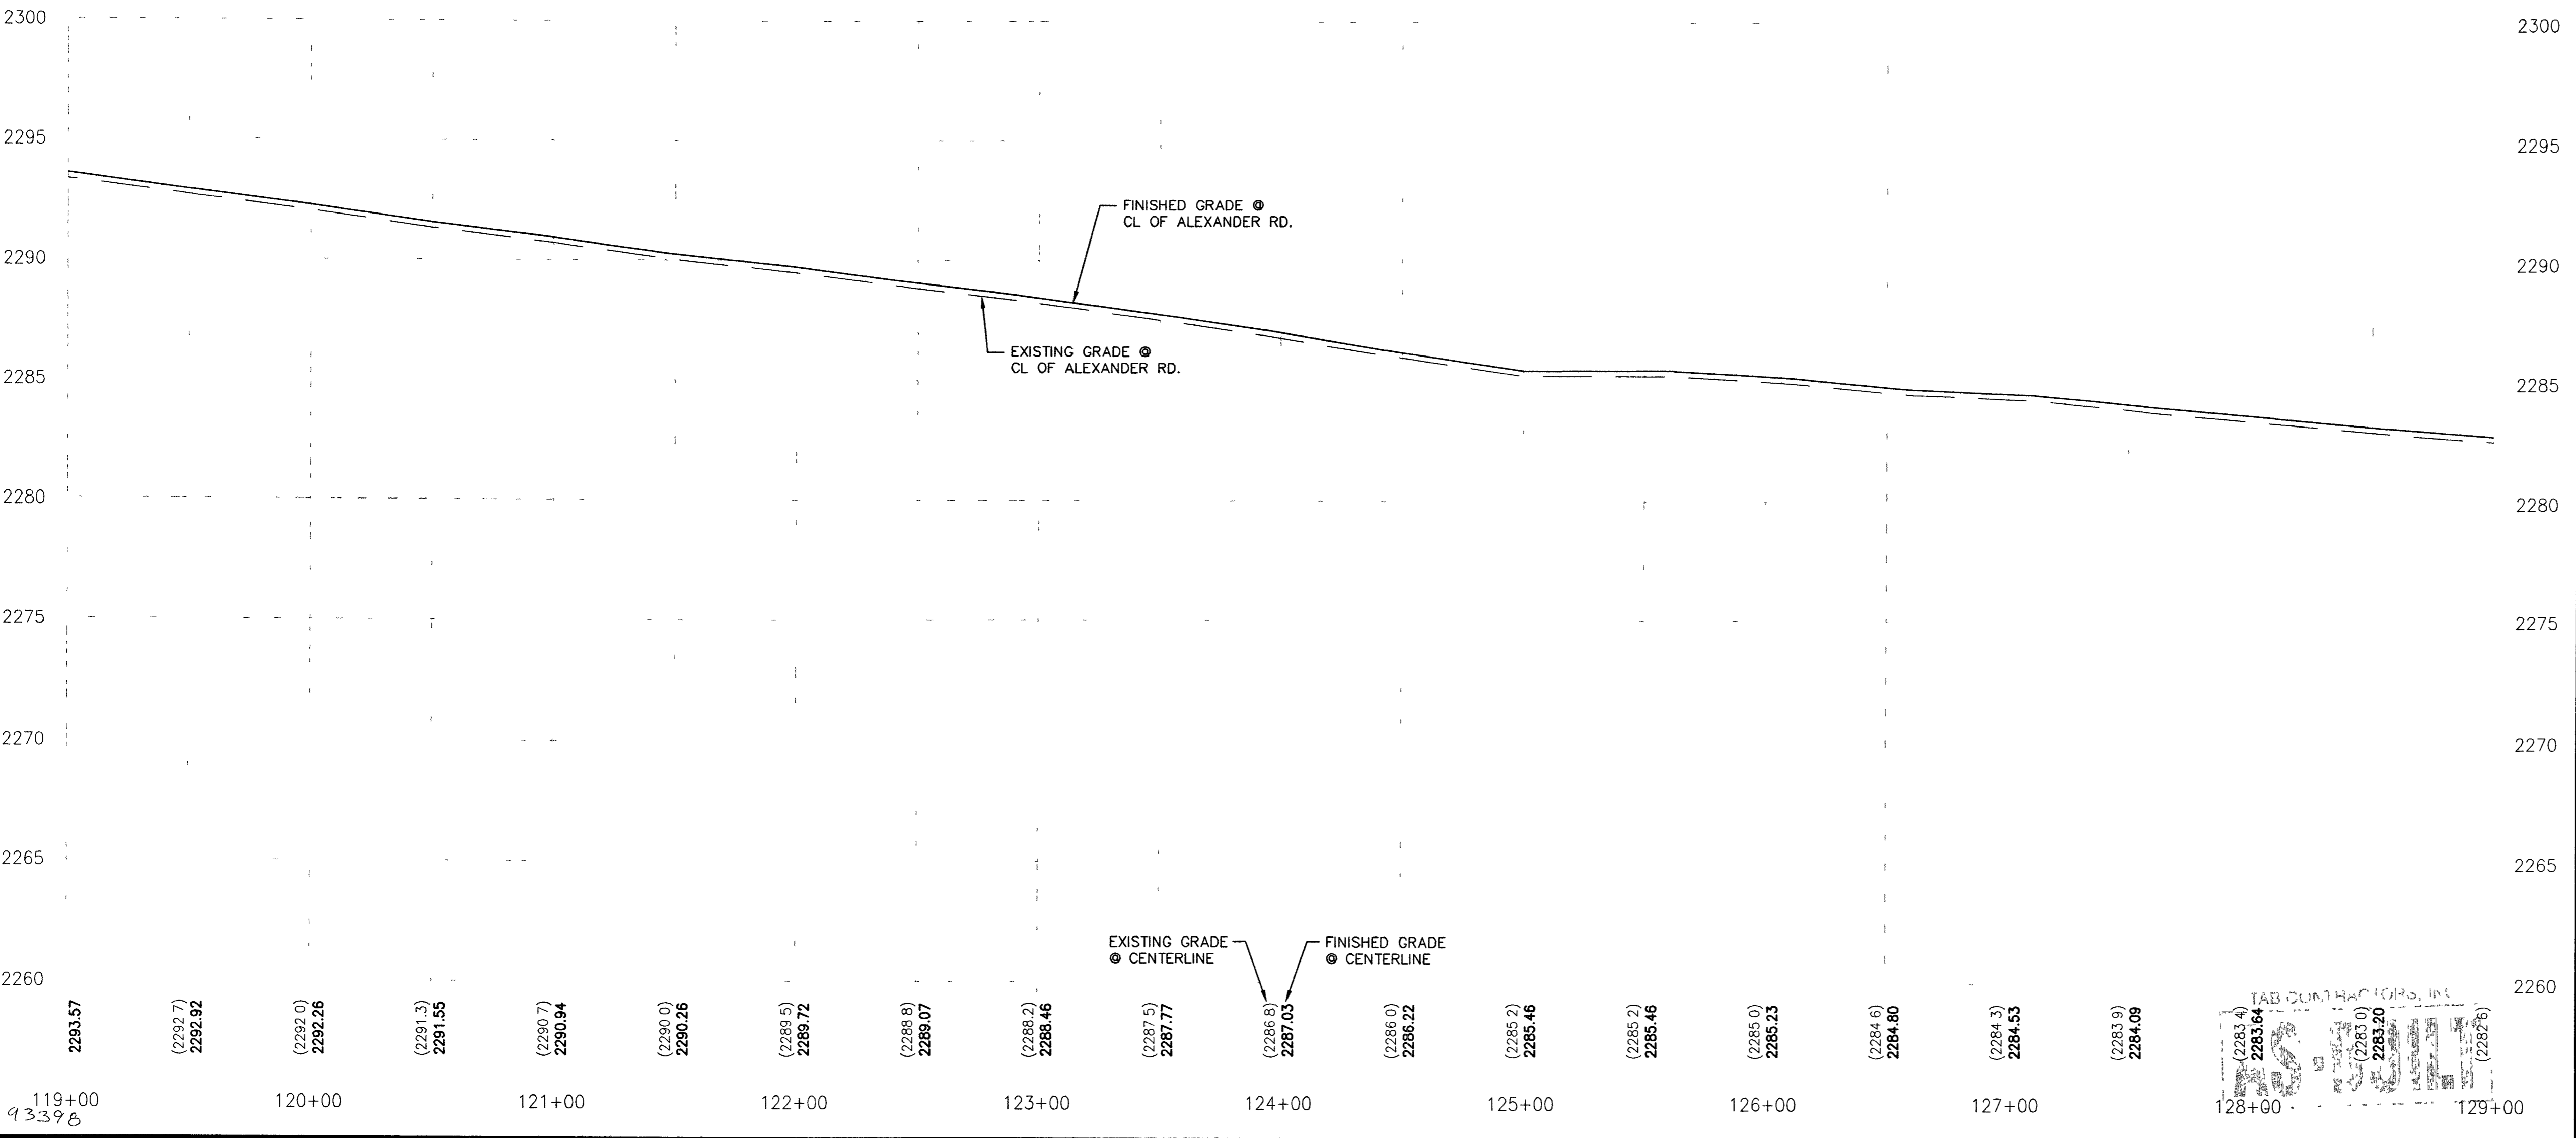

Stantec Consulting Inc.
6763 W. Charleston Blvd
Las Vegas NV U.S.A.
89146-1049
Tel. 702.258.0115
Fax 702.258.4956
www.stantec.com


- REMOVAL NOTES:**
- 1 AC PAVEMENT
 - 2 SIDEWALK
 - 3 CURB & GUTTER
 - 4 VALLEY GUTTER

- CONSTRUCTION NOTES:**
- 10 MATCH EXISTING
 - 11 SAWCUT
 - 12 ROTOMILL (SEE NOTE 2)
 - 13 3" AC PAVEMENT OVERLAY
 - 14 2" AC PAVEMENT REPLACEMENT
 - 15 3/4" OPEN GRADE
 - 16 L TYPE CURB & GUTTER PER USD NO. 216
 - 17 TYPE III SIDEWALK RAMP PER USD NO. 235
 - 19 SIDEWALK PER USD NO. 234
 - 20 ADJUST MANHOLE WITH COLLAR PER USD NO. 408
 - 21 ADJUST WATER VALVE BOX TO FINISHED GRADE PER UDACS PLATE B. VALVE SHALL BE ACCESSIBLE AT ALL TIMES.
 - 22 RE-ESTABLISH SURVEY MARKER
 - 42 P30 PULLBOX

- NOTES:**
1. ALL GEOMETRY ON MEDIAN CURBS IS TO FACE OF CURB.
 2. ROTOMILL QUANTITY EXCLUDES TRENCH AND PAVEMENT REPLACEMENT.
 3. CENTERLINE GRADE SHOWN IS SURFACE OF OPEN GRADE SEE SECTION $\frac{B}{R1}$
 4. SEE SHEET R-8 FOR ALEXANDER ROAD - TORREY PINES DRIVE GRADING PLAN.
 5. SEE SHEETS U-1 THRU U-6 FOR UTILITY PLANS.
 6. SEE SHEETS T-1 THRU T-2 FOR STRIPING PLANS.

- 3" AC PAVEMENT
- 2" AC PAVEMENT

[Signature] 4/14/03
DATE

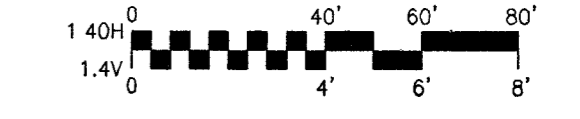


Call before you OVERHEAD
1-702-593-6111

Call before you Dig
1-800-227-2600

NO.	DATE	DESCRIPTION

DEPARTMENT OF PUBLIC WORKS
ENGINEERING DESIGN SECTION
CITY ENGINEER: CHARLES KAJKOWSKI JR., P.E.
DESIGNED BY: J.O.D.D
DRAWN BY: D.D
CHECKED BY: MW
HORIZONTAL SCALE: 1" = 40'
VERTICAL SCALE: 1" = 4'
DATE: 06/11/02

ALEXANDER ROAD
US 95 TO RANCHO DRIVE
ROADWAY PLAN + PROFILE
STA. 119+00 TO 129+00

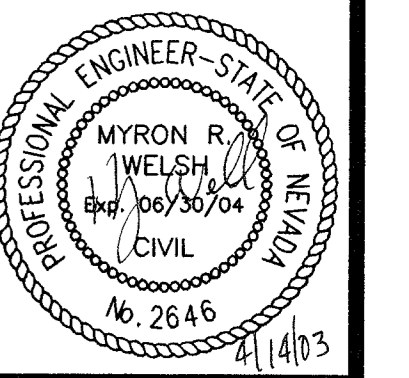

Sheet R-5
13 of 35
DRAWING NO. 107-V3634