


CURVE TABLE				
CURVE	RADIUS	DELTA	LENGTH	TANGENT
C1	1.00	00°00'00"	3.14	INFINITE
C2	2.00	00°00'00"	6.28	INFINITE
C3	30.00	97°35'27"	51.10	34.26
C4	100.00	20°28'30"	35.74	18.06
C5	250.00	15°24'51"	67.26	33.83
C6	250.00	8°23'27"	36.61	18.34
C7	254.00	16°52'35"	74.82	37.68
C8	250.00	09°08'49"	39.91	20.00
C9	2.00	179°40'27"	6.27	INFINITE
C10	100.00	17°43'32"	30.94	15.58
C11	100.00	23°22'29"	40.80	20.69
C12	100.00	20°28'30"	35.74	18.06
C13	30.00	86°54'24"	45.50	28.42

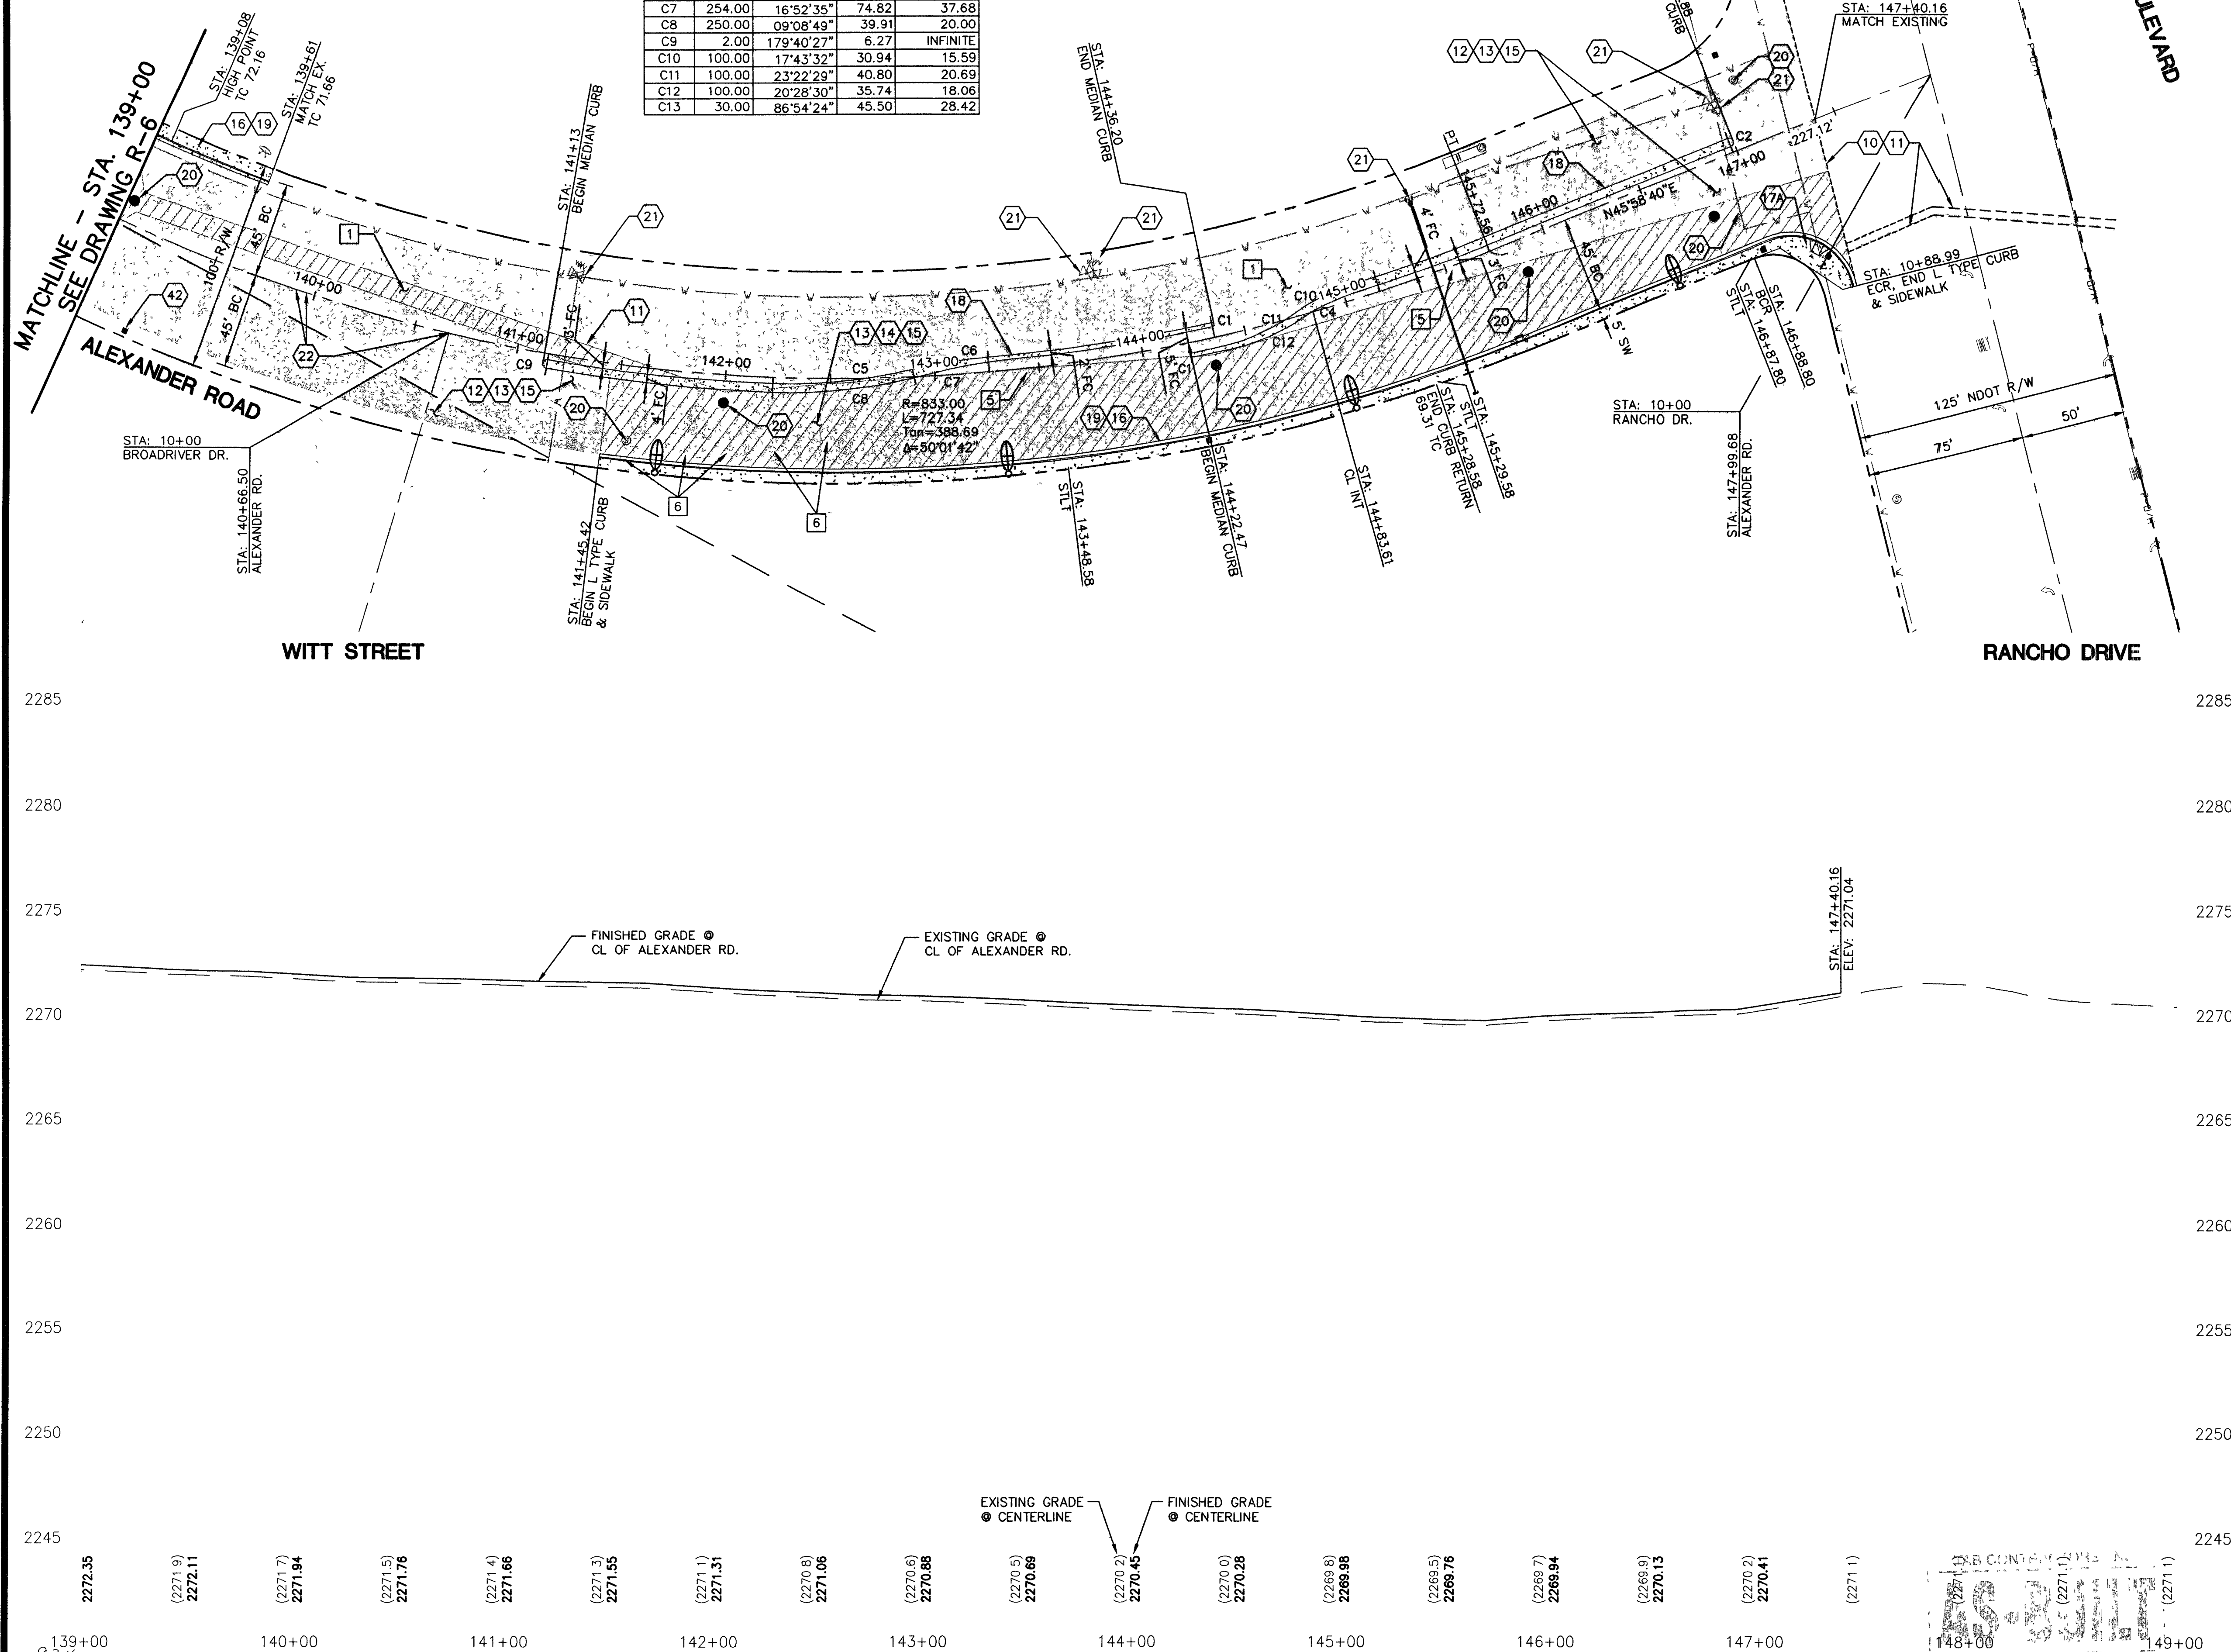

Stantec

Stantec Consulting Inc
6763 W Charleston Blvd.
Las Vegas NV U.S.A.
89146-1049
Tel 702.258 0115
Fax 702.258 4956
www.stantec.com

REMOVAL NOTES:

- | | |
|---|-------------|
| 1 | AC PAVEMENT |
| 5 | MEDIAN CURB |
| 6 | STREET SIGN |


CONSTRUCTION NOTES:

- (10) MATCH EXISTING
- (11) SAWCUT
- (12) ROTOMILL (SEE NOTE 2)
- (13) 3" AC PAVEMENT OVERLAY
- (14) 2" AC PAVEMENT REPLACEMENT
- (15) 3/4" OPEN GRADE
- (16) L TYPE CURB & GUTTER PER USD NO. 216
- (17) TYPE III SIDEWALK RAMP PER USD NO. 235
- (18) TYPE II SIDEWALK RAMP PER USD NO. 235
- (19) TACK-ON MEDIAN CURB PER USD NO. 221
- (20) SIDEWALK PER USD NO. 234
- (21) ADJUST MANHOLE WITH COLLAR PER USD NO. 408
- (22) ADJUST WATER VALVE BOX TO FINISHED GRADE PER UDACS PLATE 8. VALVE SHALL BE ACCESSIBLE AT ALL TIMES.
- (23) RE-ESTABLISH SURVEY MARKER
- (24) DRIVEWAY PER USD NO. 225
- (25) P30 PULLBOX

NOTES:


1. ALL GEOMETRY ON MEDIAN CURBS IS TO FACE OF CURB.
2. ROTOMILL QUANTITY EXCLUDES TRENCH AND PAVEMENT REPLACEMENT.
3. CENTERLINE GRADE SHOWN IS SURFACE OF OPEN GRADE SEE SECTION

4. SEE SHEET R-9 FOR ALEXANDER ROAD - RANCHO DRIVE GRADING PLAN.
5. SEE SHEETS U-1 THRU U-6 FOR UTILITY PLANS.
6. SEE SHEETS T-1 THRU T-2 FOR STRIPING PLANS.

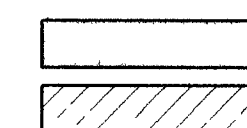

3" AC PAVEMENT
2" AC PAVEMENT

LVVWD _____ DATE _____

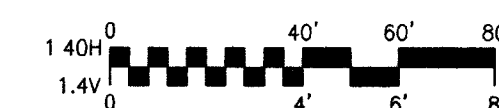

Avoid overhead power line contact. It's costly.

Avoid cutting underground utility lines. It's costly.

Call
before you
OVERHEAD

**Call
before you
Dig**


1-702-593-6111

1-800-227-2600



DEPARTMENT OF PUBLIC WORKS
 ENGINEERING DESIGN SECTION

**ALEXANDER ROAD
US 95 TO RANCHO DRIVE
ROADWAY PLAN + PROFILE
STA. 139+00 TO STA. 149+00**

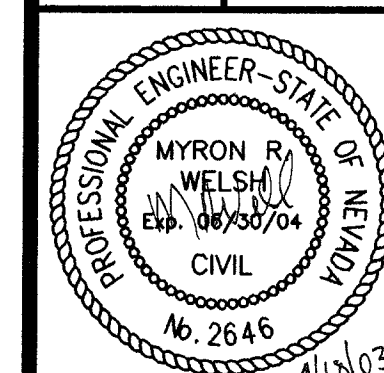

Sheet
R-7
15 of 35
DRAWING NO.
107-V3634