Stantec Consulting Inc.
6763 W Charleston Blvd
Las Vegas NV U.S.A.
89146-1049
Tel. 702.258 0115
Fax 702.258 4956
www.stantec.com

Stantec

POINT	STATION	OFFSET
20000	99+67.30	-41.2022
20001	99+99.93	-39.3613
20002	100+31.69	-40.695
20003	100+33.19	-20.3475
20004	99+99.97	-19.6806
20005	99+67.33	-20.6011
20006	99+67.36	0
20007	100+00	0
20008	100+34.68	0
20009	100+36.30	21.9486
20010	100+02.41	22.8365
20011	99+67.40	22.221
20012	99+67.43	44.4421
20013	100+04.81	45.6729
20014	100+37.91	43.8971

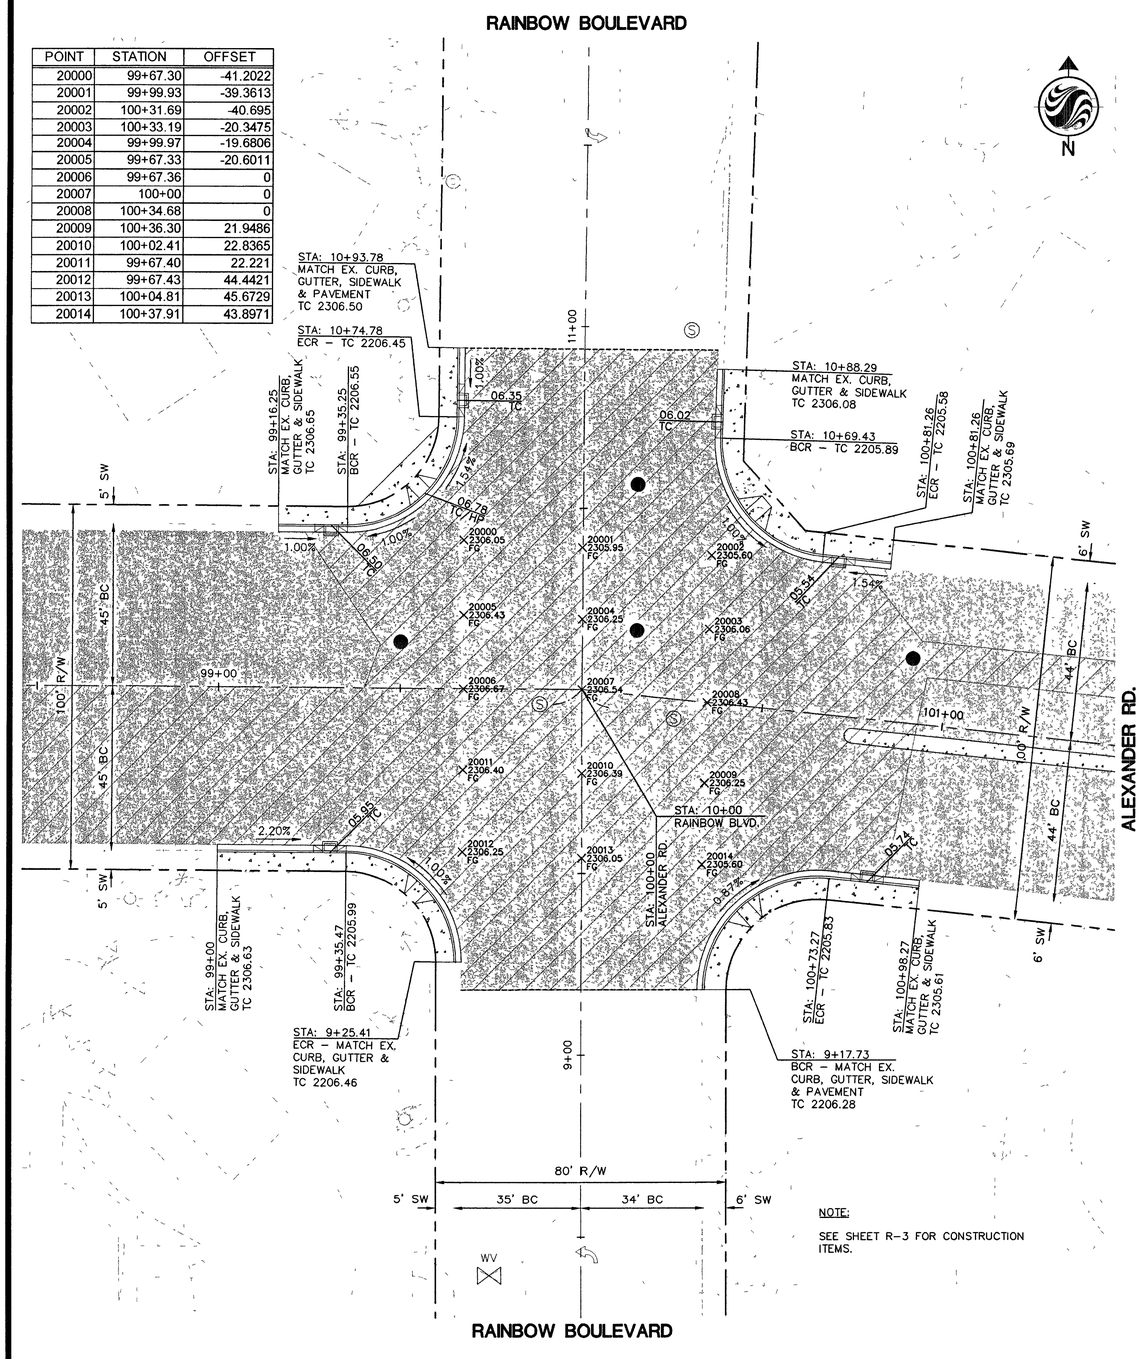

NOTE:

SEE SHEET R-3 FOR CONSTRUCTION ITEMS.

INTERSECTION GRADING PLAN
ALEXANDER RD. - RAINBOW BLVD.

1:20 0 20' 30' 40'

POINT	STATION	OFFSET
20015	124+63.77	-41.9965
20016	124+96.07	-41 9934
20017	125+28.11	-41.9965
20018	125+30.21	-20 9983
20019	124+98.24	-20.9967
20020	124+65.87	-20 9983
20021	124+67.98	0
20022	125+00.42	0
20023	125+32.30	0
20024	125+34.40	21 0018
20025	125+02.45	21 0034
20026	124+70.08	21 0018
20027	124+72.19	42.0037
20028	125+04.47	42.0068
20029	125+36.50	42 0036

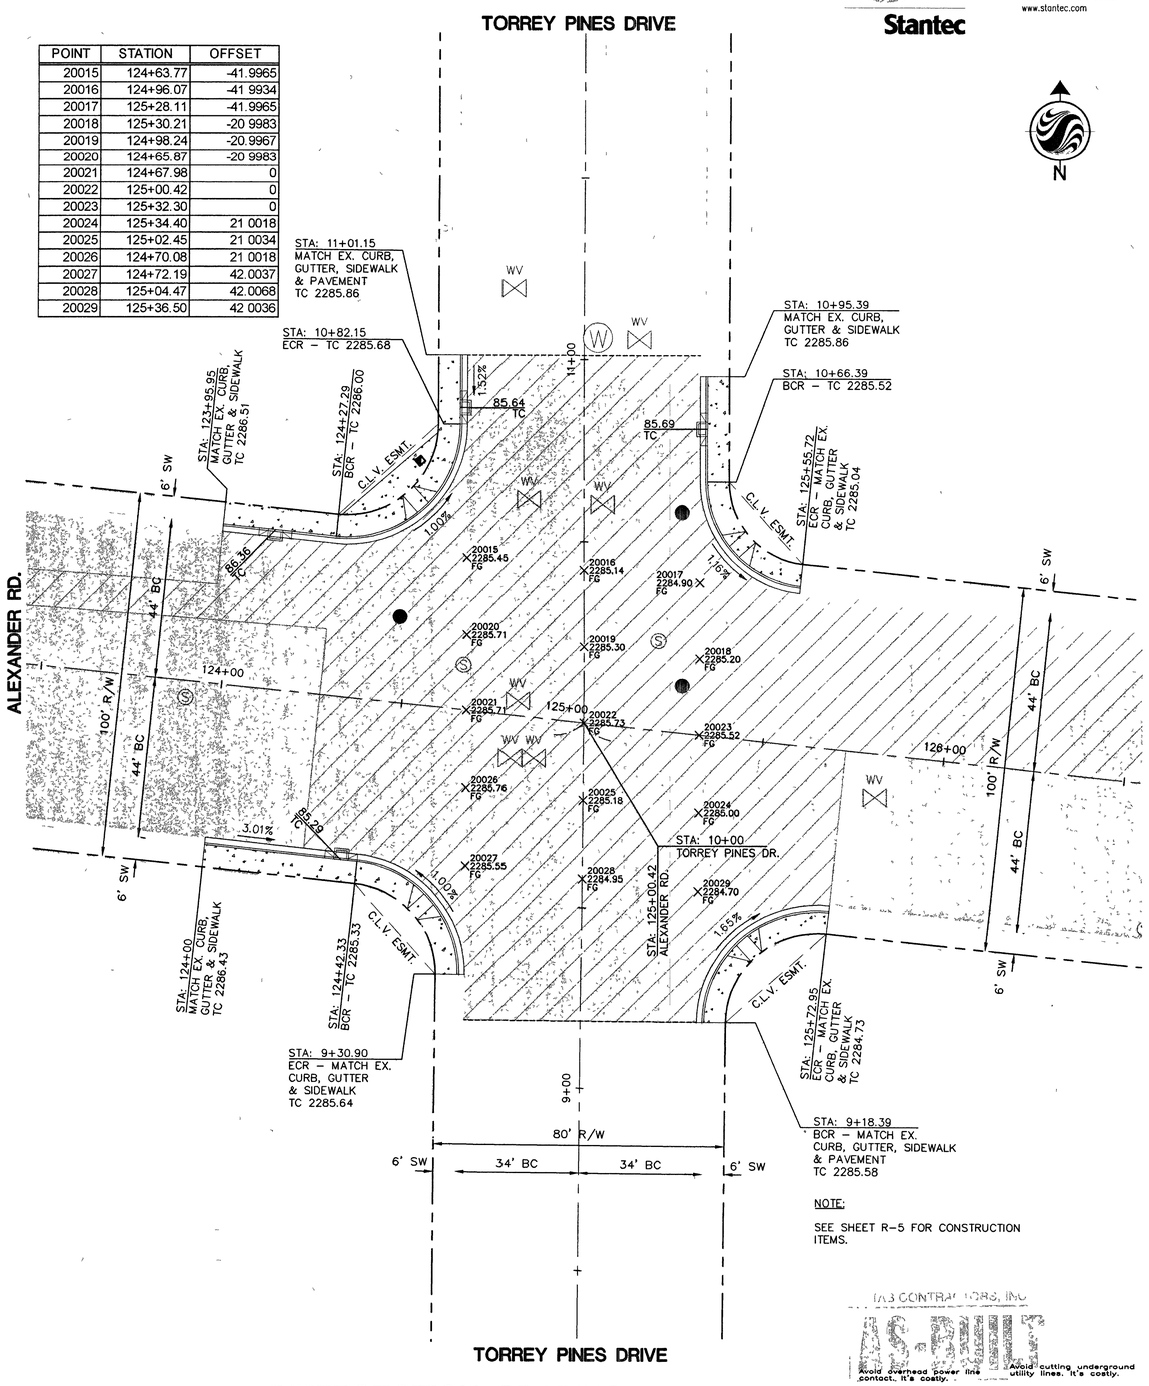

NOTE:

SEE SHEET R-5 FOR CONSTRUCTION ITEMS.

TAB CONTRACTORS, INC.

AS-BUILT

INTERSECTION GRADING PLAN
ALEXANDER RD. - TORREY PINES DR.

1:20 0 20' 30' 40'

Call before you OVERHEAD
1-702-593-6111

Avoid overhead power line contact. It's costly.

Call before you Dig
1-800-227-2600

Avoid cutting underground utility lines. It's costly.

NO.	DATE:	DESCRIPTION	APP'D

REVISIONS

DEPARTMENT OF PUBLIC WORKS
ENGINEERING DESIGN SECTION

CITY ENGINEER: CHARLES KAJKOWSKI JR, P.E.

DESIGNED BY: JO,DD
DRAWN BY: DD
CHECKED BY: MW

HORIZONTAL SCALE: 1"= 20'
VERTICAL SCALE: NONE
DATE: 06/11/02

TITLE: ALEXANDER ROAD US 95 TO RANCHO DRIVE

SHEET: INTERSECTION GRADING PLAN - 1

PROFESSIONAL ENGINEER - STATE OF NEVADA
MYRON R. WELSH
Exp. 06/30/04
CIVIL
No. 2646
4/4/03

Sheet R-8
16 of 35
DRAWING NO. 107-V3634

93401