




Stantec Consulting Inc.  
 6763 W Charleston Blvd  
 Las Vegas NV U.S.A.  
 89146-1049  
 Tel 702.258.0115  
 Fax 702.258.4956  
 www.stantec.com

REVISIONS	NO.	DATE	DESCRIPTION	APP'D.

DEPARTMENT OF PUBLIC WORKS  
 ENGINEERING DESIGN SECTION  
 CITY ENGINEER: CHARLES KAJKOWSKI JR., P.E.  
 DESIGNED BY: JO,DD AS SHOWN  
 DRAWN BY: DD VERTICAL SCALE: NONE  
 CHECKED BY: MW DATE: 08/20/02


TITLE: ALEXANDER ROAD  
 US 95 TO RANCHO DRIVE  
 SHEET: MISCELLANEOUS DETAILS

PROFESSIONAL ENGINEER - STATE OF NEVADA  
 MYRON R. WELLS  
 Exp. 04/30/04  
 No. 2646  
 CIVIL  
 Sheet R-10  
 18 of 35  
 DRAWING NO. 107-V3634

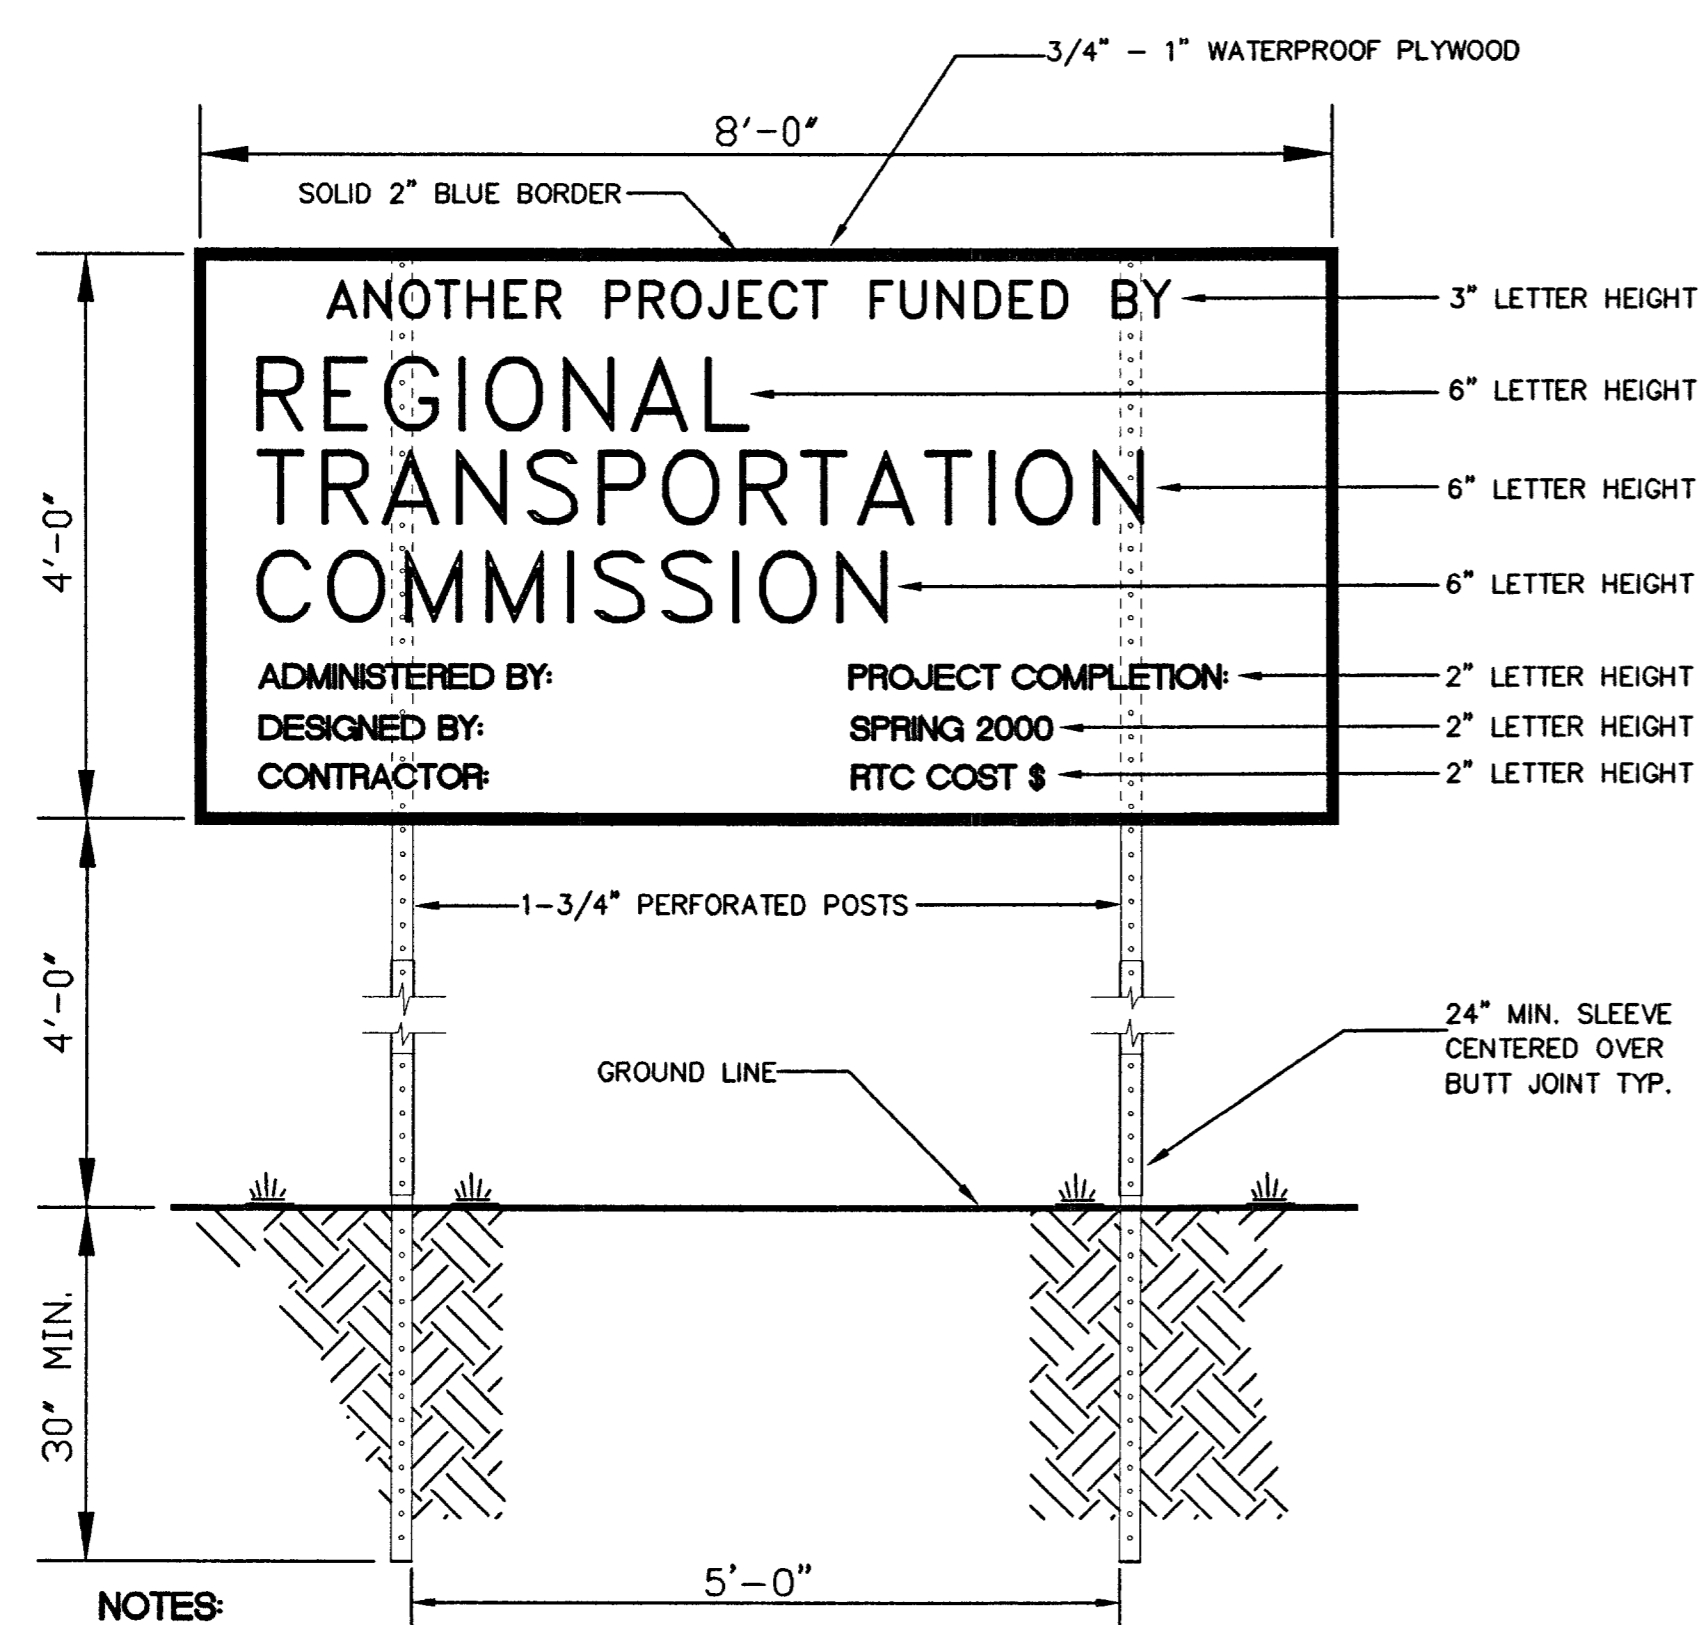

- NOTES:
1. SIGNS SHALL BE PLACED OUTSIDE OF RIGHT-OF-WAY.
  2. FIELD SHALL BE WHITE.
  3. ALL LETTERS AND NUMBERS SHALL BE SERIES "C" REFLECTIVE MATERIAL. THE FIRST LETTER OF THE WORDS REGIONAL, TRANSPORTATION, AND COMMISSION SHALL BE HIGHWAY RED. THE REMAINING LETTERS AND NUMBERS SHALL BE HIGHWAY BLUE.
  4. OTHER INFORMATION ON THE BOTTOM PORTION OF THE SIGN MAY BE AS DETERMINED BY THE ADMINISTERING ENTITY.

2 PROJECT SIGN  
 R-10 NOT TO SCALE

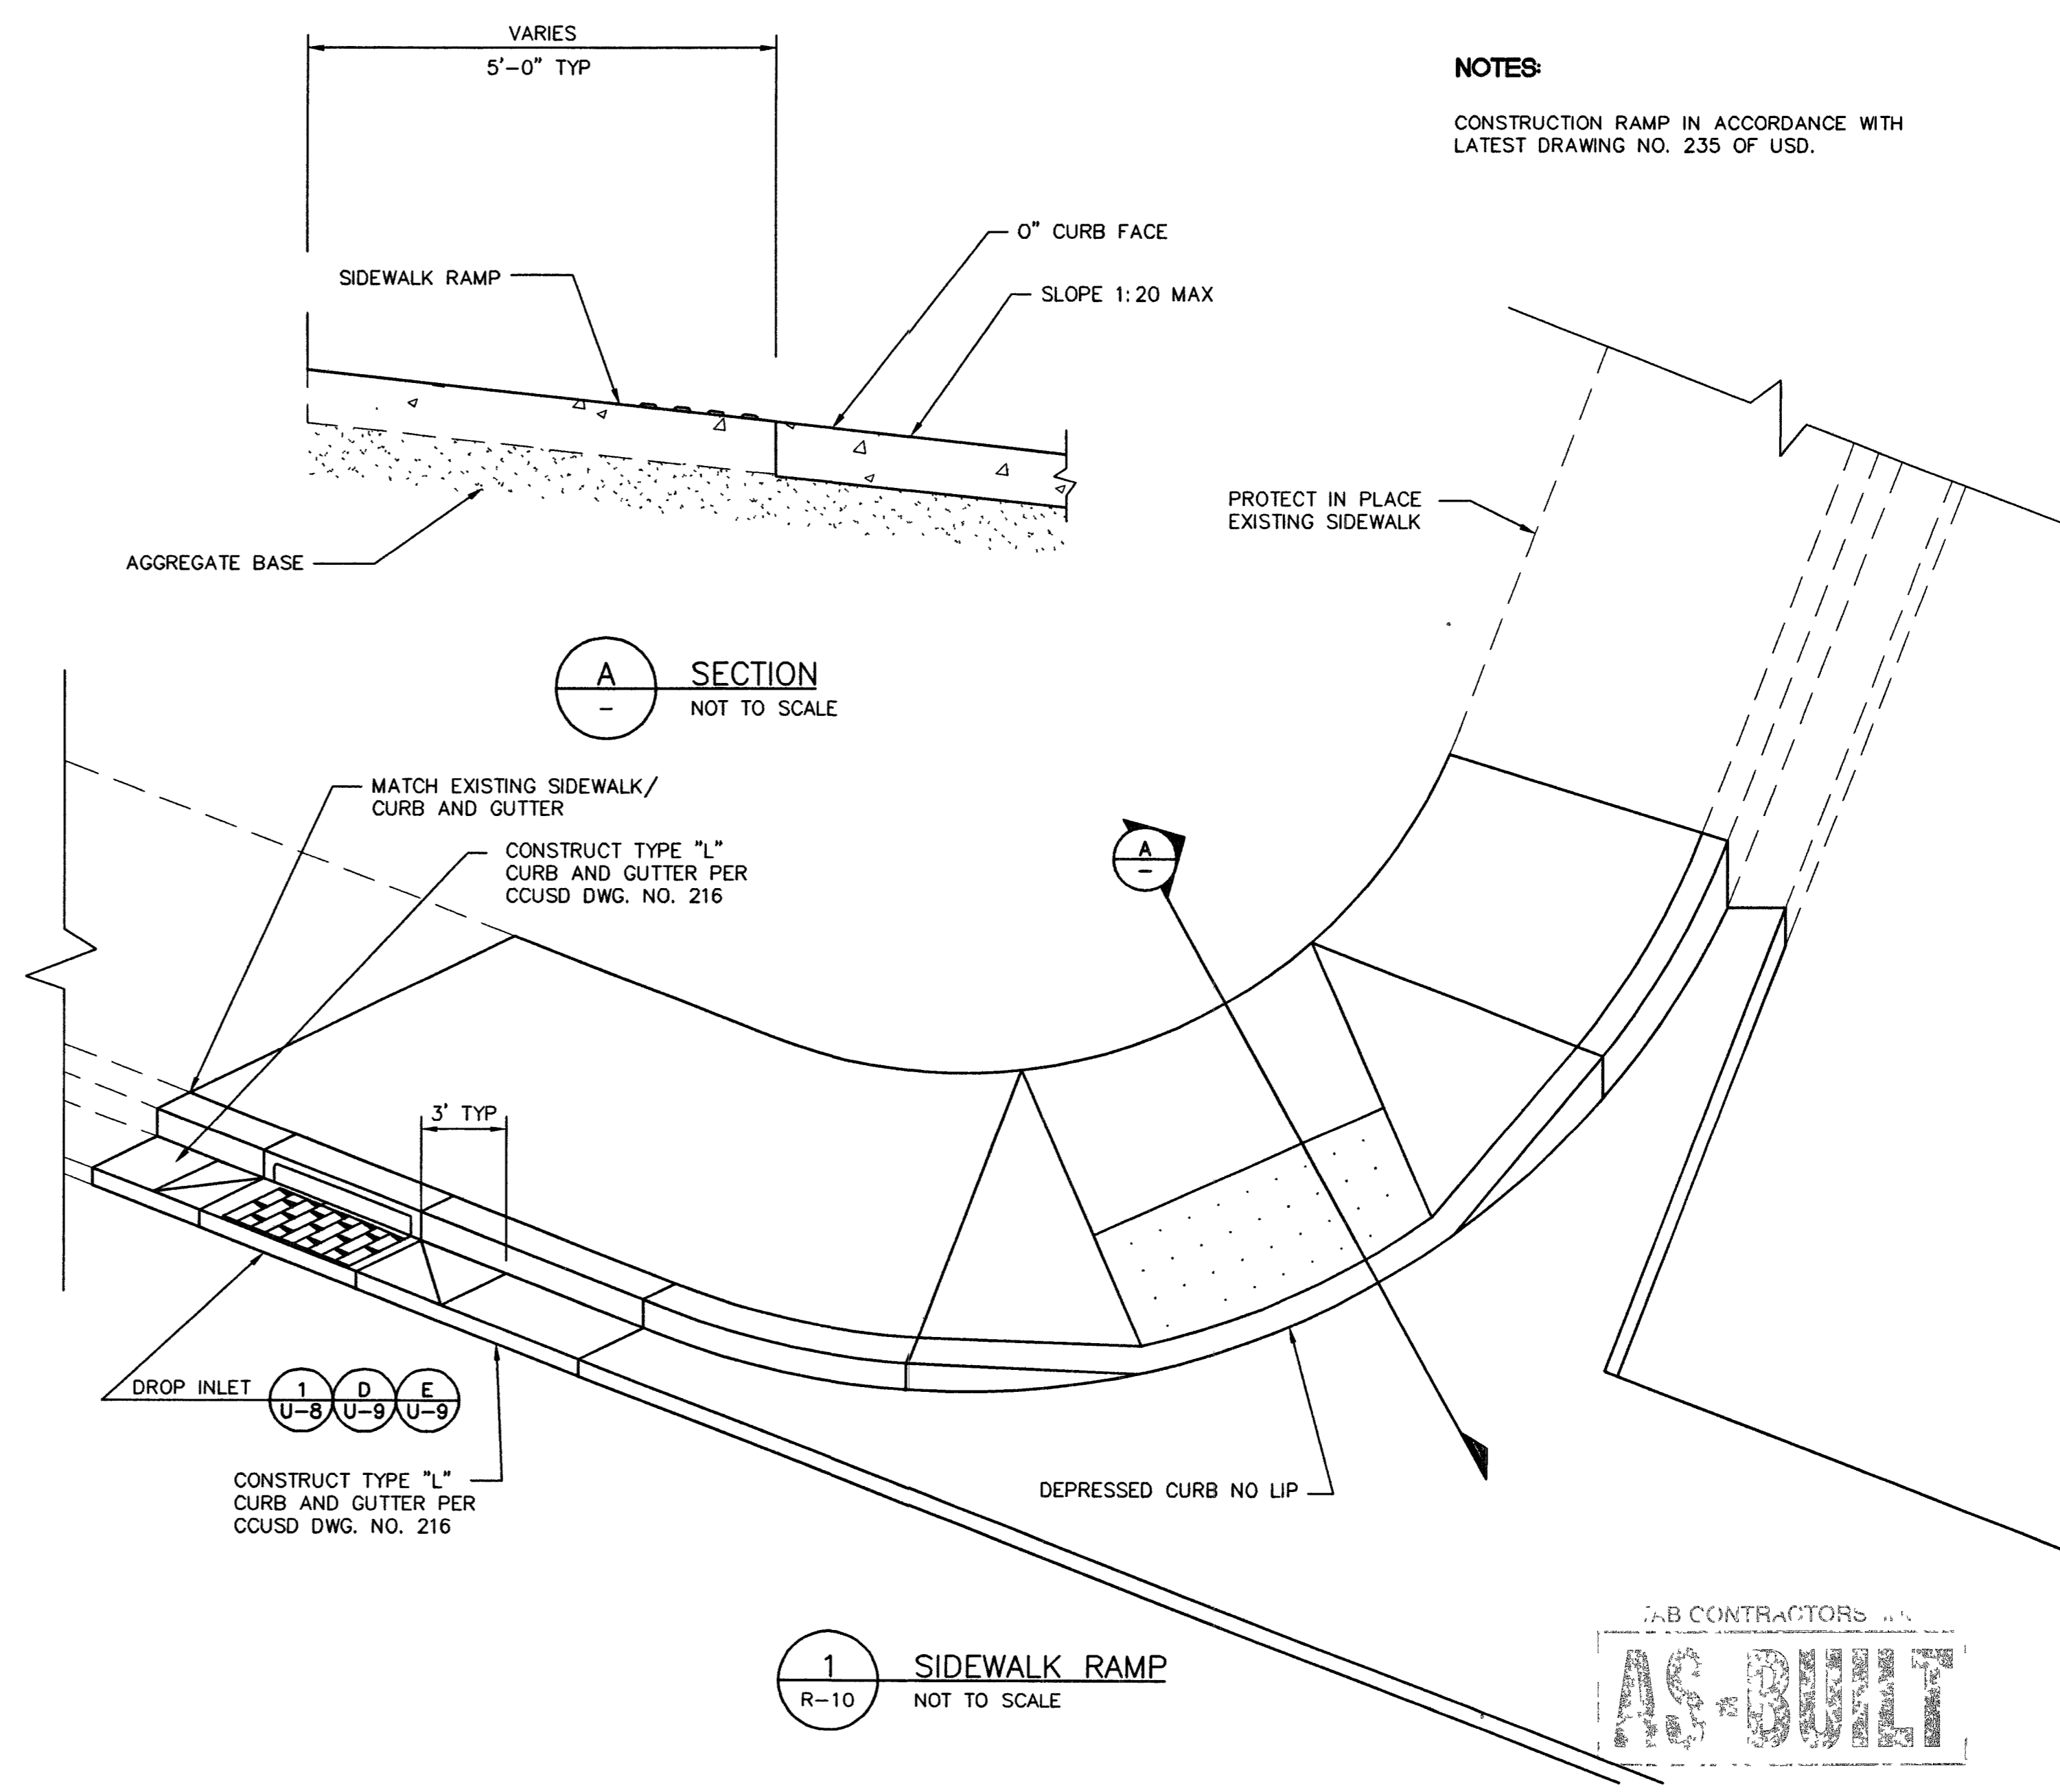

- NOTES:
- CONSTRUCTION RAMP IN ACCORDANCE WITH LATEST DRAWING NO. 235 OF USD.

A SECTION  
 NOT TO SCALE

1 SIDEWALK RAMP  
 R-10 NOT TO SCALE

93403