



**2 SECURED OPENING ELEVATION**  
SCALE: 1" = 1'-0"

REVISIONS AS PER  
GLENN R. 4/18/06

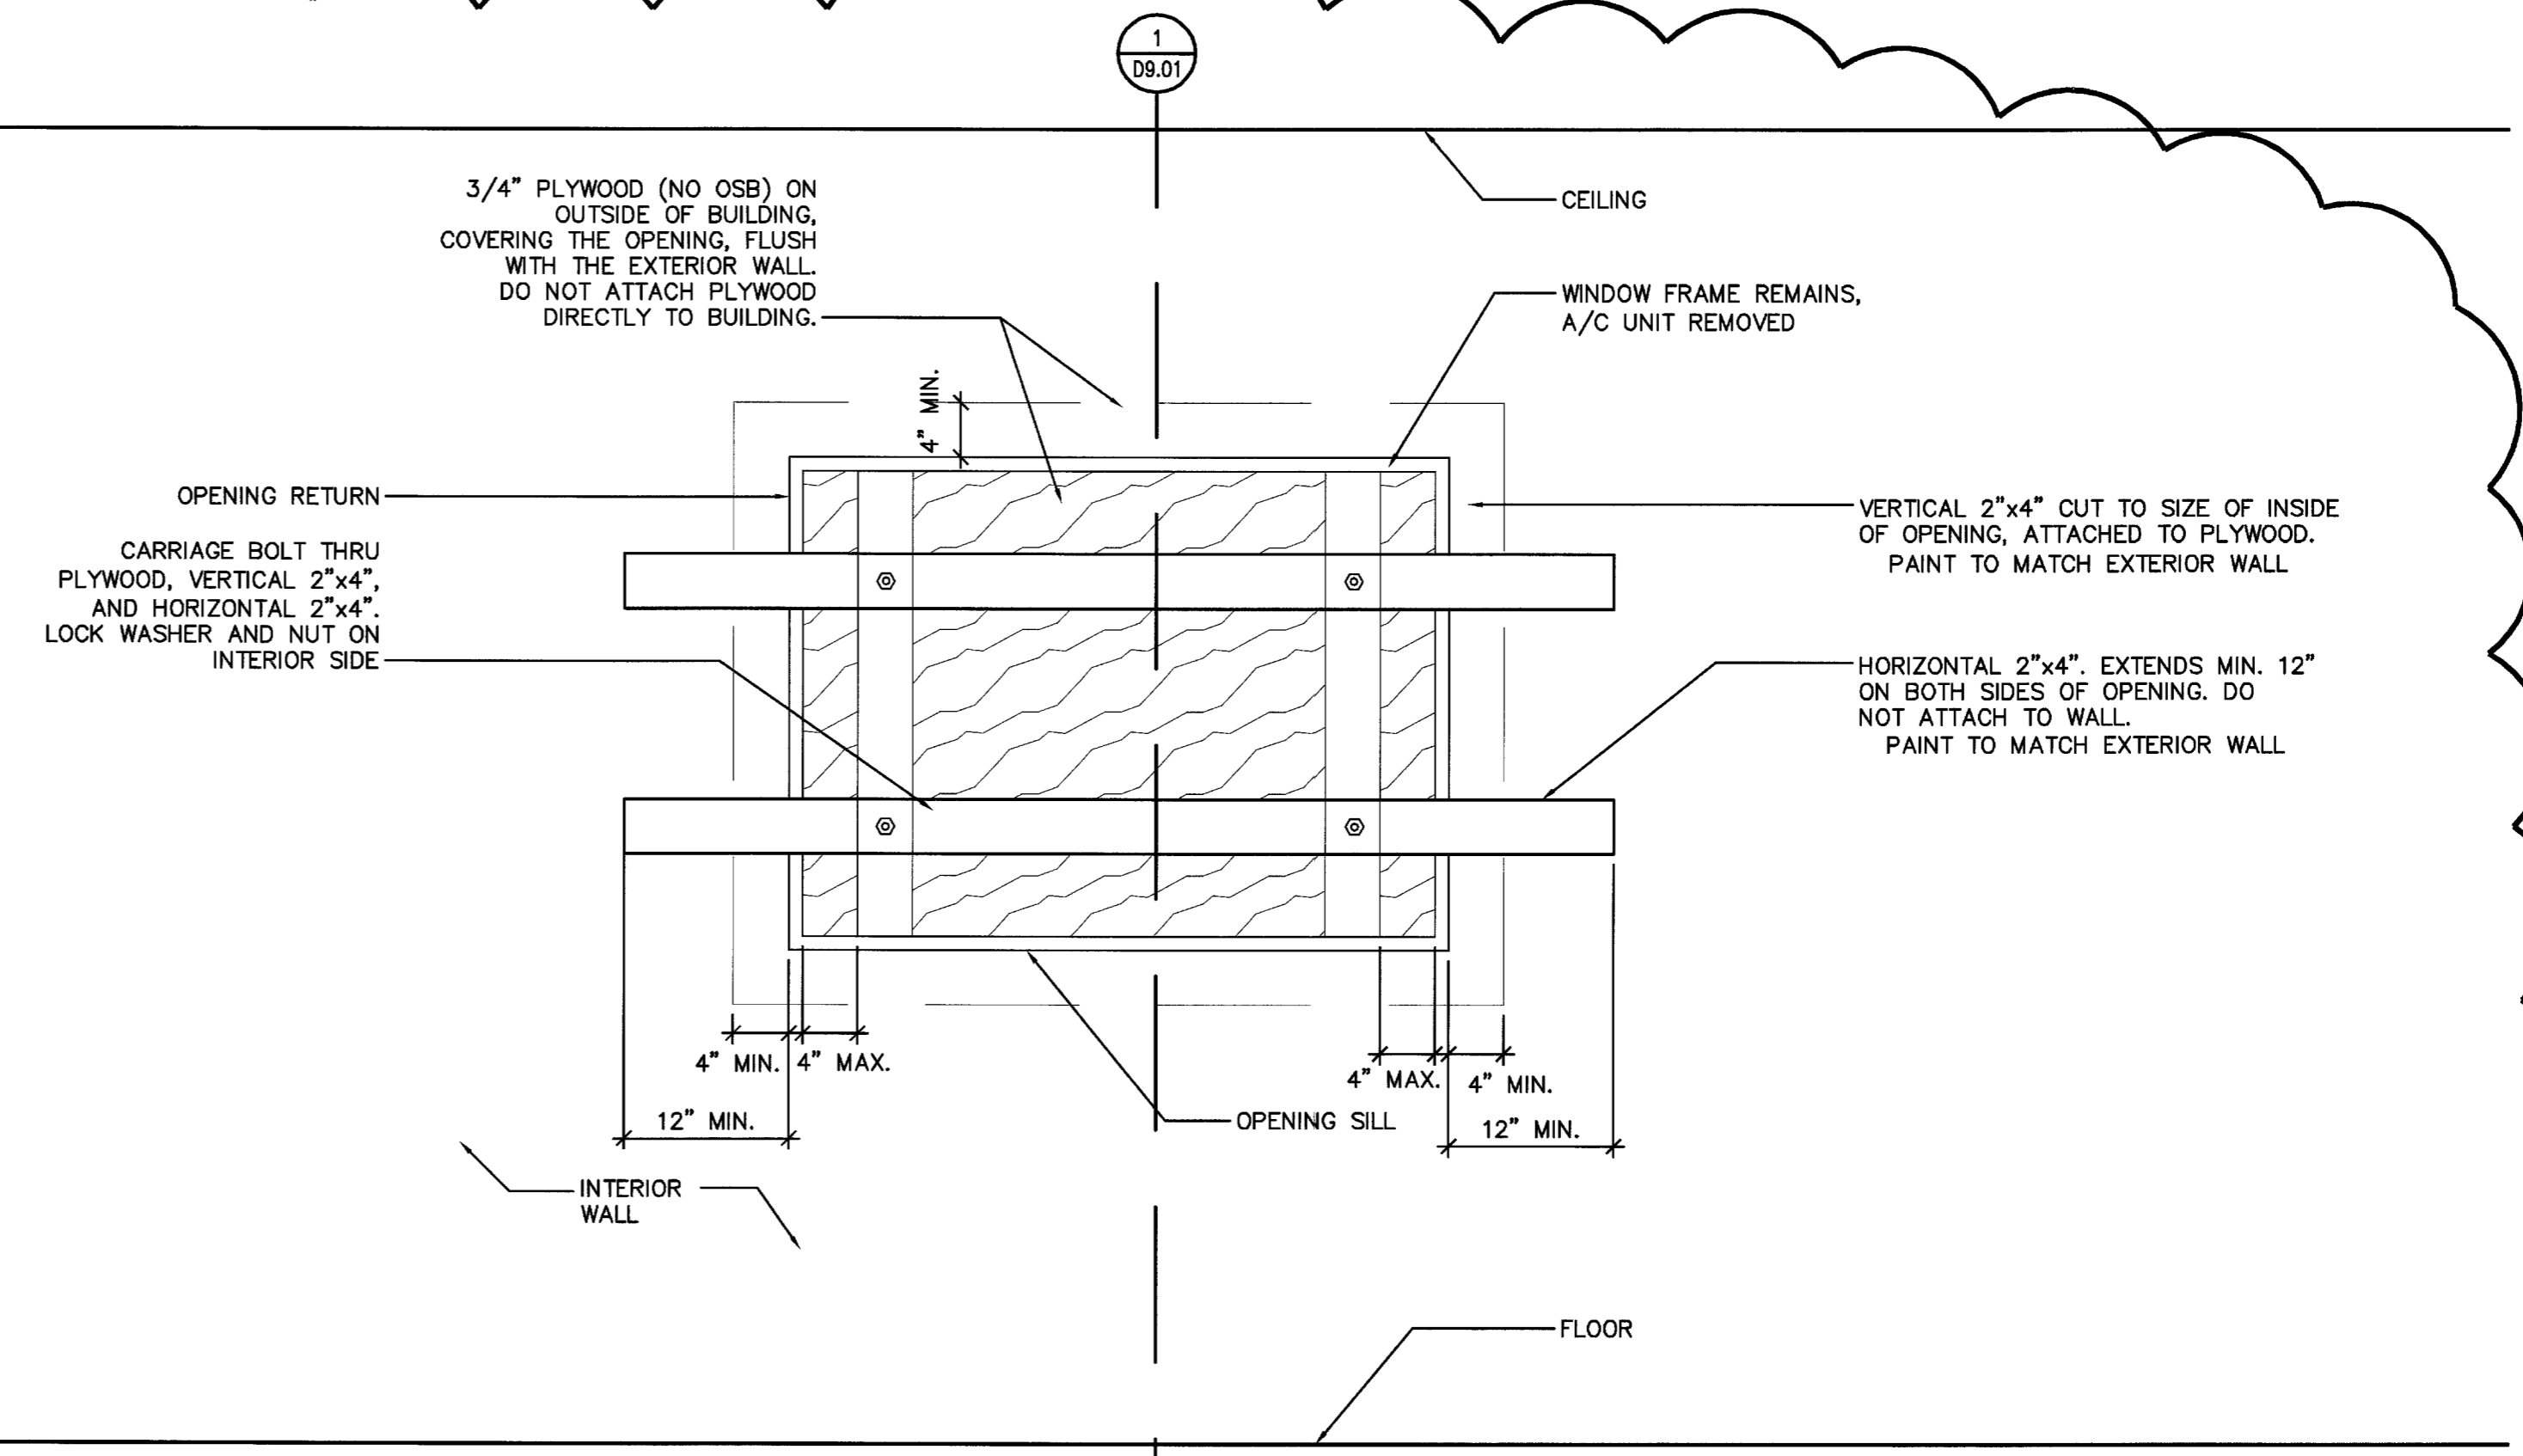

**1 SECURED OPENING DETAIL**  
SCALE: 1" = 1'-0"

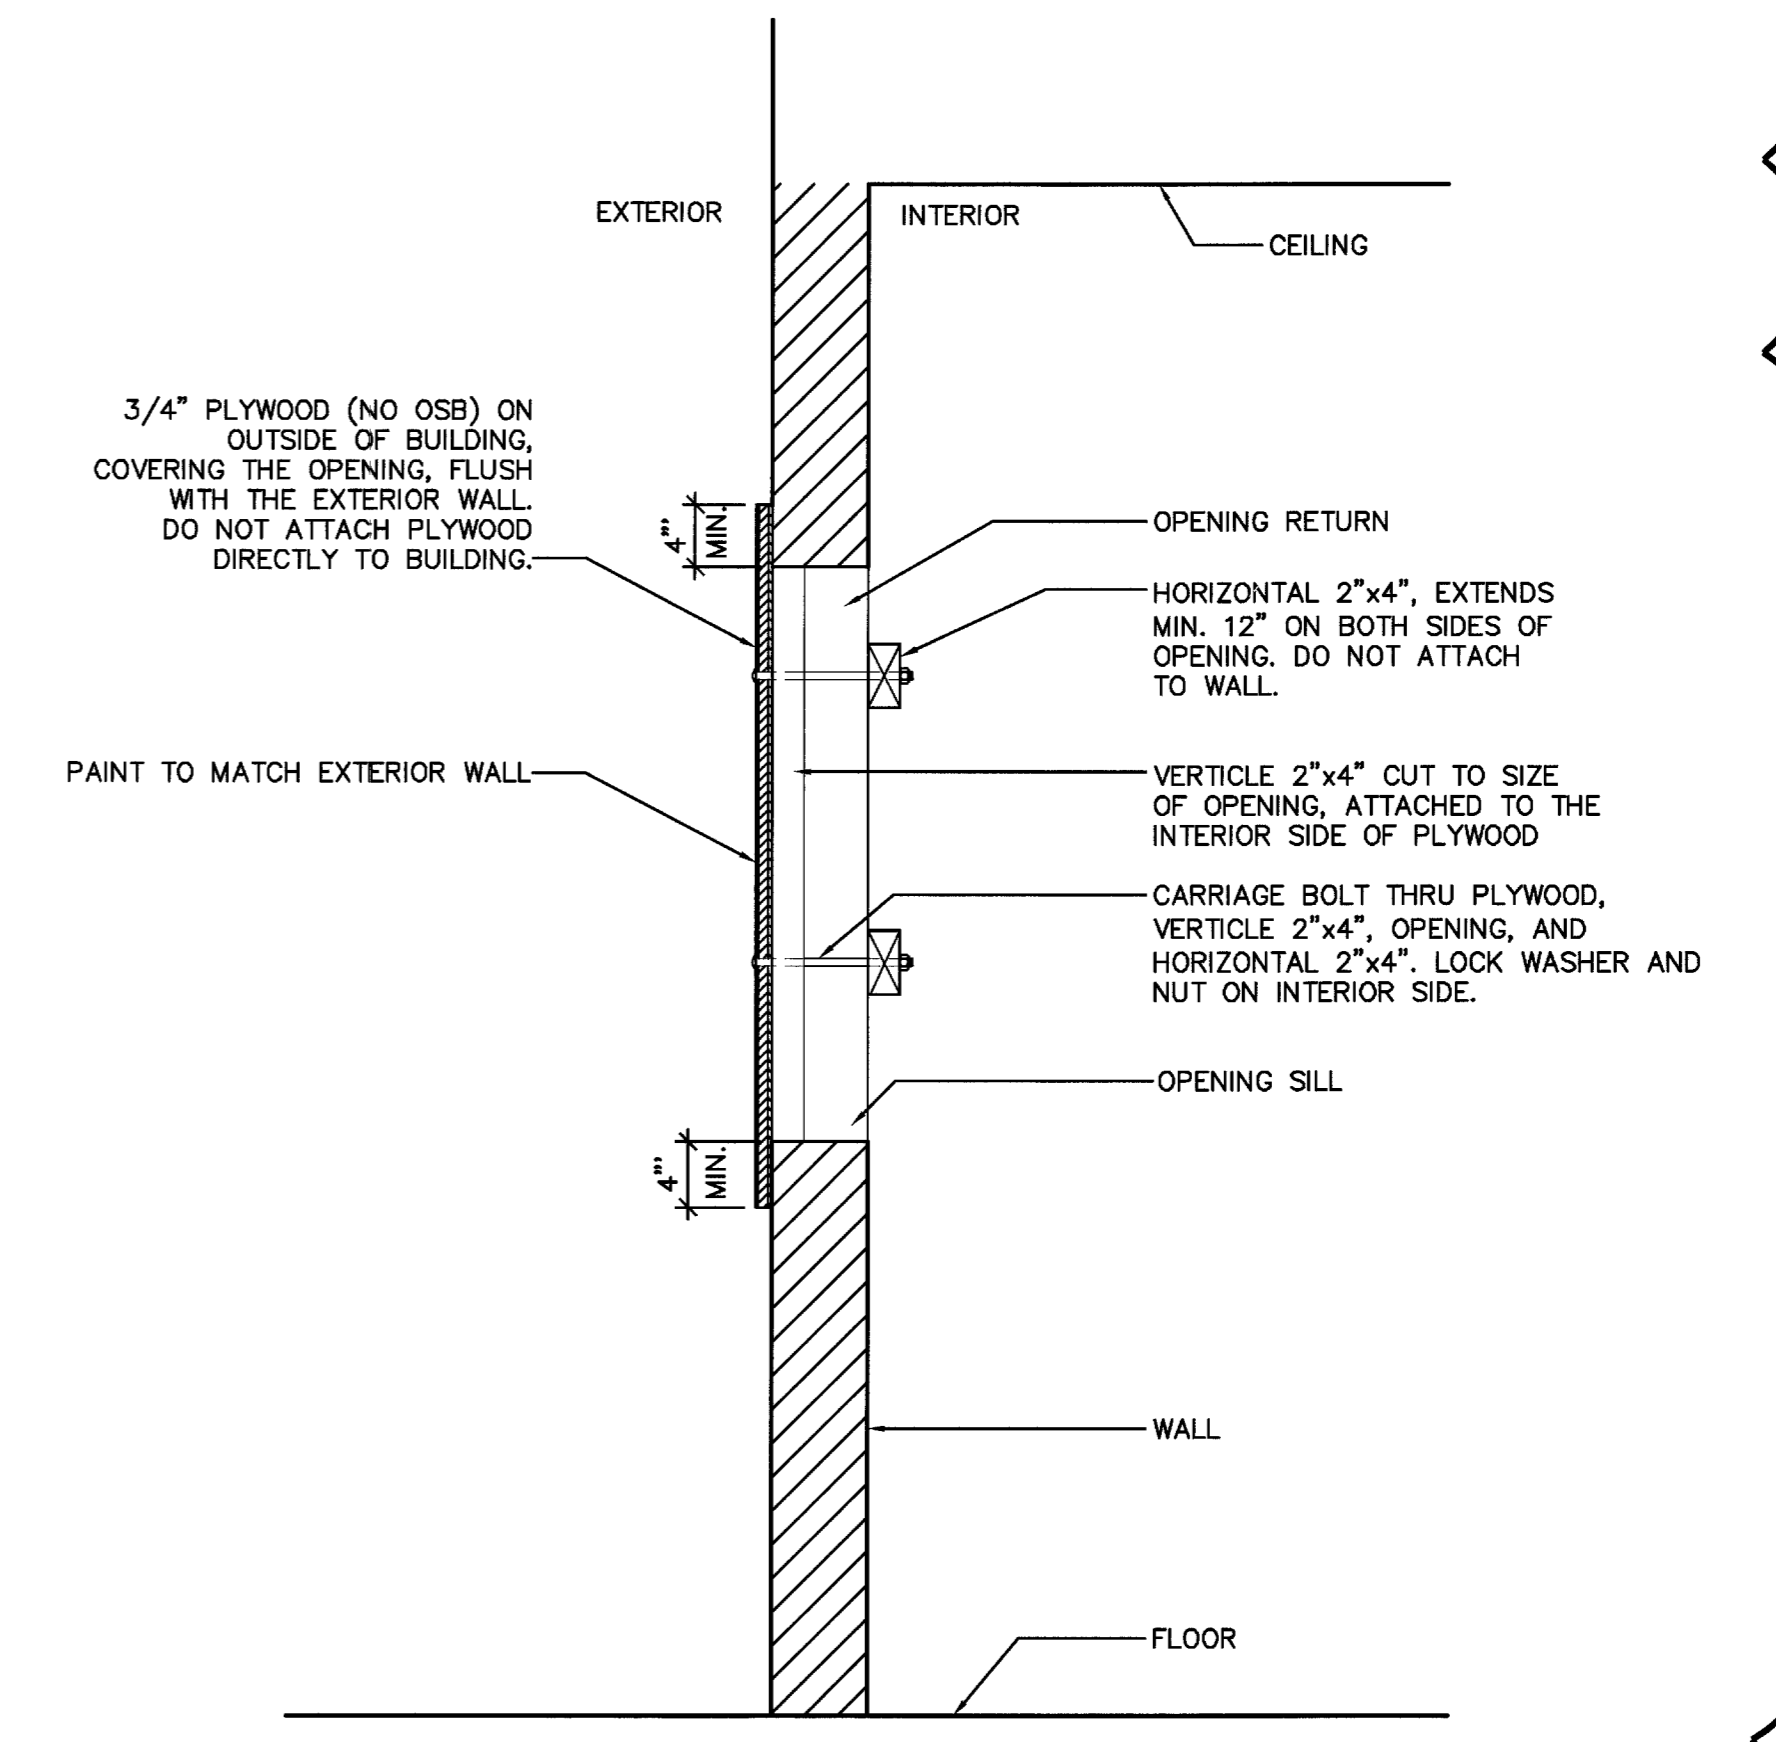

REVISIONS	
RECORD DOCUMENTS	DATE: 08/06/06
CONSULTANT	<p><b>ESTAR ARCHITECTS</b>  <b>ARCHITECTURE • PLANNING • INTERIOR DESIGN</b>          701 BRIDGER AVE., SUITE 400 LAS VEGAS, NEVADA 89101          TELEPHONE: (702) 878-0000 FAX: (702) 878-8430          www.wagnarchitects.com</p>
OWNER:	<p>5TH STREET SCHOOL - PHASE II          DEMOLITION BUILDING DETAILS          400 SOUTH LAS VEGAS BOULEVARD          LAS VEGAS, NEVADA 89101</p>
OWNER:	<p>CITY OF LAS VEGAS          DEPARTMENT OF PUBLIC WORKS          ARCHITECTURAL SERVICES</p>
OWNER:	<p>400 EAST STEWART AVENUE          LAS VEGAS, NEVADA 89101          PHONE: (702) 277-5335          FAX: (702) 384-4846          TDD: (702) 386-9108</p>
DRAWN	KDH
FILE	06161_D901.dwg
DATE	12.07.05
SCALE	AS NOTED
BID NO	06.15341.01
CLV DWG NO	513-650
SIT NO	D9.01