

This document, including the ideas and designs it contains, is an instrument of professional services rendered by the MESTAR Architectural Group/Neovada, Inc. / Engineer. This document may not be used or copied in whole, or in part, for any purpose other than the specific project without the expressed written consent of Mestor Architectural Group/Neovada, Inc.


PROJECT NUMBER	04488	DESIGNED BY	AJ
DRAWN BY	CBR	ISSUE DATE	Dec. 07, 2005
SCALE	AS SHOWN	DATE	8/11/06
REVISION DESCRIPTION	RECORD DOCUMENTS	NUMBER	
SHEET NUMBER	M1.01		

GENERAL NOTES

1. VERIFY ALL EXISTING FIELD CONDITIONS, PRIOR TO BIDDING.
2. REMOVE ALL EQUIPMENT NOTED. DO NOT ABANDON IN PLACE. ANY DUCTWORK, PIPING, CONTROLS, ETC.
3. REFER TO HAZARDOUS MATERIAL SPECIFICATIONS PRIOR TO ANY DEMOLITION WORK INCLUDING THE REMOVAL OF ANY EQUIPMENT.
4. DISPOSE ALL REFRIGERANTS ASSOCIATED WITH SPLIT SYSTEMS AND THERMOSTATS CONTAINING MERCURY PER FEDERAL REGULATIONS. SEE HAZARDOUS MATERIAL SPECIFICATIONS.

KEY NOTES

- ① REMOVE EXISTING EXHAUST DUCTS.
- ② HORIZONTAL INDOOR SINGLE-PACKAGE DX COOLING UNIT TO BE REMOVED WITH ALL ASSOCIATED DUCTWORK, GRILLES, DIFFUSERS, CONDENSATE & CONTROLS. CONTRACTOR TO SALVAGE THE UNITS WITH ASSOCIATED THERMOSTATS AND DELIVER THEM TO 3104 EAST BONANZA, LV, NV., ATTENTION JIM TAUS.
- ③ EXISTING SPLIT SYSTEM CONDENSING UNIT AND ASSOCIATED INDOOR FCU, REFRIGERANT LINES, DUCTWORK, GRILLES & DIFFUSERS, CONDENSATE LINES & CONTROLS TO BE REMOVED. CONTRACTOR TO SALVAGE INDOOR (FCU) WITH ASSOCIATED THERMOSTATS AND OUTDOOR (CU) UNITS & DELIVER TO 3104 EAST BONANZA, LV, NV. ATTENTION JIM TAUS.
- ④ REMOVE EXISTING INDOOR UNIT WITH ASSOCIATED CONDENSING UNIT INCLUDING ALL ASSOCIATED DUCTWORK, GRILLES AND DIFFUSERS, CONDENSATE LINES & CONTROLS.
- ⑤ REMOVE EXISTING EXHAUST FAN AND ALL ASSOCIATED DUCTWORK, GRILLES AND CONTROLS. SEAL WALL AND/OR ROOF WATERTIGHT.

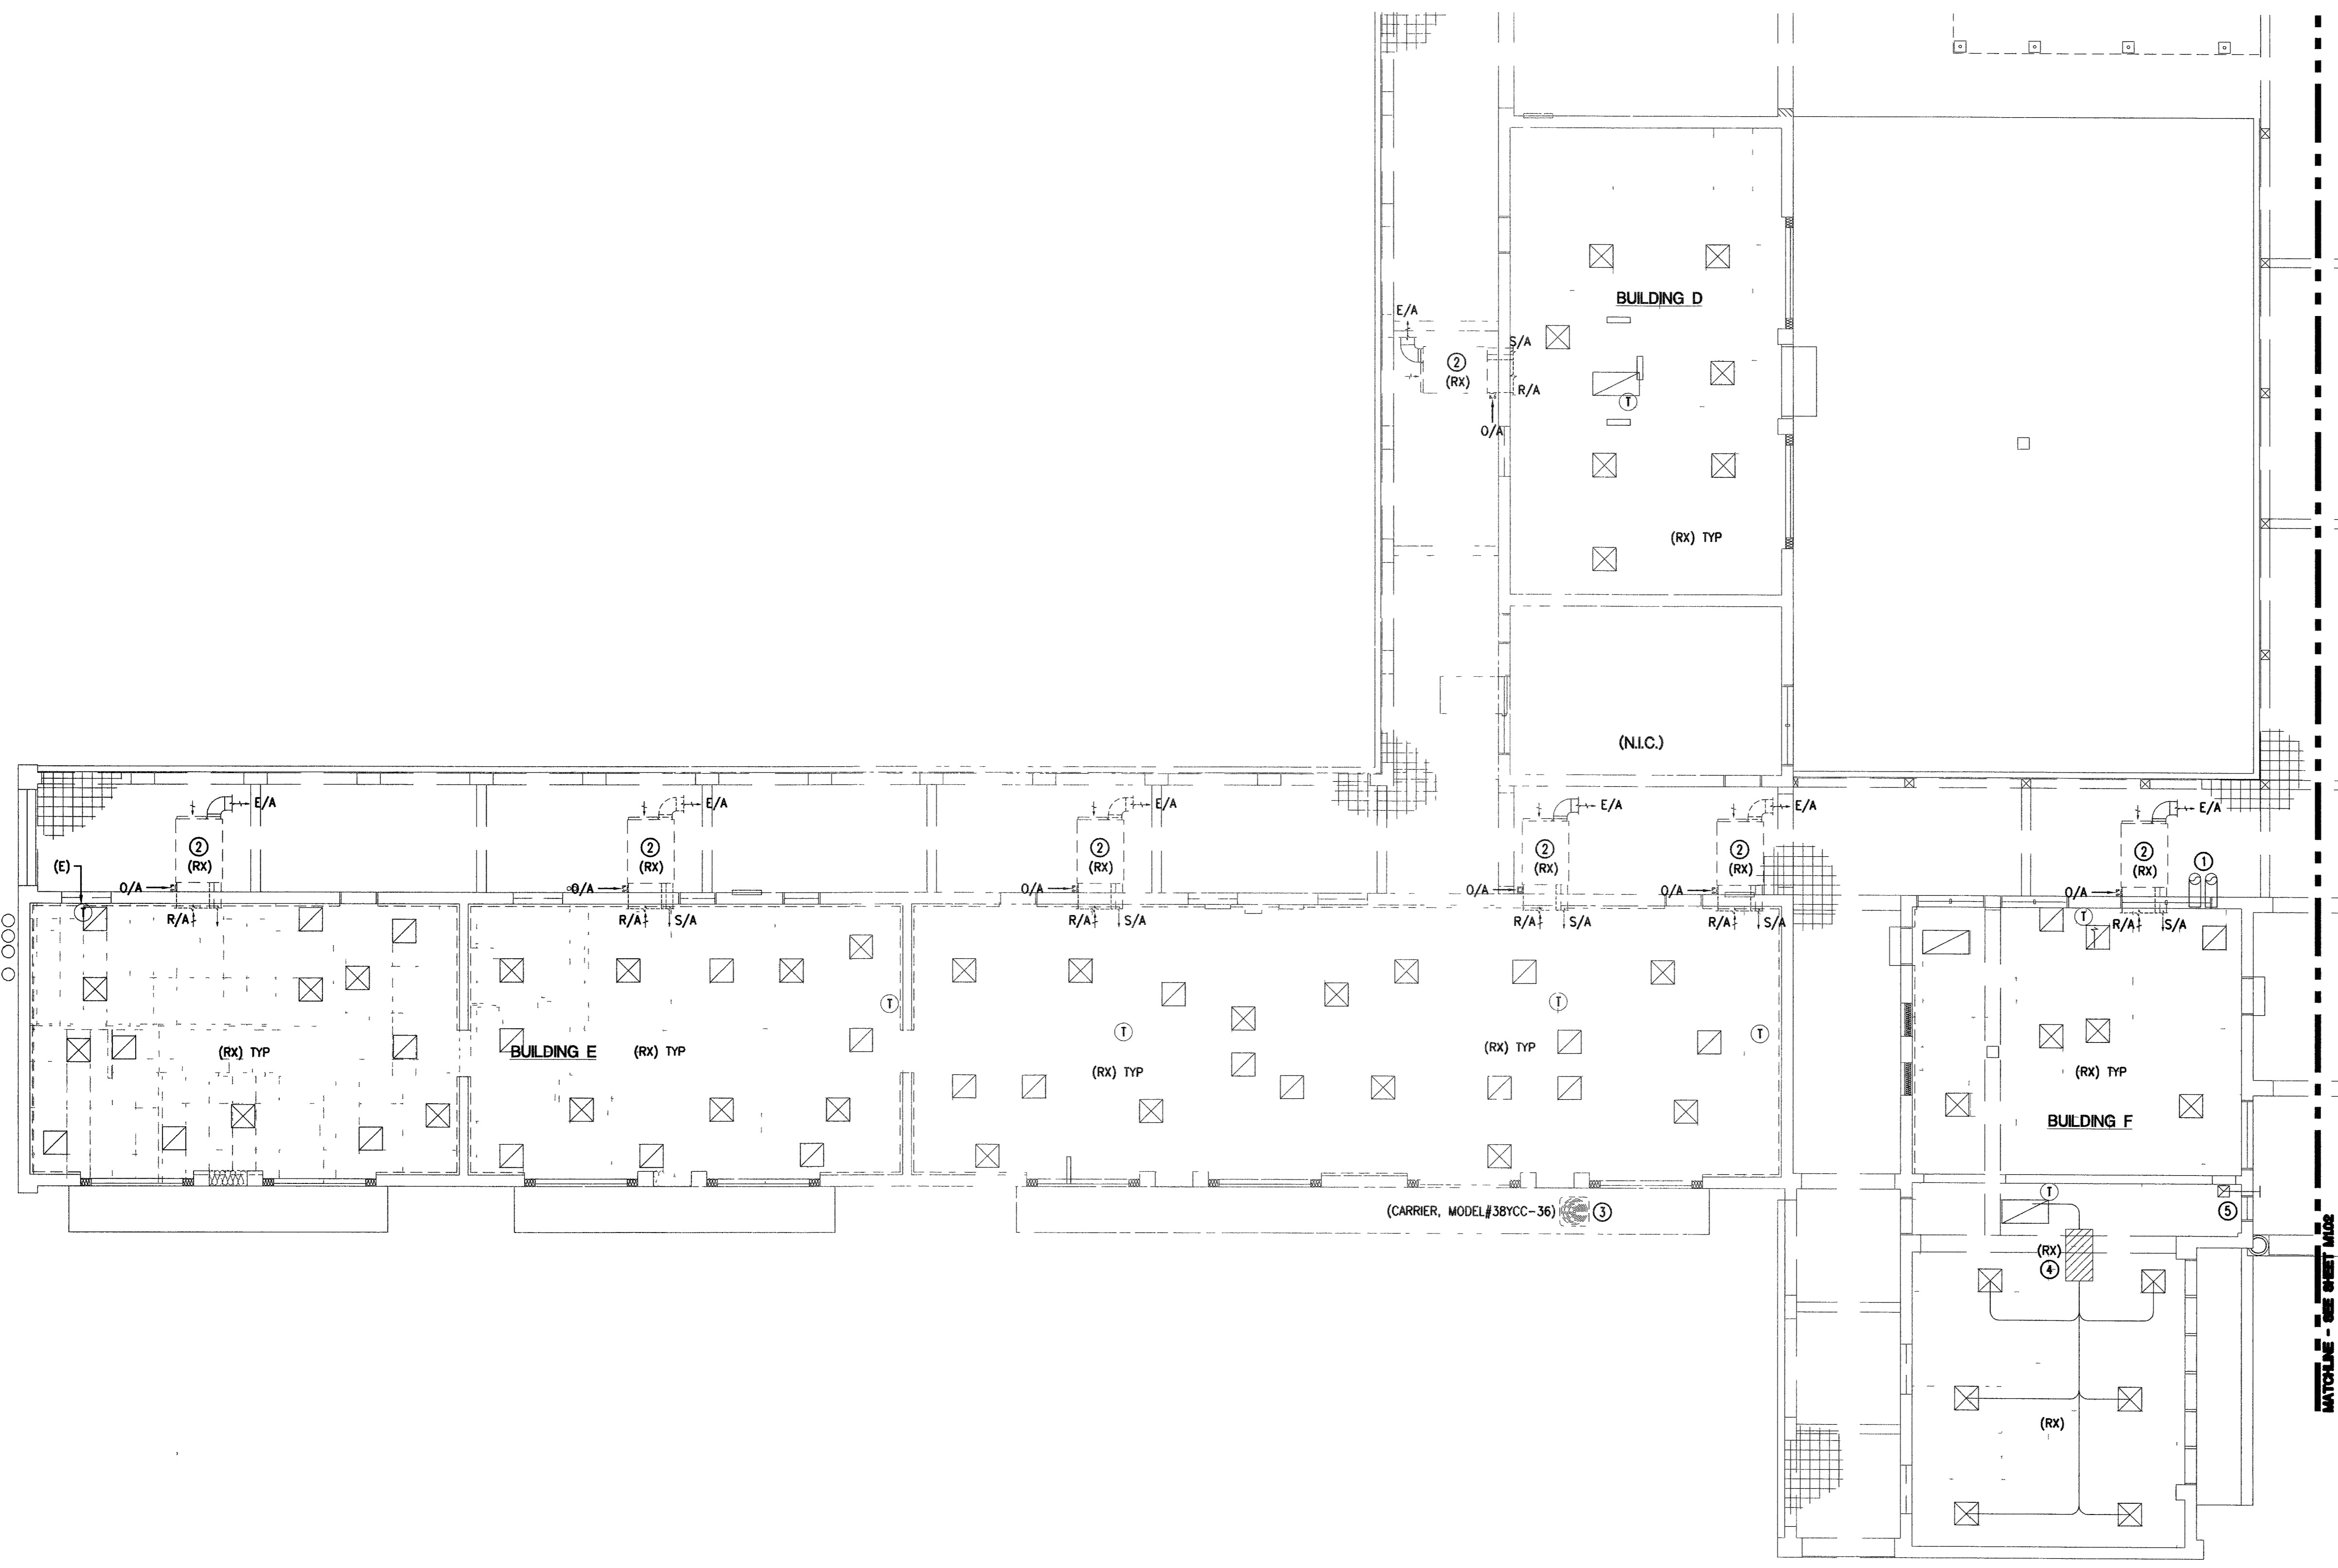

MECHANICAL DEMOLITION PLAN - BUILDINGS "D", "E" & "F"

SCALE: 1/8" = 1'-0"

96392



WORK COMPLETED PER PLANS

CONSTRUCTION DOCUMENT