This document, including the ideas and designs it contains, is an instrument of professional services rendered by the WESTAR Architectural Group/Nevada, Inc / Engineer. This document may not be used or copied in whole, or in part, for any purpose other than this specific project without the expressed written consent of Westar Architectural Group/Nevada, Inc

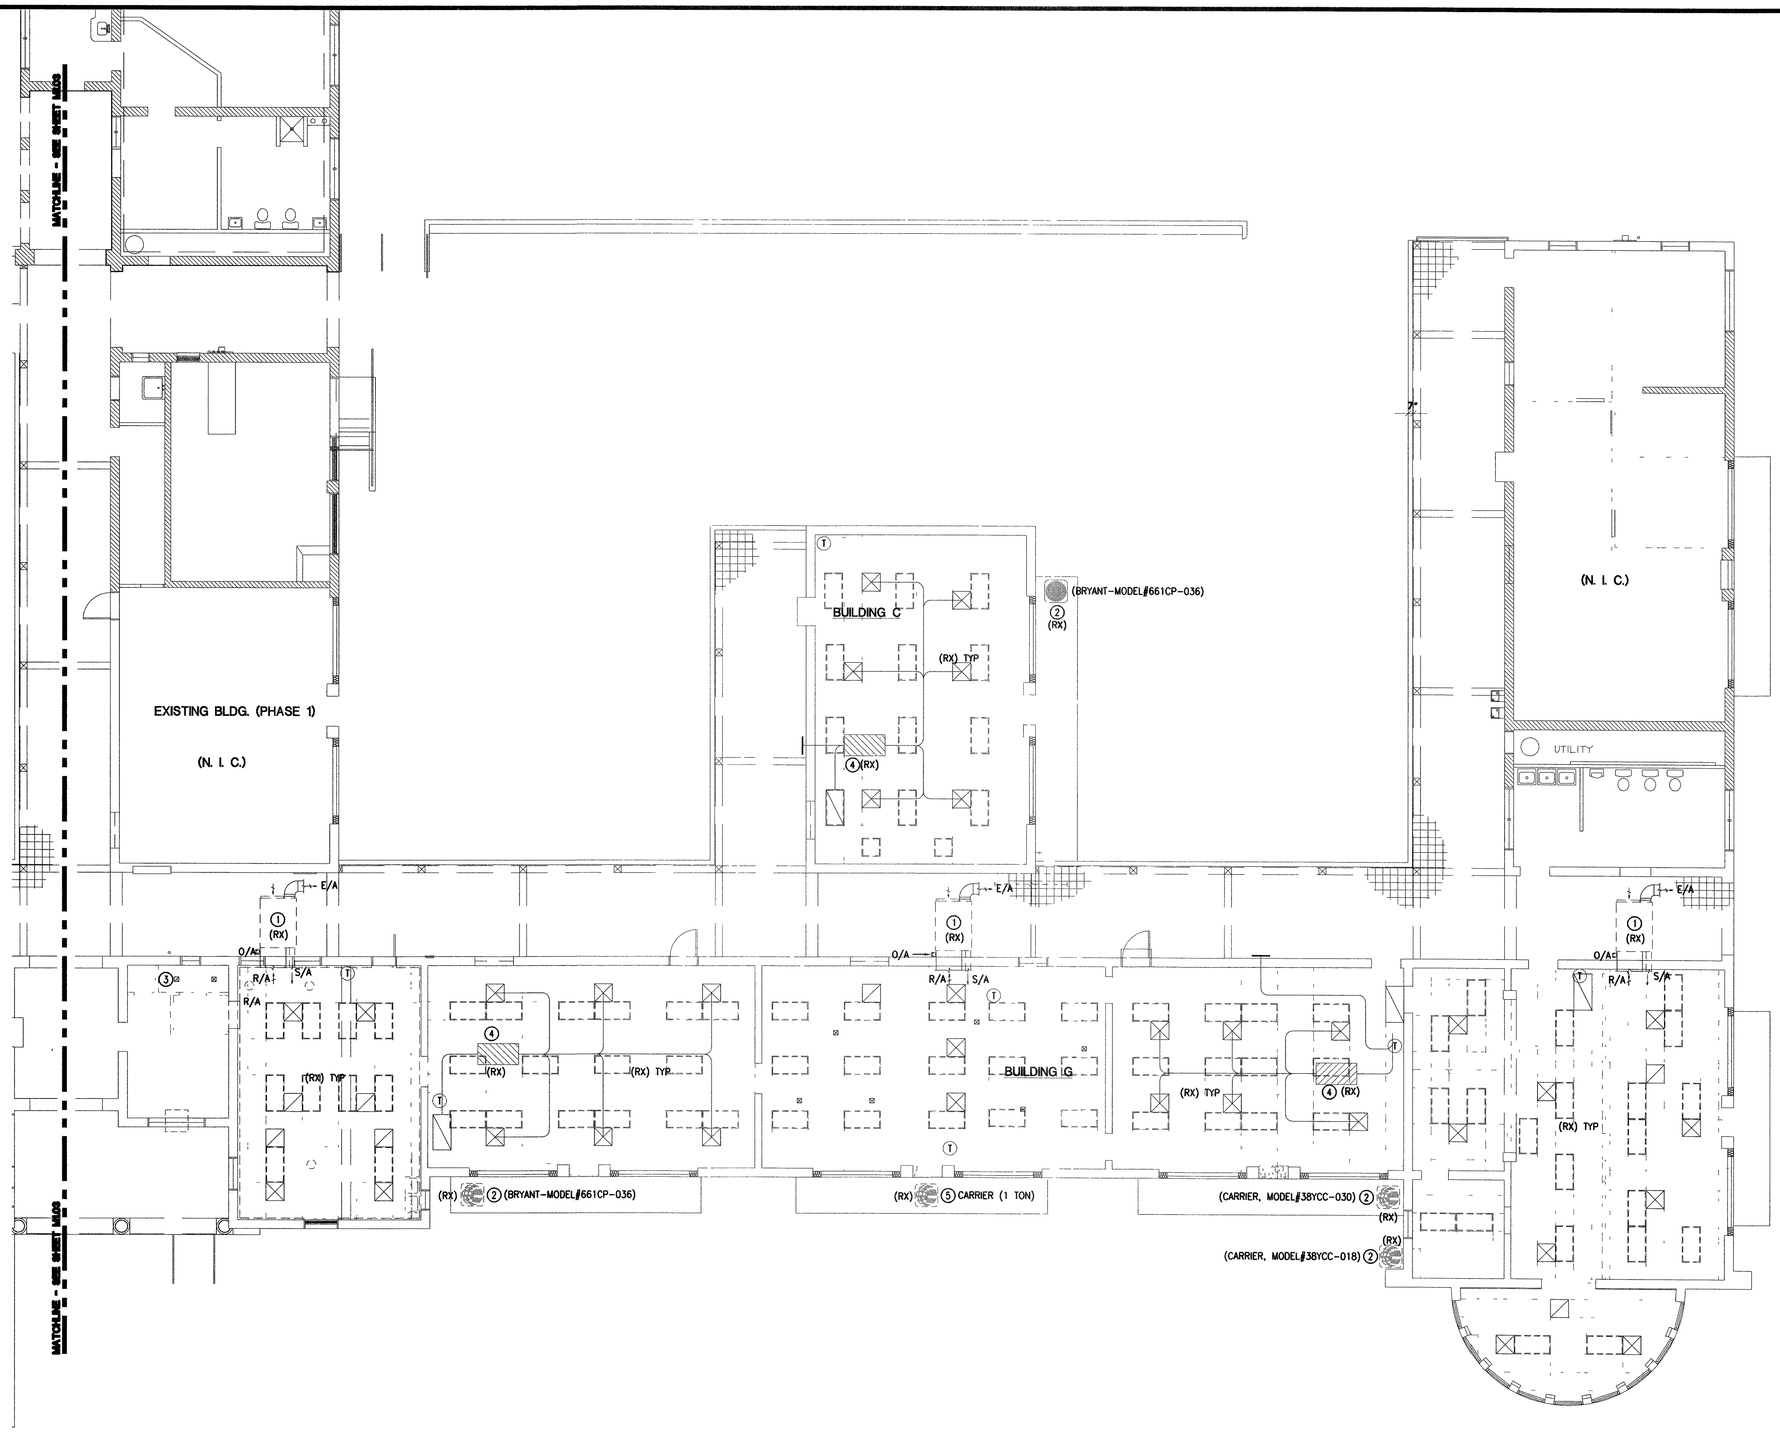

GENERAL NOTES

1. VERIFY ALL EXISTING FIELD CONDITIONS, PRIOR TO BIDDING.
2. REMOVE ALL EQUIPMENT NOTED. DO NOT ABANDON IN PLACE. ANY DUCTWORK, PIPING, CONTROLS, ETC.
3. REFER TO HAZARDOUS MATERIAL SPECIFICATIONS PRIOR TO ANY DEMOLITION WORK INCLUDING THE REMOVAL OF ANY EQUIPMENT.
4. DISPOSE ALL REFRIGERANTS ASSOCIATED WITH SPLIT SYSTEMS AND THERMOSTATS CONTAINING MERCURY PER FEDERAL REGULATIONS. SEE HAZARDOUS MATERIAL SPECIFICATIONS.

KEY NOTES

1. HORIZONTAL INDOOR SINGLE-PACKAGE DX COOLING UNIT TO BE REMOVED WITH ALL ASSOCIATED DUCTWORK, GRILLES, DIFFUSERS, CONDENSATE & CONTROLS. CONTRACTOR TO SALVAGE UNITS & ASSOCIATED THERMOSTATS AND DELIVER THEM TO 3104 EAST BONANZA, LV, NV., ATTENTION JIM TAUS.
2. EXISTING SPLIT SYSTEM CONDENSING UNIT AND ASSOCIATED INDOOR FCU, REFRIGERANT LINES, DUCTWORK, GRILLES & DIFFUSERS, CONDENSATE LINES & CONTROLS TO BE REMOVED. CONTRACTOR TO SALVAGE INDOOR (FCU) W/ ASSOCIATED THERMOSTATS AND OUTDOOR (CU) UNITS & DELIVER TO 3104 EAST BONANZA, LV, NV. ATTENTION JIM TAUS.
3. REMOVE EXISTING EXHAUST FAN AND ALL ASSOCIATED DUCTWORK, GRILLES AND CONTROLS. SEAL WALL AND/OR ROOF WATERTIGHT.
4. REMOVE EXISTING INDOOR UNIT AS PART OF THE SPLIT SYSTEM. REFER TO KEYNOTE #2.
5. REMOVE EXISTING CONDENSING UNIT AND ASSOCIATED REFRIGERANT LINES.

MECHANICAL DEMOLITION PLAN - BUILDINGS "C" & "G"

SCALE: 1/8" = 1'-0"

PLAN NORTH

WORK COMPLETED PER PLANS

96393

SEAL
SH NEVADA
4170 South Rainbow Blvd
Suite 200
Las Vegas NV 89147
Tel 702 873 0670
Fax 702 873 1098
www.shnevada.com

WESTAR ARCHITECTS
ARCHITECTURE • PLANNING • INTERIOR DESIGN
701 BRIDGER AVENUE SUITE 400 LAS VEGAS, NEVADA 89101
TELEPHONE: (702) 870-0000 FAX: (702) 870-0480
www.wagnarchitects.com

SEAL
PROFESSIONAL ENGINEER-STATE OF NEVADA
ALEXANDER JANKOVIC
EXPIRES 06/30/07
MECHANICAL
No. 13957
LV050066

5TH STREET SCHOOL
400 SOUTH LAS VEGAS BLVD.
LAS VEGAS, NEVADA

NUMBER	REVISION DESCRIPTION	DATE
1	RECORD DOCUMENTS	8/11/06

PROJECT NUMBER: 04148
DRAWN BY: QBR
CHECKED BY: AJ
ISSUE DATE: Dec. 07, 2005
SCALE: AS SHOWN

SHEET NUMBER: M1.02

CONSTRUCTION DOCUMENT