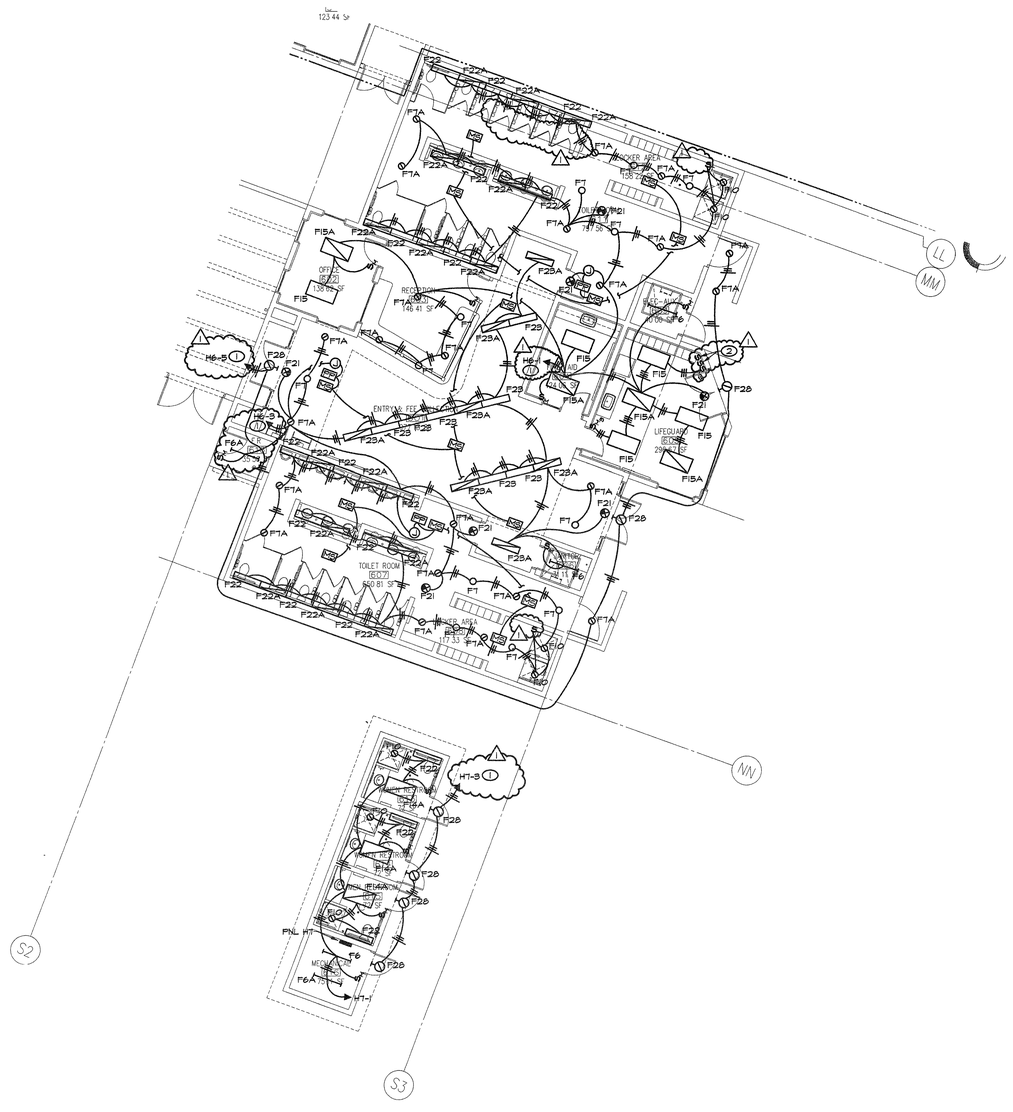

ELECTRICAL LIGHTING PLAN AREA F

SCALE: 1/8"=1'-0"

NOTES:

1. ROUTE CIRCUIT THROUGH TIMECLOCK AND CONTACTOR. SEE CONTACTOR SCHEDULE.
2. OVERIDE SWITCH FOR POOL/CANOPY LIGHTS. ROUTE 5#12, 3/4"C TO CONTACTOR "CBB" AND "CBC".

KEYPLAN

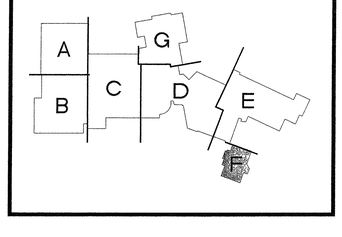

REVISIONS

1	OWNER/ CLV COMMENTS	05/02/05

CONSULTANT

tjk consulting engineers, inc.
7151 Cascade Valley Ct., 200
Las Vegas, NV 89128
P: 702.871.3621
F: 702.871.8353
www.tjkcnb.com

CITY OF LAS VEGAS
CENTENNIAL HILLS COMMUNITY CENTER

ELECTRICAL LIGHTING PLAN AREA F

STAMP

PROFESSIONAL ENGINEER
THOMAS M. ANDERSON
Exp. 12-31-06
ELECTRICAL
No. 13945
NEVADA
4-29-05

OWNER: CITY OF LAS VEGAS
DEPARTMENT OF PUBLIC WORKS
ARCHITECTURAL SERVICES

400 EAST STEWART AVENUE
LAS VEGAS, NEVADA 89101
PHONE: (702) 229-5535
FAX: (702) 384-8846
TDD: (702) 386-9108

DRAWN	TA
FILE	0408
DATE	03/18/05
SCALE	NONE
CLED NO	05153410 1
CLV DWG NO	67 1-49
SHT NO	E1.06

REVISED 6/23/04

DRAWINGS AS INSTRUMENTS OF SERVICE ARE THE PROPERTY OF THE DESIGN PROFESSIONAL. WHOLE STAMP OF CERTIFICATION APPEARS ON THE DRAWINGS AND SPECIFICATIONS ARE USE OR REPRODUCTION IN WHOLE OR IN PART WITHOUT WRITTEN CONSENT IS STRICTLY PROHIBITED COPIES OF THE DRAWINGS AND SPECIFICATIONS RETAINED BY THE CLIENT MAY BE UTILIZED ONLY FOR OCCUPYING THE PROJECT FOR WHICH THEY WERE PREPARED AND NOT FOR THE CONSTRUCTION OF ANY OTHER PROJECT N.A.C. 623.780

102677