

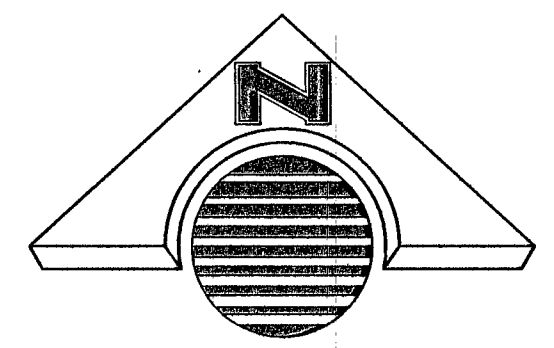


MONUMENT TIE MAP - RECORD OF SURVEY CENTENNIAL HILLS CENTER

BEING LOT 1 OF CENTENNIAL HILLS CENTER (A COMMERCIAL SUBDIVISION) PER BOOK 139, PAGE 48 OF PLATS, LYING WITHIN SECTION 29, TOWNSHIP 19 SOUTH, RANGE 60 EAST, M.D.M., CLARK COUNTY, NEVADA.

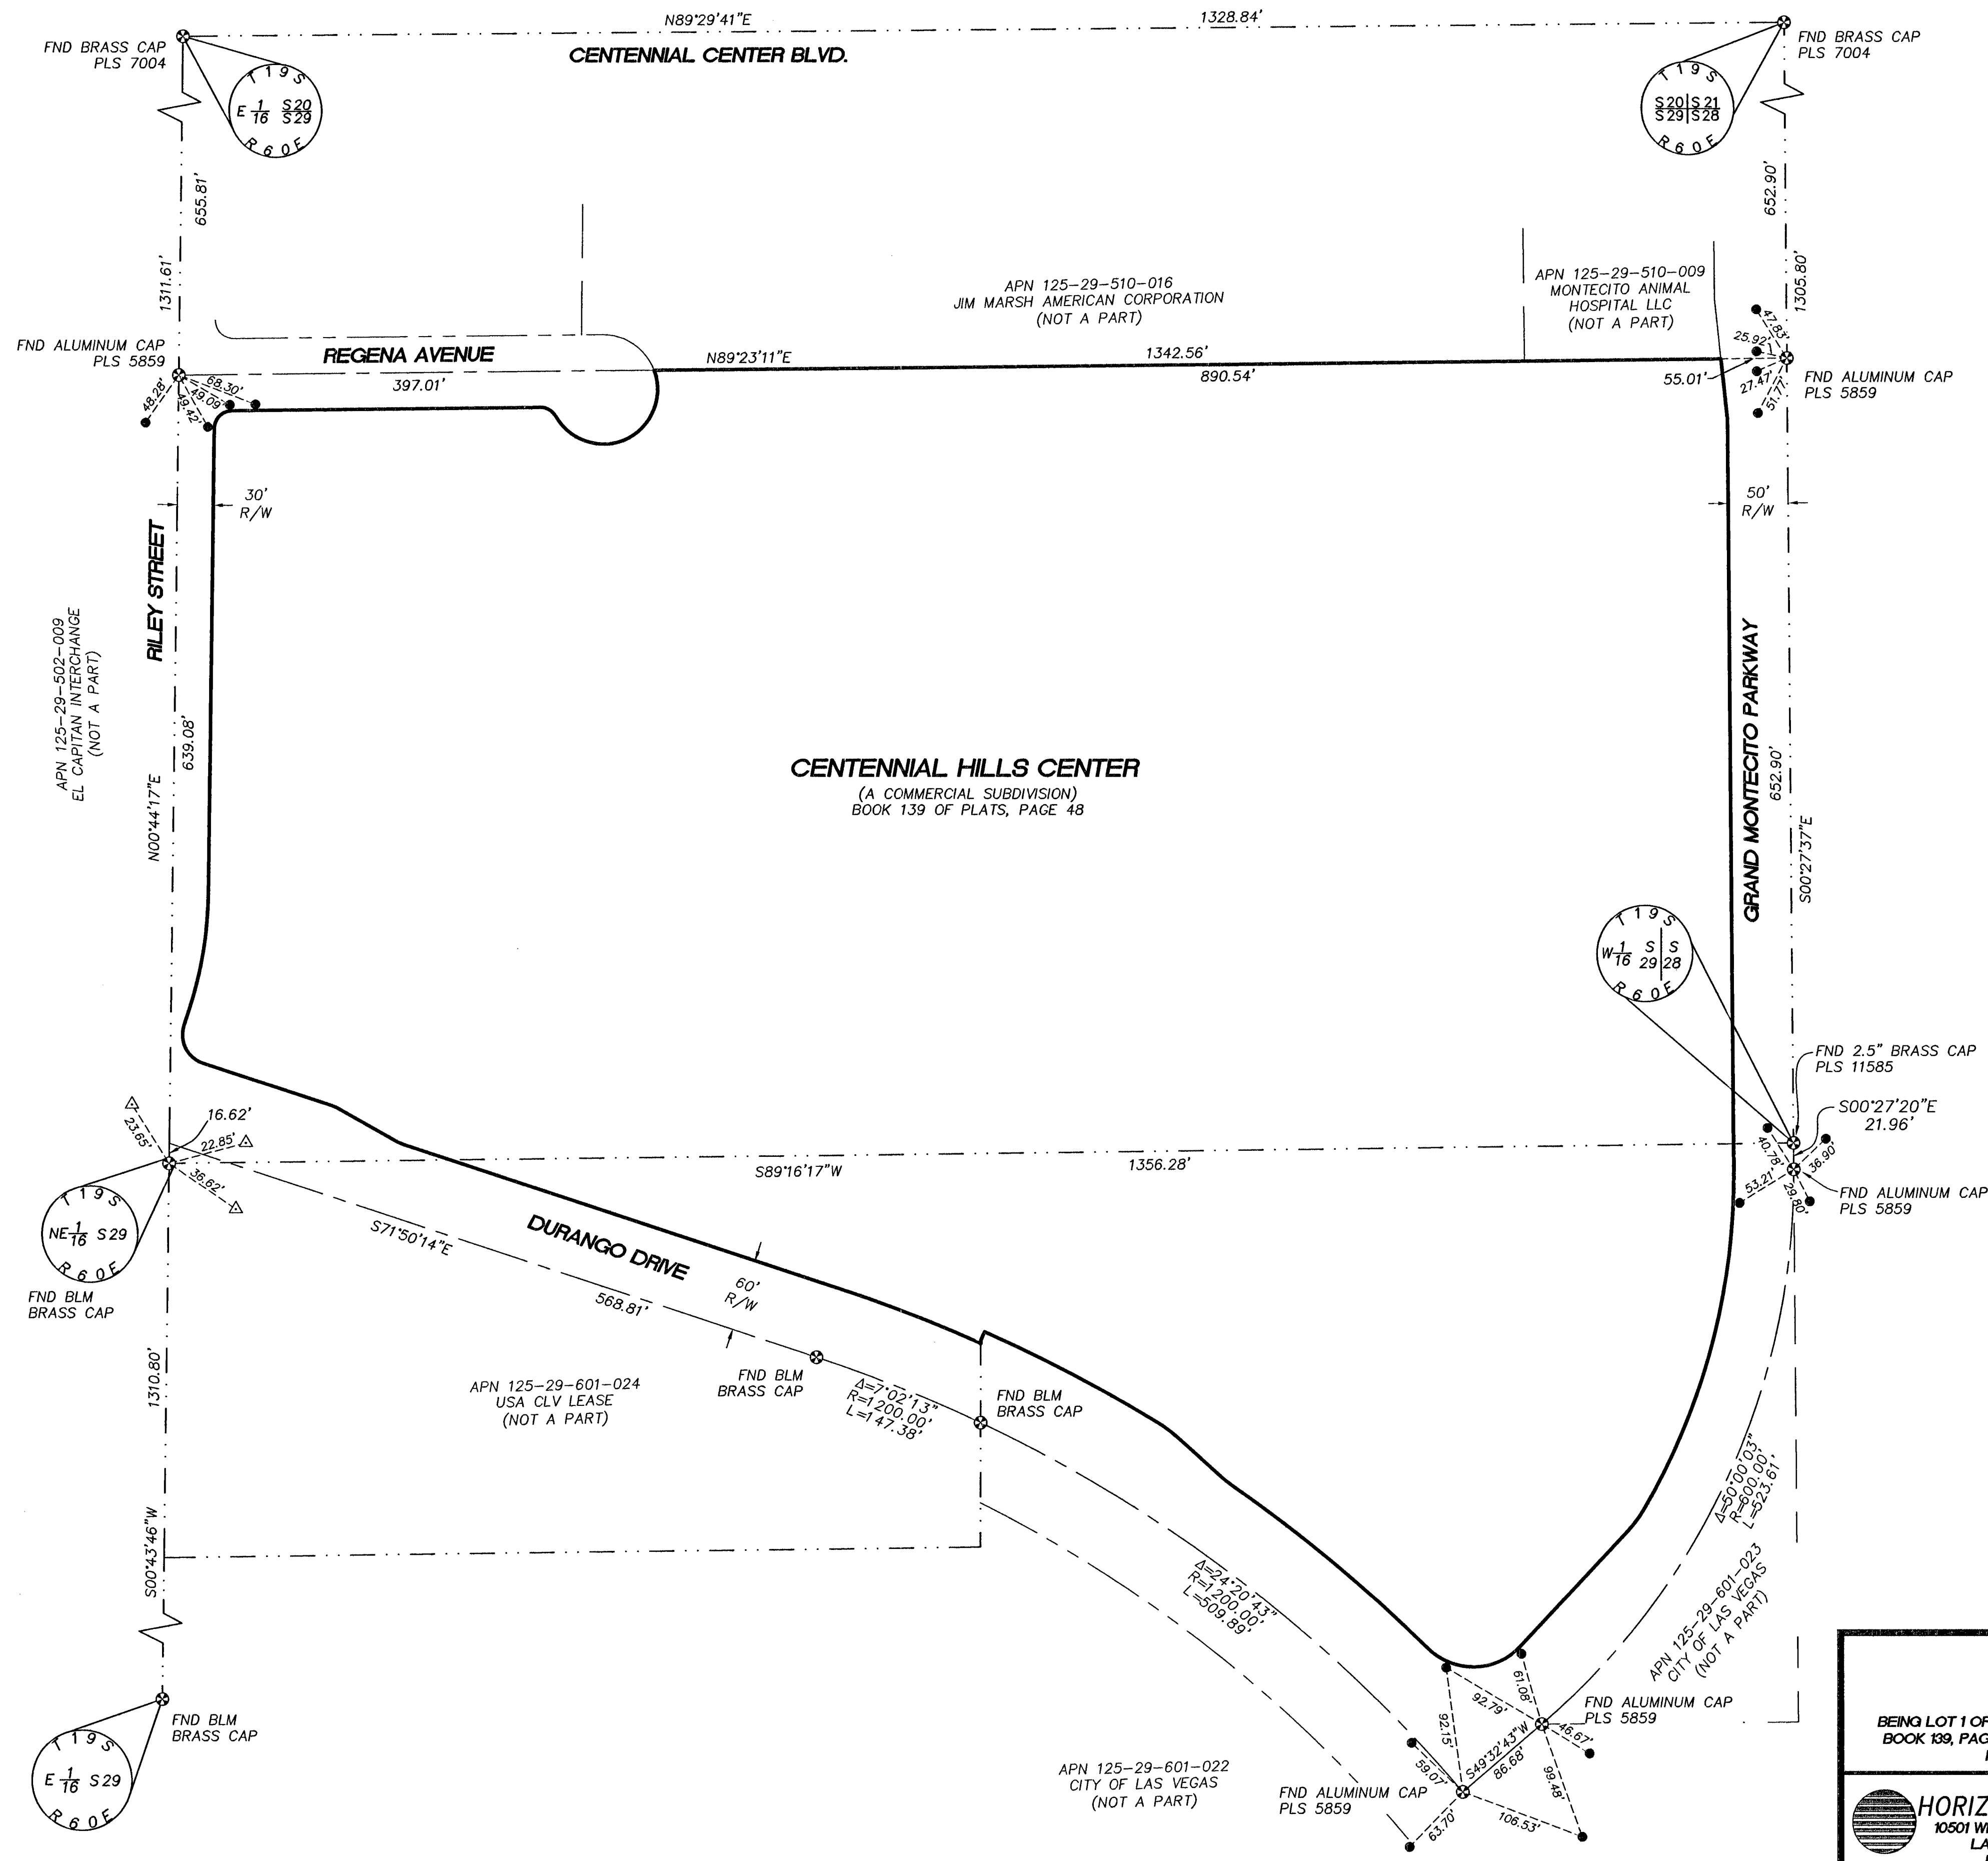


GRAPHIC SCALE

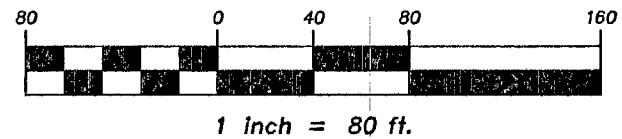

LEGEND

- SUBDIVISION BOUNDARY
- SECTION LINE
- LOT LINE
- CENTERLINE
- RIGHT OF WAY LINE
- TIE LINE
- FOUND MONUMENT AS NOTED
- SET REFERENCE MONUMENT P.L.S. 5859
- FOUND BLM REFERENCE MONUMENT

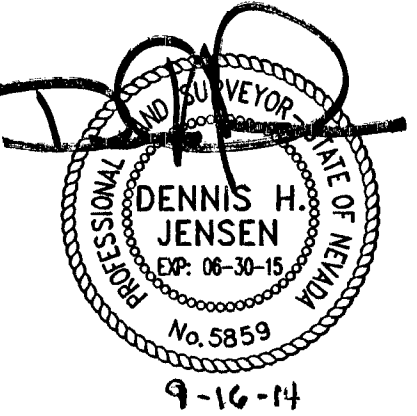

MONUMENT TIE MAP RECORD OF SURVEY CENTENNIAL HILLS CENTER	
BEING LOT 1 OF CENTENNIAL HILLS CENTER (A COMMERCIAL SUBDIVISION) PER BOOK 139, PAGE 48 OF PLATS, LYING WITHIN SECTION 29, TOWNSHIP 19 SOUTH, RANGE 60 EAST, M.D.M., CLARK COUNTY, NEVADA.	
HORIZON SURVEYS, LLC 10501 WEST GOWAN ROAD, SUITE 200 LAS VEGAS, NEVADA 89129 PHONE (702) 228-5066 FAX (702) 228-0677 WWW.HORIZONSURVEYS.COM	Date: 09/11/2014 Drawn: DH JENSEN Checked: R SLIGAR Job Number: 1032.002 Sheet No. 4938 1 of 1
FILED AT THE REQUEST OF: Horizon Surveys, LLC DATE: _____ TIME: _____ FILE: _____ PAGE: _____ SURVEY OFFICIAL RECORDS No. _____ CLARK COUNTY, NEVADA RECORDS DEBBIE CONWAY, RECORDER FEE \$ _____ DEPUTY: _____	

FILE PAGE

HANSEN 13769