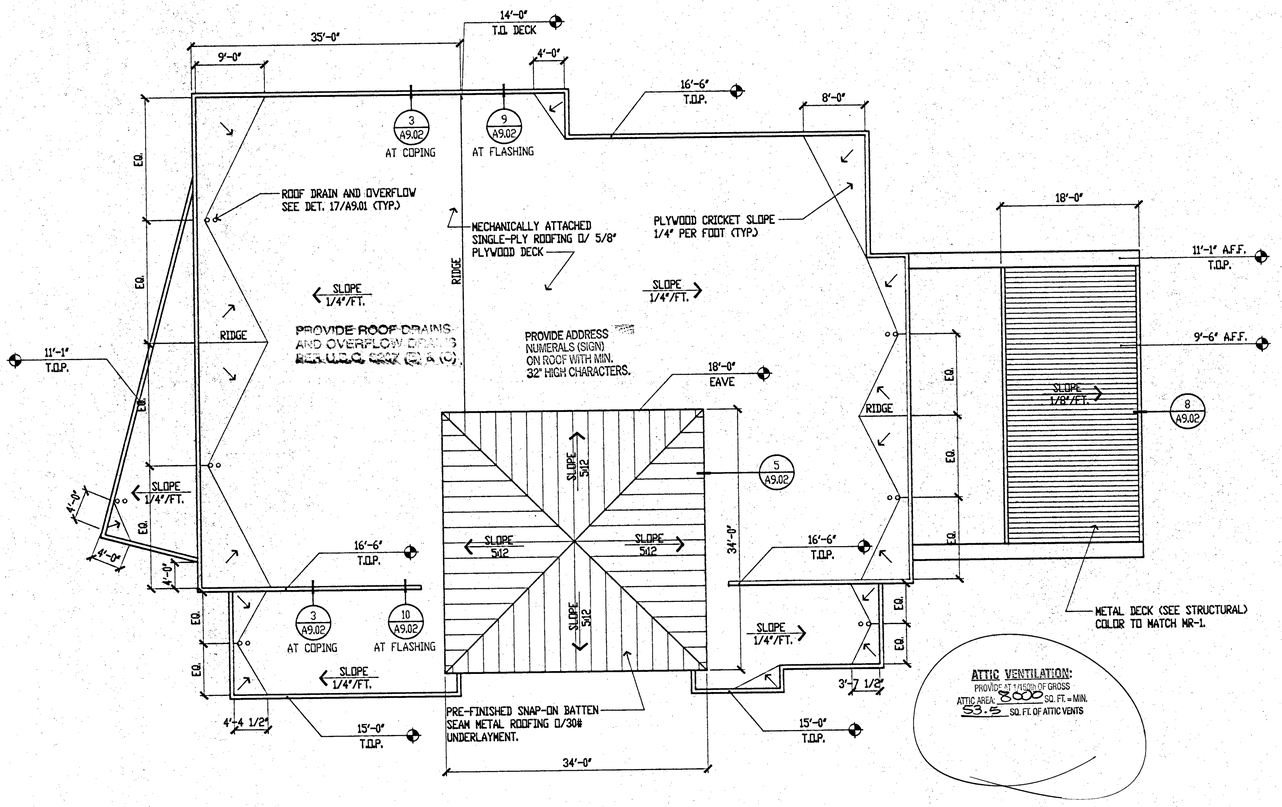

ROOF PLAN

SCALE: 1/8"=1'-0"

NORTH

GENERAL NOTES

1. FOR SINGLE PLY ROOF MEMBRANE SEE SPECIFICATION SECTION 07533 IN ORIGINAL CONTRACT.
2. FOR PRE-FINISHED METAL PANEL ROOF SEE SPECIFICATION SECTION 07611 INCLUDED WITH THIS CONTRACT DOCUMENT.
3. FOR PAINTED FINISH OF EXPOSED METAL DECK OVER PARKING CANOPY, SEE SPECIFICATION SECTION 09900 IN ORIGINAL CONTRACT.

PLANS APPROVED
CONSTRUCTION
BUILDING & SAFETY DIVISION
CITY OF LAS VEGAS, NEVADA
03 NOV 05 1992
Does not include Electrical, Plumbing
or Mechanical improvements
Changes without approval
of Plan is void &
violates Any Ordinance

REVISIONS

REV	DESCRIPTION	DATE	BY

© DOMINGO CAMBEIRO CORPORATION 1990

All designs, arrangements and plans indicated or presented by this drawing, as instruments of service, are owned by and the property of DOMINGO CAMBEIRO CORPORATION. The use of these plans and/or specifications shall be restricted to the original site for which they were prepared and publication thereof is expressly limited to such use. Reproduction, publication or reuse by any method, in whole or in part is prohibited. None of such designs, arrangements or plans shall be used by or disclosed to any person, firm, agency or corporation without the written permission of DOMINGO CAMBEIRO CORPORATION. Visual contact with these plans and specifications shall constitute prima facie evidence of acceptance of these restrictions.

SEAL: DOMINGO CAMBEIRO REGISTERED 631 ARCHITECT STATE OF NEVADA

DRAWN BY
CHECKED BY
ISSUED DATE 1-21-92

ROOF PLAN

DO NOT SCALE DRAWINGS

ADMINISTRATION BUILDING
DETENTION FACILITY EXPANSION
CITY OF LAS VEGAS, NEVADA

Domingo Cambeiro Corporation
ARCHITECTURE · ENGINEERING · PLANNING · INTERIORS
3555 PECOS-McLEOD RD. LAS VEGAS, NEVADA 89121 (702) 732-0084

SHEET NO.

A4.01