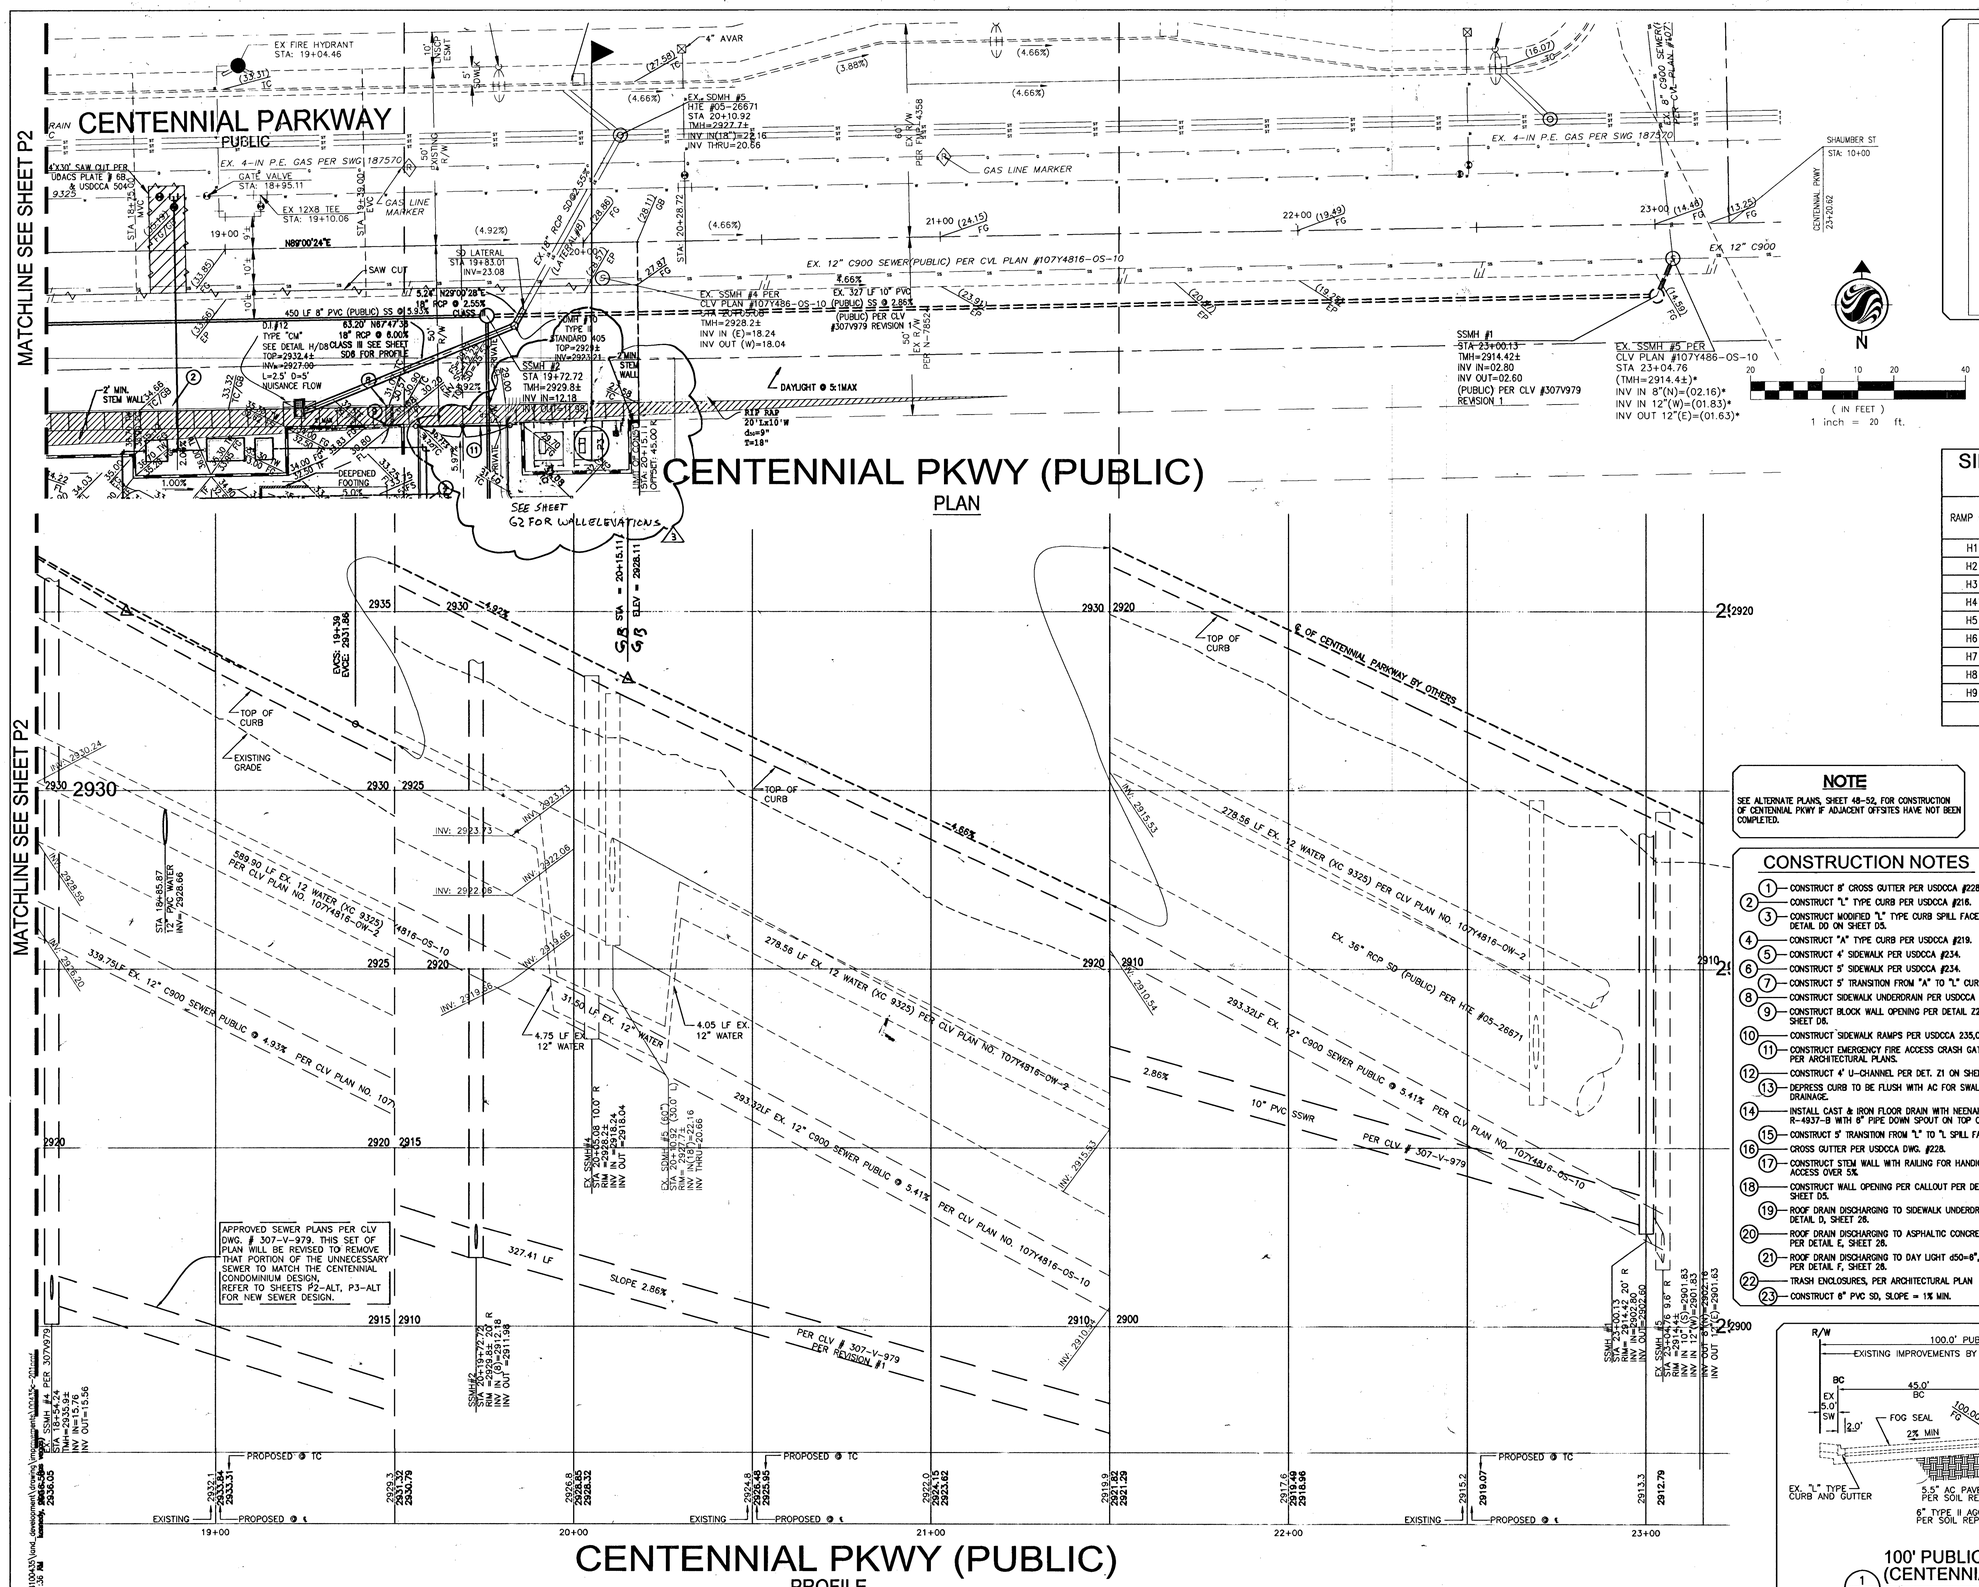

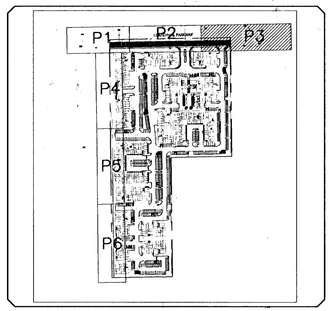

KEY MAP
NOT TO SCALE

SIDEWALK RAMP TRANSITION TABLE

RAMP NO.	GRADE (%) "B" TO "A"	"A" (FT) MIN.	"B" (FT) MIN.
H1	-6 TO -5.01	4.5	21.5
H2	-5 TO -4.01	4.5	15.0
H3	-4 TO -3.01	4.5	12.0
H4*	-3 TO -2.01	4.5	9.5
H5	-2 TO 2	8.08	8.0
H6	2.01 TO 3	9.5	4.5
H7	3.01 TO 4	12.0	4.5
H8	4.01 TO 5	15.0	4.5
H9	5.01 TO 6	21.5	4.5

SEE CLARK COUNTY AREA STANDARD DRAWING NO. 235 CASE 1

NOTE

SEE ALTERNATE PLANS, SHEET 48-52, FOR CONSTRUCTION OF CENTENNIAL PKWY IF ADJACENT OFFSITES HAVE NOT BEEN COMPLETED.

CONSTRUCTION NOTES

1. CONSTRUCT 8' CROSS GUTTER PER USDCCA #228.
2. CONSTRUCT "L" TYPE CURB PER USDCCA #216.
3. CONSTRUCT MODIFIED "L" TYPE CURB SPILL FACE PER DETAIL D0 ON SHEET D3.
4. CONSTRUCT "A" TYPE CURB PER USDCCA #219.
5. CONSTRUCT 4' SIDEWALK PER USDCCA #234.
6. CONSTRUCT 5' SIDEWALK PER USDCCA #234.
7. CONSTRUCT 5' TRANSITION FROM "A" TO "L" CURB.
8. CONSTRUCT SIDEWALK UNDERDRAIN PER USDCCA #236
9. CONSTRUCT BLOCK WALL OPENING PER DETAIL Z2 ON SHEET D8.
10. CONSTRUCT SIDEWALK RAMPS PER USDCCA 235,CASE 1.
11. CONSTRUCT EMERGENCY FIRE ACCESS CRASH GATE PER ARCHITECTURAL PLANS.
12. CONSTRUCT 4' U-CHANNEL PER DET. Z1 ON SHEET D8.
13. DEPRESS CURB TO BE FLUSH WITH AC FOR SWALE DRAINAGE.
14. INSTALL CAST & IRON FLOOR DRAIN WITH NEENAH GRATE R-4937-B WITH 6" PIPE DOWN SPOUT ON TOP OF CURB.
15. CONSTRUCT 5' TRANSITION FROM "L" TO "L SPILL FACE" CURB.
16. CROSS GUTTER PER USDCCA DWG. #228.
17. CONSTRUCT STEM WALL WITH RAILING FOR HANDICAP ACCESS OVER 5%.
18. CONSTRUCT WALL OPENING PER CALLOUT PER DETAIL AA SHEET D5.
19. ROOF DRAIN DISCHARGING TO SIDEWALK UNDERDRAIN PER DETAIL D, SHEET 28.
20. ROOF DRAIN DISCHARGING TO ASPHALTIC CONCRETE PER DETAIL E, SHEET 28.
21. ROOF DRAIN DISCHARGING TO DAY LIGHT (d50=8", D=1' PER DETAIL F, SHEET 28.
22. TRASH ENCLOSURES, PER ARCHITECTURAL PLAN
23. CONSTRUCT 8" PVC SD, SLOPE = 1% MIN.

EXISTING UTILITIES

EXISTING UTILITY LOCATIONS SHOWN HEREIN ARE APPROXIMATE ONLY. IT SHALL BE THE CONTRACTOR'S RESPONSIBILITY TO DETERMINE THE EXACT VERTICAL AND HORIZONTAL LOCATION OF ALL EXISTING UNDERGROUND UTILITIES PRIOR TO COMMENCING CONSTRUCTION. NO REPRESENTATION IS MADE THAT ALL EXISTING UTILITIES ARE SHOWN HEREON. THE ENGINEER ASSUMES NO RESPONSIBILITY FOR UTILITIES NOT SHOWN OR UTILITIES NOT SHOWN IN THEIR PROPER LOCATION.

CALL BEFORE YOU DIG: 1-800-227-2600.

BENCHMARK

CLV BENCHMARK: BLV90 30W4 NAVD 88'.2002
ELEVATION 834.6354 (METERS), 2738.30 (FEET).

RIVET AND PLATE IN CONCRETE PAD (ELEC) NE CORNER OF HUALAPAI & TROPICAL PARKWAY.

CALL BEFORE YOU DO UNDERGROUND– AVOID HITTING UNDERGROUND TRAFFIC SIGNAL SYSTEMS AND STREET LIGHT SYSTEM CONDUITS–IT'S COSTLY

Call before you underground
1-702-432-5300
FREEWAY ARTERIAL SYSTEM TRANSPORTATION F.A.S.T.
AVOID CUTTING UNDERGROUND UTILITY LINES. IT'S COSTLY.

Call before you Dig
AVOID CUTTING UNDERGROUND UTILITY LINES. IT'S COSTLY.
Call
811
OR
1-800-227-2600
AND
CLARK COUNTY TRAFFIC OPERATIONS
1-702-455-7544

AVOID OVERHEAD POWER LINE CONTACT. IT'S COSTLY.
Call before you OVERHEAD
1-702-227-2929

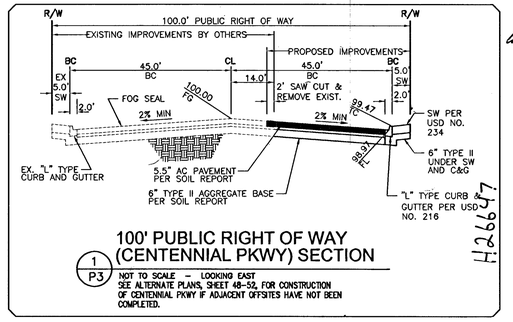

100' PUBLIC RIGHT OF WAY (CENTENNIAL PKWY) SECTION
1 / P3
NOT TO SCALE – LOOKING EAST
SEE ALTERNATE PLANS, SHEET 48-52, FOR CONSTRUCTION OF CENTENNIAL PKWY IF ADJACENT OFFSITES HAVE NOT BEEN COMPLETED.

Stantec Consulting Ltd.
7251 West Charleston Boulevard
Las Vegas, NV
89117
Tel. 702.258.0115
Fax. 702.258.4956
www.stantec.com

Stantec
The Contractor shall verify and be responsible for all dimensions. DO NOT scale the drawing – any errors or omissions shall be reported to Stantec without delay. Copyright is held in perpetuity and remains the property of Stantec. Reproduction or use for any purpose other than that authorized by Stantec is forbidden.

Revision	By	Appd.	YY.MM.DD
2 ADD NEW POWER WALL ENCLOSURE			08/04

Client/Project
FAIRFIELD CENTENNIAL, LLC
CENTENNIAL CONDOMINIUMS
CITY OF LAS VEGAS, NV

Title
PLAN & PROFILE

Permit-Seal

ENGINEER ALHWAYEK Exp.12-31-10 CIVIL No. 10502 STATE OF NEVADA
5/8/08

Project Number: 188100435
File Name: 00435c-201prof.dwg

DWN	CHKD	DSGN	DATE
EA/NW	SA/NW	EA/NW	5/7/2008

Drawing No. P3
CLV# 107Y4967
Revision 0
Sheet 30 of 52

115567
111183
H26647