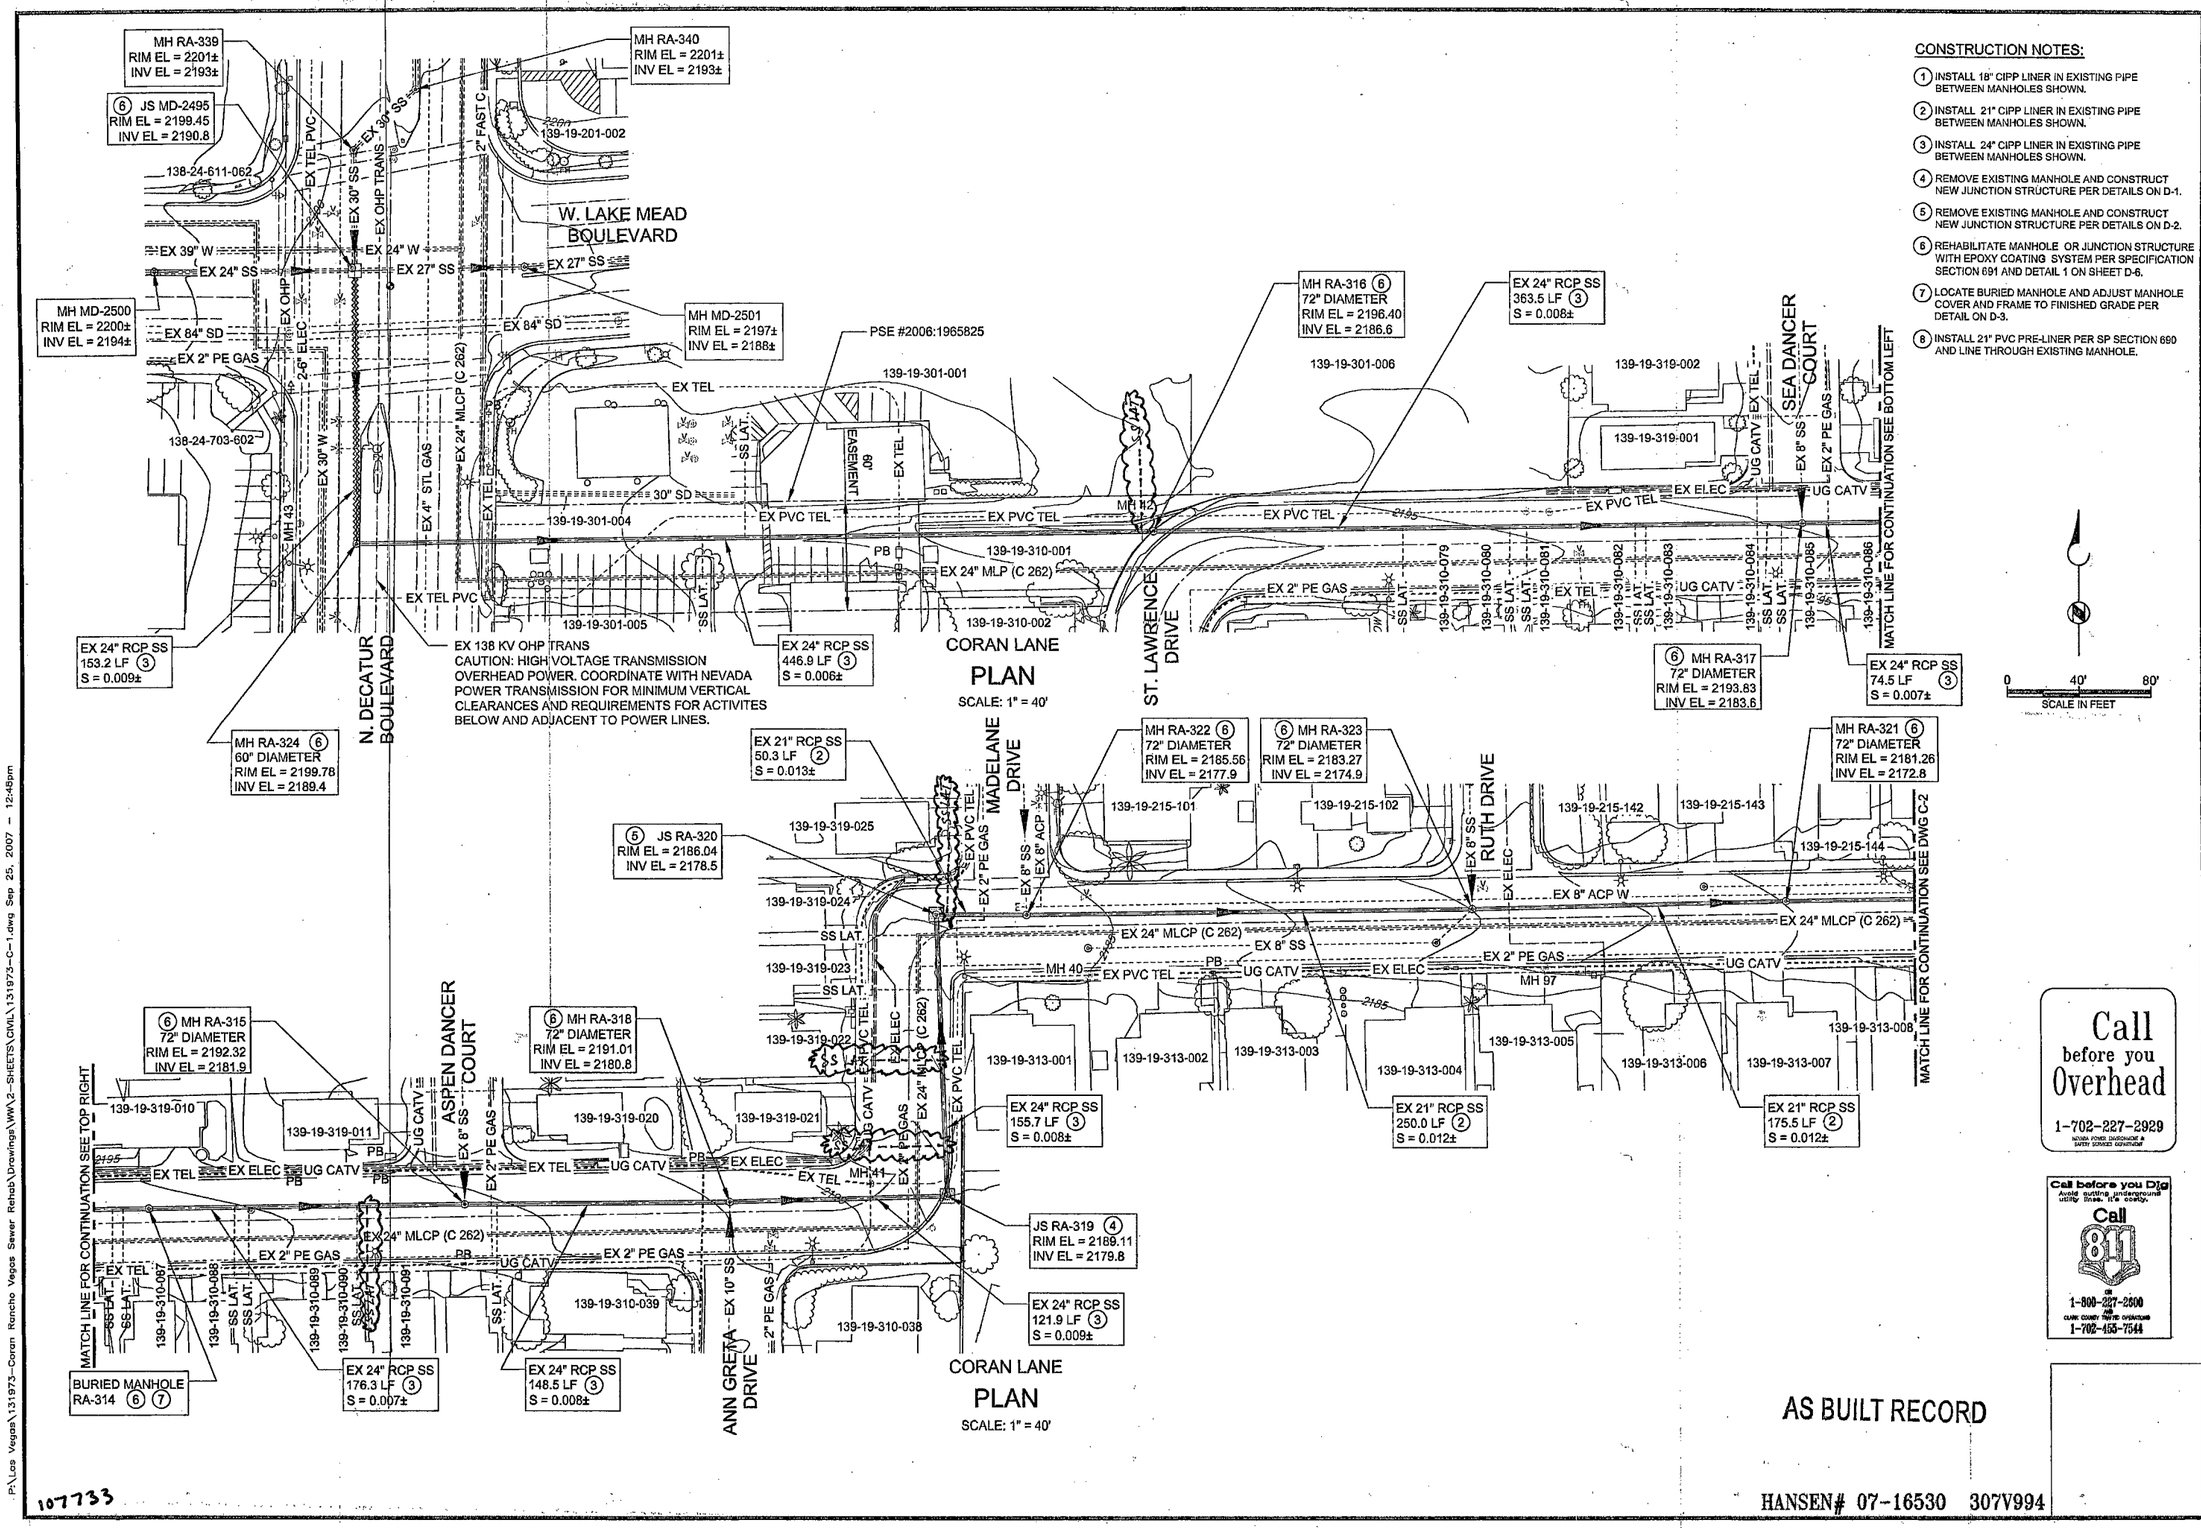

CONSTRUCTION NOTES:

1. INSTALL 18" CIPP LINER IN EXISTING PIPE BETWEEN MANHOLES SHOWN.
2. INSTALL 21" CIPP LINER IN EXISTING PIPE BETWEEN MANHOLES SHOWN.
3. INSTALL 24" CIPP LINER IN EXISTING PIPE BETWEEN MANHOLES SHOWN.
4. REMOVE EXISTING MANHOLE AND CONSTRUCT NEW JUNCTION STRUCTURE PER DETAILS ON D-1.
5. REMOVE EXISTING MANHOLE AND CONSTRUCT NEW JUNCTION STRUCTURE PER DETAILS ON D-2.
6. REHABILITATE MANHOLE OR JUNCTION STRUCTURE WITH EPOXY COATING SYSTEM PER SPECIFICATION SECTION 691 AND DETAIL 1 ON SHEET D-6.
7. LOCATE BURIED MANHOLE AND ADJUST MANHOLE COVER AND FRAME TO FINISHED GRADE PER DETAIL ON D-3.
8. INSTALL 21" PVC PRE-LINER PER SP SECTION 690 AND LINE THROUGH EXISTING MANHOLE.

DATE	REVISIONS

LINE IS 2 INCHES AT FULL SIZE (IF NOT 2" - SCALE ACCORDINGLY)

DESIGNED: O. FURLAN
DRAWN: L. OLIVARES
CHECKED: H. STEED
CHECKED: R. GABRIEL

BROWN AND CALDWELL
4425 W. SPRING MOUNTAIN ROAD, SUITE 225
LAS VEGAS, NEVADA 89102
(702) 938-4080

SUBMITTED: PROJECT MANAGER DATE:
APPROVED: BROWN AND CALDWELL DATE:

CITY OF LAS VEGAS - DEPARTMENT OF PUBLIC WORKS

CORAN/ RANCHO/ VEGAS SEWER REHABILITATION

CORAN LANE PLAN VIEW DECATUR BOULEVARD TO RUTH DRIVE

PROFESSIONAL ENGINEER - STATE OF NEVADA
HARRISON
Exp. 6/30/08
CIVIL
No. 17509

DRAWING NO. C-1
5/39

P:\Las Vegas\131973-Coran Rancho Vegas Sewer Rehab\Drawings\WW\2-SHEETS\CIVIL\131973-C-1.dwg Sep 25, 2007 - 12:45pm

107733