



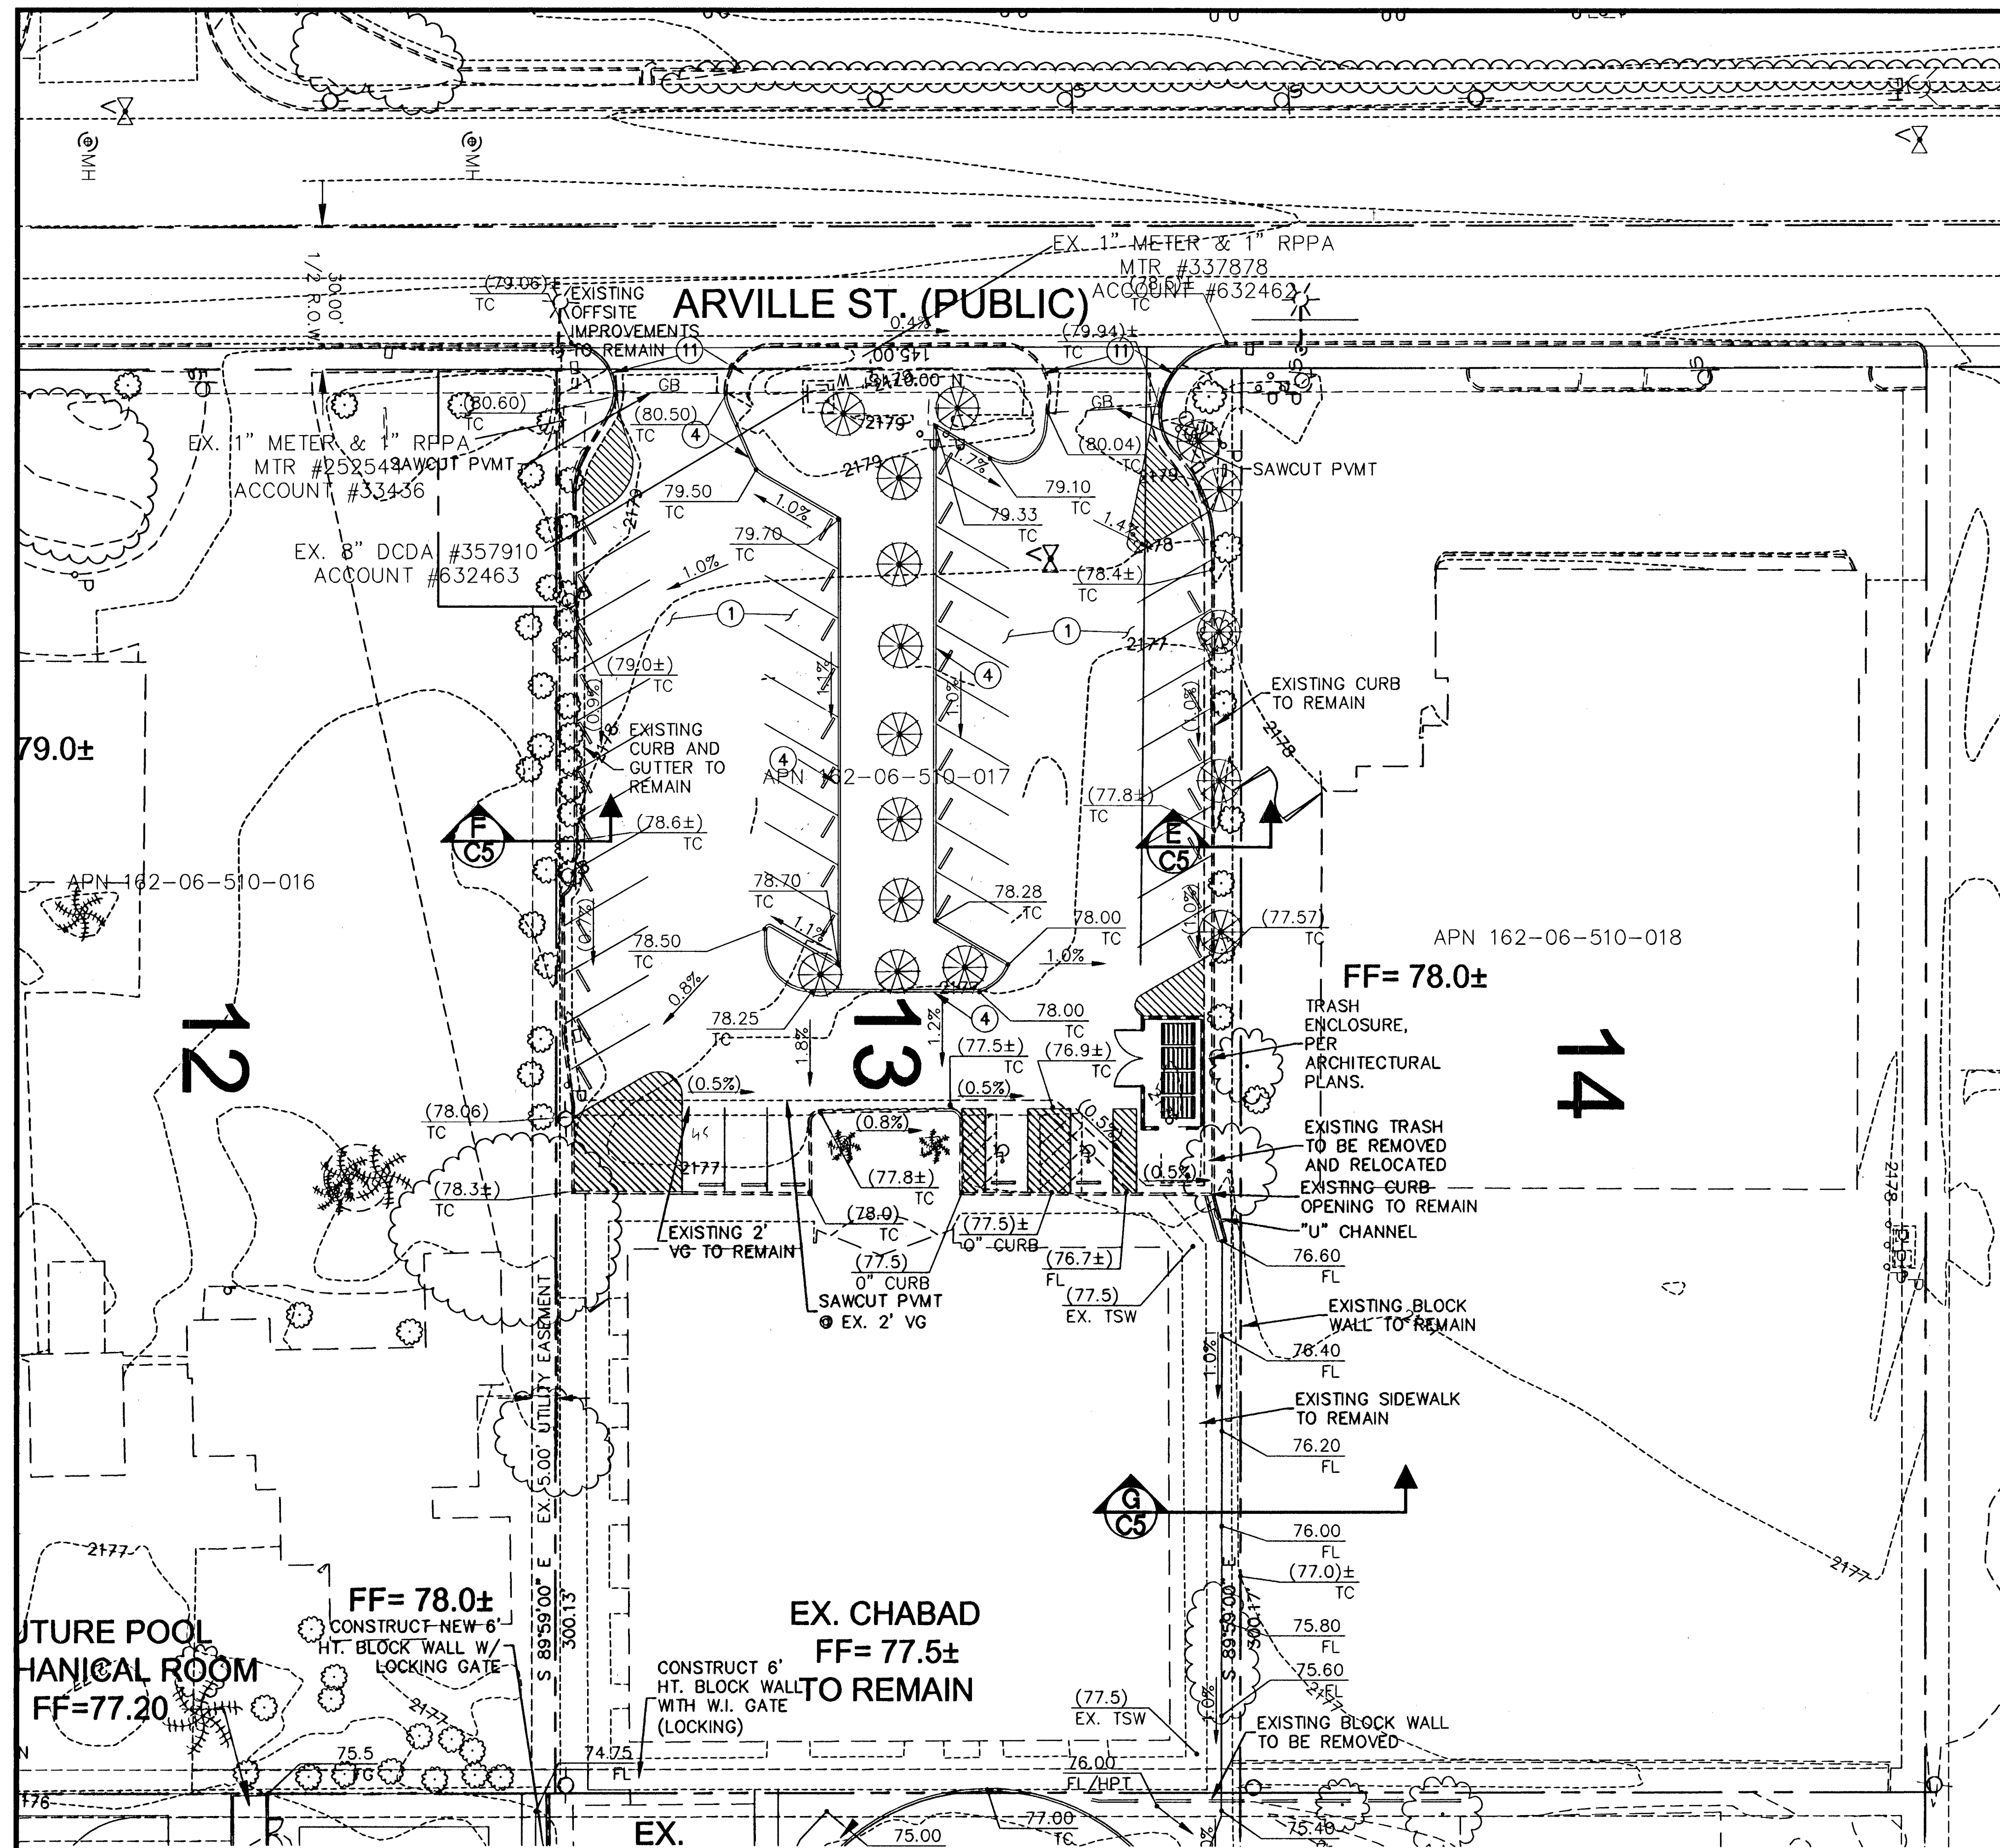

SEE SHEET C6 FOR CONTINUATION

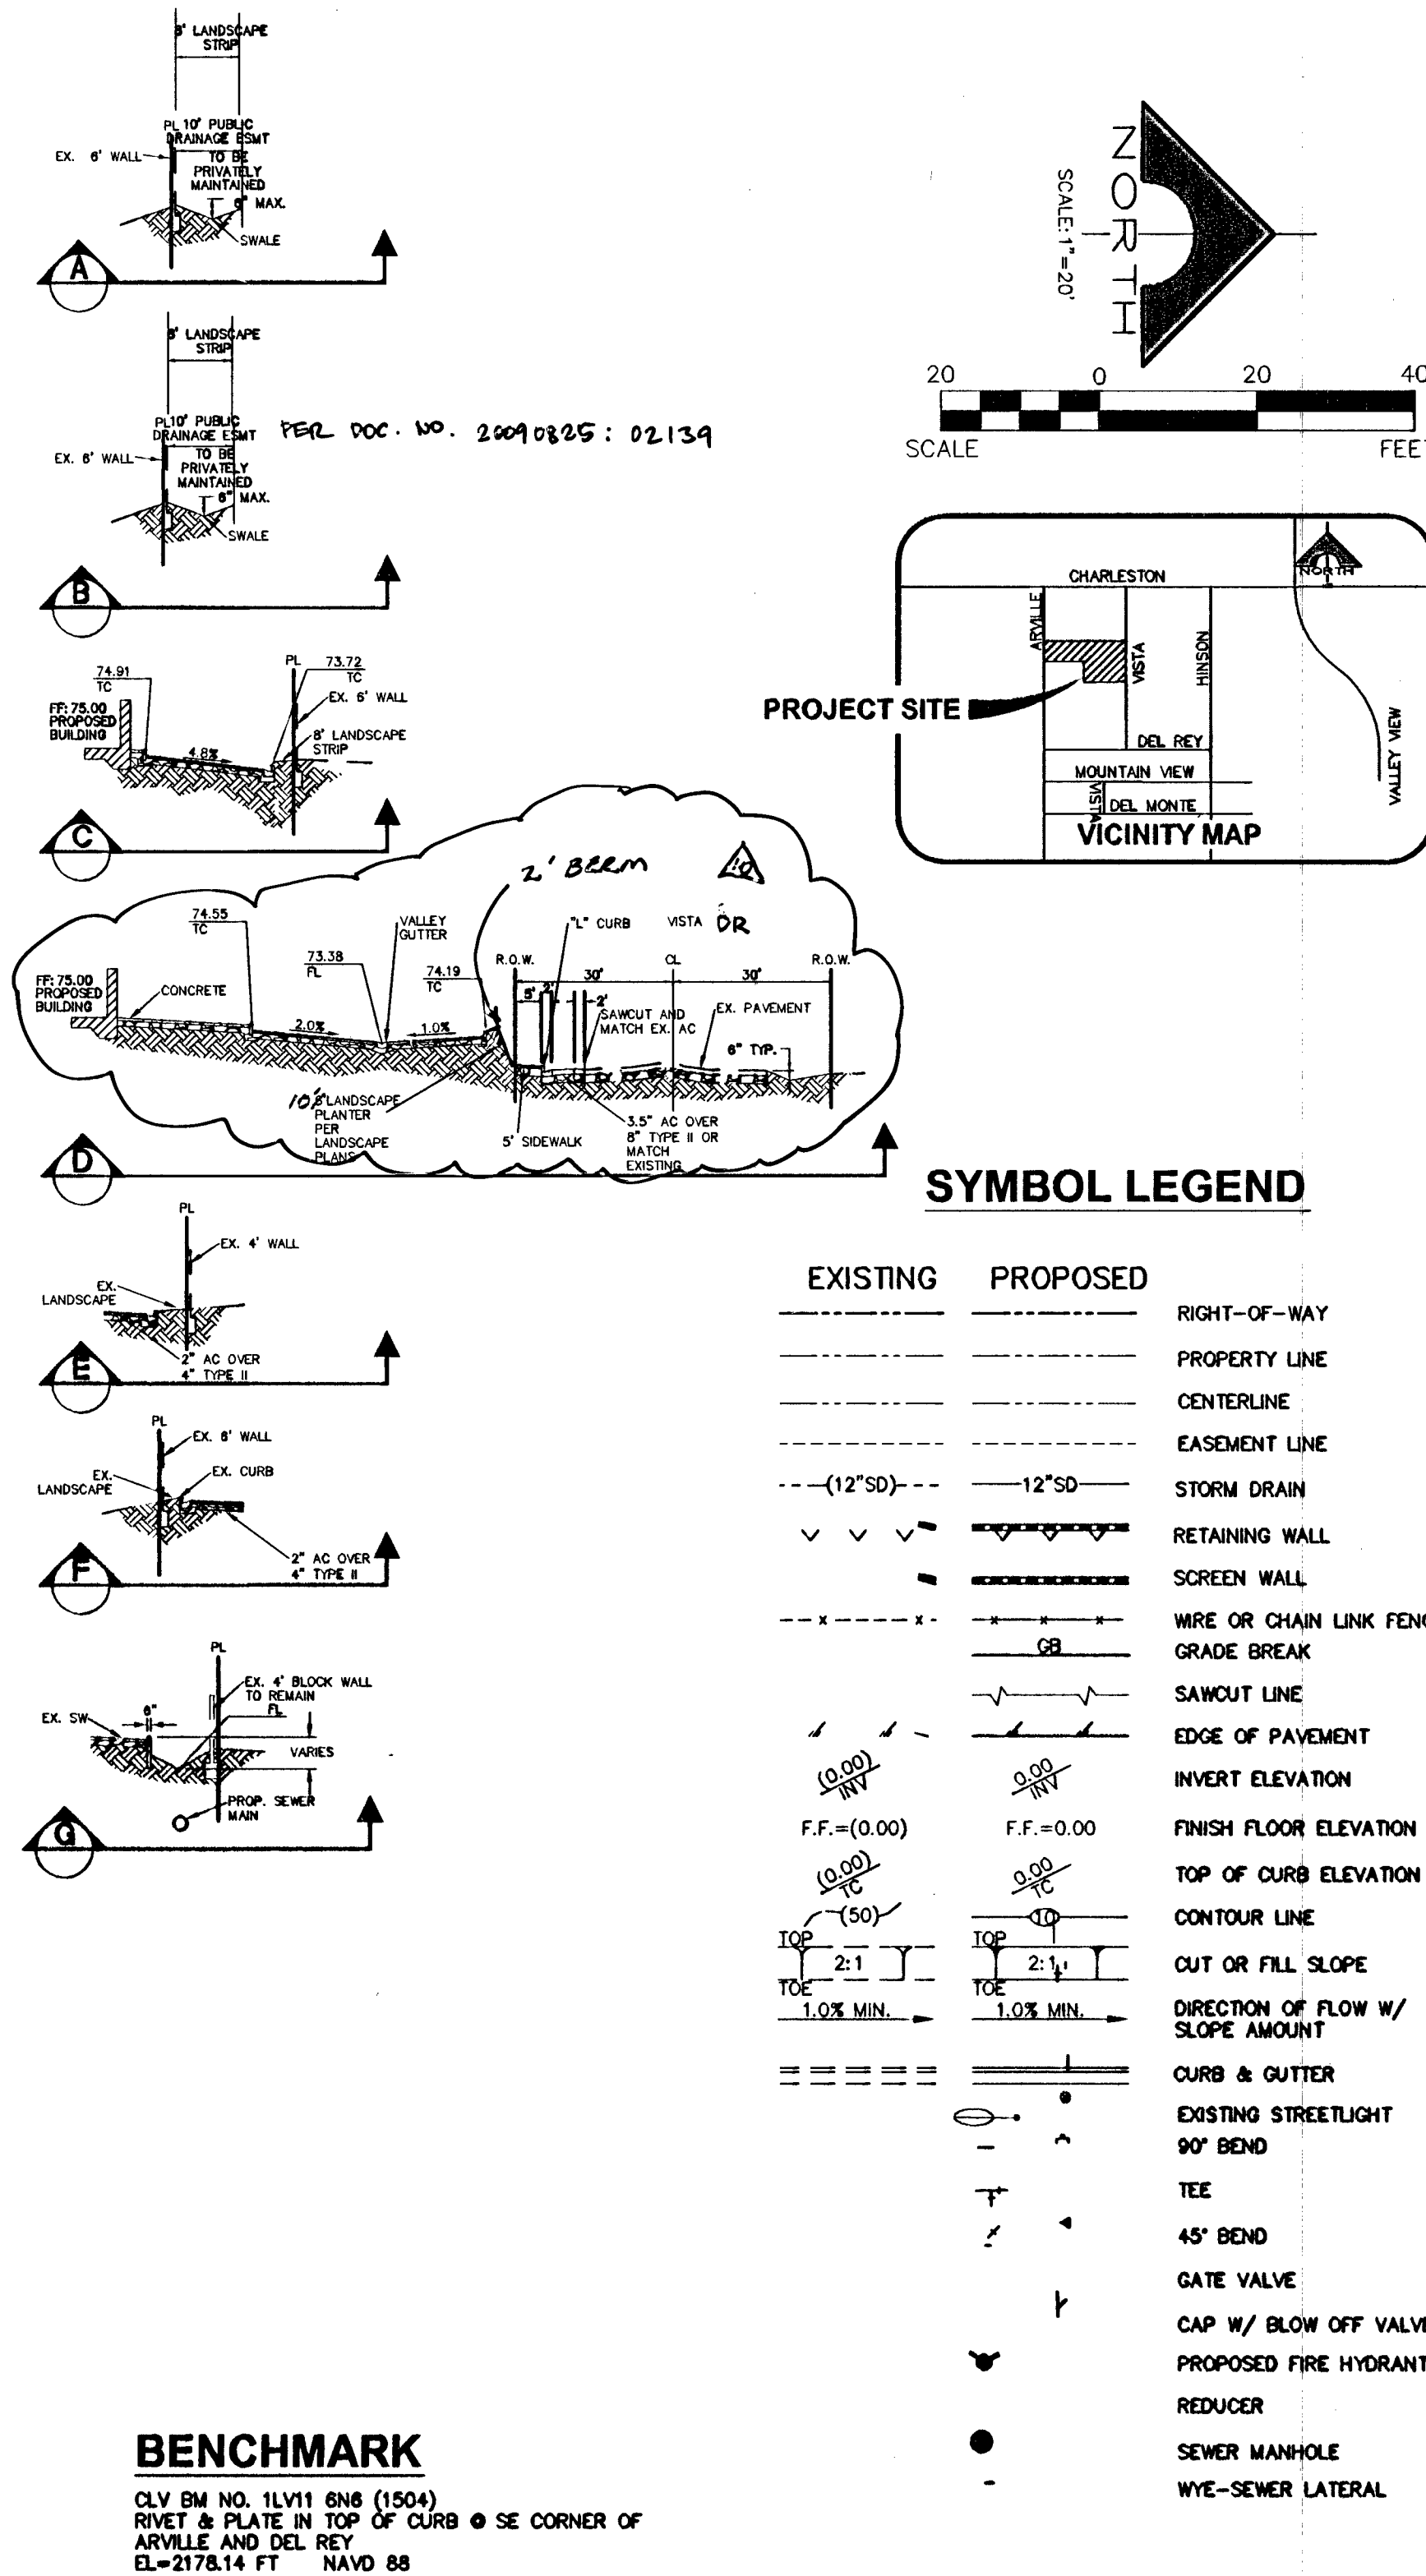

BENCHMARK
CLV BM NO. 11V11 6NB (1504)
RIVET & PLATE IN TOP OF CURB @ SE CORNER OF
ARVILLE AND DEL REY
EL=2178.14 FT NAVD 88

BASIS OF BEARINGS
N89°59'00\"/>

CONSTRUCTION NOTES

- ① CONSTRUCT AC PAVEMENT PER DETAIL SHEET C8
- ② CONSTRUCT 4\"/>



Call before you dig
1-800-227-2600
UNDERGROUND SERVICE (US)

H# 34588

OWNER/DEVELOPER CHABAD OF SOUTHERN NEVADA 1201 ARVILLE ST. LAS VEGAS, NV 89102		DESIGNED BY JHC CHECKED BY JHC DRAWING DATE: 8/3/2009		JOB # 482	
CHABAD OF SO. NEVADA - DESERT TORAH ACADEMY		GRADING PLAN 1		REVISION APPROVAL BLOCK	
SHEET C5 5 OF 10 SHEETS		7/15 - 18/		SCALE: 1\"/>	