


CONSTRUCTION DRAWING
CITY OF LAS VEGAS, NEVADA

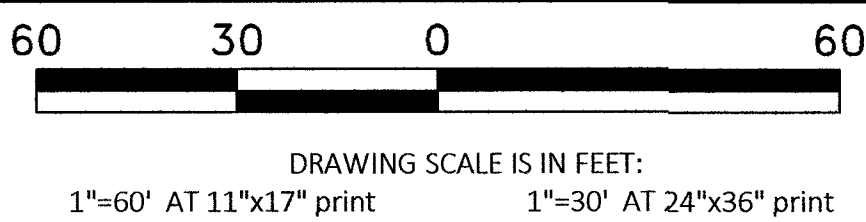

CELL SITE: LSV OAKLEY DECATUR - REV 06-10-19

CITY OF LAS VEGAS, NEVADA

CLARIFICATION NO. QUANTITY

SHEET TOTAL	
2" HDPE CONDUIT:	896'
2.5" HDPE CONDUIT:	34'
4" HDPE CONDUIT:	-
2' x 3' x 2' HANDHOLE(S):	-
2.5' x 5' x 2.5' HANDHOLE(S):	1
4' x 5' x 4' HANDHOLE(S):	-
MANHOLE(S):	-
AERIAL:	-
VZW CONDUIT:	-
3RD PARTY CONDUIT:	111'
BORE:	445'
TRENCH:	34'
TOTAL NEW UG FOOTAGE:	479'
TOTAL FOOTAGE:	590'

COMMUNICATIONS SERVICES, INC.

OUTSIDE PLANT CONSTRUCTION

TITLE: CELL SITE: LSV OAKLEY DECATUR - REV 06-10-19

DATE: 6/10/2019

DRAWN BY: ERAMSEY

REVISIONS

DATE	DESCRIPTION	INITIAL
6-10-19	CHANGED R/L FROM 3RD PARTY TO UG	CM

EXCEPT AS MAY BE OTHERWISE PROVIDED BY CONTRACT, THESE DRAWINGS AND SPECIFICATIONS SHALL REMAIN THE PROPERTY OF MCI COMMUNICATIONS SERVICES, INC. BOTH BEING ISSUED IN STRICT CONFIDENCE AND SHALL NOT BE REPRODUCED, COPIED, OR USED FOR ANY PURPOSE WITHOUT SPECIFIC WRITTEN PERMISSION.

SCALE

HORIZONTAL: 1"=30'

VERTICAL: NA

MP TO MP

SHEET 12 OF 14

FILE: LSV OAKLEY DECATUR - REV 06-10-19

RTC NOTES:

BACKFILL AND RIGHT OF WAY RESTORATION SHALL CONFORM TO CLARK COUNTY UNIFORM STANDARD DRAWINGS

(1) 500.1	0 TO 5 YEARS PAVEMENT RESTORATION LONGITUDINAL CUT
(2) 500.2	0 TO 5 YEARS PAVEMENT RESTORATION TRAVERSE CUT
(3) 500.3	OVER 5 YEARS PAVEMENT RESTORATION LONGITUDINAL CUT, GREATER THAN 60" R.O.W
(4) 500.4	OVER 5 YEARS PAVEMENT RESTORATION LONGITUDINAL CUT, 60" R.O.W OR LESS
(5) 500.5	OVER 5 YEARS PAVEMENT RESTORATION TRAVERSE ALL R.O.W WIDTHS
(6) 501	TYPICAL UNDERGROUND UTILITY LOCATIONS IN RESIDENTIAL STREETS 60' OR LESS R.O.W
(7) 501.1	TYPICAL UTILITY UNDERGROUND LOCATIONS IN STREETS WITH GREATER THAN 60" R.O.W
(8) 503	METHOD B FOR RIGID AND FLEXIBLE PIPE TRENCH BACKFILL - PAVED AREAS
(9) 503.1	METHOD A FOR FLEXIBLE PIPE TRENCH BACKFILL - PAVED AREAS
(10) 503.2	METHOD A FOR RIGID PIPE TRENCH BACKFILL - PAVED AREAS
(11) 234	SIDEWALK
(12)	BACKFILL IN UNPAVED AREA AS REQUIRED BY LOCAL CODE OR AS APPROVED BY AGENCY.


210	PLACE CONDUIT
212	PLACE HIGH DENSITY POLYETHYLENE (HDPE)
240	PLACE HANDHOLE
250	PLACE MANHOLE
270	REMOVE AND RESTORE ASPHALT
280	REMOVE AND RESTORE CONCRETE
281	REMOVE AND RESTORE SIDEWALK
282	REMOVE AND RESTORE CURBING
410	PULL CABLE
411	PULL THROUGH DUCT (INNERDUCT)
520	PLACE AERIAL CABLE
630	DIRECTIONAL BORE

West Charleston Boulevard

Montclair Street

MATCH TO STA. 41+00' SHEET 11 OF 14

MATCH TO STA. 100+00' SHEET 13 OF 14

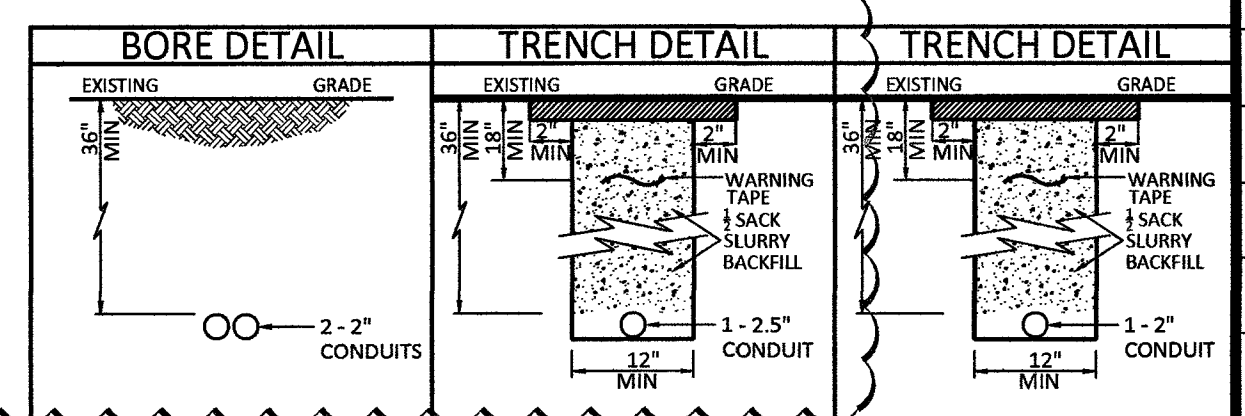


Replot
L 19-00110-R002
10/17/2019-PFB

M:\VERSION ONE\FIBER\LAS VEGAS\LSV WASHINGTON DECATUR\CONSTRUCTION DRAWINGS

L 19-00110-R002

CONSTRUCTION DRAWING
CITY OF LAS VEGAS, NEVADA

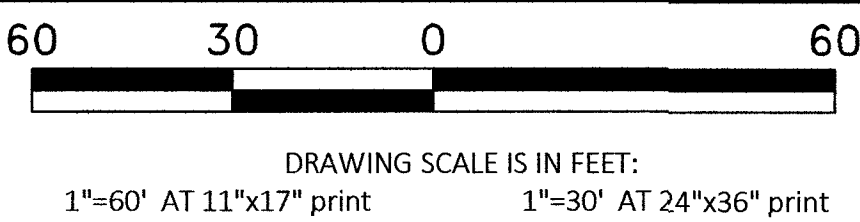


Call at least two full working days
before you begin excavation.



CELL SITE: LSV OAKLEY DECATUR - REV
06-10-19

CITY OF LAS VEGAS, NEVADA

CLARIFICATION NO.	QUANTITY
SHEET TOTAL	
2" HDPE CONDUIT:	700'
2.5" HDPE CONDUIT:	-
4" HDPE CONDUIT:	-
2' x 3' x 2' HANDHOLE(S):	-
2.5' x 5' x 2.5' HANDHOLE(S):	-
4' x 4' x 4' MANHOLE(S):	1
MANHOLE(S):	-
AERIAL:	-
VZW CONDUIT:	-
3RD PARTY CONDUIT:	-
BORE:	347'
TRENCH:	-
TOTAL NEW UG FOOTAGE:	347'
TOTAL FOOTAGE:	347'

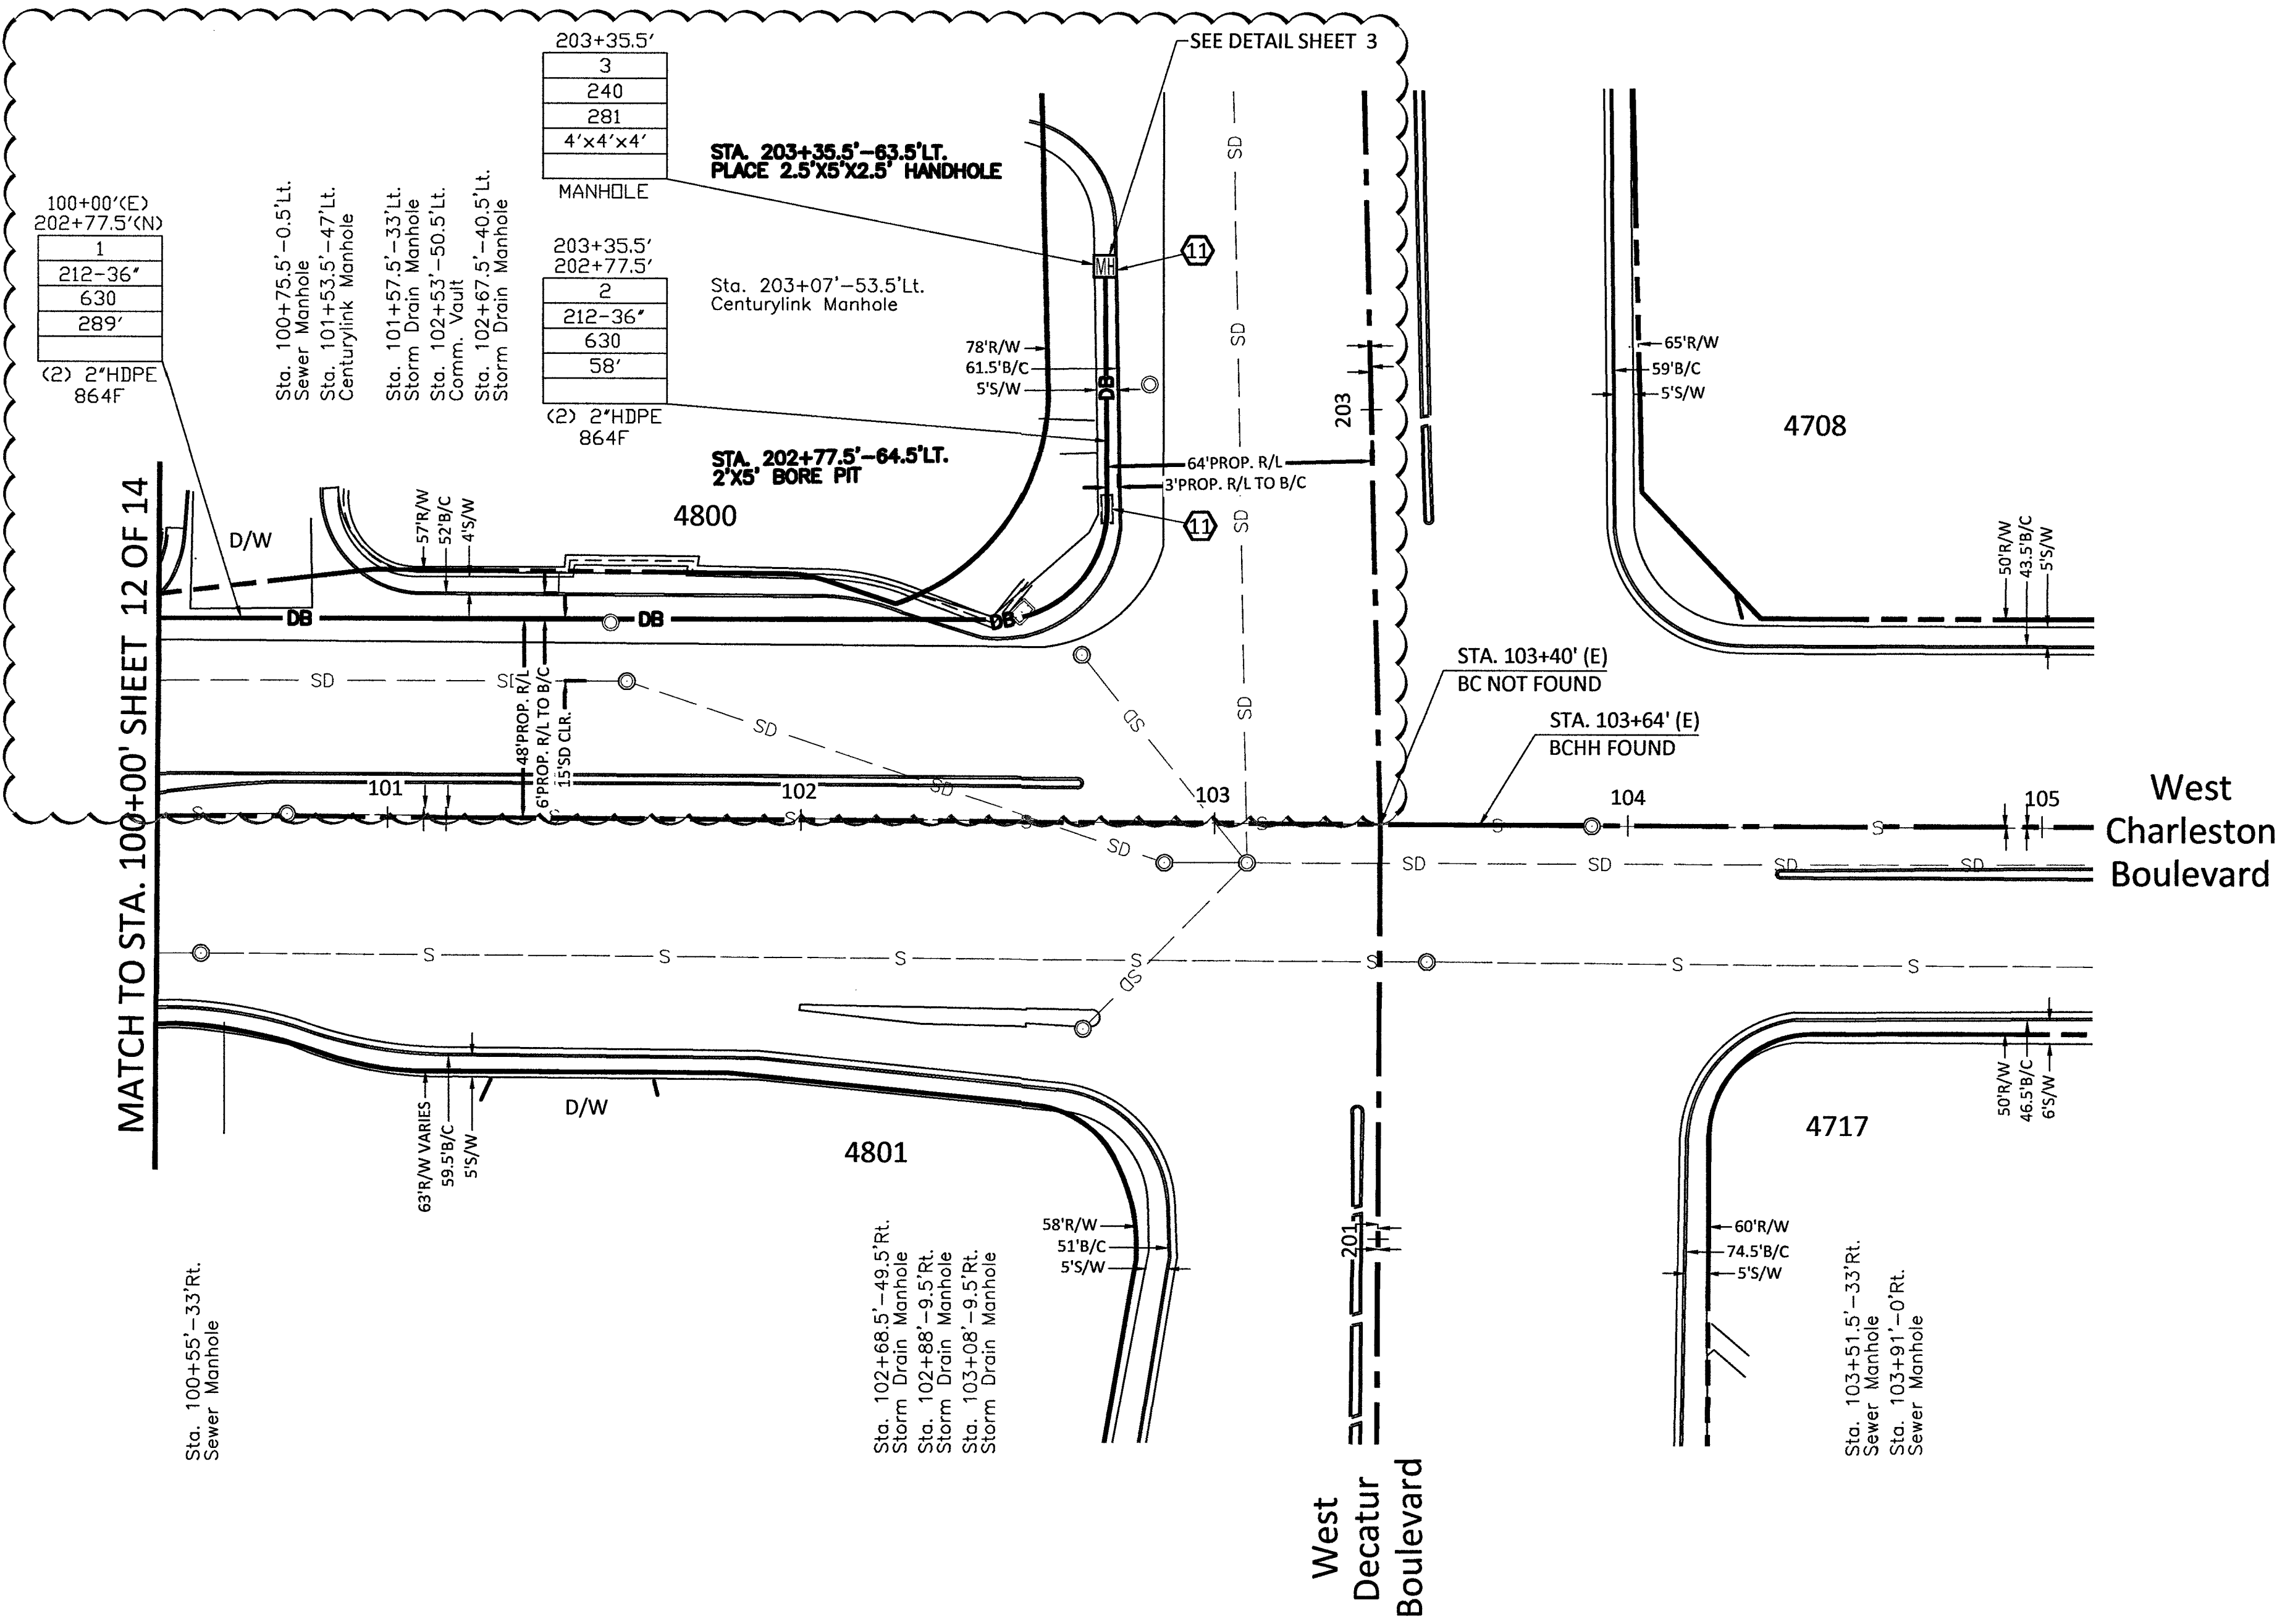


RTC NOTES:

BACKFILL AND RIGHT OF WAY RESTORATION SHALL CONFORM TO CLARK COUNTY
UNIFORM STANDARD DRAWINGS

(1) 500.1	0 TO 5 YEARS PAVEMENT RESTORATION LONGITUDINAL CUT
(2) 500.2	0 TO 5 YEARS PAVEMENT RESTORATION TRAVERSE CUT
(3) 500.3	OVER 5 YEARS PAVEMENT RESTORATION LONGITUDINAL CUT, GREATER THAN 60' R.O.W
(4) 500.4	OVER 5 YEARS PAVEMENT RESTORATION LONGITUDINAL CUT, 60' R.O.W OR LESS
(5) 500.5	OVER 5 YEARS PAVEMENT RESTORATION TRAVERSE ALL R.O.W WIDTHS
(6) 501	TYPICAL UNDERGROUND UTILITY LOCATIONS IN RESIDENTIAL STREETS 60' OR LESS R.O.W
(7) 501.1	TYPICAL UTILITY UNDERGROUND LOCATIONS IN STREETS WITH GREATER THAN 60' R.O.W
(8) 503	METHOD B FOR RIGID AND FLEXIBLE PIPE TRENCH BACKFILL - PAVED AREAS
(9) 503.1	METHOD A FOR FLEXIBLE PIPE TRENCH BACKFILL - PAVED AREAS
(10) 503.2	METHOD A FOR RIGID PIPE TRENCH BACKFILL - PAVED AREAS
(11) 234	SIDEWALK
(12) BACKFILL	IN UNPAVED AREA AS REQUIRED BY LOCAL CODE OR AS APPROVED BY AGENCY.

210	PLACE CONDUIT
212	PLACE HIGH DENSITY POLYETHYLENE (HDPE)
240	PLACE HANDHOLE
250	PLACE MANHOLE
270	REMOVE AND RESTORE ASPHALT
280	REMOVE AND RESTORE CONCRETE
281	REMOVE AND RESTORE SIDEWALK
282	REMOVE AND RESTORE CURBING
410	PULL CABLE
411	PULL THROUGH DUCT (INNERDUCT)
520	PLACE AERIAL CABLE
630	DIRECTIONAL BORE

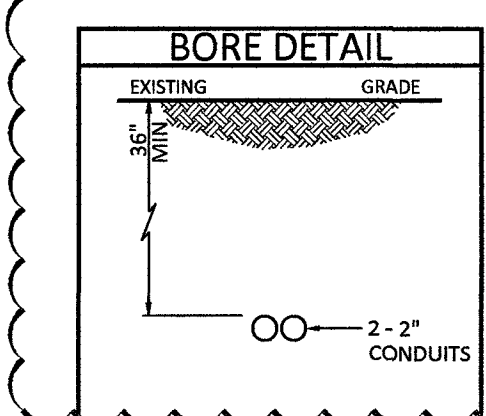

DATE: 6/10/2019
DRAWN BY: ERAMSEY

REVISIONS

DATE	DESCRIPTION	INITIAL
6-10-19	CHANGED R/L FROM 3RD PARTY TO UG	CM
	Pk 9 4 19	

EXCEPT AS MAY BE OTHERWISE PROVIDED BY CONTRACT, THESE DRAWINGS AND SPECIFICATIONS SHALL REMAIN THE PROPERTY OF MCI COMMUNICATIONS SERVICES, INC., BOTH BEING ISSUED IN STRICT CONFIDENCE AND SHALL NOT BE REPRODUCED, COPIED, OR USED FOR ANY PURPOSE WITHOUT SPECIFIC WRITTEN PERMISSION.

SCALE

HORIZONTAL: 1"=30'
VERTICAL: NA
MP _____ TO MP _____
SHEET 13 OF 14
FILE: LSV OAKLEY DECATUR - REV 06-10-19

ROUTE SCHEMATIC

Call at least two full working days
before you begin excavation.



Know what's below.
Call 811 before you dig.



CELL SITE: LSV OAKLEY DECATUR - REV
06-19-19

CITY OF LAS VEGAS, NEVADA

CLARIFICATION NO. QUANTITY

FIBER TOTALS

FIBER SIZE/LENGTH: 864F/4,378'
FIBER SIZE/LENGTH: 72F/646'

MCI
COMMUNICATIONS SERVICES, INC.
OUTSIDE PLANT CONSTRUCTION
TITLE: CELL SITE: LSV OAKLEY DECATUR
- REV 06-19-19
PROJECT TITLE

DATE: 6/19/2019

DRAWN BY: JJAMES

REVISIONS

DATE	DESCRIPTION	INITIAL
6-04-19	CHANGED R/L FROM 3RD PARTY TO UG	CM
6-19-19	ADJUSTED R/L, CALLED BOXES, STATIONS & FOOTAGE SHEET & ADJUSTED FOOTAGE SHEET & ADJUSTED SCHEMATIC SHEET 14	JJ
	pk 9 4 19	

EXCEPT AS MAY BE OTHERWISE PROVIDED BY
CONTRACT, THESE DRAWINGS AND SPECIFICATIONS
SHALL REMAIN THE PROPERTY OF MCI
COMMUNICATIONS SERVICES, INC. BOTH BEING
ISSUED IN STRICT CONFIDENCE AND SHALL NOT BE
REPRODUCED, COPIED, OR USED FOR ANY PURPOSE
WITHOUT SPECIFIC WRITTEN PERMISSION.

SCALE

HORIZONTAL: 1"=30'


VERTICAL: NA

MP TO MP

SHEET 14 OF 14

FILE: LSV OAKLEY DECATUR -
REV 06-19-19

SITE-SPAN NAME: LSV OAKLEY DECATUR								
SITE-SPAN ID: 1708APXY.009								
SEGMENT	FIBER COUNT	TRENCH	BORE	DB/OT	3RD PARTY	VZ OWNED	AERIAL	TOTAL
9111025	864F				2,664'			2,664'
9111026	72F	446'						446'
911139	864F	34'						34'
911140	864F	20'						20'
911141	864F	32'						32'
911160	864F	34'	792'					826'

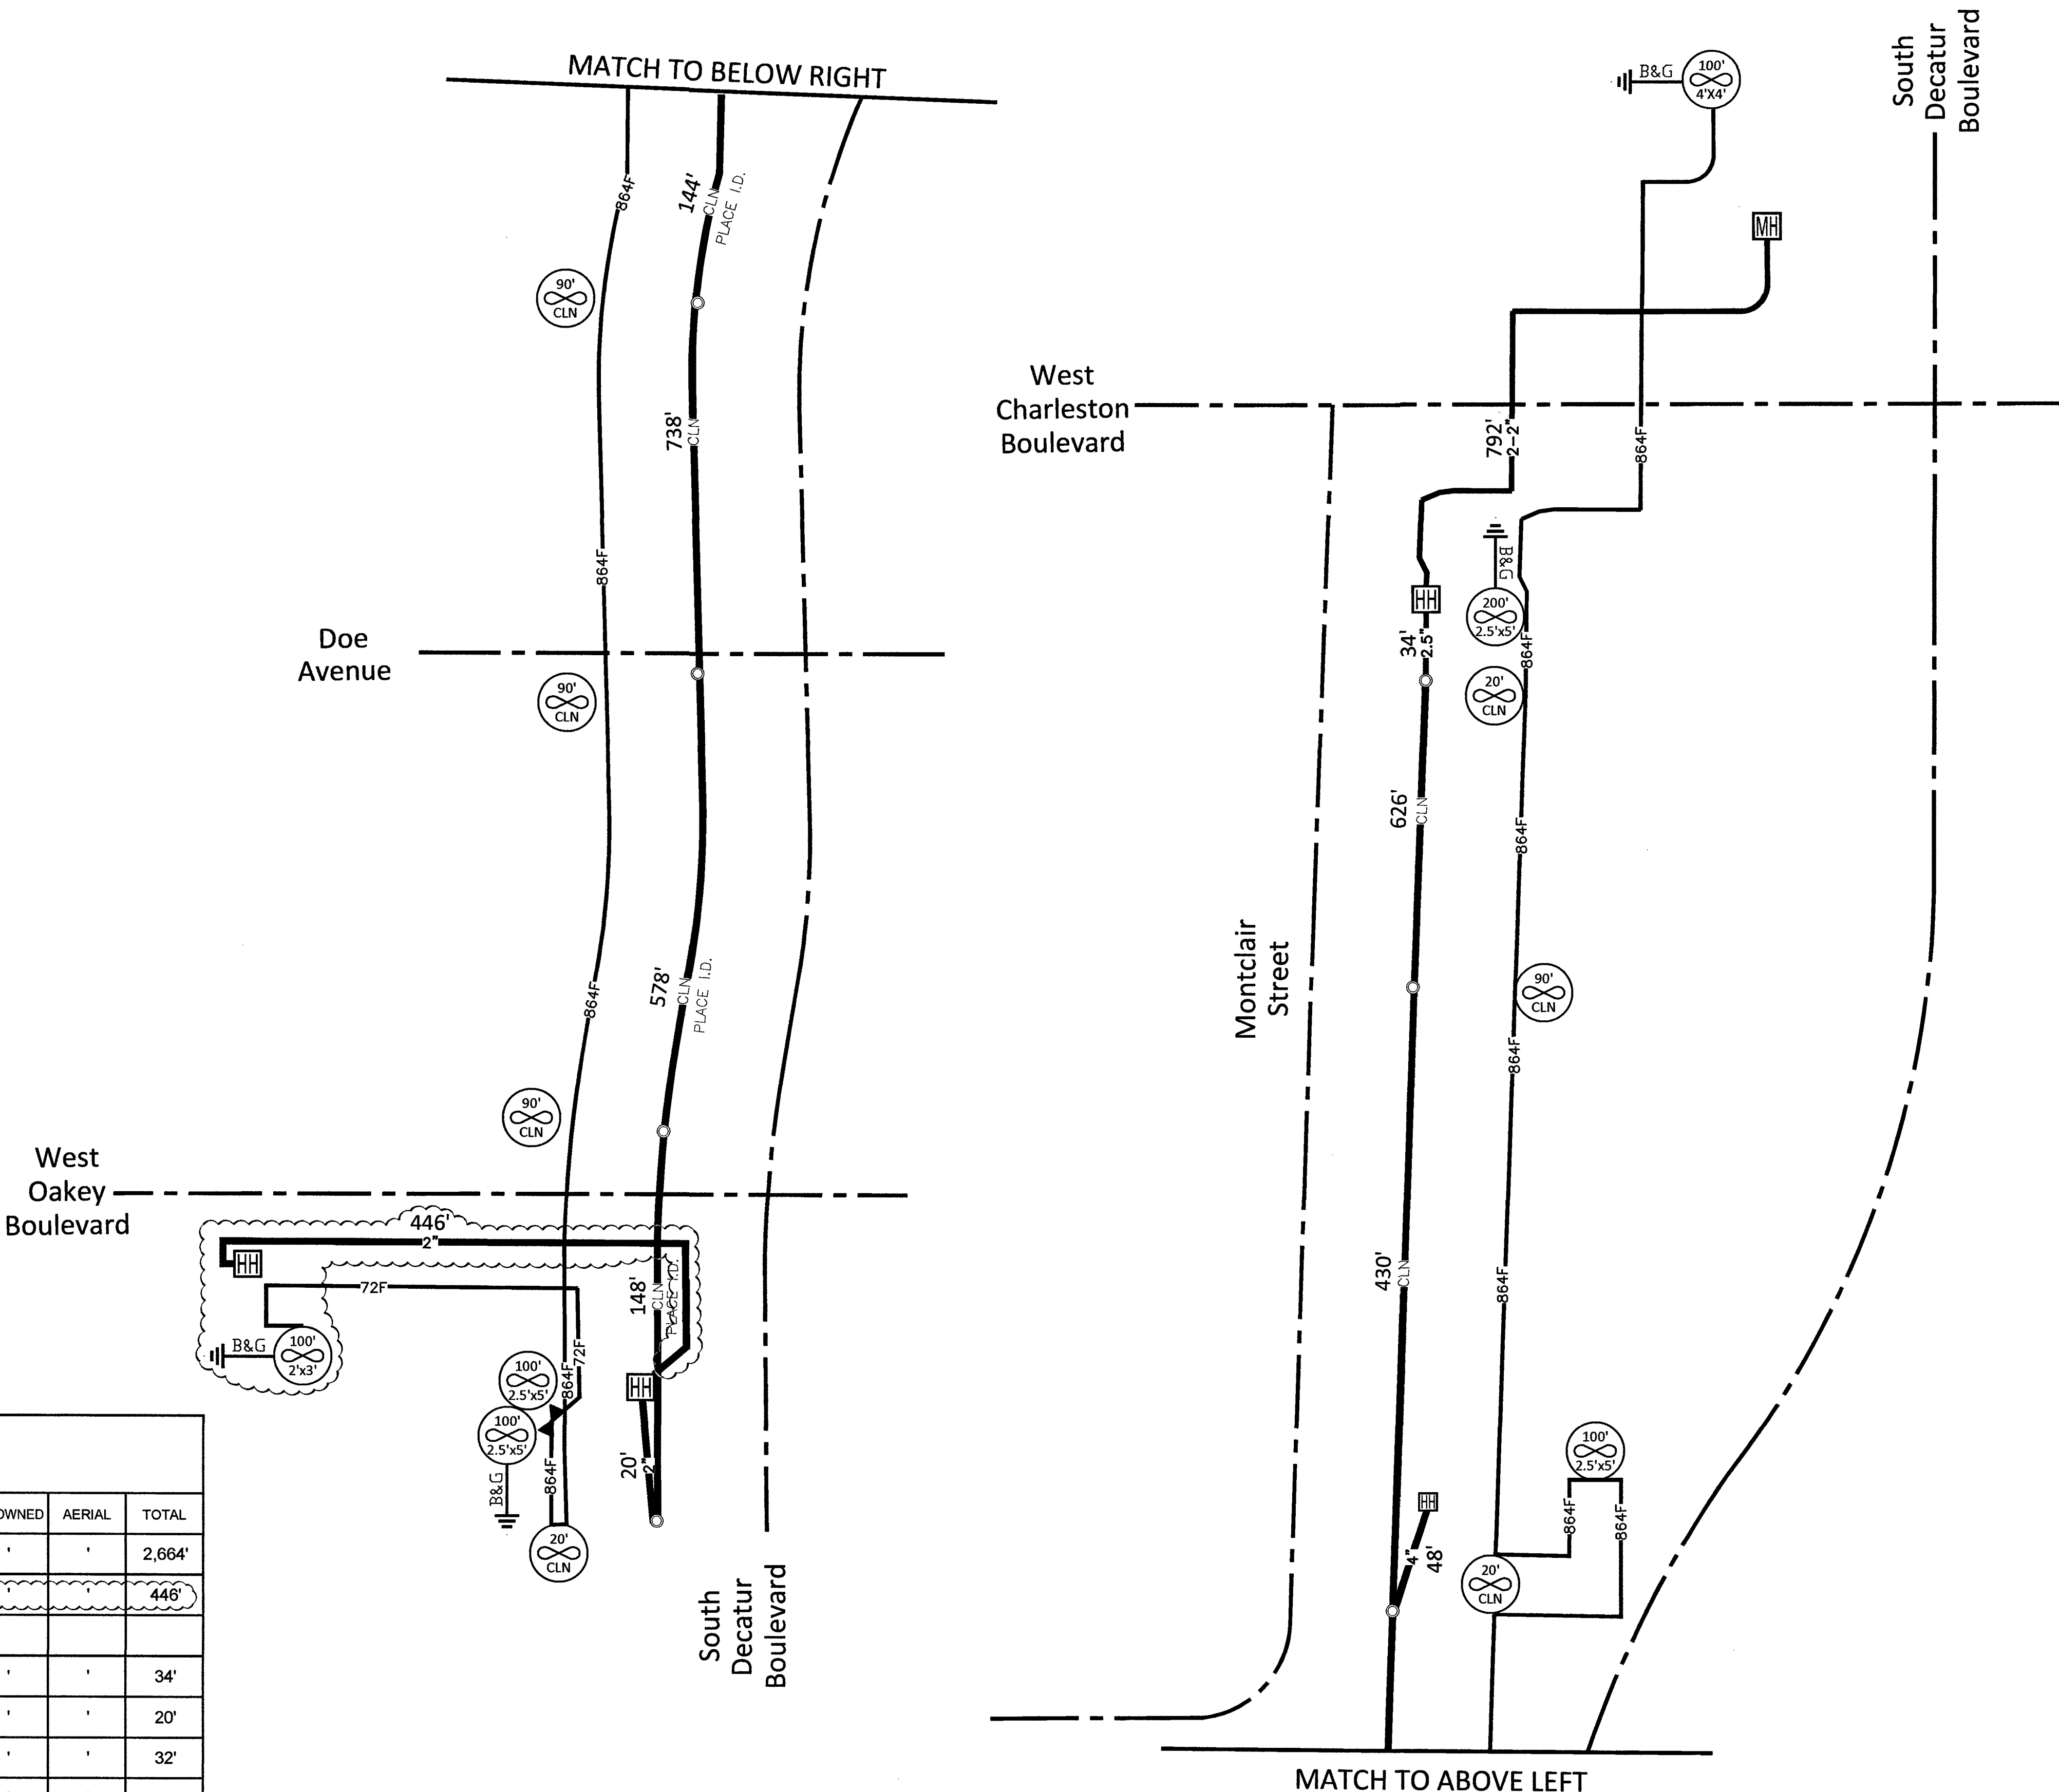

REPL 9