





- ## PROJECT GENERAL NOTES

- ## CONSTRUCTION NOTES

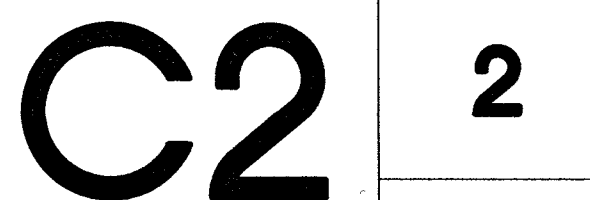

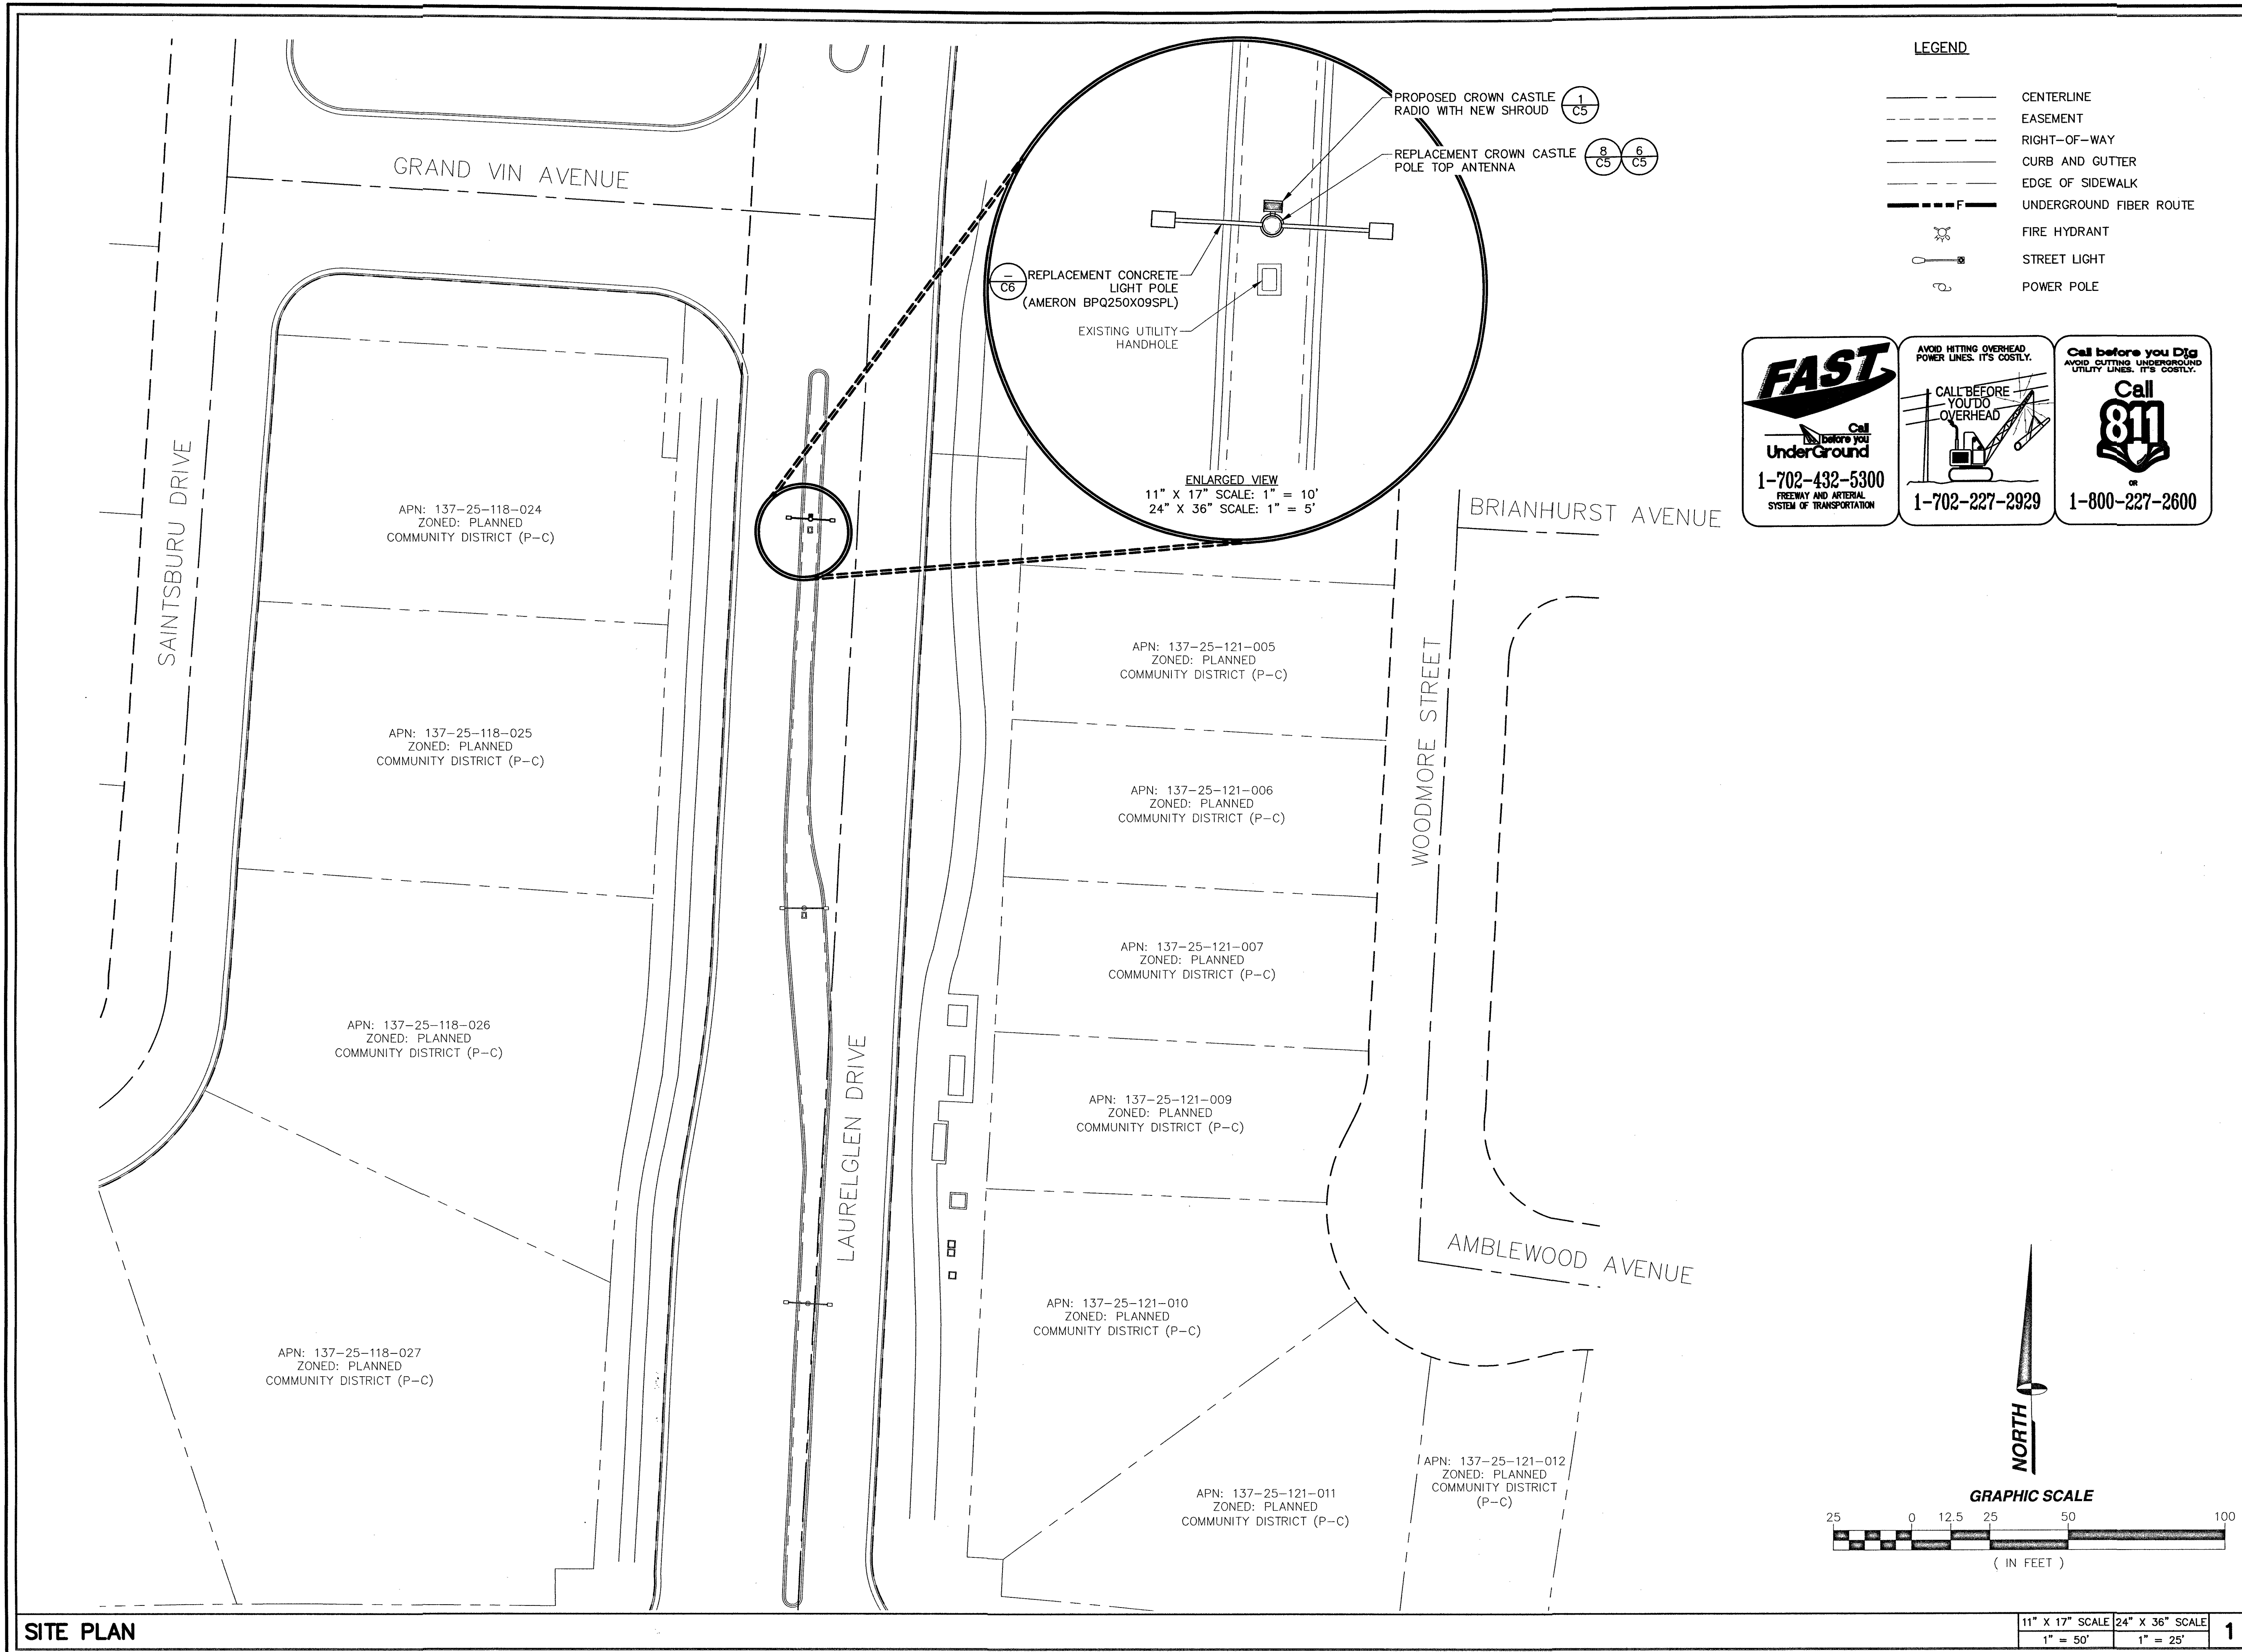

- LEGEND**
- CENTERLINE
 - - - EASEMENT
 - - - RIGHT-OF-WAY
 - - - CURB AND GUTTER
 - - - EDGE OF SIDEWALK
 - - - UNDERGROUND FIBER ROUTE
 - ⊗ FIRE HYDRANT
 - ⊕ STREET LIGHT
 - ⊙ POWER POLE

CROWN CASTLE NG WEST LLC
2055 SOUTH STEARMAN DRIVE
CHANDLER, ARIZONA 85286

PROJECT INFORMATION:

CROWN CASTLE ID # LV020

LAURELGLEN DRIVE
LAS VEGAS, NEVADA 89144

CURRENT ISSUE DATE:

04/04/19

ISSUED FOR:

PROPOSED WORK

REV.	DATE	DESCRIPTION	BY
2	02/05/19	POLE REVISION	D.C.
1	10/16/18	100% PERMITTING	C.P.
0	09/27/18	90% PERMITTING	D.C.

PLANS PREPARED BY:

SPECTRUM SERVICES, INC.
4850 WEST OQUENDO ROAD
LAS VEGAS, NEVADA 89118
PHONE: (702) 367-7705
FAX: (702) 367-8733

LICENSURE:

SHEET TITLE:

SITE PLAN

SHEET NUMBER:	REVISION:
C3	2

SITE PLAN

11" X 17" SCALE 24" X 36" SCALE
1" = 50' 1" = 25' 1

PROJECT INFORMATION:

CROWN CASTLE ID #
LV020

LAURELGLEN DRIVE
LAS VEGAS, NEVADA 89144

CURRENT ISSUE DATE:

04/04/19

ISSUED FOR:

PROPOSED WORK


REV.: DATE: DESCRIPTION: BY:

REV.	DATE	DESCRIPTION	BY
3	04/04/19	LAND DEV. COMMENTS	R.S.
2	02/05/19	POLE REVISION	D.C.
1	10/16/18	100% PERMITTING	C.P.
0	09/27/18	90% PERMITTING	D.C.

PLANS PREPARED BY:

SPECTRUM
SPECTRUM SERVICES, INC.
4850 WEST OQUENDO ROAD
LAS VEGAS, NEVADA 89118
PHONE: (702) 367-7705
FAX: (702) 367-8733

LICENSURE:

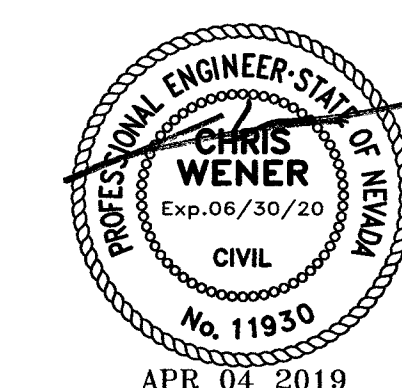


SHEET TITLE:

EXISTING AND PROPOSED
NORTH ELEVATION

SHEET NUMBER: REVISION:

C4 **3**

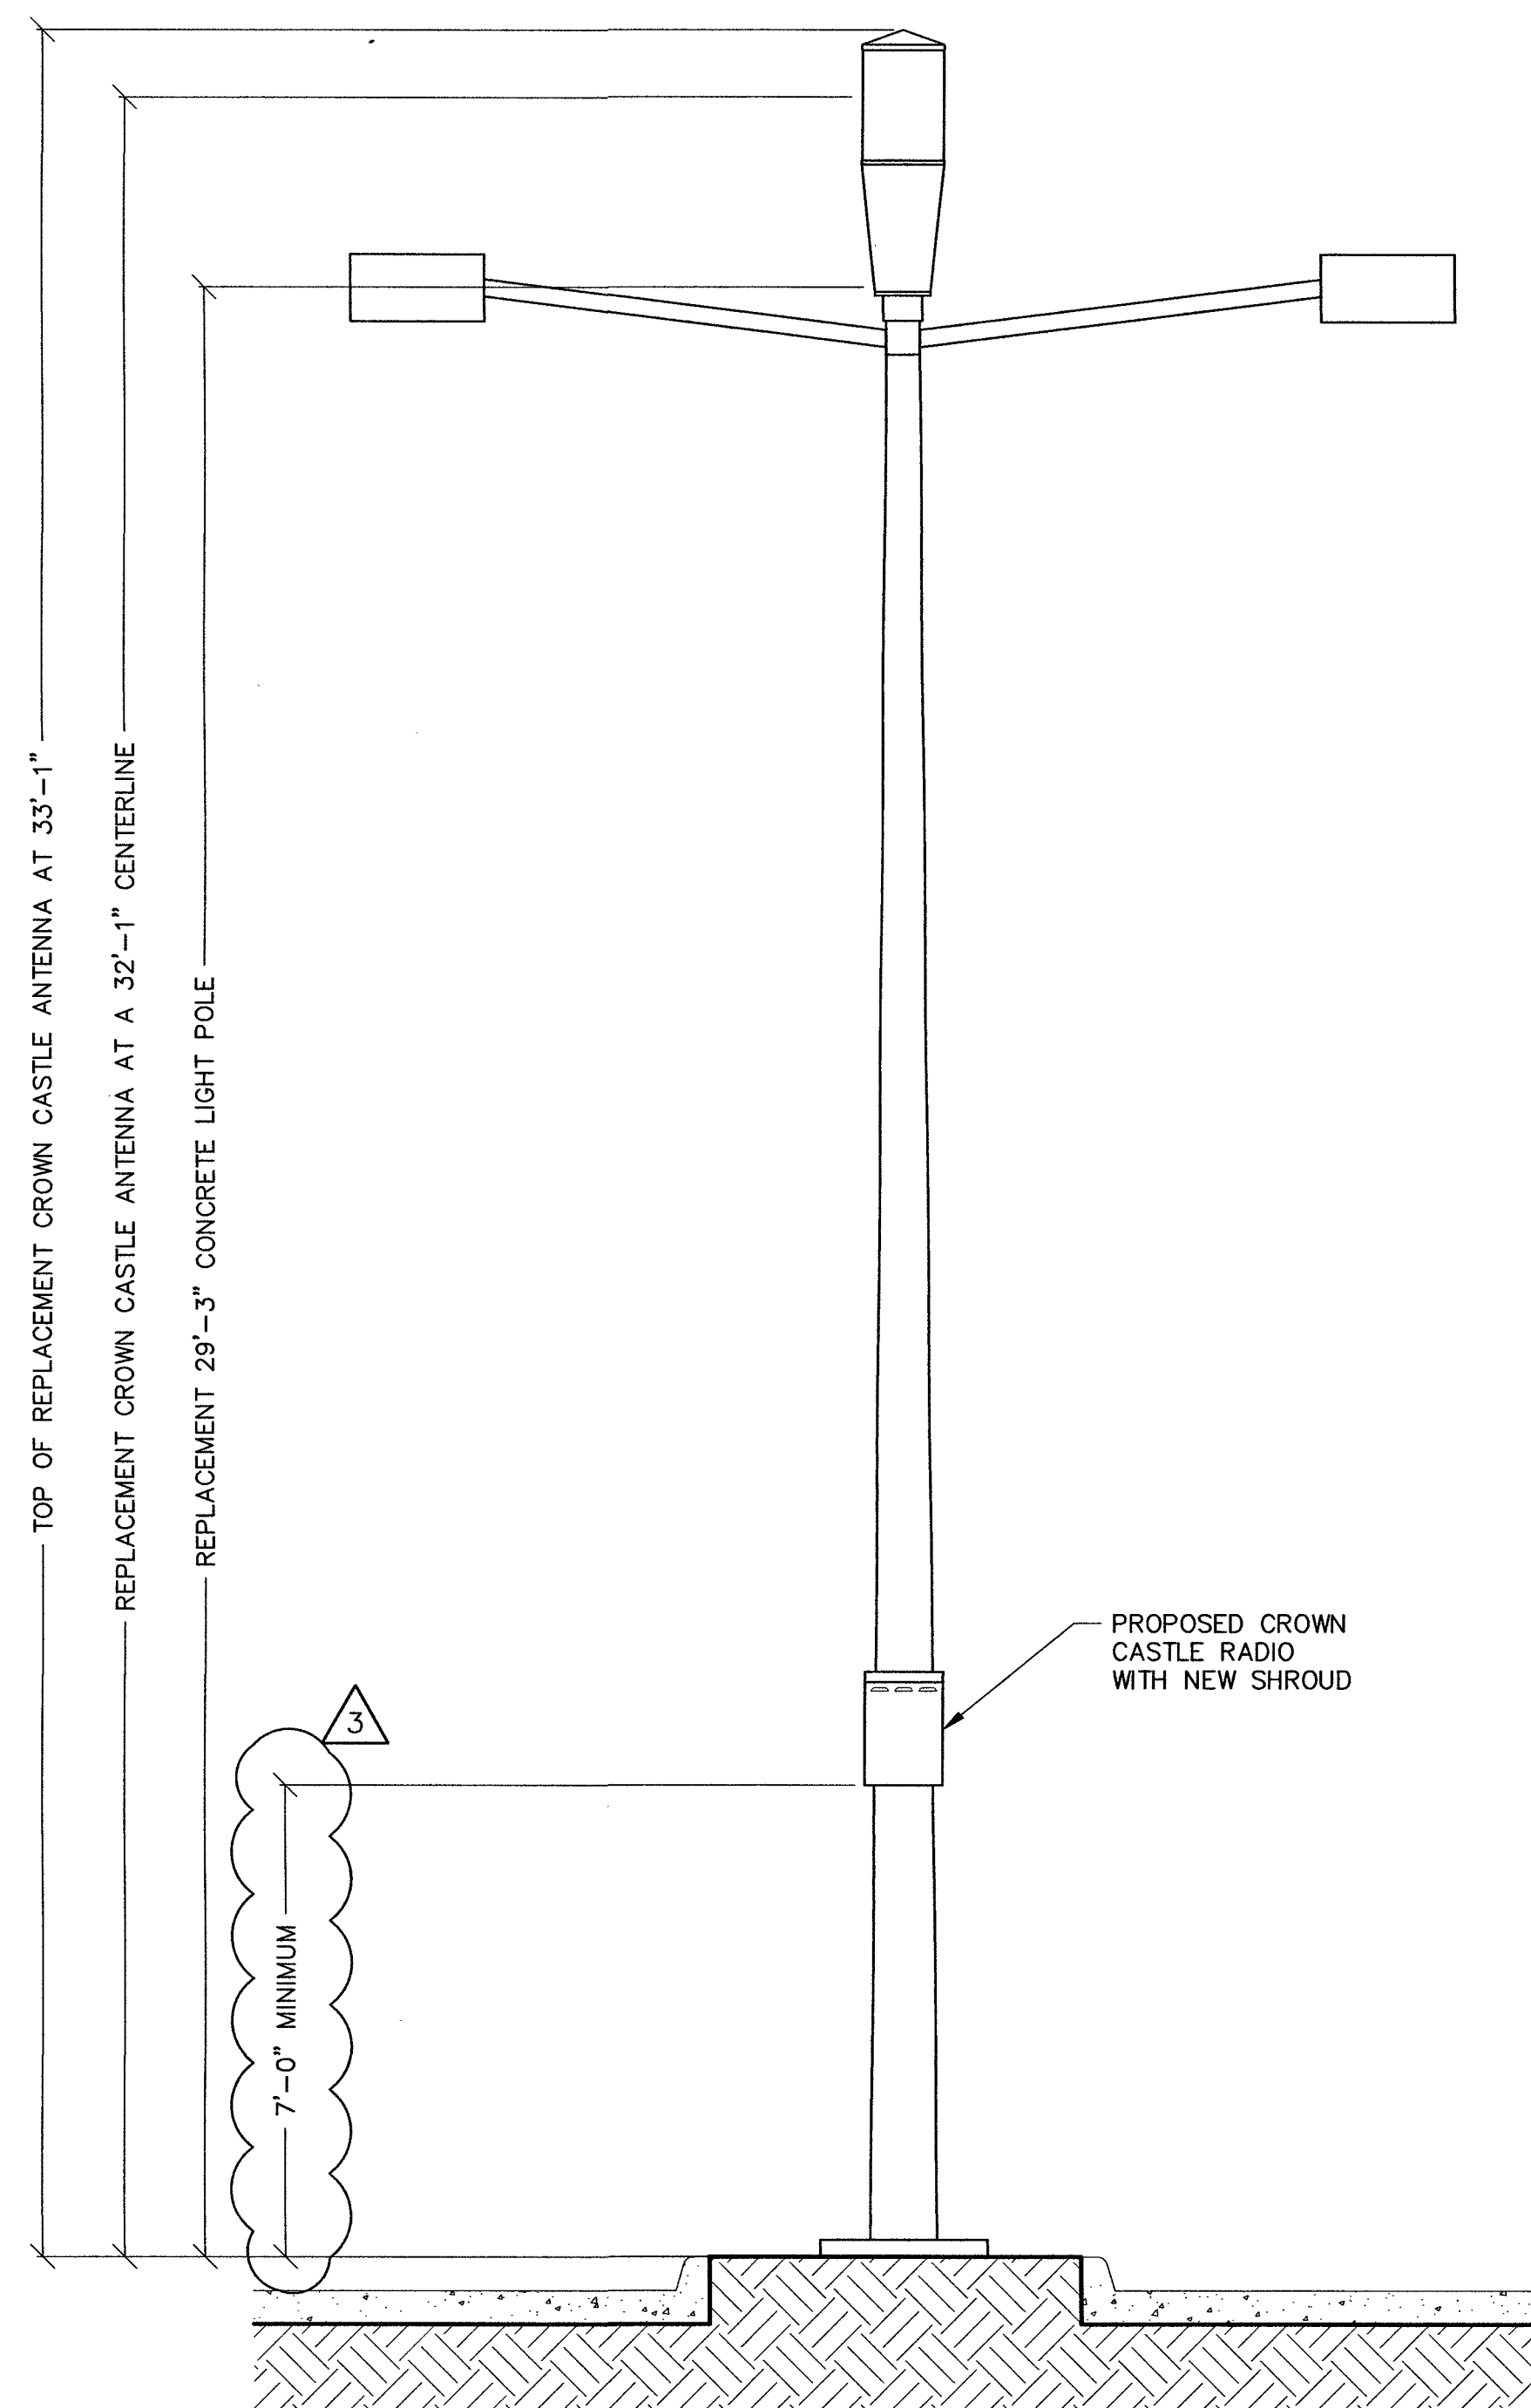


PROPOSED NORTH ELEVATION

11" X 17" SCALE 24" X 36" SCALE
1" = 5' 1" = 2'-6"


2

EXISTING NORTH ELEVATION

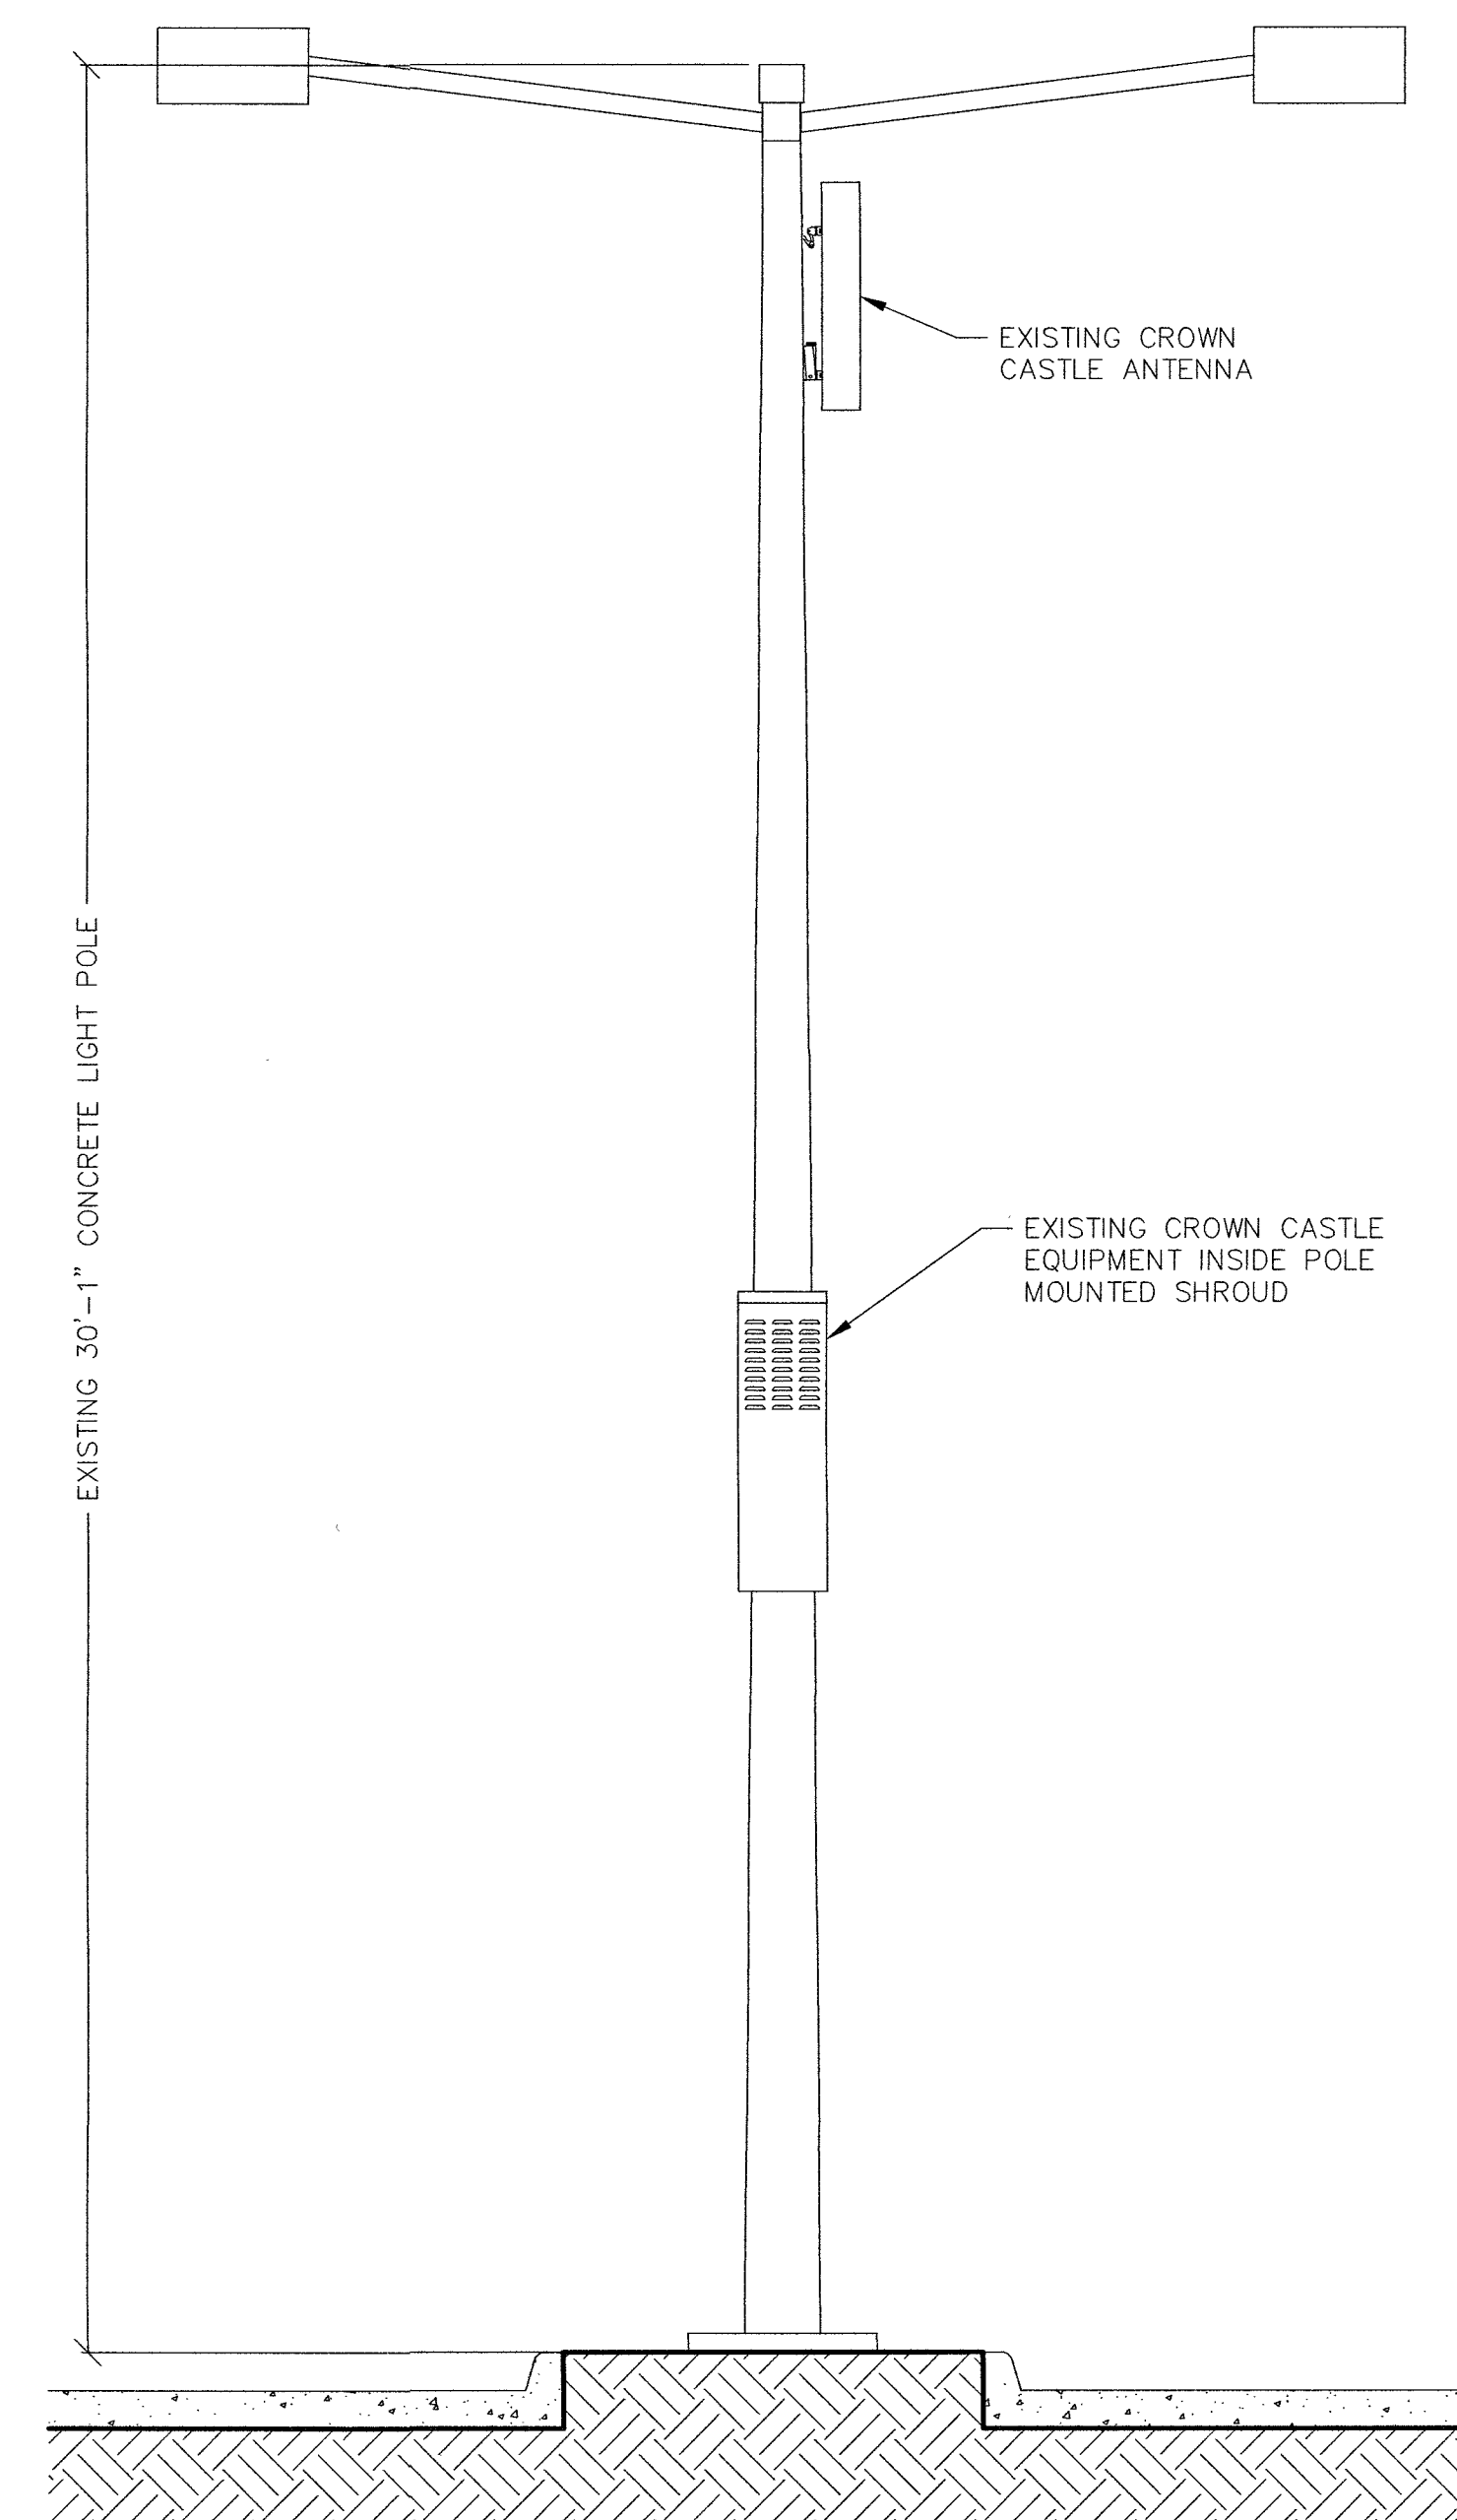

11" X 17" SCALE 24" X 36" SCALE
1" = 5' 1" = 2'-6"

1

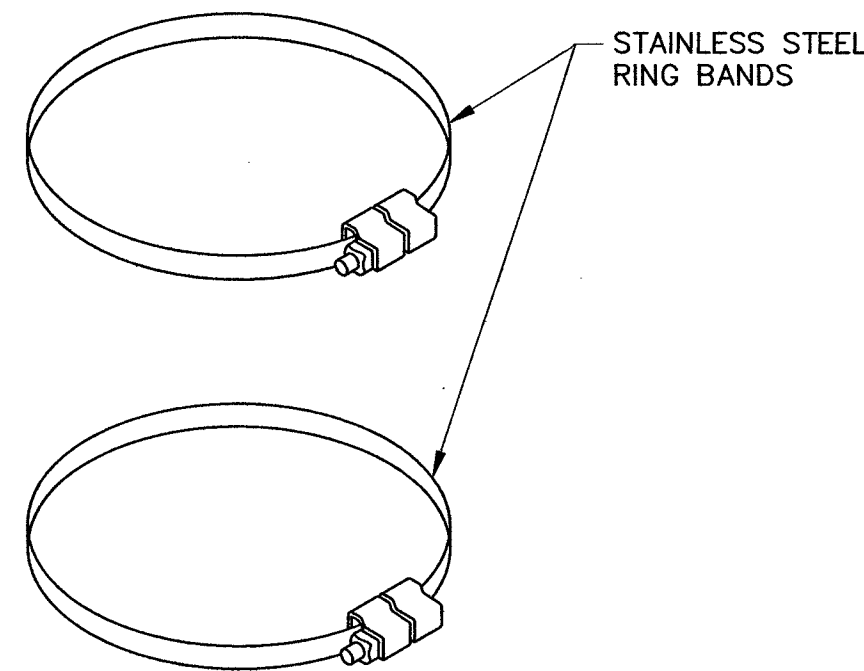



AMPHENOL 2C2U3MT360X06FY70 ANTENNA SPECIFICATIONS
INPUT CONNECTOR (2X) 4.3/10 OR 7/16-DIN / FEMALE / BOTTOM
DIMENSION (H x DIA.) 24.0 x 14.6 IN.
ANTENNA WEIGHT 22.1 LBS
LIGHTNING PROTECTION DIRECT GROUND

WIND SURVIVAL SPEED
241 KM/HR - 150 MPH

WIND LOAD @ 100 MPH (160 KM/HR)
191 N - 43 LBF

Ø4" & 6" Ø BCD FOR
3/8"-16 UNC MOUNTING
STUDS (X6) AT 120°
APART THEY EXTEND 1
1/4" BELOW PLATE FOR
MOUNTING

NOTES:
1. CONNECTOR HOLES ARE 2" FROM CENTER TO CENTER
APART IN EACH SECTOR

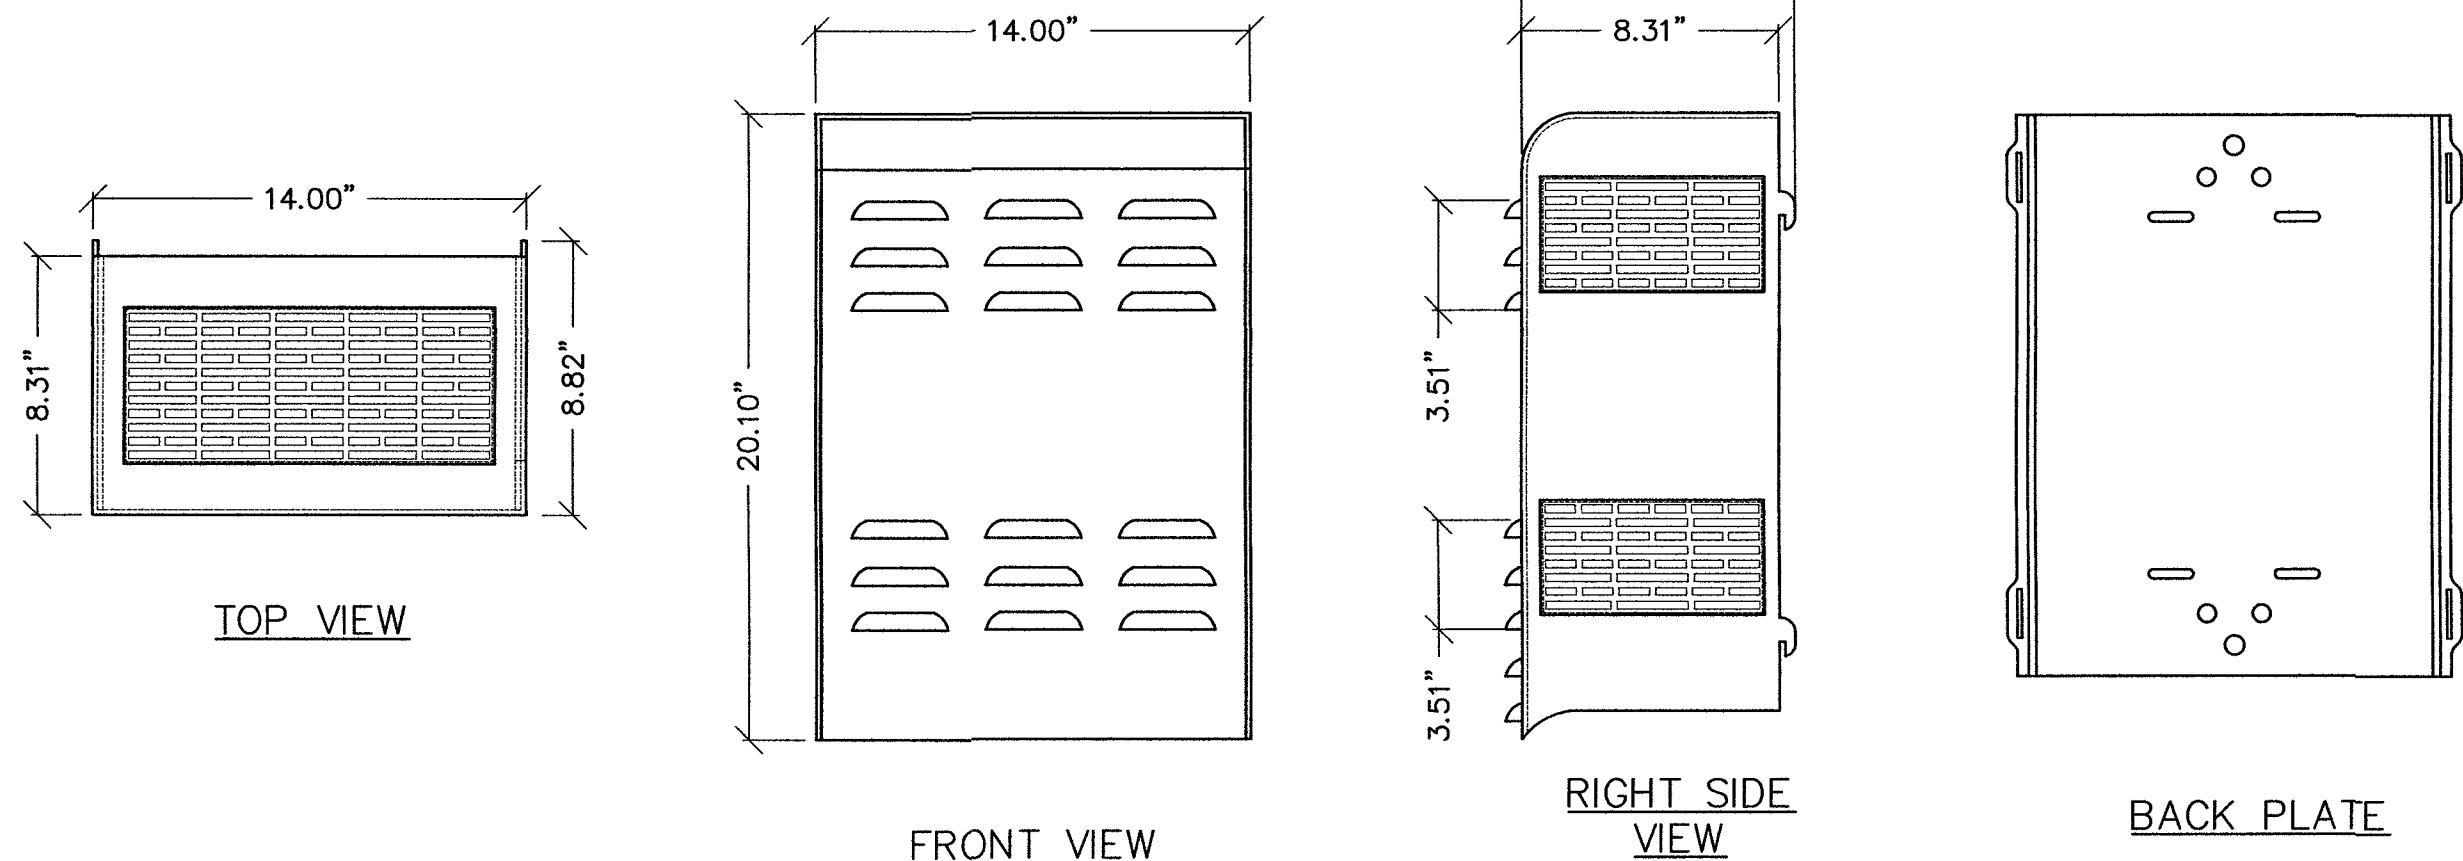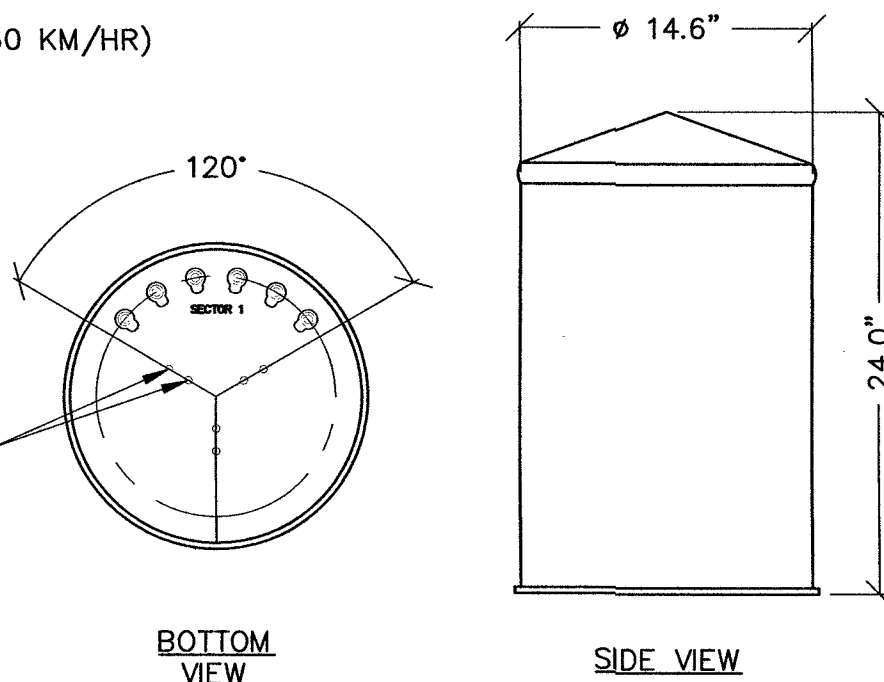

STAINLESS STEEL RING BAND

SCALE:
NONE

9

ANTENNA DETAIL





SCALE:
NONE

7

RADIO SHROUD

SCALE:
NONE

2

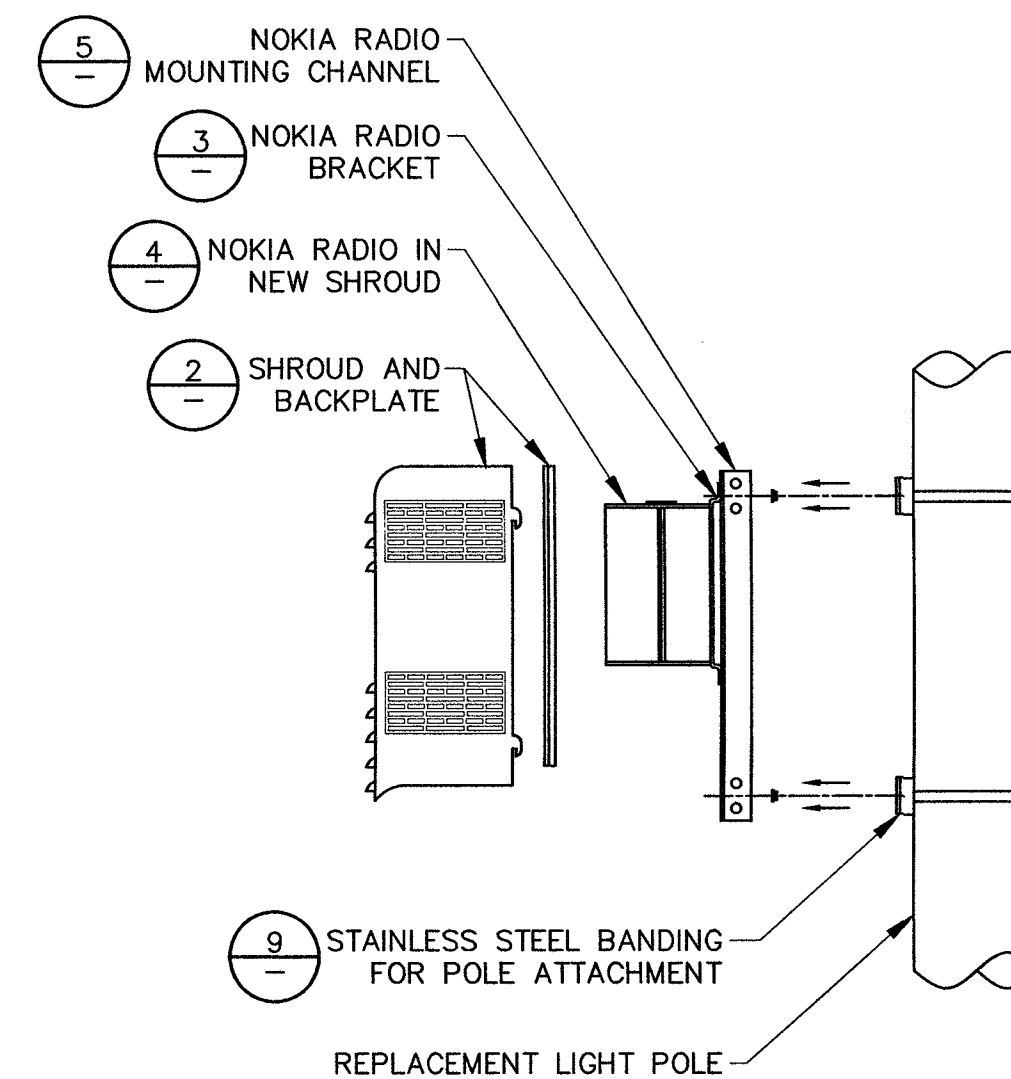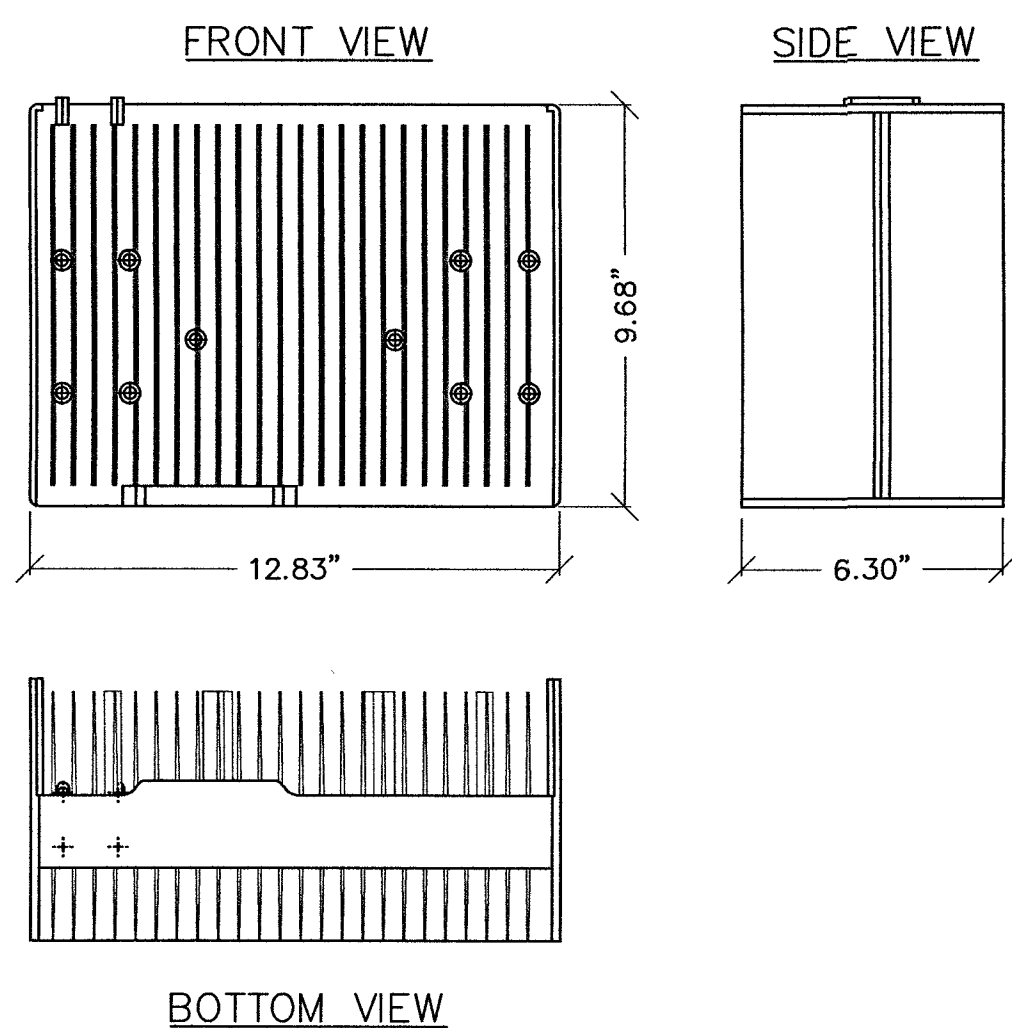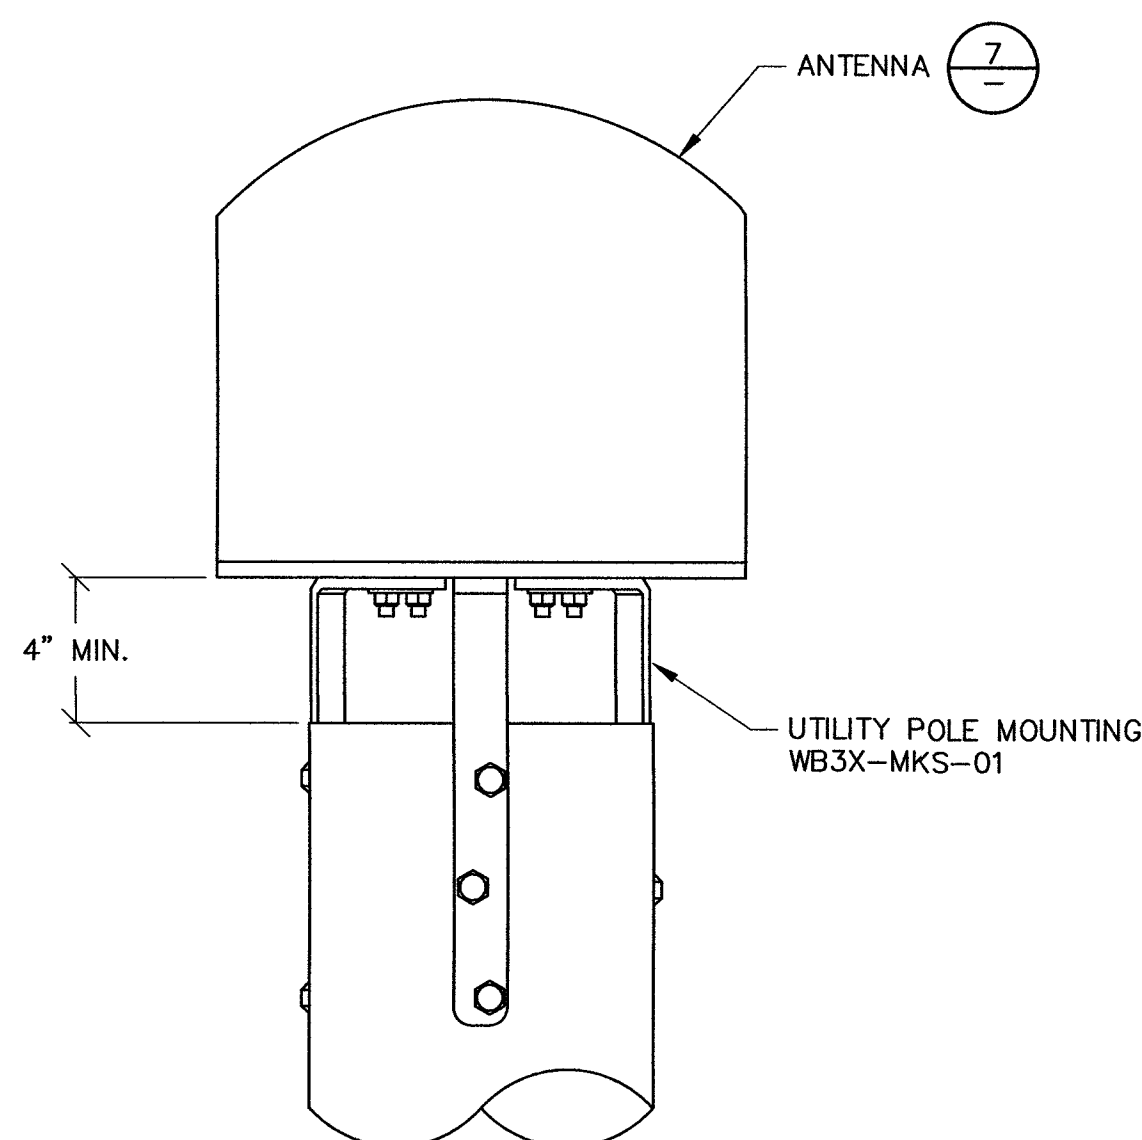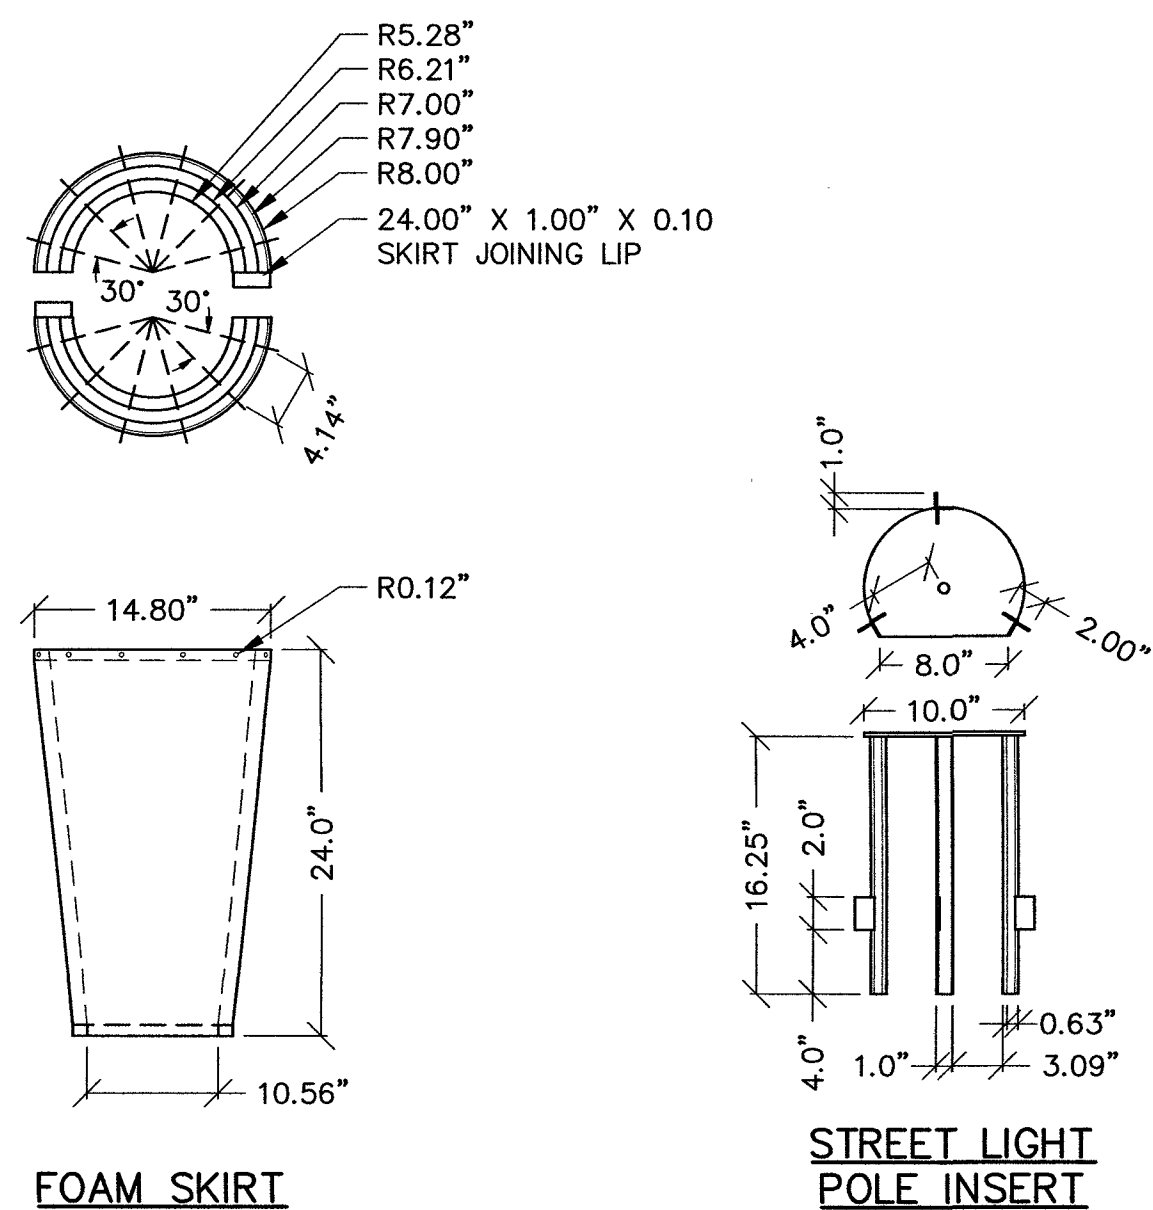


2	02/05/19	POLE REVISION	D.C.
1	10/16/18	100% PERMITTING	C.P.
0	09/27/18	90% PERMITTING	D.C.

PLANS PREPARED BY:

SPECTRUM

SPECTRUM SERVICES, INC.
4850 WEST OQUENDO ROAD
LAS VEGAS, NEVADA 89118
PHONE: (702) 367-7705
FAX: (702) 367-8733

LICENSURE:

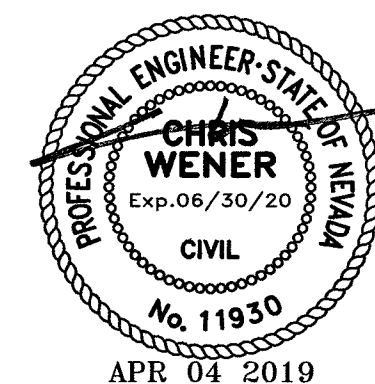

SHEET TITLE:

CONSTRUCTION DETAILS

SHEET NUMBER: REVISION:

C5 2

ANTENNA SHROUD

SCALE:
NONE

8

NOKIA 20W RADIO MOUNTING CHANNEL

SCALE:
NONE

5

NOKIA 20W RADIO BRACKET



SCALE:
NONE

3

SHROUD ASSEMBLY

SCALE:
NONE

1

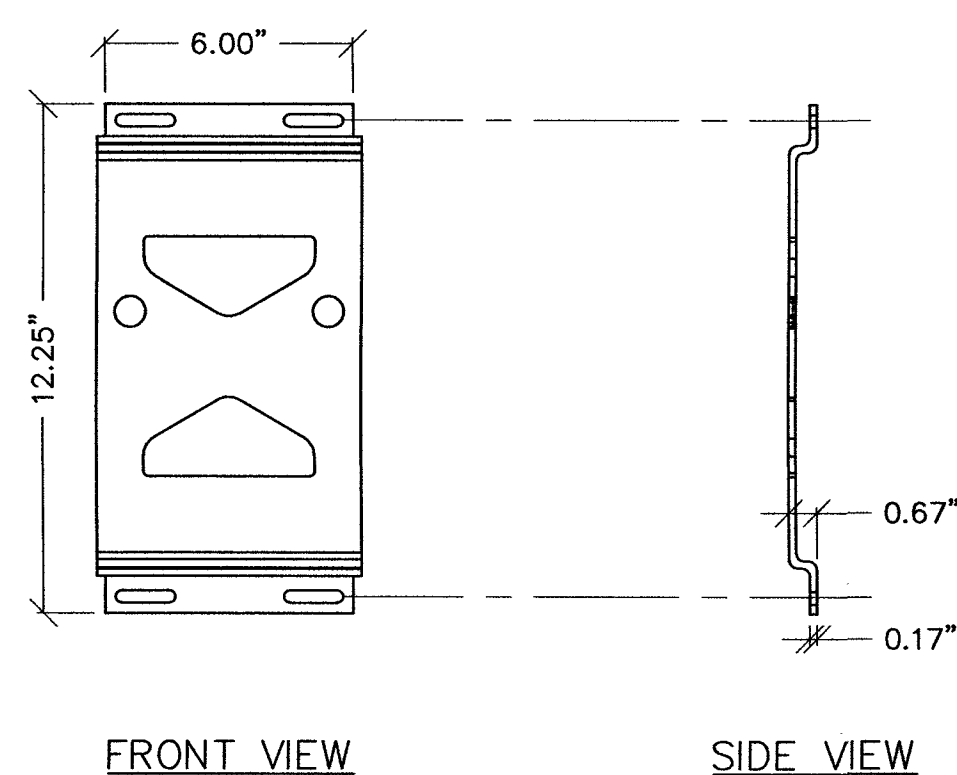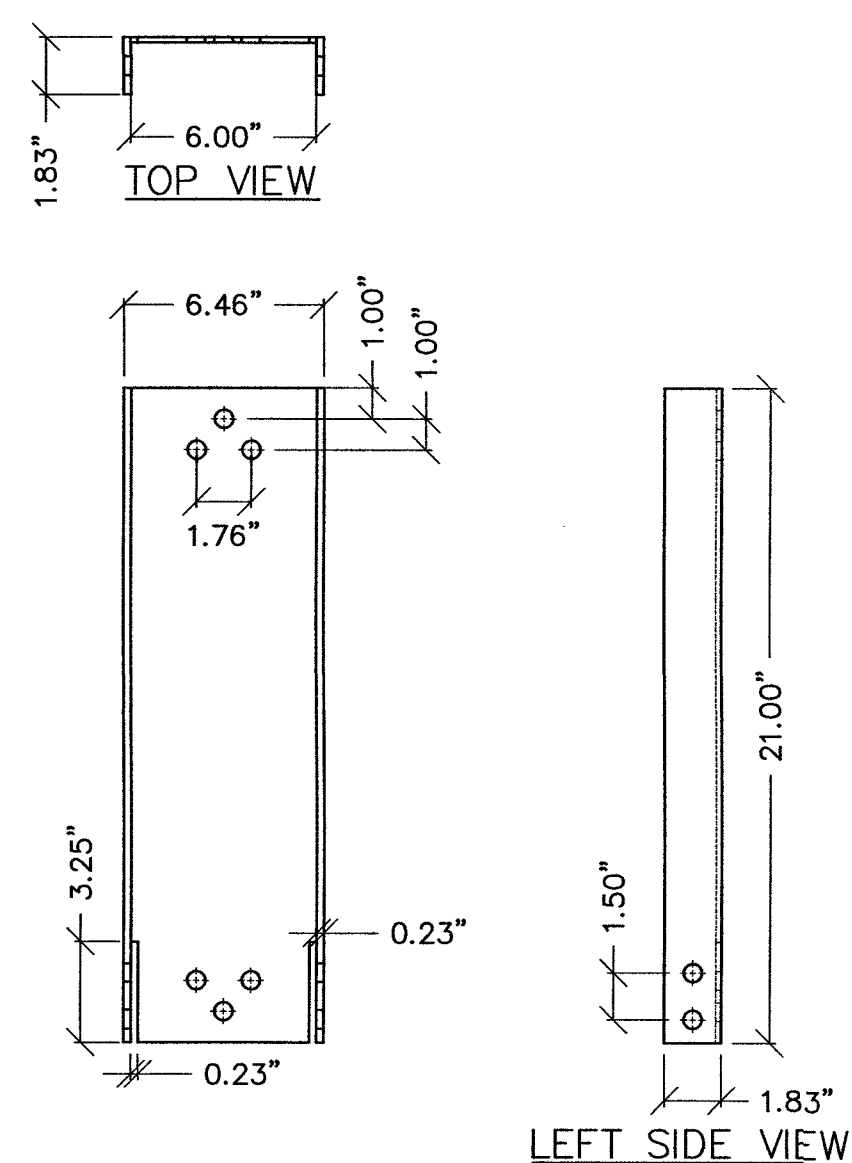



CROWN CASTLE NG WEST LLC
2055 SOUTH STEARMAN DRIVE
CHANDLER, ARIZONA 85286

PROJECT INFORMATION:

CROWN CASTLE ID #
LV020

LAURELGLEN DRIVE
LAS VEGAS, NEVADA 89144

CURRENT ISSUE DATE:

04/04/19

ISSUED FOR:

PROPOSED WORK

REV.: DATE: DESCRIPTION: BY:


REV.	DATE	DESCRIPTION	BY
3	04/04/19	LAND DEV. COMMENTS	R.S.
2	02/05/19	POLE REVISION	D.C.
1	10/16/18	100% PERMITTING	C.P.
0	09/27/18	90% PERMITTING	D.C.

PLANS PREPARED BY:



SPECTRUM SERVICES, INC.
4850 WEST OQUENDO ROAD
LAS VEGAS, NEVADA 89118
PHONE: (702) 367-7705
FAX: (702) 367-8733

LICENSURE:

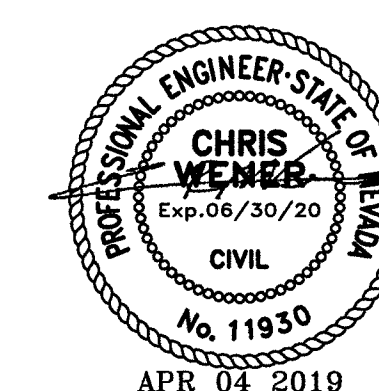


SHEET TITLE:

CONSTRUCTION DETAILS


SHEET NUMBER: REVISION:

C6 3

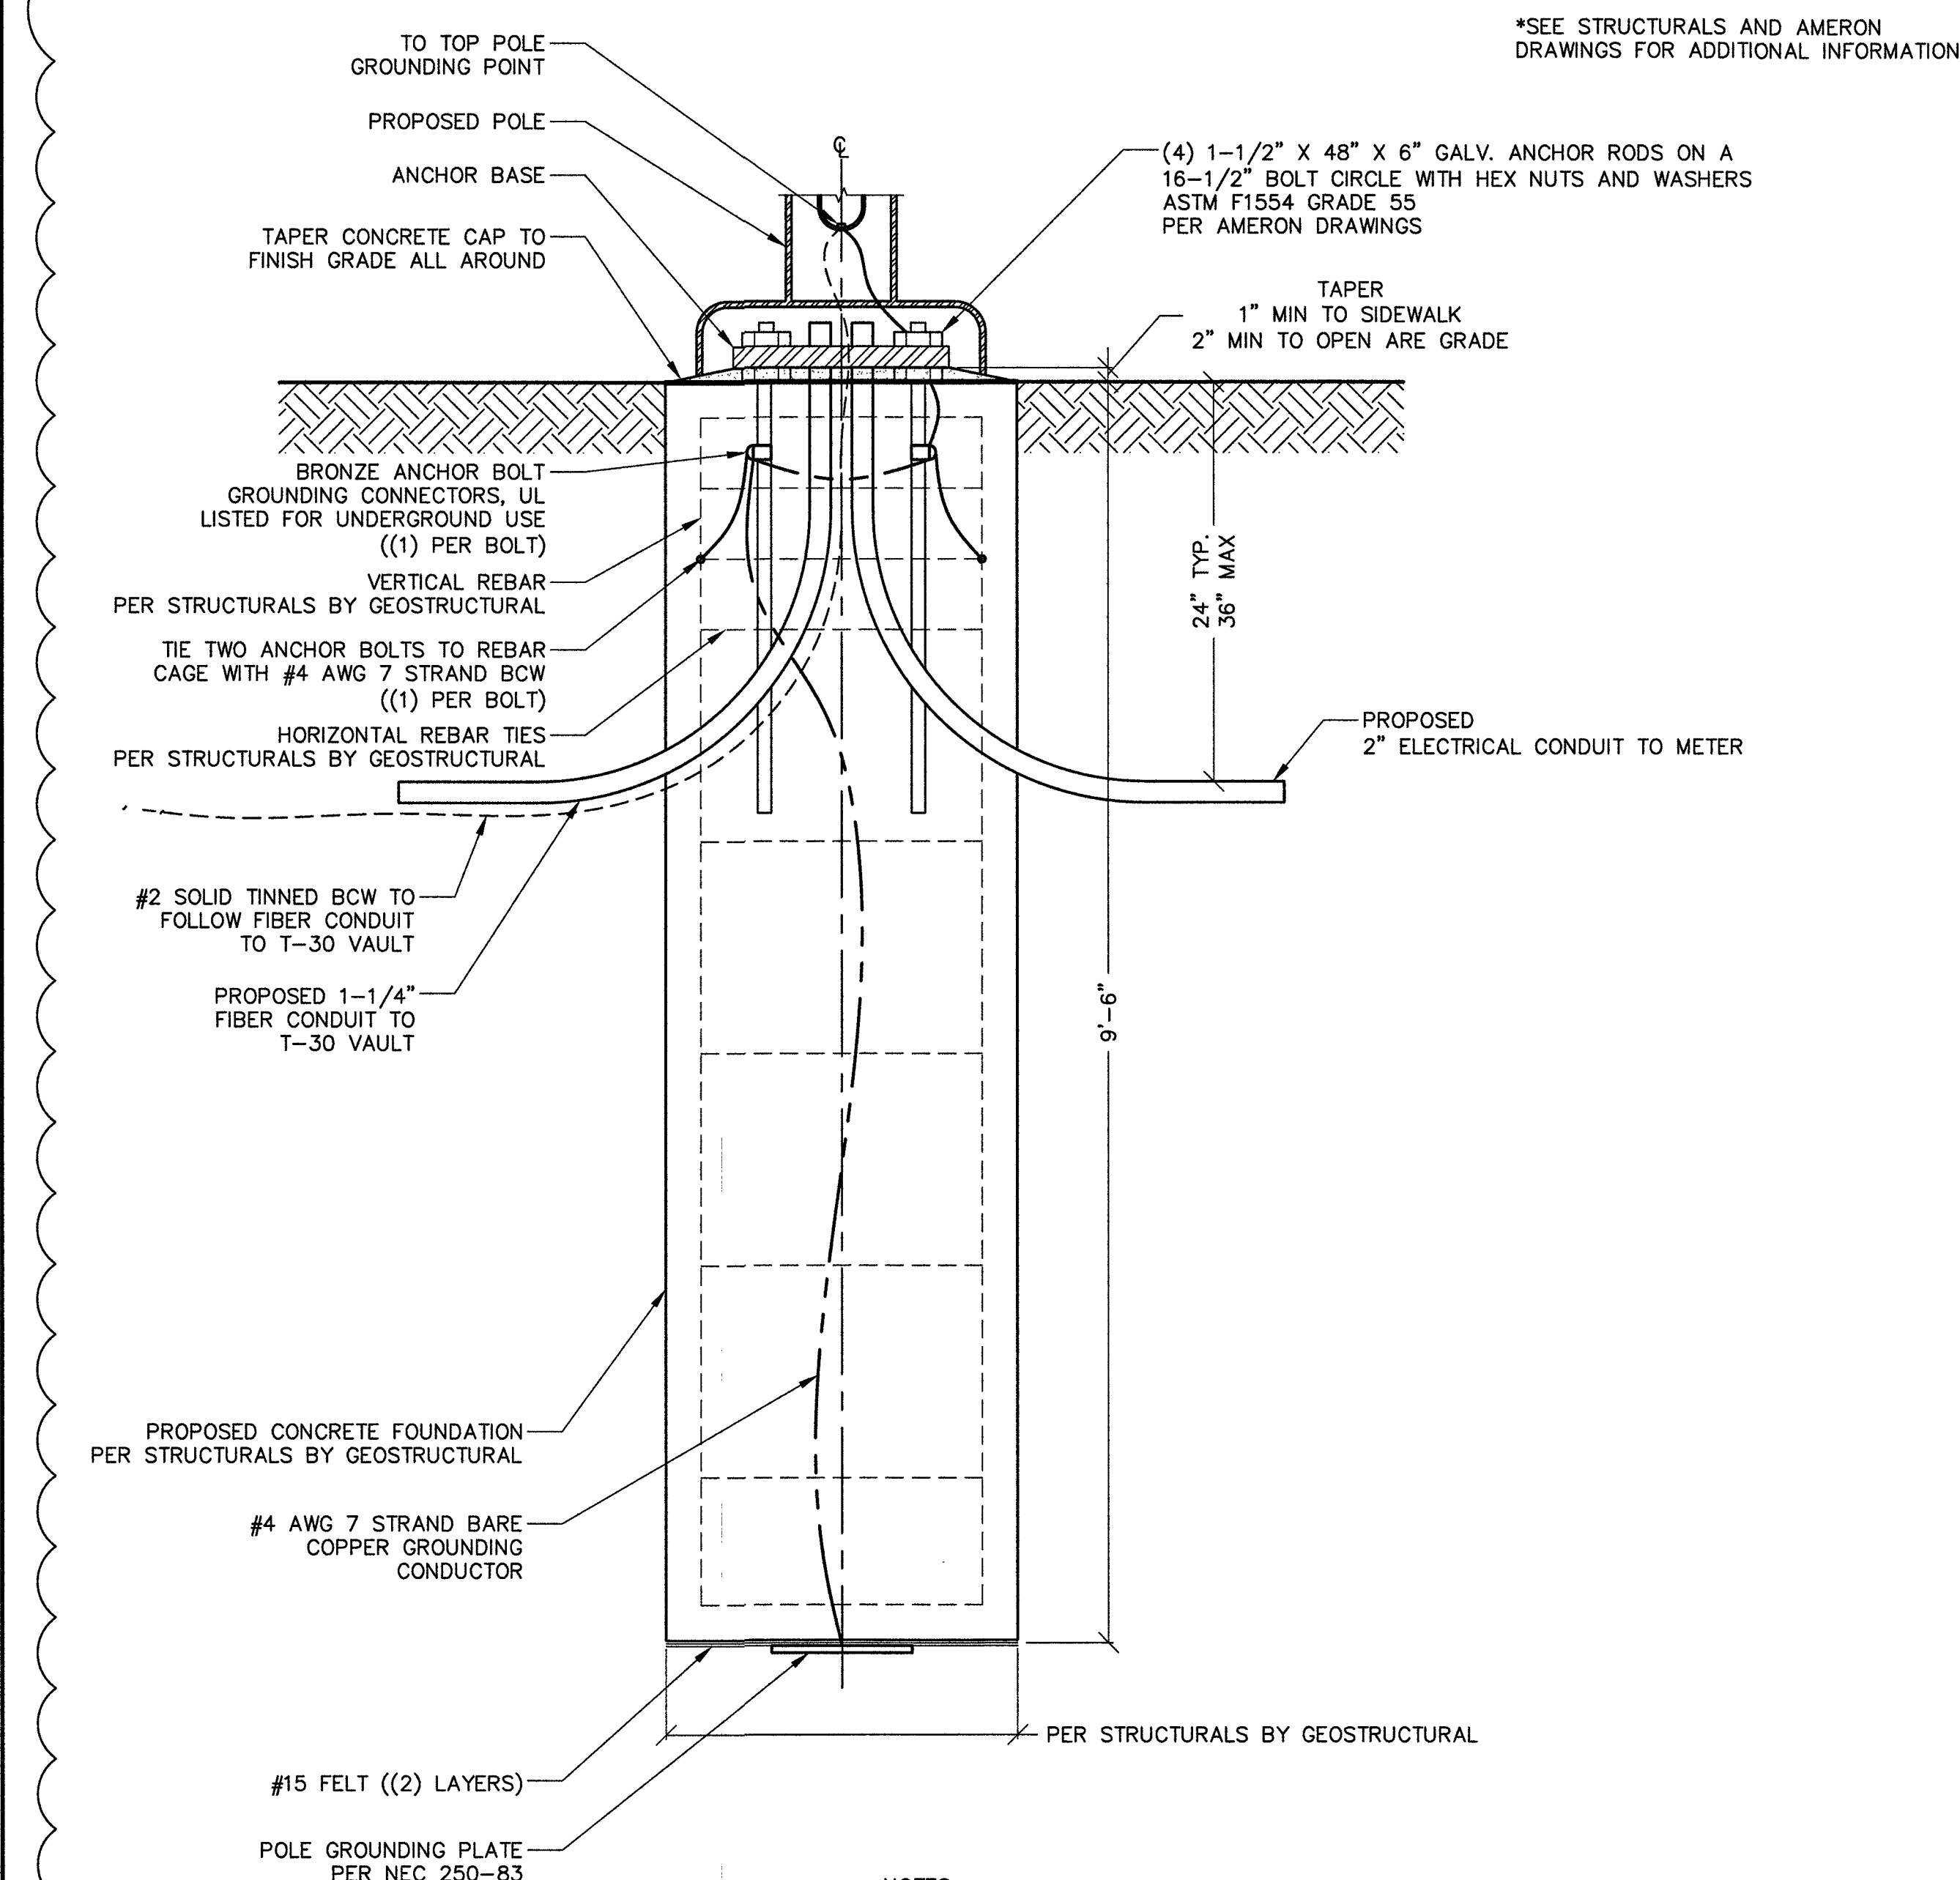

NOTES:

1. CONCRETE SHALL HAVE A MINIMUM 28-DAY COMPRESSIVE STRENGTH OF 4500 PSI, IN ACCORDANCE WITH ACI 318-11. BASE PLATE GROUT STRENGTH AT 8000 PSI.
2. USE TYPE V PORTLAND CEMENT AND A MAXIMUM WATER-CEMENT RATIO OF 0.45.
3. REBAR TO CONFORM TO ASTM SPECIFICATION A615 GRADE 60.
4. ALL REBAR TO HAVE A MINIMUM OF 3" CONCRETE COVER.
5. ALL EXPOSED CONCRETE CORNERS TO BE CHAMFERED 3/4".
6. SEE THE GEOTECHNICAL REPORT FOR DRILLED PIER INSTALLATION REQUIREMENTS, IF SPECIFIED.
7. ANCHOR RODS ARE TO BE (4) 1-1/2" DIAMETER ASTM F1554 GRADE 55 ON A 16"-1/2" DIAMETER BOLT CIRCLE. MINIMUM LENGTH OF ANCHOR RODS IS 48", WITH A MAXIMUM PROJECTION OF 5" ABOVE CONCRETE. AMERON DRAWINGS TO SUPERCEDE THIS NOTE.


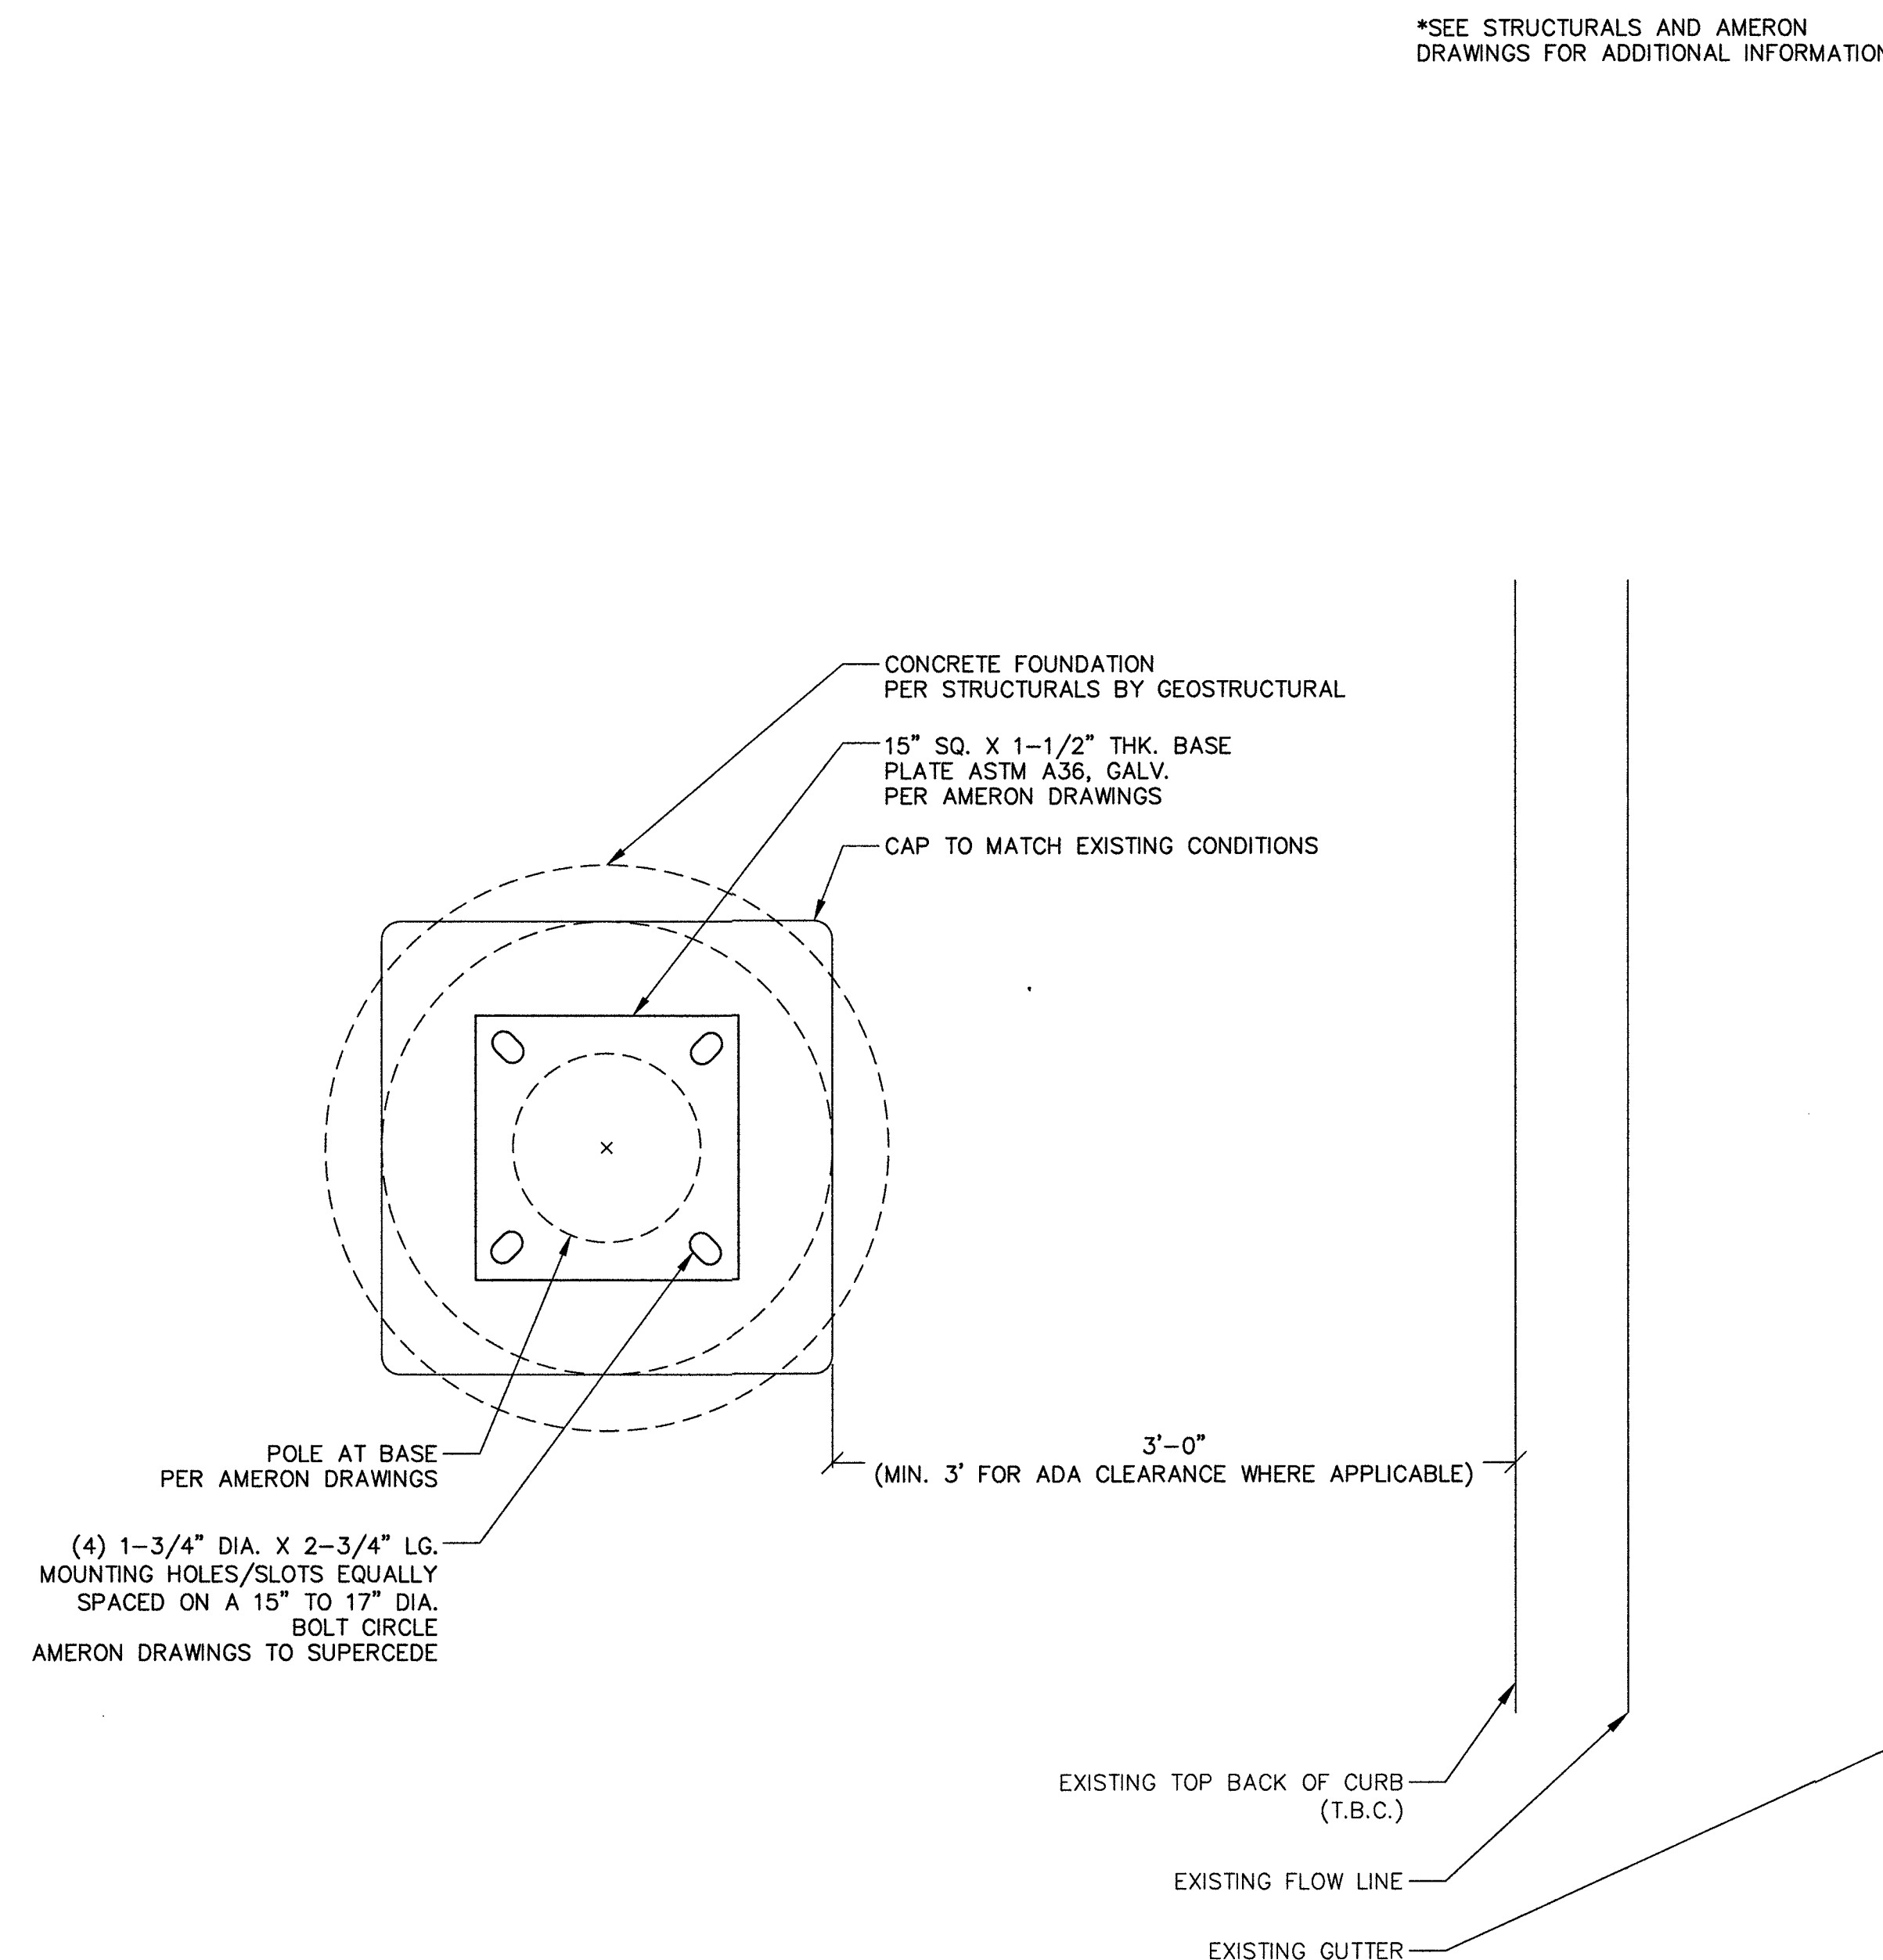


STREETLIGHT FOUNDATION DESIGN

SCALE: NONE 2

STREETLIGHT PLACEMENT ON CONCRETE FOUNDATION



SCALE: NONE 1

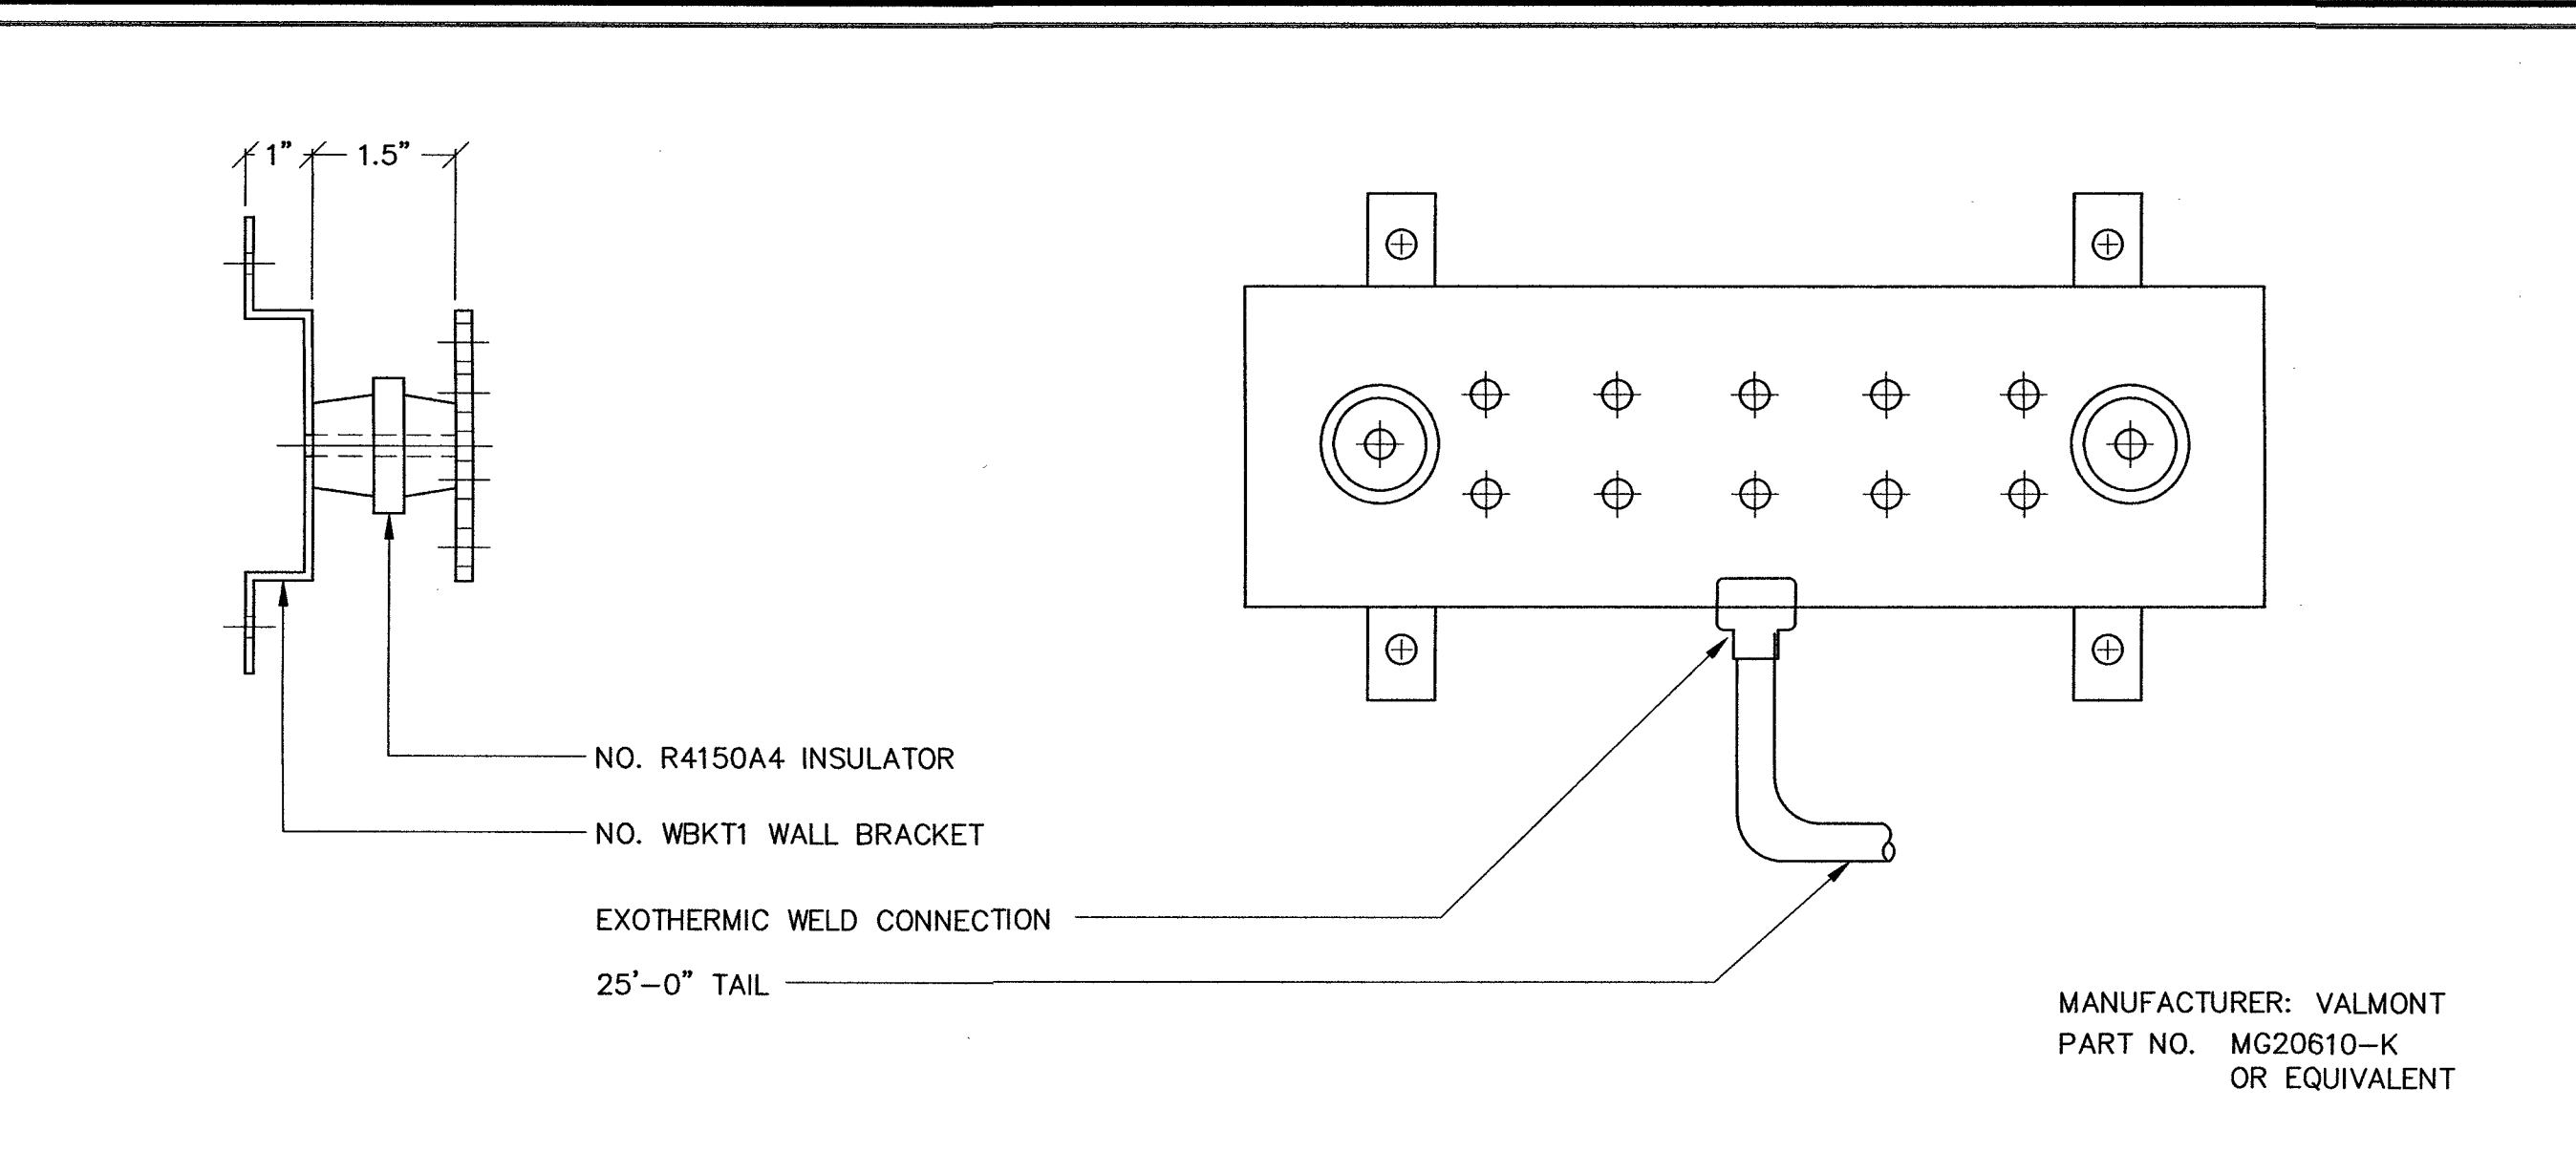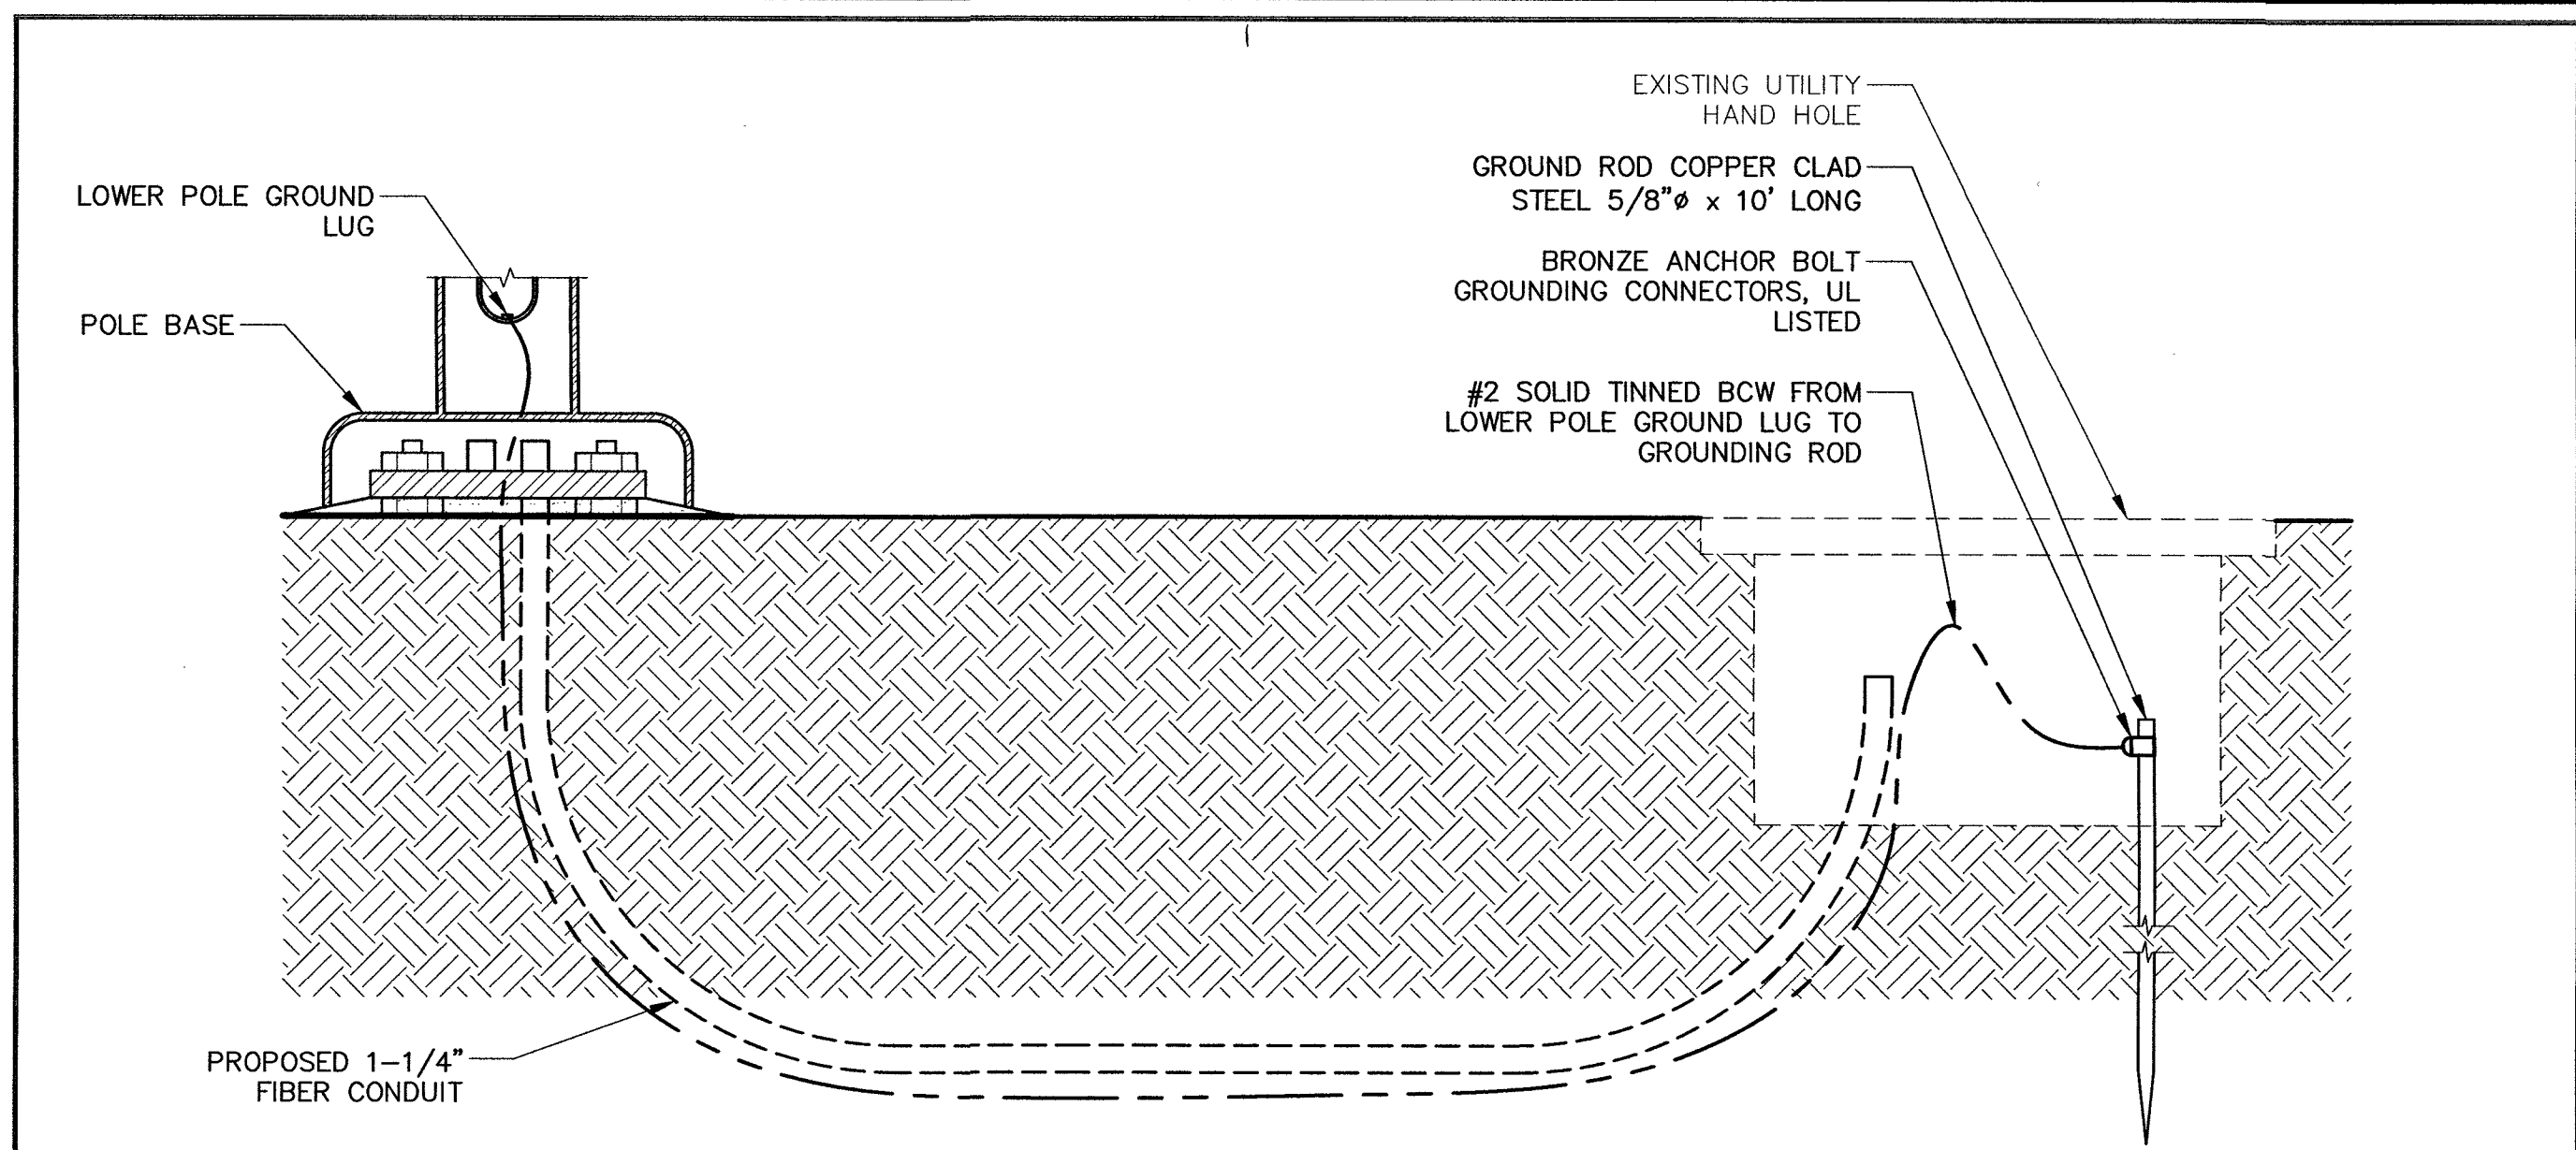

GROUND ROD

GROUND BAR

- ALL DETAILS ARE SHOWN IN GENERAL TERMS. ACTUAL GROUNDING REQUIREMENTS AND CONSTRUCTION ACCORDING TO SITE CONDITIONS AND CARRIER GROUNDING STANDARD, LATEST REVISION.
- ALL GROUNDING CONDUCTORS: #2 AWG SOLID BARE TINNED COPPER WIRE UNLESS OTHERWISE NOTED.
- GROUND RING TO GROUND BAR CONNECTIONS SHALL BE CADWELED QTY. (2) #2 AWG SOLID BARE TINNED COPPER WIRE UNLESS OTHERWISE NOTED.
- GROUND BAR TO EQUIPMENT AND CABLES SHALL BE #2 AWG BTCW W/ DOUBLE LUG CONNECTIONS.
- GROUND BAR LOCATED IN BASE OF EQUIPMENT WILL BE PROVIDED, FURNISHED AND INSTALLED BY THE VENDOR.
- GROUND BAR LOCATED BELOW WAVEGUIDE ENTRY PORT. CABLES SHALL BE #2 AWG BTCW/DOUBLE LUG CONNECTIONS. TWO PATHS TO GROUND RING.
- ALL BELOW GRADE CONNECTIONS: EXOTHERMIC WELD TYPE, ABOVE GRADE CONNECTIONS: EXOTHERMIC WELD TYPE.
- EXTERIOR GROUNDING CONDUCTORS: BURIED TO A MINIMUM DEPTH OF 1'-6" BELOW FINISHED GRADE TO ALLOW FOR FUTURE CONSTRUCTION.
- INSTALL GROUND CONDUCTORS AND GROUND ROD MINIMUM OF 1'-0" FROM EQUIPMENT CONCRETE SLAB, SPREAD FOOTING, OR FENCE.
- EXOTHERMIC WELD GROUND CONNECTION TO FENCE POST: TREAT WITH A COLD GALVANIZED SPRAY.
- GROUND BARS:
EQUIPMENT GROUND BUSS BAR (EGB) LOCATED AT BOTTOM OF ANTENNA POLE/MAST FOR MAKING GROUNDING JUMPER CONNECTIONS TO COAX FEEDER CABLES SHALL BE FURNISHED AND INSTALLED BY ELECTRICAL CONTRACTOR. JUMPERS (FURNISHED BY OWNERS) SHALL BE INSTALLED AND CONNECTED BY ELECTRICAL CONTRACTOR.
MAIN GROUND BUSS BAR (MGB) LOCATED NEAR THE BASE OF THE RADIO EQUIPMENT CABINET(S) SHALL BE FURNISHED AND INSTALLED BY ELECTRICAL CONTRACTOR.
- ALL GROUNDING INSTALLATIONS AND CONNECTIONS SHALL BE MADE BY ELECTRICAL CONTRACTOR.
- ALL BOLTED TORQUE CONNECTORS SHALL BE LONG-BARRELLED TYPES AND HAVE TWO HOLES FOR CONNECTION TO SURFACE AND NON-OXIDIZING AGENT APPLIED TO INHIBIT CORROSION.

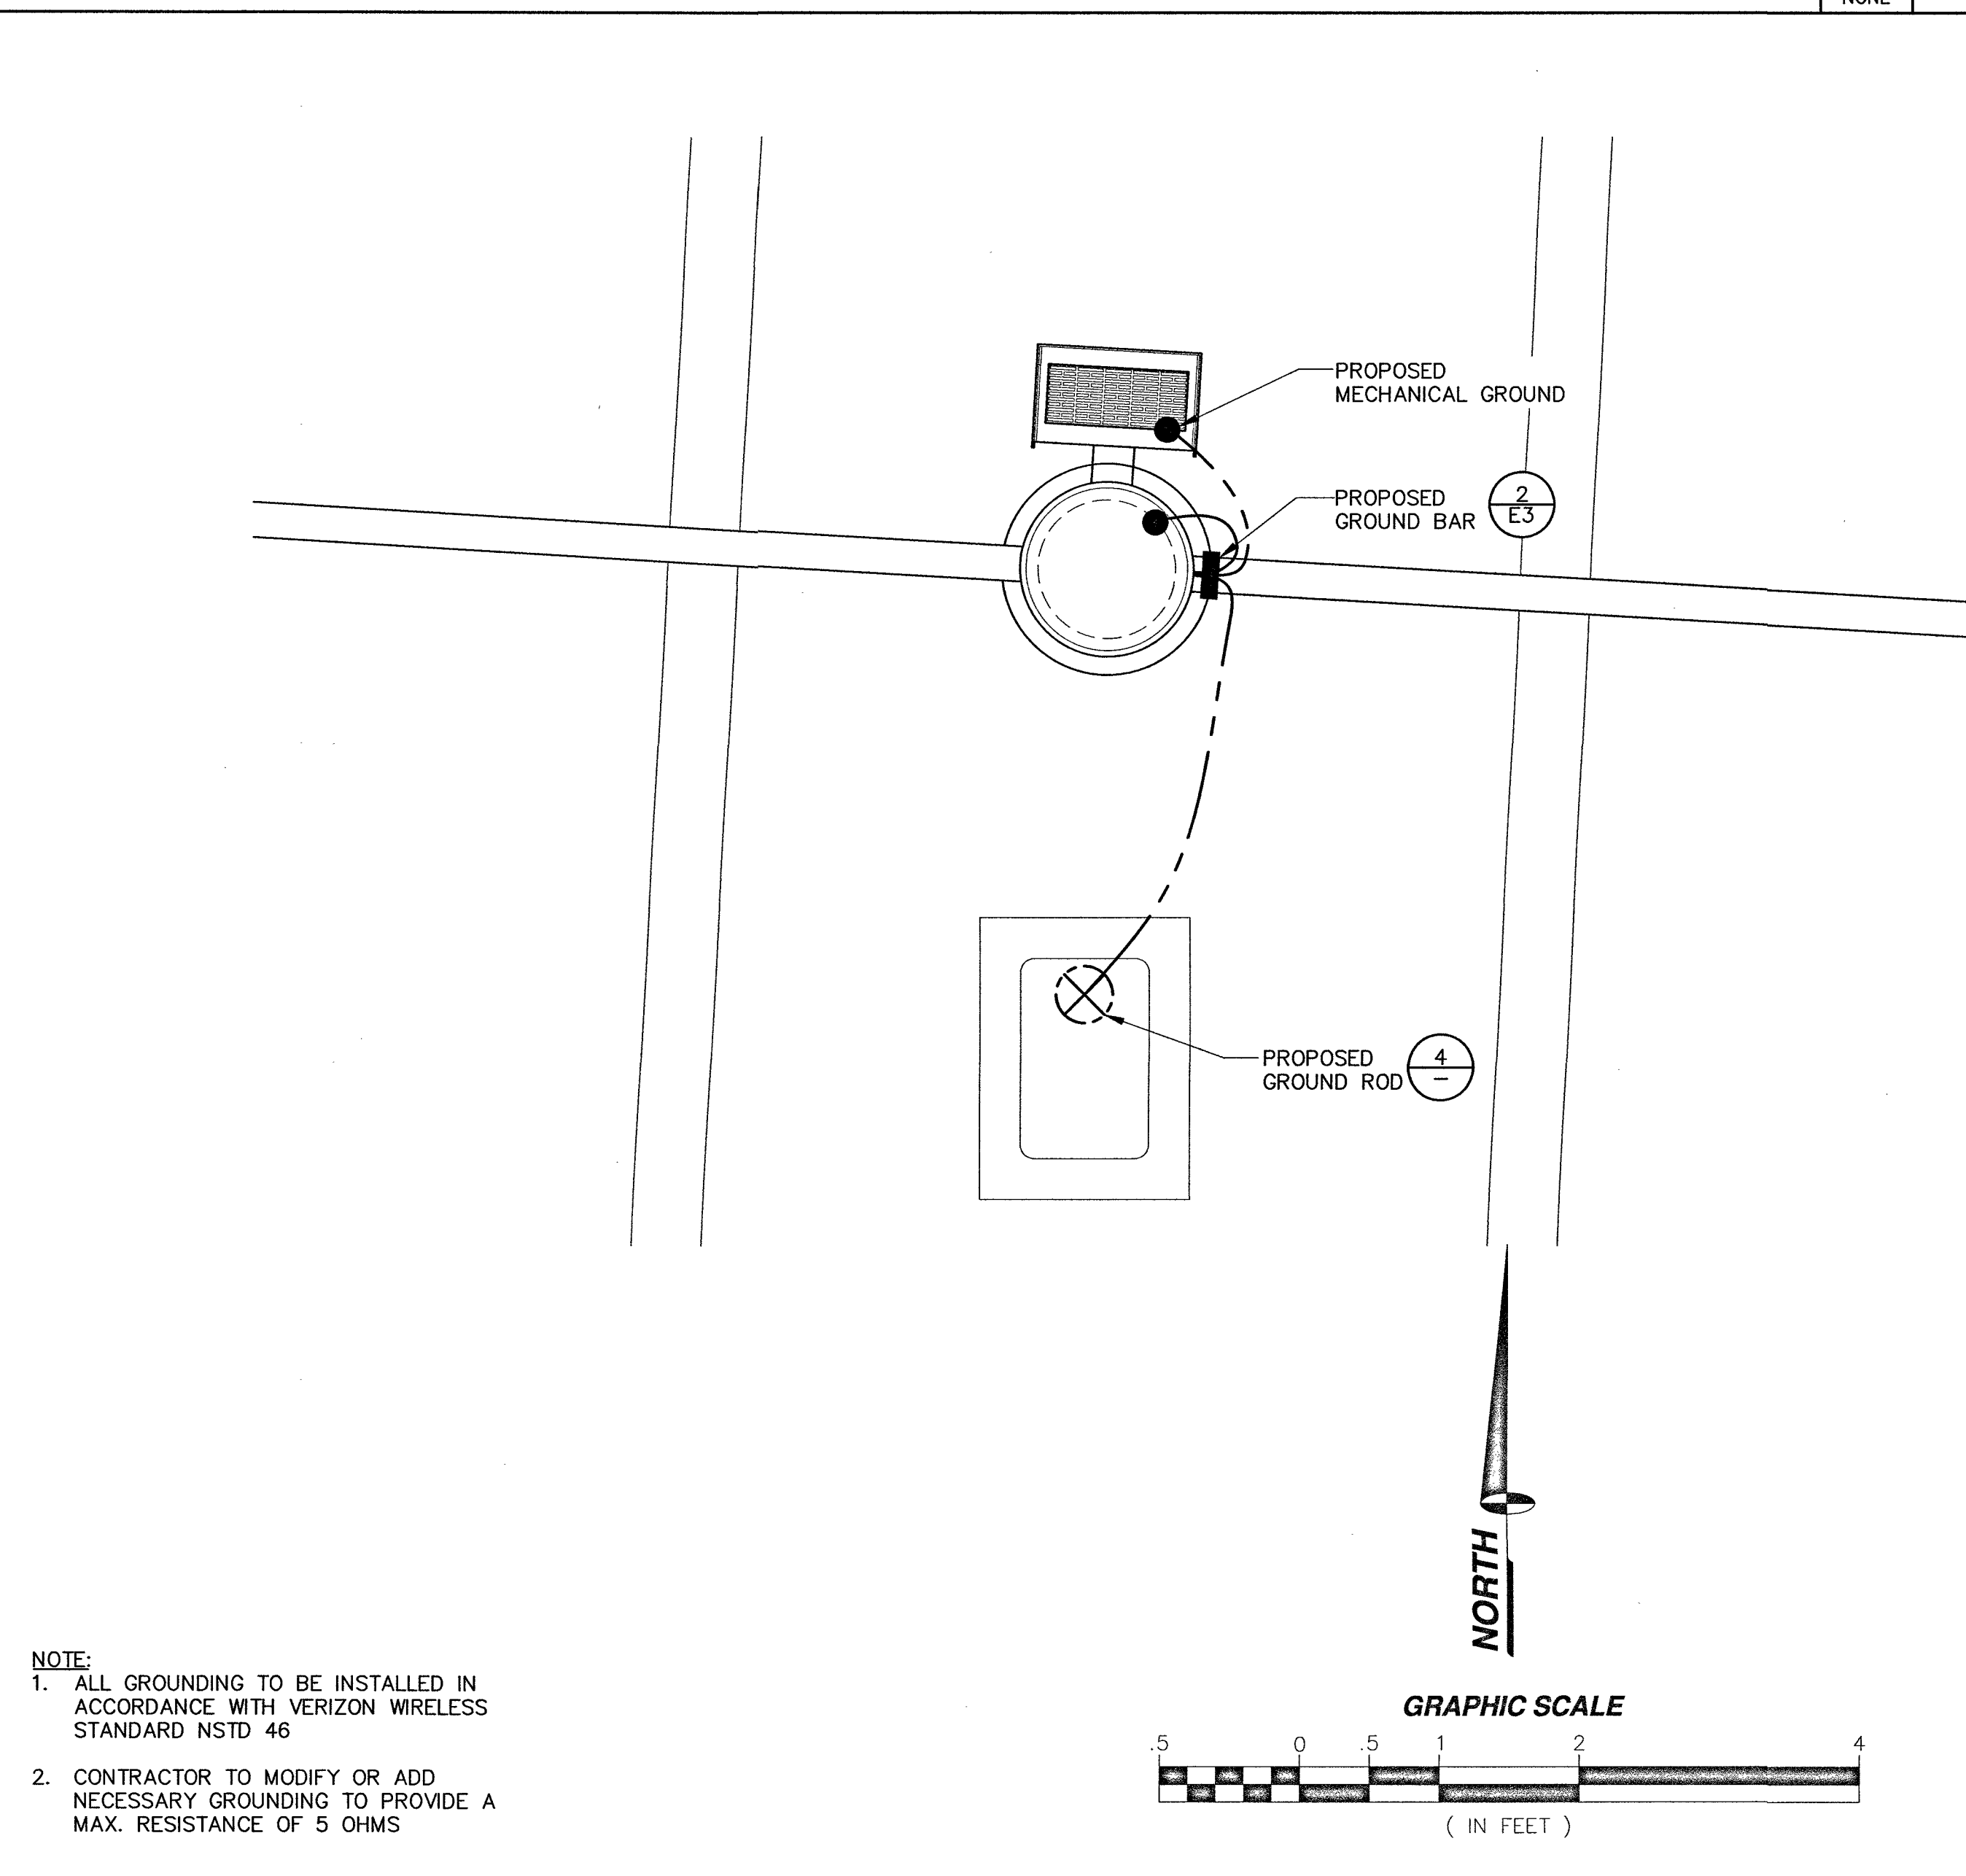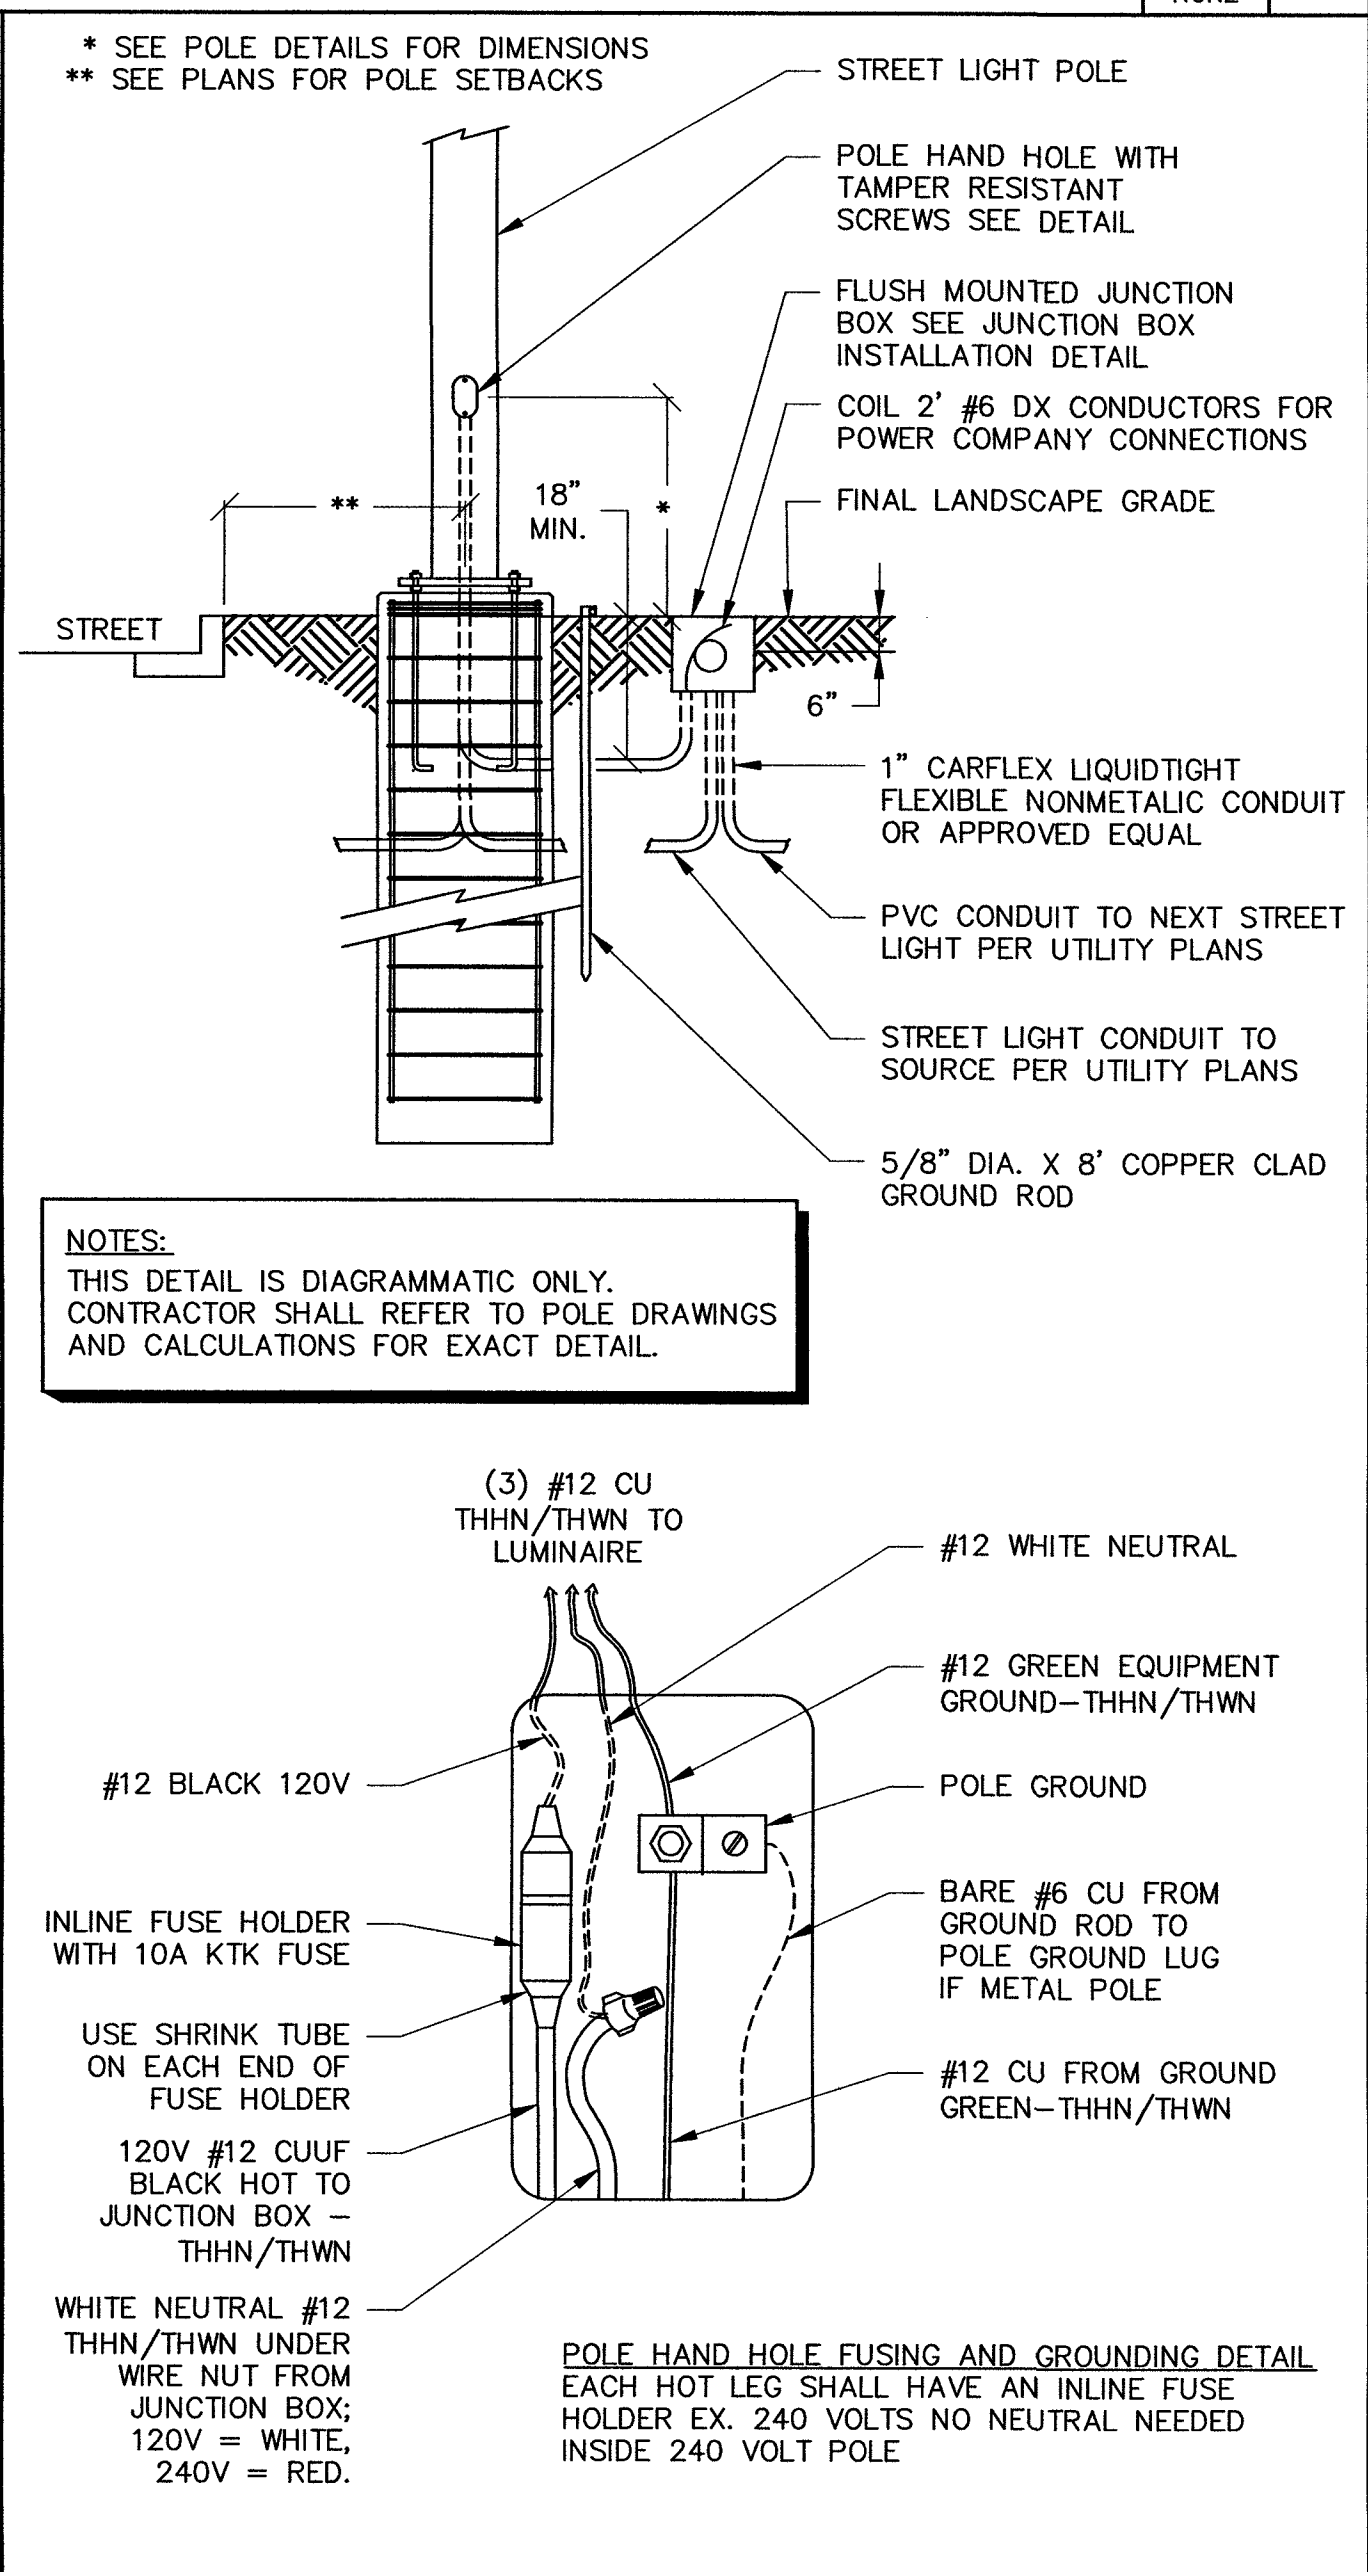

GROUNDING NOTES

STREET LIGHT WIRING AND GROUNDING

GROUNDING LAYOUT

CROWN CASTLE NG WEST LLC
2055 SOUTH STEARMAN DRIVE
CHANDLER, ARIZONA 85286

PROJECT INFORMATION:

CROWN CASTLE ID # LV020

LAURELGLEN DRIVE
LAS VEGAS, NEVADA 89144

CURRENT ISSUE DATE:

04/04/19

ISSUED FOR:

PROPOSED WORK

REV.: DATE: DESCRIPTION: BY:

2	02/05/19	POLE REVISION	D.C.
1	10/16/18	100% PERMITTING	C.P.
0	09/27/18	90% PERMITTING	D.C.

PLANS PREPARED BY:

DGS
CONSULTING ENGINEERING SERVICES LLC

LICENSURE:

SHEET TITLE:

GROUNDING LAYOUT, NOTES & DETAILS

SHEET NUMBER: REVISION:

E1 2