STORMWATER RUNOFF MANAGEMENT

(REQUIRED FOR ALL SITES GREATER THAN 1 ACRE (43,560 SQ.FT.))

1. THE OWNER, SITE DEVELOPER, CONTRACTOR AND/OR THEIR AUTHORIZED AGENTS SHALL EACH DAY REMOVE ALL SEDIMENT MUD, CONSTRUCTION DEBRIS, OR OTHER POTENTIAL POLLUTANTS THAT MAY HAVE BEEN DISCHARGED TO, OR ACCUMULATE IN, THE PUBLIC RIGHTS OF WAYS OF CLARK COUNTY AS A RESULT OF CONSTRUCTION ACTIVITIES ASSOCIATED WITH THIS SITE DEVELOPMENT OR CONSTRUCTION PROJECT. SUCH MATERIALS SHALL BE PREVENTED FROM ENTERING THE STORM SEWER SYSTEM.
2. ADDITIONAL CONSTRUCTION SITE DISCHARGE BEST MANAGEMENT PRACTICES MAY BE REQUIRED OF THE OWNER AND HIS OR HER AGENTS DUE TO UNFORESEEN EROSION PROBLEMS OR IF THE SUBMITTED PLAN DOES NOT MEET THE PERFORMANCE STANDARDS SPECIFIED IN TITLE 24.40 AND THE LAS VEGAS VALLEY CONSTRUCTION SITE BEST MANAGEMENT PRACTICES MANUAL.
3. TEMPORARY OR PERMANENT STABILIZATION PRACTICES WILL BE INSTALLED ON DISTURBED AREAS AS SOON AS PRACTICABLE AND NO LATER THAN 14 DAYS AFTER THE CONSTRUCTION ACTIVITY IN THAT PORTION OF THE SITE HAS TEMPORARILY OR PERMANENTLY CEASED. SOME EXCEPTIONS MAY APPLY; REFER TO NEVADA STORMWATER GENERAL PERMIT FOR CONSTRUCTION ACTIVITY NVR100000, SECTION III.A.5.
4. AT A MINIMUM, THE CONTRACTOR OR HIS ACCENT SHALL INSPECT ALL DISTURBED AREAS, AREAS USED FOR STORAGE OF MATERIALS AND EQUIPMENT THAT ARE EXPOSED TO PRECIPITATION, VEHICLE ENTRANCE AND EXIT LOCATIONS AND ALL BMPS WEEKLY, AND WITHIN 24 HOURS AFTER ANY ACTUAL RAIN EVENT OF 0.5 INCHES OR MORE. THE CONTRACTOR OR HIS AGENT SHALL UPDATE OR MODIFY THE STORMWATER POLLUTION PREVENTION PLAN AS NECESSARY. SOME EXCEPTIONS TO WEEKLY INSPECTIONS MAY APPLY, SUCH AS SUSPENSION OF LAND DISTURBANCE ACTIVITIES. REFER TO NEVADA STORMWATER GENERAL PERMIT FOR CONSTRUCTION ACTIVITY NVR100000, SECTION III.A.12.
5. ACCUMULATED SEDIMENT IN BMPS SHALL BE REMOVED WITHIN SEVEN DAYS AFTER A STORMWATER RUNOFF EVENT OR PRIOR TO THE NEXT ANTICIPATED STORM EVENT, WHICHEVER IS EARLIER. SEDIMENT MUST BE REMOVED WHEN BMP DESIGN CAPACITY HAS BEEN REDUCED BY 50 PERCENT OR MORE.

BASIS OF BEARINGS

NORTH 05°59'55" WEST, BEING THE BEARING OF THE WEST LINE OF SECTION 34, TOWNSHIP 20 SOUTH, RANGE 59 EAST, M.D.M., CITY OF LAS VEGAS, CLARK COUNTY, NEVADA, AS SHOWN BY MAP THEREOF ON FILE IN THE CLARK COUNTY, NEVADA RECORDER'S OFFICE IN BOOK 135, PAGE 71 OF PLATS.

BENCHMARK

CITY OF LAS VEGAS BENCHMARK 7LV09 34SW6

RIVET AND ROUND PLATE IN THE TOP OF CURB AT THE SOUTHEAST CORNER OF DESERT MOON RD. AND SKY VISTA DR.

ELEVATION = 1011.422 METERS (NAVD '88)
ELEVATION = 3318.31 US SURVEY FEET (NAVD '88)

LEGAL DESCRIPTION

A PORTION OF THE NORTHEAST QUARTER (NE ¼) OF SECTION 33, TOWNSHIP 20 SOUTH, RANGE 59 EAST, M.D.M., CITY OF LAS VEGAS, LCARK COUNTY, NEVADA DESCRIBED AS FOLLOWS:

LOTS L AND M OF "SUMMERLIN VILLAGE 24 – UNIT 4", AS SHOWN BY MAP THEREOF ON FILE IN BOOK 154 OF PLATS PAGE 83 IN THE OFFICE OF THE COUNTY RECORDER OF CLARK COUNTY, NEVADA

CONTAINING 37.56 ACRES

SOUTHERN NEVADA - SOUTHWEST GAS CORPORATION GENERAL NOTES

1. IN THE EVENT OF NATURAL GAS EMERGENCIES CALL 911 AND 1-877-860-6020
2. THERE SHALL BE A MINIMUM HORIZONTAL AND VERTICAL CLEARANCE OF 12-INCHES BETWEEN NATURAL GAS FACILITIES AND ANY UNDERGROUND FACILITIES AND/OR STRUCTURES, INCLUDING BUT NOT LIMITED TO WATER, SEWER, STORM DRAIN, COMMUNICATIONS, AND ELECTRIC
3. FOR VALVE ADJUSTMENT CONTACT 702-668-6107 48 HOURS PRIOR TO CONSTRUCTION.
4. IN THE EVENT OF NATURAL GAS CONFLICT WITH PROPOSED UTILITIES AND/OR STRUCTURES CONTACT 702-365-2099

CAUTION: HIGH PRESSURE GAS

CALL SOUTHWEST GAS AT 702-400-1789 FOR STANDBY WHEN EXCAVATING OVER OR NEAR HIGH PRESSURE GAS LINES 48 HOURS PRIOR TO CONSTRUCTION

SOUTHWEST GAS APPROVAL

SOUTHWEST GAS CORPORATION — DATE 5/9/19

2.2 CITY OF LAS VEGAS SEWER NOTES

1. ALL CONSTRUCTION AND MATERIALS SHALL BE IN ACCORDANCE WITH THE LATEST EDITION OF THE DESIGN AND CONSTRUCTION STANDARDS FOR WASTEWATER COLLECTION SYSTEMS AND THE UNIFORM STANDARD SPECIFICATIONS FOR PUBLIC WORKS' CONSTRUCTION OFF-SITE IMPROVEMENTS, CLARK COUNTY AREA, NEVADA, AS AMENDED. IT WILL BE THE RESPONSIBILITY OF THE CONTRACTOR TO BE AWARE OF THE CONTENTS OF THE ABOVE SPECIFICATIONS.
2. IT SHALL BE THE CONTRACTOR'S RESPONSIBILITY TO PERFORM CONSTRUCTION AS PER PLANS, ANY ADDITIONS, DELETIONS, OR CHANGES SHALL FIRST MEET WITH THE APPROVAL OF THE CITY ENGINEER.
3. CHISEL "S" OR "G" IN CURBS WHERE SEWER OR GAS LATERALS PASS UNDER THE CURB.
4. POLYVINYL (PVC) SEWER PIPE SHALL MEET ASTM D-3034 SDR 35 SPECIFICATIONS, INSTALLED WITH SAND BEDDING AND BACKFILL OF TYPE II AGGREGATE BASE.
5. ALL MANHOLES PAVED IN STREETS EIGHTY (80') FOOT R/W AND LARGER SHALL HAVE CONCRETE COLLARS. STREETS LESS THAN EIGHTY (80') FOOT R/W WILL REQUIRE RETROFIT IF PAVING DOES NOT CONFORM TO CITY STANDARDS AT THE MANHOLE.
6. TEE SADDLES SHALL BE USED TO CONNECT SEWER LATERALS TO EXISTING MAIN LINES UP TO TWELVE INCH (12") DIAMETER. CONNECTIONS TO FIFTEEN INCH (15") OR LARGER MAINS SHALL REQUIRE SPECIAL PROCEDURES. IN LINE "Y" 'S SHALL BE USED ON LINES TWELVE INCHES (12") OR ABOVE.
7. WATER MAINS SHALL BE PROTECTED IN ACCORDANCE WITH LVVWD STANDARDS WHENEVER A SEWER MAIN CROSSES OVER A WATER MAIN OR THE SEWER IS LESS THAN EIGHTEEN INCH (18") UNDER A WATER MAIN.
8. ALL CONTRACTORS INSTALLING SEWER MAINS THAT WILL BE UNDER THE JURISDICTION OF THE CITY OF LAS VEGAS MUST BE STATE OF NEVADA CLASS "A" CONTRACTORS.
9. THE CITY OF LAS VEGAS WILL NOT ACCEPT ANY SEWER MAINS WHICH HAVE A VERTICAL DEFLECTION OF MORE THAN ONE TENTH (0.1) OF A FOOT FROM THE APPROVED CONSTRUCTION PLANS AT ANY LOCATION. SEWER MAINS FOUND TO EXCEED THIS TOLERANCE WILL HAVE TO BE REPAIRED OR REMOVED OR REPLACED TO THE SATISFACTION OF THE CITY ENGINEER PRIOR TO ACCEPTANCE BY THE CITY OF LAS VEGAS.
10. INSTALLATION OF CURVED SEWER REQUIRES THE USE OF C-900 PIPE WHICH ALLOWS FOR PIPE DEFLECTION AT THE JOINTS.

LAS VEGAS VALLEY WATER DISTRICT (LVVWD) STANDARD NOTES

LVVWD PROJECT # 136382 (REVISED 08/01/2017)

1. NO WORK SHALL BEGIN UNTIL THE WATER PLANS HAVE BEEN APPROVED FOR CONSTRUCTION BY THE LVVWD. FOLLOWING WATER PLAN APPROVAL, NOTICE SHALL BE GIVEN TO THE LVVWD COMMUNICATION SUPPORT CENTER (258-7171) TWO (2) WORKING DAYS PRIOR TO THE START OF CONSTRUCTION. FOR FUTURE INSPECTIONS, NOTICE MUST BE GIVEN BY 2:00 P.M. THE BUSINESS DAY PRIOR TO THE REQUESTED LVVWD INSPECTION. WHEN REQUESTING INSPECTIONS, PLEASE REFER TO THE PROJECT # IDENTIFIED ABOVE.
2. ALL WORK SHALL CONFORM TO LVVWD STANDARD PLATES, DRAWINGS, AND SPECIFICATIONS, AND TO THE 2010 EDITION OF THE UNIFORM DESIGN AND CONSTRUCTION STANDARDS FOR POTABLE WATER SYSTEMS (UDACS). THE LATEST EDITION OF UDACS SHALL SUPERSEDE ANY CONFLICTS CONTAINED IN THE APPROVED DRAWINGS AND/OR SPECIFICATIONS.
3. ALL WORK, EXCEPT AS MODIFIED BY THESE PLANS OR BY NOTE 2 ABOVE, SHALL BE DONE IN ACCORDANCE WITH THE MOST RECENT DRAFT OR EDITION OF THE UNIFORM STANDARD SPECIFICATIONS FOR PUBLIC WORKS CONSTRUCTION OFFSITE IMPROVEMENT, CLARK COUNTY AREA.
4. A SINGLE PIPE MATERIAL SHALL BE USED THROUGHOUT THE PROJECT UNLESS OTHERWISE APPROVED BY THE LVVWD.
5. ALL SERVICE LATERALS TWO (2) INCHES IN DIAMETER AND SMALLER SHALL BE TYPE K COPPER TUBING WITH LVVWD APPROVED SERVICE SADDLES.
6. ALL WATER METER BOXES SHALL BE LOCATED OUTSIDE OF DRIVEWAY AREAS.
7. ALL VALVES SHALL BE LOCATED OUTSIDE OF DRIVEWAYS, VALLEY AND CURB GUTTERS.
8. ALL WATER AND STORM DRAIN OR SANITARY SEWER CROSSINGS SHALL CONFORM TO SECTION 2.22 OF THE 2010 EDITION OF THE UDACS.
9. ALL WATER FACILITIES AND APPURTENANCES SHALL BE DISINFECTED, PRESSURE TESTED, AND HAVE AN ACCEPTABLE PASSING HEALTH WATER SAMPLE OBTAINED, PRIOR TO OPERATION AND USE.
10. THE CONTRACTOR MUST OBTAIN ALL METERS TWO (2) INCHES AND SMALLER FROM LVVWD CENTRAL STORES. TELEPHONE 258-3152 OR 258-3802, TWO (2) WORKING DAYS PRIOR TO METER PICKUP.
11. ANY INTERRUPTION OF SERVICE MUST BE PERFORMED IN ACCORDANCE WITH UDACS SECTION 3.14.01, AND APPROVED BY THE LVVWD INSPECTION DIVISION PRIOR TO SHUTDOWN. PROPER WRITTEN NOTIFICATION MUST BE GIVEN TO ALL AFFECTED CUSTOMERS.
12. ALL WATER FACILITY CONSTRUCTION MATERIALS USED MUST BE AS LISTED ON THE LVVWD APPROVED PRODUCT'S LIST FOR NEW FACILITIES, LATEST REVISION, OR SPECIFICALLY APPROVED ON THESE PLANS BY SUBMITTING SHOP DRAWINGS.
13. TELEPHONE "CALL BEFORE YOU DIG" AT "811" OR 1-800-227-2600.
14. THE INSTALLATION OF LVVWD MUNICIPAL WATER FACILITIES WITHIN ALL STREETS IS ASSUMED TO BE IN COMPLIANCE WITH THE UNIFORM STANDARDS, INCLUDING THE PLACEMENT OF ASPHALT PAVING STREET SURFACES. ANY REPAIR WORK DONE BY THE LVVWD TO THE MUNICIPAL WATER FACILITIES WILL INCLUDE THE PLACEMENT OF AN APPROPRIATELY SIZED ASPHALT REPAIR PATCH ON THE STREET SURFACE.

    ANY DECORATIVE PAVING SURFACE WITHIN THE STREET IS THE RESPONSIBILITY OF THE OWNER'S ASSOCIATION, OR THE INDIVIDUAL PROPERTY OWNERS IF NO OWNER'S ASSOCIATION IS IN EXISTENCE, OR THE AGENCY HAVING JURISDICTION. DECORATIVE SURFACE MATERIALS PLACED WITHIN THE TEN FOOT EASEMENT ABUTTING A PUBLIC OR PRIVATE STREET, IF DISTURBED BY THE LVVWD DURING THE REPAIR OR OPERATION OF ITS FACILITIES, WILL BE REPLACED BY LVVWD WITH AN APPROPRIATELY SIZED PLAIN FINISH CONCRETE PATCH. THE LVVWD WILL NOT RESTORE, AND WILL NOT BE RESPONSIBLE FOR THE RESTORATION OF, ANY DECORATIVE PAVING SURFACE WITHIN THE STREET. THE LVVWD WILL NOT ATTEMPT TO MATCH COLOR OR FINISH OF ANY ADJACENT MATERIALS.

IS NO LEAD COMPLIANCE NOTE
TO COMPLY WITH THE FEDERAL SAFE DRINKING WATER ACT, ALL WATER WORKS BRASS PRODUCTS PROPOSED TO BE RELOCATED, OR INSTALLED AS NEW MUST BE INSTALLED WITH THE LEAD FREE APPROVED PRODUCT. THE OLD LEADED PRODUCT MAY NOT BE REUSED.

GRADING NOTES

1. INDICATED GRADES OTHER THAN T.C., F.G. & GUTTER F.L. ARE ROUGH GRADES.
2. THE ROUGH GRADING PLANS SHALL BE ON THE JOB SITE AT ALL TIMES. THE ROUGH GRADING SHALL BE FINISHED IN CONFORMANCE WITH THE LINES AND GRADES SHOWN ON THE PLANS. THE GRADING QUANTITIES ARE BASED ON THE ELEVATION AND DETAILS SHOWN ON THE PLANS. ANY DEVIATIONS FROM THE PLANS WILL RESULT IN QUANTITY CHANGES.
3. CARE SHALL BE EXERCISED IN GRADING CORNER LOTS.
4. ROUGH PAD ELEVATIONS SHALL BE GRADED TO WITHIN 0.1' OF THE PAD ELEVATIONS SHOWN ON THE PLANS. WHEN GRADING IS COMPLETE PER THE PLANS, THE CONTRACTOR SHALL NOTIFY THE ENGINEER SO THAT THE LOTS CAN BE INSPECTED. AT THAT TIME THE ENGINEER SHALL ALSO DECIDE IF ANY ADDITIONAL DITCHES OR BERMS ARE REQUIRED. THE CONTRACTOR IS REQUESTED NOT TO REMOVE ANY OF HIS ROUGH GRADING EQUIPMENT UNTIL HE RECEIVES GRADING APPROVAL FROM THE ENGINEER.
5. SOILS REPORT PREPARED BY SOUTHWEST GEOTECHNICAL, PROJECT NO. 182267, DATED 7/12/18.
6. EARTHWORK QUANTITIES (RAW):
   -CUT = 23,900 CUBIC YARDS
   -FILL = 51,700 CUBIC YARDS

   A) THE ABOVE QUANTITIES DO NOT REFLECT LOSSES DUE TO SUBSIDENCE OR SHRINKAGE.
   B) THE ABOVE QUANTITIES DO REFLECT USING NATIVE MATERIAL IN LIEU OF TYPE I GRAVEL BASE MATERIAL FOR STREET SECTIONS.
   C) THE ABOVE QUANTITIES DO NOT REFLECT ANY EARTHWORK WHICH MAY BE REQUIRED BY THE ENGINEER TO CONSTRUCT ADDITIONAL PROTECTIVE DITCHES OR BERMS NOT SHOWN ON THESE DRAWINGS.

CITY OF LAS VEGAS FIRE AND RESCUE GENERAL NOTES

1. ALL WORK SHALL BE DONE IN STRICT ACCORDANCE WITH THE LAS VEGAS FIRE AND RESCUE ADOPTED FIRE CODE ORDINANCE # 6331, FOR HYDRANT SPECIFICATIONS, AND HYDRANT INSTALLATION SPECIFICATIONS.
2. ONLY FIRE HYDRANTS THAT ARE ON THE LAS VEGAS VALLEY WATER DISTRICT'S – APPROVED PRODUCTS LIST ARE ALLOWED TO BE INSTALLED.
3. A PERMIT IS REQUIRED FROM LAS VEGAS FIRE AND RESCUE FOR THE INSTALLATION OF ON-SITE WATER LINES AND FIRE HYDRANTS. THE PERMIT AND CONTRACTORS MATERIAL TEST CERTIFICATE FOR UNDERGROUND PIPING FORM SHALL BE OBTAINED FROM THE FIRE PROTECTION ENGINEER BEFORE COMMENCEMENT OF WORK [IFC 105.7.12]
4. ON ANT RESIDENTIAL OR COMMERCIAL INSTALLATIONS, FIRE HYDRANTS SHALL BE INSTALLED AND FIRE APPARATUS ACCESS ROADS SHALL BE MAINTAINED BEFORE COMMENCEMENT OF ANY COMBUSTIBLE CONSTRUCTION. ALL FIRE HYDRANTS SHALL BE IN GOOD WORKING ORDER AND SHALL BE CAPABLE OF DELIVERING THE REQUIRED FIRE FLOW. [IFC 3310, 3312]
5. TO IDENTIFY THE FIRE HYDRANT LOCATIONS, THE CONTRACTOR SHALL PLACE A BLUE REFLECTIVE MARKER AT THE CENTER LINE OF THE STREET ADJACENT TO THE FIRE HYDRANTS. [IFC 507.5.7.3]
6. ALL UNDERGROUND INSPECTIONS, PRESSURE AND FLUSH VERIFICATIONS OF ALL FIRE HYDRANTS AND FIRE LINES, SHALL BE CONDUCTED BEFORE COVERING THE LINES. CENTER LOADING IS ACCEPTABLE FOR THE HYDRO TESTS WITH PRIOR FIRE PREVENTION APPROVAL. [IFC 106.3]
7. ALL ON-SITE UNDERGROUND WATER MAINS AND MATERIALS SHALL BE U.L. LISTED, A.W.W.A APPROVED AND SHALL BE RATED FOR THE APPROPRIATE WORKING PRESSURE. [IFC 507.2.1, NFPA 24]
8. PAINTING OF CURBS, FIRE HYDRANTS, PADS, PROTECTION OF FIRE HYDRANTS FROM PHYSICAL DAMAGE, AND ALL OTHER WORK NECESSARY PER PLANS SHALL BE COMPLETED BEFORE APPROVAL BY LAS VEGAS FIRE AND RESCUE, FIRE PREVENTION DIVISION. [IFC 507]
9. PRIVATE HYDRANTS SHALL BE PAINTED RED. [IFC 507.5.7.1]
10. PRIOR TO THE FINAL OCCUPANCY, A FIRE FLOW TEST SHALL BE WITNESSED BY LAS VEGAS FIRE AND RESCUE, FIRE PREVENTION DIVISION TO VERIFY AVAILABILITY OF THE REQUIRED FIRE FLOW. [IFC 507]
11. FIRE HYDRANT SPACING SHALL BE AS FOLLOWS: [IFC C102]
    - RESIDENTIAL– 500 FT UNSPRINKLERED; 600 FT SPRINKLERED.
    - COMMERCIAL– 300 FT UNSPRINKLERED; 400 FT SPRINKLERED.
12. WHERE NEW WATER MAINS ARE EXTENDED ALONG STREETS OR NEW STREETS ARE INSTALLED WHERE FIRE HYDRANTS ARE NOT NEEDED FOR PROTECTION OF THE STRUCTURES, FIRE HYDRANTS SHALL BE INSTALLED AT A MAXIMUM OF 1,000 FT SPACING, TO PROVIDE FOR TRANSPORTATION HAZARDS. WHERE STREETS ARE PROVIDED WITH MEDIAN DIVIDERS OR HAVE FOUR (4) OR MORE TRAFFIC LANES AND HAVE A TRAFFIC COUNT OF MORE THAN 30,000 PER DAY, HYDRANTS ARE REQUIRED ON EACH SIDE OF THE STREET SPACED AT 500 FT ON AN ALTERNATING BASIS. [IFC C102.8]
13. NO FIRE HYDRANTS SHALL BE LOCATED WITHIN THE RADIUS OF A CUL-DE-SAC OR WITHIN 20 FEET OF THE PERIMETER OF THE RADIUS OF THE CUL-DE-SAC.
14. NO FIRE HYDRANTS SHALL BE LOCATED WITHIN 6 FT OF ANY CURB RETURN, DRIVEWAY, POWER POLE, STREETLIGHT OR ANY OTHER OBSTRUCTION. [IFC C102.12]
15. A MAXIMUM DISTANCE FROM A FIRE HYDRANT TO A ONE-TWO FAMILY DWELLING SHALL NOT EXCEED 300 FT, AS MEASURED BY AN APPROVED ROUTE. [IFC C102.4]
16. THE MAXIMUM DISTANCE FROM A FIRE HYDRANT TO A FIRE DEPARTMENT CONNECTION (FDC) SHALL NOT EXCEED 100 FT, AS MEASURED BY AN APPROVED ROUTE. [IFC C102.7]
17. THE MAXIMUM DISTANCE FROM A HYDRANT TO THE END OF A DEAD-END STREET SHALL NOT EXCEED 200 FT. [IFC C102.6]
18. TWO (2) SOURCES OF SUPPLY ARE REQUIRED WHENEVER THERE ARE 4 OR MORE FIRE HYDRANTS/SPRINKLER LEAD-INS ARE INSTALLED ON A SINGLE SYSTEM. SECTIONAL CONTROL VALVES SHALL BE INSTALLED SO THAT NO MORE THAN 2 FIRE HYDRANTS CAN BE OUT OF SERVICE DUE TO A BREAK IN A WATER MAIN. [IFC C104]
19. ALL FIRE APPARATUS ACCESS ROADS SHALL BE PAVED TO PROVIDE ALL-WEATHER DRIVING CAPABILITIES, AND SHALL BE DESIGNED AND MAINTAINED TO SUPPORT THE IMPOSED LOADS OF THE FIRE APPARATUS. [IFC 503.2.3]
20. THE GRADIENT FOR THE FIRE APPARATUS ACCESS ROADS SHALL NOT EXCEED 12% ANGLES OF APPROACH AND ANGLES OF DEPARTURE SHALL NOT EXCEED 6% FOR 25 FEET PRIOR TO OR AFTER THE GRADE CHANGE. ADJACENT TO THE STRUCTURES GRADIENT SHALL NOT EXCEED 6%. [IFC 503.2.7, 503.2.8]
21. THE TURNING RADIUS OF THE FIRE APPARATUS ACCESS ROADS SHALL BE NO LESS THAN 52 FEET OUTSIDE AND 28 FEET INSIDE TURNING RADIUS. [IFC 503.2.4]
22. VERTICAL CLEARANCE OF ALL FIRE APPARATUS ACCESS ROADS SHALL NOT BE LESS THAN 13 FT 6 INS. [IFC 503.2.1]
23. FIRE DEPARTMENT ACCESS ROADS SHALL HAVE A MINIMUM UNOBSTRUCTED WIDTH OF NOT LESS THAN 40 FT. FLOW LINE TO FLOW LINE WITH PARALLEL PARKING PERMITTED ON BOTH SIDES. NOT LESS THAN 32 FT WIDE, FLOW LINE TO FLOW LINE, WHERE PARKING IS PERMITTED ONLY ON ONE SIDE OF THE FIRE APPARATUS ACCESS ROAD. NOT LESS THAN 24 FT WIDE, FLOW LINE TO FLOW LINE, WHERE PARKING IS PERMITTED ON EITHER SIDE. FIRE LANES THROUGH PARKING LOTS SHALL BE NOT LESS THAN 24 FT. [IFC 503.2.1.1]
24. A FIRE APPARATUS ACCESS ROAD SHALL BE REQUIRED WHEN ANY PORTION OF AN EXTERIOR WALL OF THE FIRST STORY IS LOCATED MORE THAN 150 FT FROM A FIRE DEPARTMENT VEHICLE ACCESS. THE DISTANCE SHALL BE INCREASED TO 250 FT IF THE BUILDING IS SPRINKLERED. [IFC 503.1.1]
25. APPROVED SECONDARY FIRE APPARATUS ACCESS SHALL BE PROVIDED FOR 100 OR MORE DWELLING UNITS, ROAD(S) WITH DEAD-ENDS OR WITH A SINGLE POINT OF ACCESS IN EXCESS OF 600 FT, COMMERCIAL AND INDUSTRIAL DEVELOPMENTS WHERE BUILDINGS EXCEED 2 STORIES OR 30 FEET IN HEIGHT, OR EXCEEDING 62,000 SQUARE FEET IN AREA. [IFC 503.1.2]
26. ALL DEAD-END FIRE APPARATUS ROADS AND/OR FIRE LANES, PUBLIC OR PRIVATE, IN EXCESS OF 150 FT IN LENGTH SHALL BE PROVIDED WITH AN APPROVED TURN AROUND HAVING A MINIMUM DIAMETER OF 81 FT. [IFC 503.2.5]
27. ALL FIRE APPARATUS ACCESS ROADS SHALL BE MARKED BY PLACING APPROVED SIGNS AT THE START OF THE DESIGNATED FIRE LANE, ONE SIGN AT THE END OF THE FIRE LANE AND WITH SIGNS AT INTERVALS OF 100 FEET ALONG THE DESIGNATED FIRE LANES. SIGNS TO BE PLACED ON BOTH SIDES OF AN ACCESS ROADWAY IF NEEDED TO PREVENT PARKING ON EITHER SIDE. SIGNS TO BE INSTALLED NO HIGHER THAN 10 FT OR LESS THAN 6 FT FROM THE ROADWAY LEVEL. THE CURB ALONG OR ON THE PAVEMENT OR CEMENT (IF NO CURB IS PROVIDED) SHALL BE PAINTED WITH A RED WEATHER RESISTANT PAINT IN ADDITION TO THE SIGNS. [IFC 503.3]
28. ELECTRICALLY CONTROLLED ACCESS GATES SHALL BE PROVIDED WITH AN APPROVED EMERGENCY VEHICLE DETECTOR/RECEIVER SYSTEM. SAID SYSTEM SHALL BE INSTALLED IN ACCORDANCE WITH THE IFC 503.6 AND IFC APPENDIX M.

2.5 CITY OF LAS VEGAS GRADING NOTES

1. IN THE EVENT THAT ANY UNFORESEEN CONDITIONS NOT COVERED BY THESE NOTES ARE ENCOUNTERED DURING GRADING OPERATIONS, THE OWNER/ENGINEER SHALL BE IMMEDIATELY NOTIFIED FOR DIRECTION.
2. IT SHALL BE THE RESPONSIBILITY OF THE CONTRACTOR TO PERFORM ALL NECESSARY CUTS AND FILLS WITHIN THE LIMITS OF THIS PROJECT AND THE RELATED OFF-SITE WORK, SO AS TO GENERATE THE DESIRED SUBGRADE, FINISH GRADES AND SLOPES SHOWN.
3. CONTRACTOR SHALL TAKE FULL RESPONSIBILITY FOR ALL EXCAVATION. ADEQUATE SHORING SHALL BE DESIGNED AND PROVIDED BY THE CONTRACTOR TO PREVENT UNDERMINING OF ANY ADJACENT FEATURES OR FACILITIES AND/OR CAVING OF THE EXCAVATION.
4. THE CONTRACTOR IS WARNED THAT AN EARTHWORK BALANCE WAS NOT NECESSARILY THE INTENT OF THIS PROJECT. ANY ADDITIONAL MATERIAL REQUIRED OR LEFTOVER MATERIAL FOLLOWING EARTHWORK OPERATIONS BECOMES THE RESPONSIBILITY OF THE CONTRACTOR.
5. THE GRADING CONTRACTOR IS RESPONSIBLE TO COORDINATE WITH THE OWNER TO PROVIDE FOR THE REQUIREMENTS OF THE PROJECT STORM WATER POLLUTION PREVENTION PLAN (SWPPP) AND ASSOCIATED PERMIT.
6. CONTRACTOR SHALL GRADE TO THE LINES AND ELEVATIONS SHOWN ON THE PLANS WITHIN THE FOLLOWING HORIZONTAL AND VERTICAL TOLERANCES AND DEGREES OF COMPACTION, IN THE AREAS INDICATED:

	HORIZONTAL	VERTICAL COMPACTION	
A. PAVEMENT AREA SUBGRADE	0.1'+	+0.0' TO –0.1'	SEE SOILS REPORT
B. ENGINEERED FILL	0.5'+	+0.1' TO –0.1'	SEE SOILS REPORT

COMPACTION TESTING WILL BE PERFORMED BY THE OWNER OR HIS REPRESENTATIVE.

7. ALL CUT AND FILL SLOPES SHALL BE PROTECTED UNTIL EFFECTIVE EROSION CONTROL HAS BEEN ESTABLISHED.
8. THE USE OF POTABLE WATER WITHOUT A SPECIAL PERMIT FOR BUILDING OR CONSTRUCTION PURPOSES INCLUDING CONSOLIDATION OF BACKFILL OR DUST CONTROL IS PROHIBITED. THE CONTRACTOR SHALL OBTAIN ALL NECESSARY PERMITS FOR CONSTRUCTION WATER.
9. THE CONTRACTOR SHALL MAINTAIN THE STREETS, SIDEWALKS AND ALL OTHER PUBLIC RIGHT-OF-WAY IN A CLEAN, SAFE AND USABLE CONDITION. ALL SPILLS OF SOIL, ROCK OR CONSTRUCTION DEBRIS SHALL BE PROMPTLY REMOVED FROM THE PUBLICLY OWNED PROPERTY DURING CONSTRUCTION AND UPON COMPLETION OF THE PROJECT. ALL ADJACENT PROPERTY, PRIVATE OR PUBLIC SHALL BE MAINTAINED IN A CLEAN, SAFE AND USABLE CONDITION.
10. IN THE EVENT THAT ANY TEMPORARY CONSTRUCTION ITEM IS REQUIRED THAT IS NOT SHOWN ON THESE DRAWINGS, THE OWNER AGREES TO PROVIDE AND INSTALL SUCH ITEM AT HIS OWN EXPENSE AND AT THE DIRECTION OF THE CITY ENGINEER. TEMPORARY CONSTRUCTION INCLUDES DITCHES, BERMS, ROAD SIGNS AND BARRICADES, ETC.

UTILITY LOCATION NOTE TO CONTRACTOR

EXISTING UTILITY LOCATIONS SHOWN HEREIN ARE APPROXIMATE ONLY. IT SHALL BE THE CONTRACTOR'S RESPONSIBILITY TO DETERMINE THE EXACT VERTICAL AND HORIZONTAL LOCATION OF ALL EXISTING UNDERGROUND UTILITIES PRIOR TO COMMENCING CONSTRUCTION. NO REPRESENTATION IS MADE THAT ALL EXISTING UTILITIES ARE SHOWN HEREON. THE ENGINEER ASSUMES NO RESPONSIBILITY FOR UTILITIES NOT SHOWN OR UTILITIES NOT SHOWN IN THEIR PROPER LOCATIONS. CALL BEFORE YOU DIG: 1 (800) 227-2600; SOUTHWEST GAS CORPORATION: 702-400-1789 (STANDBY CONTACT NUMBER)

2.1 CITY OF LAS VEGAS GENERAL NOTES

1. ALL CONSTRUCTION AND MATERIALS SHALL BE IN ACCORDANCE WITH THE "UNIFORM STANDARD SPECIFICATIONS FOR PUBLIC WORKS CONSTRUCTION OFF-SITE IMPROVEMENTS, CLARK COUNTY AREA NEVADA", LATEST ISSUE; THE "UNIFORM STANDARD DRAWINGS FOR PUBLIC WORKS CONSTRUCTION, CLARK COUNTY AREA NEVADA", LATEST REVISED EDITION; THE "SUMERLIN IMPROVEMENT STANDARDS" FOR WORK IN THE SUMMERLIN AREA; AND OTHER APPLICABLE APPROVED STANDARDS ISSUED BY THE CONTROLLING AGENCY; THE UNIFORM BUILDING CODE; AND ALL LOCAL CITY CODES AND ORDINANCES APPLICABLE, EXCEPT AS NOTED ON THIS SHEET IN "DEVIATIONS FROM STANDARDS".
2. THE EXISTENCE AND LOCATION OF ANY OVERHEAD OR UNDERGROUND UTILITY LINES, PIPES, OR STRUCTURES SHOWN ON THESE PLANS ARE OBTAINED BY A RESEARCH OF THE AVAILABLE RECORDS. EXISTING UTILITIES AS SHOWN FROM CLV PLANS LIBRARY ARE APPROXIMATE AND FOR RECORD PURPOSES. EXISTING UTILITIES ARE LOCATED ON PLANS ONLY FOR THE CONVENIENCE OF THE CONTRACTOR. EXISTING UTILITY SERVICE LATERALS MAY NOT BE SHOWN ON THE PLANS. THE CONTRACTOR SHALL, AT HIS OWN EXPENSE, LOCATE ALL UNDERGROUND AND OVERHEAD INTERFERENCE'S WHICH MAY AFFECT HIS OPERATION DURING CONSTRUCTION AND SHALL TAKE ALL NECESSARY PRECAUTIONS TO AVOID DAMAGE TO SAME. THE CONTRACTOR SHALL USE EXTREME CAUTION WHEN WORKING NEAR OVERHEAD UTILITIES SO AS TO SAFELY PROTECT ALL PERSONNEL AND EQUIPMENT, AND SHALL BE RESPONSIBLE FOR ALL COST AND LIABILITY IN CONNECTION THEREWITH.
3. THE CONTRACTOR SHALL TAKE ALL PRECAUTIONARY MEASURES NECESSARY TO PROTECT EXISTING UTILITY LINES, STRUCTURES AND STREET IMPROVEMENTS WHICH ARE TO REMAIN IN PLACE, FROM DAMAGE, AND ALL SUCH IMPROVEMENTS OR STRUCTURES DAMAGED BY THE CONTRACTOR'S OPERATIONS SHALL BE REPAIRED OR REPLACED SATISFACTORY TO THE CITY ENGINEER AND OWNING UTILITY COMPANY AT THE EXPENSE OF THE CONTRACTOR.
4. ALL CONSTRUCTION SHALL BE AS SHOWN ON THESE PLANS, ANY REVISIONS SHALL HAVE THE PRIOR WRITTEN APPROVAL OF THE CITY ENGINEER.
5. TYPE V CEMENT SHALL BE USED IN ALL OFF-SITE CONCRETE WORK. CONCRETE TO BE 3000 P.S.I. MINIMUM @ 28 DAYS. MIX DESIGNS TO BE APPROVED BY THE CITY, PRIOR TO THE USE ON THE PROJECT.
6. PERMITS ARE REQUIRED FOR ANY WORK IN THE PUBLIC RIGHT-OF-WAY. THE CONTRACTOR SHALL SECURE ALL PERMITS AND INSPECTIONS REQUIRED FOR THIS CONSTRUCTION.
7. EXPANSION JOINTS REQUIRED, MAXIMUM EVERY 300' IN EXTRUDED-TYPE CURB.
8. AC PAVEMENT TO BE ONE-HALF INCH (½") ABOVE LIP OF ALL GUTTERS AFTER COMPACTION, EXCEPT AT SIDEWALK RAMPS AND CROSS GUTTERS.
9. CURB AND GUTTER FOUND TO BE UNACCEPTABLE TO THE CITY OF LAS VEGAS SHALL BE REMOVED AND REPLACED PER STANDARD DRAWING 216.
10. SIDEWALK RAMPS SHALL BE CONSTRUCTED IN EACH QUADRANT OF AN INTERSECTION PER STANDARD DRAWING 235. EXACT LOCATION OF RAMPS MAY BE ADJUSTED IN THE FIELD BY A CITY INSPECTOR.
11. CONTRACTOR SHALL PROVIDE ALL NECESSARY HORIZONTAL AND VERTICAL TRANSITIONS BETWEEN NEW CONSTRUCTION AND EXISTING SURFACES TO PROVIDE FOR PROPER DRAINAGE AND FOR INGRESS AND EGRESS TO NEW CONSTRUCTION. THE EXTENT OF THE TRANSITIONS TO BE AS SHOWN ON PLANS.
12. ALL GRADING WORK SHALL CONFORM TO THE SOILS REPOR

ABBREVIATIONS

AC	ASPHALTIC CONCRETE OR ACRE	FL	FLOWLINE	PVI	POINT OF VERTICAL INTERSECTION
AGG	AGGREGATE BASE	FT	FEET OR FOOT	QTY	QUANTITY
APN	ASSESSORS PARCEL NUMBER	FUT	FUTURE	R	RADIUS
APPROX OR ~	APPROXIMATE	GRD	GRADE OR GROUND	RCA	REINFORCED CONCRETE ARCH
AVE	AVENUE	GB	GRADE BREAK OR GRADE CHANGE	RCB	REINFORCED CONCRETE BOX
@	AT	GV	GATE VALVE	RCP	REINFORCED CONCRETE PIPE
BC	BEGIN CURVE OR BACK OF CURB	HDPE	HIGH DENSITY POLYETHYLENE	RD	RADIUS
BCR	BEGINNING OF CURB RETURN	HOA	HOME OWNERS ASSOCIATION	RDWY ESMT	ROADWAY EASEMENT
BHW	BOTTOM OF HEADWALL	HORZ	HORIZONTAL	REQD	REQUIRED
BLDG	BUILDING	HP	HIGH POINT	REV	REVISION
BLVD	BOULEVARD	HWL	HIGH WATER LEVEL	RG	ROUGH GRADE
BM	BENCHMARK	HDWL OR HW	HEADWALL	RT OR R	
BVC	BEGIN VERTICAL CURVE	HYD	HYDRAULIC OR HYDRANT	R/W, ROW	RIGHT OF WAY
BWV	BACK WATER VALVE	ID	INSIDE DIAMETER	S	SLOPE
CC	CLARK COUNTY	IN	INCH	SCH	SCHEDULE
CCAUSD	CLARK COUNTY AREA UNIFORM STANDARD DRAWINGS	INT	INTERSECTION	SD	STORM DRAIN
CCPW	CLARK COUNTY PUBLIC WORKS	INV	INVERT ELEVATION	SDDI	STORM DRAIN DROP INLET
CCRFCD	CLARK COUNTY REGIONAL FLOOD DISTRICT	IP	IRON PIPE	SDMH	STORM DRAIN MANHOLE
CCWRD	CLARK COUNTY WATER RECLAMATION DISTRICT	IRRG	IRRIGATION	SE	SEWER EASEMENT
CE	COMMON ELEMENT	LF	LINEAR FEET	SEC	SECTION
CL,C/L,C	CENTERLINE	LMC	LANDSCAPE MAINTENANCE CORPORATION	SF	SQUARE FEET
CLR	CLEAR OR CLEARANCE	LP	LOW POINT	SHT	SHEET
CLSM	CONTROLLED LOW STRENGTH MATERIAL	LT OR L	LEFT	SLTC	STREET LIGHT & TRAFFIC CONTROL ESMT
CLV	CITY OF LAS VEGAS	LVWD	LAS VEGAS VALLEY WATER DISTRICT	SNWA	SOUTHERN NEVADA WATER AUTHORITY
CML&C	CEMENT MORTAR LINED AND COATED	LWL	LOW WATER LEVEL	SPECS	SPECIFICATIONS
CMU	CONCRETE MASONRY UNIT	MAX	MAXIMUM	ST	STREET
CNLV	CITY OF NORTH LAS VEGAS	MECH	MECHANICAL	SSMH	SANITARY SEWER MANHOLE
COH	CITY OF HENDERSON	MH	MANHOLE	STA	STATION
CONC	CONCRETE	MIN	MINIMUM	STD	STANDARD
CT	COURT	MISC	MISCELLANEOUS	STL	STEEL
CY OR CU YD	CUBIC YARD	MUE	MUNICIPAL UTILITY EASEMENT	STLT	STREET LIGHT
DCWCS	DESIGN AND CONSTRUCTION FOR WASTEWATER COLLECTION SYSTEMS	NDOT	NEVADA DEPARTMENT OF TRANSPORTATION	SW	SIDEWALK
		NTS	NOT TO SCALE	SWG	SOUTHWEST GAS
DE	DRAINAGE EASEMENT	NUE	NONEXCLUSIVE UTILITY EASEMENT	SWR OR SS	SANITARY SEWER
DET	DETAIL	NVE	NV ENERGY	SY	SQUARE YARD
DI	DUCTILE IRON OR DRAIN INLET	OC	ON CENTER	TAN	TANGENT
DIA, ø	DIAMETER	OD	OUTSIDE DIAMETER OR OVERALL DIMENSION	TC	TOP OF CURB
DIP	DUCTILE IRON PIPE	OFF	OFFSET	TF	TOP OF FLOOR OR TOP OF FOOTING
DR	DRIVE	ORIG	ORIGINAL	TG	TOP OF GRATE
DWG(S)	DRAWING	PAE	PUBLIC OR PEDESTRIAN ACCESS EASEMENT	THRU	THROUGH
DWY	DRIVEWAY	PB	PULL BOX	THW	TOP OF HEADWALL
EA	EACH	PC	POINT OF CURVE	TP	TOP OF PIPE
ECR	END CURB RETURN	PCC	POINT OF COMPOUND CURVE	TW	TOP OF WALL
EG	EXISTING GROUND	PDE	PUBLIC DRAINAGE EASEMENT	TRW	TOP OF RETAINING WALL
ELEV	ELEVATION	℄ OR PL	PROPERTY LINE	TSW	TOP OF SCREEN WALL
ESMT	EASEMENT	POB	POINT OF BEGINNING	TYP	TYPICAL
EP	EDGE OF PAVEMENT	POC	POINT OF CURVATURE	UDACS	UNIFORM DESIGN AND CONSTRUCTION STANDARDS
ERU	EQUIVALENT RESIDENTIAL UNIT	POE	POINT OF ENDING		
EVC	END VERTICAL CURVE	PRC	POINT OF REVERSE CURVATURE	VC	VERTICAL CURVE
EX OR EXIST	EXISTING	PRELIM	PRELIMINARY	VERT	VERTICAL
FC	FACE OF CURB	PROP	PROPOSED	VG	VALLEY GUTTER
FF	FINISHED FLOOR	PRV	PRESSURE REDUCING VALVE	WI	WROUGHT IRON
FG	FINISHED GRADE	PUE	PUBLIC UTILITY EASEMENT	WL	WATER LINE
FGH	FINISHED GRADE, HIGH SIDE	PT	POINT OF TANGENT OR POINT	WPZ	WATER PRESSURE ZONE
FGL	FINISHED GRADE, LOW SIDE	PVC	POLYVINYL CHLORIDE	WT	WEIGHT
FH	FIRE HYDRANT			WTR	WATER LINE

SPECIAL NOTE

IN THE EVENT THAT ANY TEMPORARY CONSTRUCTION ITEM IS REQUIRED WHICH IS NOT SHOWN ON THESE DRAWINGS, THE OWNER AGREES TO PROVIDE AND INSTALL SUCH ITEM AT HIS OWN EXPENSE AND AT THE DIRECTION OF THE CITY OF LAS VEGAS DEPT. OF PUBLIC WORKS. TEMPORARY CONSTRUCTION ITEMS INCLUDE: PAVEMENT TRANSITIONS, PROTECTIVE DITCHES AND BERMS, ROAD SIGNS AND BARRICADES, ETC.

NOTICE TO CONTRACTOR

-QUANTITIES SHOWN ARE ESTIMATES ONLY AND ARE INTENDED TO ILLUSTRATE SCOPE OF WORK. THE CONTRACTOR SHALL BE RESPONSIBLE FOR VERIFYING THE EXACT QUANTITIES INVOLVED.

-EXISTING UTILITY LOCATIONS SHOWN HEREIN ARE APPROXIMATE ONLY. IT SHALL BE THE CONTRACTOR'S RESPONSIBILITY TO DETERMINE THE EXACT VERTICAL AND HORIZONTAL LOCATION OF ALL EXISTING UNDERGROUND UTILITIES PRIOR TO COMMENCING CONSTRUCTION. NO REPRESENTATION IS MADE THAT ALL EXISTING UTILITIES ARE SHOWN HEREON. THE ENGINEER ASSUMES NO RESPONSIBILITY FOR UTILITIES NOT SHOWN OR UTILITIES NOT SHOWN IN THEIR PROPER LOCATIONS. CALL BEFORE YOU DIG: (800) 227-2600

LEGEND

EXISTING	PROPOSED	DESCRIPTION
(1900)	1900	5' CONTOUR
		1' CONTOUR
		STRIPING
		SEWER MANHOLE
		CURB AND GUTTER
EX 8" PVC SS	8" PVC SS	SANITARY SEWER PIPE AND FLOW ARROW
EX 8" PVC WTR	8" PVC WTR	WATER PIPE
		WATER GATE VALVE
		FIRE HYDRANT
		WATER BLOW-OFF
		WATER LATERAL W/ METER
		SANITARY SEWER LATERAL
		STREETLIGHT
		EDGE OF PAVEMENT
		TRAFFIC SIGN
PAD= XXX.X FF = XXX.X	PAD= XXX.X FF = XXX.X	PAD ELEVATION FINISHED FLOOR ELEVATION
(00.00) TC	00.00 TC	ELEVATION
		RETAINING WALL
		STORM DRAIN W/ MANHOLE

	EXISTING GAS GATE VALVE
@VH	EXISTING UNKNOWN MANHOLE
	EXISTING GAS, SIZE PER PLAN
	EXISTING POWER POLE
	EXISTING TRAFFIC SIGNAL
	EXISTING WALL
	WATER PIPE FITTING
POC	WATER POINT OF CONNECTION
POC	SEWER POINT OF CONNECTION
	DAYLIGHT LINE
	STREET CENTERLINE
	RIGHT-OF-WAY
	MATCHLINE
	BOUNDARY LINE
	PHASE LINE
	PROPERTY LINE
	FLOWLINE
	SAWCUT
FILL / CUT	CUT/FILL TRANSITION LINE
	SIDEWALK
	EX STRIPING TO BE OBLITERATED
	GRADE BREAK LINE
	REFLECTIVE RAISED PAVEMENT MARKERS
BWV	BACK WATER VALVE
	WROUGHT IRON FENCE
	PONY WALL
	DECORATIVE PERIMETER WALL
	DECORATIVE PERIMETER RETAINING WALL
	PROPOSED CURB AND GUTTER WITH RIGHT-OF-WAY AT BACK OF CURB
	EXISTING CURB AND GUTTER WITH RIGHT-OF-WAY AT BACK OF CURB
	FUTURE CURB AND GUTTER WITH RIGHT-OF-WAY AT BACK OF CURB

	PROPOSED SCARP AREA
	DRIVEWAY
	PROPOSED RIP RAP
	SIGHT VISIBILITY ZONE PER STD DWG NO. 201.2
	HANDICAP RAMP

QUANTITIES

			PRIVATE	PUBLIC
DRAINAGE				
1.	48" TYPE III STORM DRAIN MANHOLE	EA	–	7
2.	12.5' TYPE "CM2" DROP INLET	EA	–	2
3.	15.5' TYPE "CM2" DROP INLET	EA	–	1
4.	30" RCP CLASS IV STORM DRAIN	LF	–	30
5.	42" RCP CLASS IV STORM DRAIN	LF	–	72
6.	8' WIDE CONCRETE VALLEY GUTTER W/10" TYPE I AGGREGATE BASE	SF	–	1,350
SEWER SYSTEM				
1.	4" PVC SEWER LATERAL (PRIVATE)	LF	2500	–
2.	8" PVC SEWER PIPE (PUBLIC)	LF	–	2,000
3.	STANDARD 48" SEWER MANHOLE (PUBLIC)	EA	–	12
4.	BACK WATER VALVE	EA	30	–
WATER SYSTEM				
1.	FIRE HYDRANT ASSEMBLY W/6" GATE VALVE PER UDACS PLATE NO. 40	EA	–	5
2.	6" PVC WATER PIPE (CLASS 150)	LF	–	100
3.	8" PVC WATER PIPE (CLASS 150)	LF	–	2,300
4.	8" GATE VALVE WITH VALVE BOX PER UDACS PLATE NO. 30 & 39	EA	–	5
5.	8" X 6" TEE PER UDACS PLATE NO. 31	EA	–	5
6.	8" X 8" TEE PER UDACS PLATE NO. 31	EA	–	3
7.	8" 5 DEGREE BEND WITH THRUST BLOCK PER UDACS PLATE NO. 31	EA	–	13
8.	8" 11.25 DEGREE BEND PER UDACS PLATE NO. 31	EA	–	6
9.	8" 22.5 DEGREE BEND PER UDACS PLATE NO. 31	EA	–	2
10.	8" 45 DEGREE BEND PER UDACS PLATE NO. 31	EA	–	4
11.	CAP AND 2" BLOW-OOF ASSEMBLY W/COPPER UDACS PLATE NO. 36	EA	–	1
12.	1" COPPER SERVICE W/ 3/4" METER PER UDACS PLATE NO. 1	EA	–	94
13.	1" COPPER SERVICE W/ 3/4" IRRIGATION METER & 1" RPPA PER UDACS PLATE NO. 4 & 8	EA	–	1
14.	PRESSURE REDUCING VALVE	EA	–	85
STREET IMPROVEMENTS				
1.	2" A.C. PAVEMENT W/ 4" TYPE II OVER 6" TYPE I AGGREGATE BASE	SY	9,000	–
2.	STANDARD 18" TYPE "L" ISLAND CURB & GUTTER W/6" TYPE I AGGREGATE BASE	LF	50	–
3.	STANDARD 30" TYPE "ROLL" CURB & GUTTER W/6" TYPE I AGGREGATE BASE	LF	1,350	–
4.	4' WIDE CONCRETE SIDEWALK W/4" TYPE II AGGREGATE BASE	SF	10,000	–
TRAFFIC SIGNALS				
1.	30" STOP SIGN WITH POST (R1-1)	EA	3	–
2.	9" STREET NAME SIGN (D-3, BROWN W/ WHITE LETTERS)(6 POLES x 2 PER POLE=12)	EA	3	–
3.	BLUE COLORED REFLECTIVE RAISED PAVEMENT MARKER	EA	5	–
DRY UTILITIES				
1.	100W H.P.S. LUMINAIRE STREET LIGHT W/DECORATIVE POLE	EA	18	–
2.	1-1/4" PVC STREET LIGHT CONDUIT WITH (2) #4 AND (1) #8 CONDUCTORS	LF	2,270	–
3.	NO. 3-1/2 PULLBOX	LF	2	–
4.	125 AMP SERVICE PEDESTAL (IRR)	EA	3	–
5.	200 AMP SERVICE PEDESTAL (STLT)	EA	1	–

ADDITIONAL QUANTITIES

			PRIVATE	PUBLIC
DRAINAGE				
7.	5.0' TYPE "CM2" DROP INLET	EA	–	2
8.	10.0' TYPE "CM2" DROP INLET	EA	–	1
9.	24" RCP CLASS III STORM DRAIN	LF	–	35

SOUTHWEST GAS APPROVAL

SOUTHWEST GAS CORPORATION — DATE 5/9/19

APPROVED FOR CONSTRUCTION

LAS VEGAS VALLEY WATER DISTRICT ENGINEERING SERVICES

PROJECT NO.: 136382 FIRST APPROVED DATE: 5/13/19

SLATER HANIFAN GROUP
a Westwood team
5740 S. ARVILLE STREET #216, LAS VEGAS, NV 89118
PHONE (702) 284-5300 FAX (702) 284-5399

NO.	DESCRIPTION	DATE	BY	APP. DATE	APP.
1	REVISE QUANTITIES PER CLV	5/10/19	OQ	5-23-19	

LAS VEGAS, NV

KB HOME

BRISTLE VALE - UNIT 2

LEGEND, ABBREVIATIONS, AND QUANTITIES

S 33
T 20S
R 59E

DATE: 5/8/19
DRAFTER: OQ
DESIGNER: OQ
CHECKED: DSP

PROJECT NO.
KBH1804-000

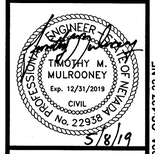

5/8/19

C-3
SHEET 3 OF 29

L19-00527
107Y5102-2

PRO.#:136382A QS:137-33-NE

z:\kbh1804-000 summerlin v24 parcel 18&m\dwg\improv\phase 2\kbh1804-000 cvr p2.dwg 5/8/2019 3:08 PM Oscar Quirez

HOWARD HUGHES COMPANY, LLC
APN: 137-33-501-001
ALTA DR
INFRASTRUCTURE
IMPROVEMENTS
PER CLV#H63699
ALTA DR
(PUBLIC)
COMMON LOT OF
HOWARD HUGHES
COMPANY, LLC APN:
137-33-610-008
OREGON CHERRY AVE
(PRIVATE)
PURPLE SANDPIPER ST
(PRIVATE)
SPOTTED DOVE ST
(PRIVATE)
BRISTLE VALE UNIT
IMPROVEMENT PLAN
PER CLV #19-00027
UNIT 1
UNIT 2
EX 42" SD PER CLV NO H63699
EX 24" RCP SD PER CLV NO H63699
EX 15" SSMH #7 PER CLV NO H63699
EX 30" LS
EX 78" RCW
24'X30' LVWMD ESMT PER INST # 20180501-0001653
24'X6' LVWMD EXCLUSIVE EASEMENT PER INST # 20180501-0001661
EX 3" AIR VALVE RELOCATE PER DETAIL 22 ON SHEET D-2 TO STA:2474+44.31 OFF: 52.5L

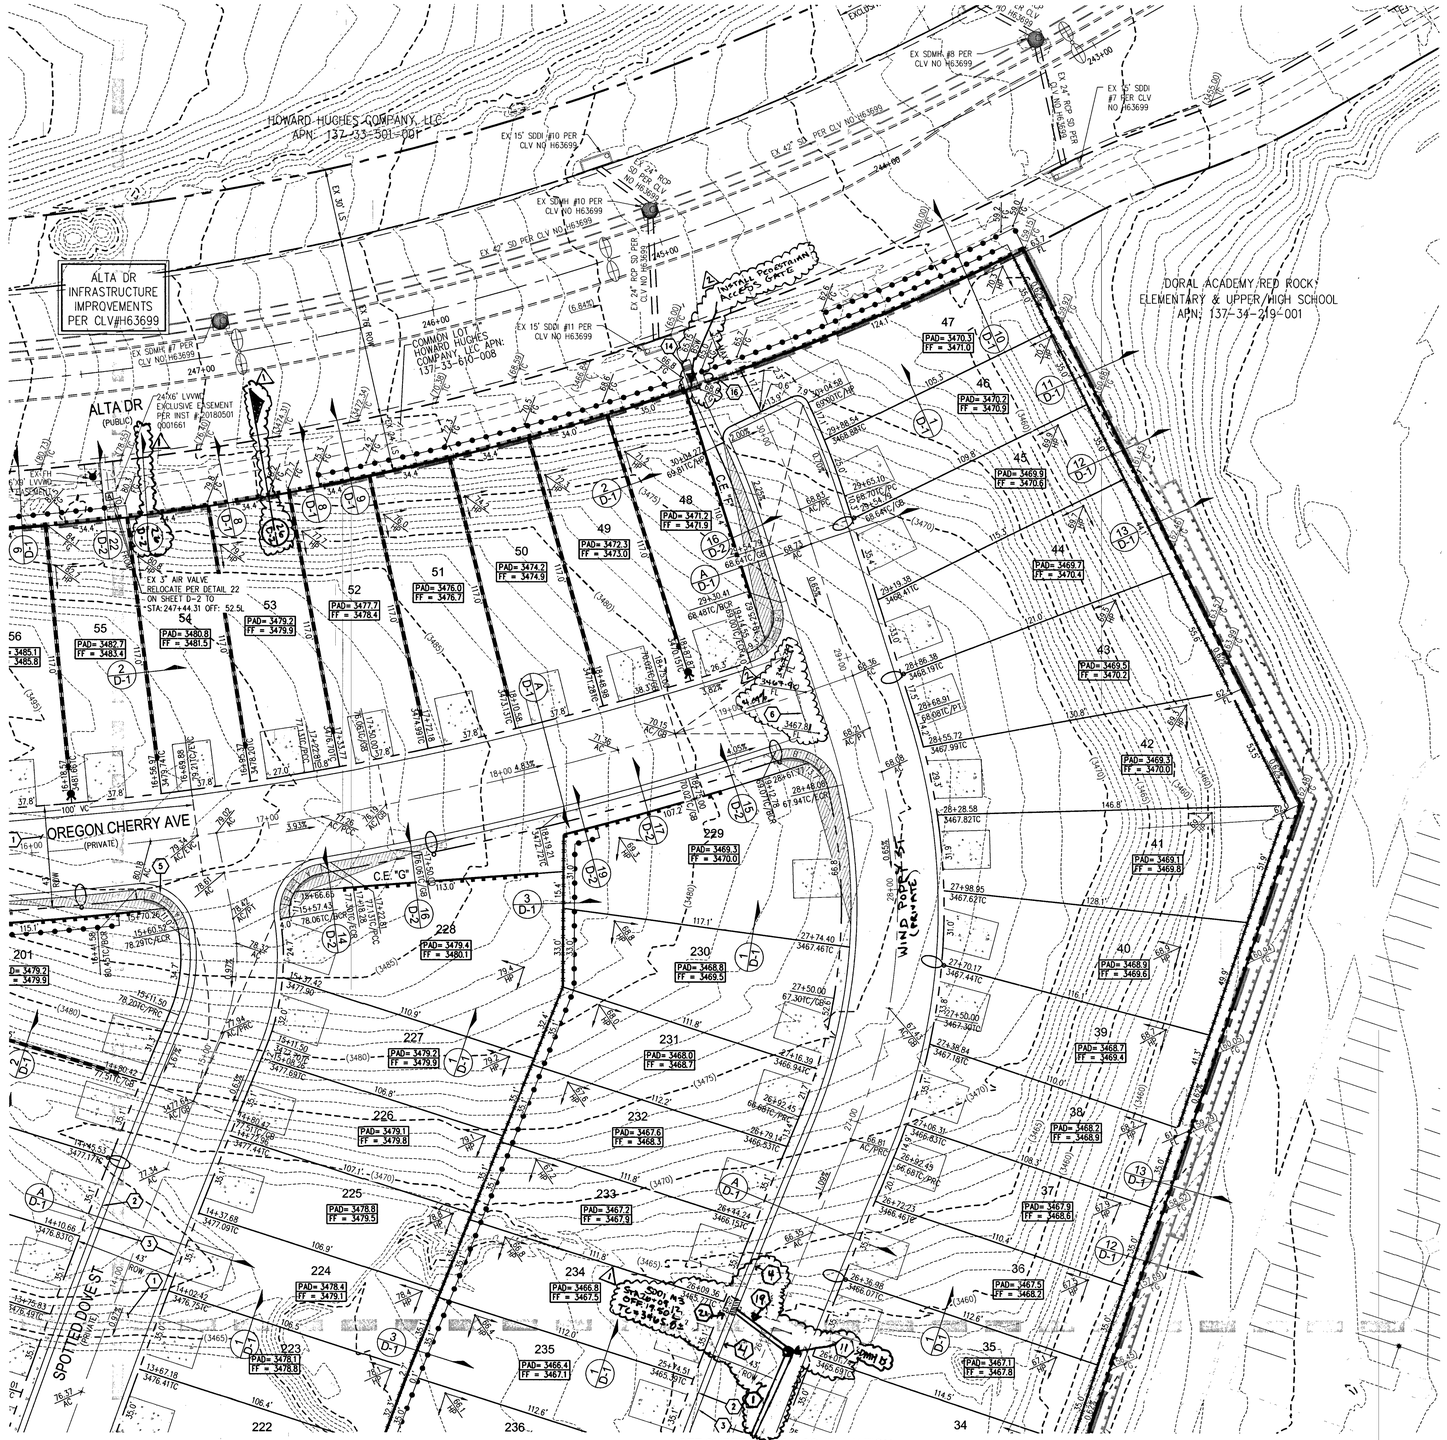

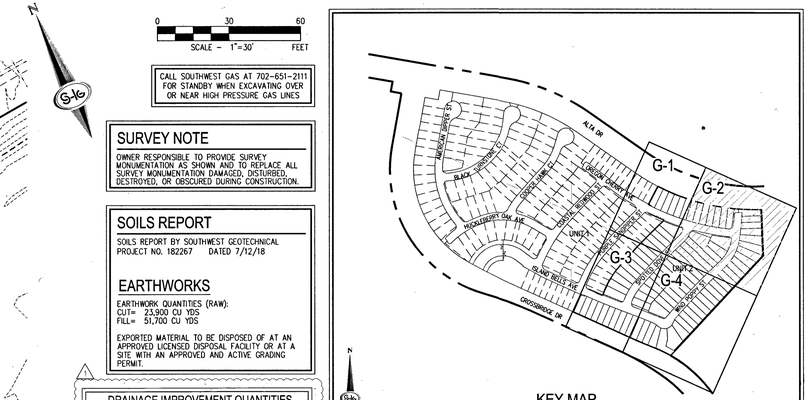

SCALE - 1"=30' (0, 30, 60 FEET)

CALL SOUTHWEST GAS AT 702-651-2111 FOR STANDBY WHEN EXCAVATING OVER OR NEAR HIGH PRESSURE GAS LINES

SURVEY NOTE

OWNER RESPONSIBLE TO PROVIDE SURVEY MONUMENTATION AS SHOWN AND TO REPLACE ALL SURVEY MONUMENTATION DAMAGED, DISTURBED, DESTROYED, OR OBSCURED DURING CONSTRUCTION.

SOILS REPORT

SOILS REPORT BY SOUTHWEST GEOTECHNICAL
PROJECT NO. 182267 DATED 7/12/18

EARTHWORKS

EARTHWORK QUANTITIES (RAW):
CUT= 23,900 CU YDS
FILL= 51,700 CU YDS

EXPORTED MATERIAL TO BE DISPOSED OF AT AN APPROVED LICENSED DISPOSAL FACILITY OR AT A SITE WITH AN APPROVED AND ACTIVE GRADING PERMIT.

DRAINAGE IMPROVEMENT QUANTITIES

1.	48" TYPE III STORM DRAIN MANHOLE	EA	7
2.	24" RCP STORM DRAIN	LF	35
3.	30" RCP STORM DRAIN	LF	30
4.	42" RCP STORM DRAIN	LF	72
5.	5' TYPE "CM2" DROP INLET	EA	2
6.	10' TYPE "CM2" DROP INLET	EA	1
7.	12.5' TYPE "CM2" DROP INLET	EA	2
8.	15' TYPE "CM2" DROP INLET	EA	1
9.	8' WIDE CONCRETE VALLEY GUTTER	EA	2
10.	REMOVE 5'x2' NDOT TYPE 2A DROP INLET	EA	1

LEGAL DESCRIPTION

LYING WITHIN THE NORTH EAST QUARTER (NE1/4) OF SECTION 33, TOWNSHIP 20 SOUTH, RANGE 59 EAST M.D.M., CITY OF LAS VEGAS, CLARK COUNTY, NEVADA.

EASEMENT NOTES

1. ALL PRIVATE STREETS ARE P.U.E., PUBLIC SEWER EASEMENTS AND PUBLIC DRAINAGE EASEMENTS TO BE PRIVATELY MAINTAINED BY HOA.
2. ALL COMMON ELEMENTS ARE PUBLIC DRAINAGE EASEMENTS TO BE PRIVATELY MAINTAINED BY HOA.

GRADING NOTES

1. SEE SHEETS 16-19 FOR RETAINING WALL ELEVATIONS.
2. FINAL GRADES ADJACENT TO STRUCTURES SHALL BE IN CONFORMANCE WITH IBC 2012, SECTION 2304.11.2.2.
3. THE CONTRACTOR SHALL VERIFY ALL CONDITIONS AND DIMENSIONS AND REPORT ALL DISCREPANCIES TO THE ENGINEER.
4. ALL IMPROVEMENTS TO BE PROTECTED FROM EROSION BY SWPPP.
5. MAXIMUM/MINIMUM SLOPES AND MINIMUM STREET SECTIONS NOT TO EXCEED THAT SHOWN ON GEOTECH REPORT.
6. SEE DETAIL SHEET FOR STREET SECTIONS AND DETAILS.
7. ALL PUBLIC AND PRIVATE DRAINAGE IMPROVEMENTS TO BE BONDED FOR AND INSPECTED.
8. CONSTRUCTION OF BLOCK WALLS REQUIRES A SEPARATE BUILDING PERMIT AND APPROVAL BY THE CITY OF LAS VEGAS BUILDING DEPARTMENT.
9. CONTRACTOR TO VERIFY LOCATION AND ELEVATION OF EXISTING UTILITY STRUCTURES AND FACILITIES AND NOTIFY ENGINEER OF ANY DISCREPANCIES PRIOR TO CONSTRUCTION. CONTRACTOR TO PROTECT IN PLACE DURING CONSTRUCTION. ENGINEER/OWNER SHALL BE NOTIFIED OF PRIOR DAMAGE TO EXISTING FACILITIES PRIOR TO CONSTRUCTION. CONTRACTOR WILL BE RESPONSIBLE FOR REPAIR/REPLEPING FACILITIES IF ENGINEER/OWNER IS NOT NOTIFIED OF EXISTING DAMAGE PRIOR TO CONSTRUCTION COMMENCING.
10. NO STRUCTURE, VEGETATION, OR OBJECTS OF ANY KIND IS PERMITTED OVER TWENTY-FOUR (24) INCHES IN HEIGHT (MEASURED FROM THE TOP OF THE ADJACENT CURB IF CURB EXIST) WITHIN THE SIGHT VISIBILITY ZONES.

CONSTRUCTION NOTES

1. INSTALL 2" ASPHALT PAVEMENT OVER 4" TYPE II AGGREGATE BASE
2. CONSTRUCT 4' WIDE SIDEWALK PER CCAUSD NO. 234 (5" THICK W/ 5" TYPE II AGGREGATE BASE)
3. INSTALL MODIFIED ROLL TYPE CURB PER CCAUSD NO. 217.1
4. INSTALL 10' 2" TYPE CURB TO MODIFIED ROLL CURB TRANSITION PER DETAIL 29, SHEET D-3
5. CONSTRUCT SIDEWALK RAMPS USING ARMOR TILE TRUNCATED DOMES OR EQUIVALENT PER DETAIL 28, SHEET D-3
6. CONSTRUCT 8' CROSS GUTTER PER CCAUSD NO. 228
7. INSTALL 30" RCP STORM DRAIN PIPE
8. INSTALL 42" RCP STORM DRAIN PIPE
9. INSTALL 12.5' TYPE "CM2" DROP INLET PER CCAUSD NO. 412.1 AND STORM WATER QUALITY MANAGEMENT STAMP PER CCAUSD NO. 421
10. INSTALL 15' TYPE "CM2" DROP INLET WITH ALTERNATE CONNECTION PER CCAUSD NO. 412.1 AND STORM WATER QUALITY MANAGEMENT STAMP PER CCAUSD NO. 421
11. INSTALL 48" TYPE III SDMH CCAUSD NO. 401, 402 & 406
12. REMOVE EX 4.5'X6' NDOT TYPE 2A DROP INLET AND APRON
13. REMOVE AND REINSTALL 8' WIDE SIDEWALK PER CCAUSD NO. 234
14. INSTALL 10 STEPS @ 4.1"
15. INSTALL WROUGHT IRON MAN GATE
16. INSTALL WROUGHT FENCE PER CCAUSD NO. 425.S1
17. INSTALL THROUGH WALL DRAIN BLOCK PER DETAIL 24, SHEET D-2
18. SAWCUT AND MATCH EXISTING IMPROVEMENTS (3" AC/6" TYPE I OR SCARIFY, NATIVE) PER CCAUSD NO 500.2. EXISTING STRIPING TO BE REPLACED
19. INSTALL 18" RCP STORM DRAIN PIPE
20. INSTALL 36" RCP STORM DRAIN PIPE
21. INSTALL 5' TYPE "CM2" DROP INLET PER CCAUSD NO. 412.1 AND STORM WATER QUALITY MANAGEMENT STAMP PER CCAUSD NO. 421
22. INSTALL 10' TYPE "CM2" DROP INLET PER CCAUSD NO. 412.1 AND STORM WATER QUALITY MANAGEMENT STAMP PER CCAUSD NO. 421

SEE SHEET G-3 FOR LEGEND, ABBREVIATIONS, & QUANTITIES

FLOOD ZONE

THE PROJECT SITE IS LOCATED WITHIN A FEMA DESIGNATED ZONE X (UNSHADED) AS DEPICTED ON FLOOD INSURANCE RATE MAP (FIRM) PANEL 32003C2125E & 32003C2150E, DATED SEPTEMBER 27, 2002. A ZONE X (UNSHADED) IS DESCRIBED AS AN AREA DETERMINED TO BE OUTSIDE THE 0.2% ANNUAL CHANCE FLOOD PLAIN.

DISCLAIMER NOTE

1. EXISTING UTILITY LOCATIONS SHOWN HEREON ARE APPROXIMATE ONLY. IT SHALL BE THE CONTRACTOR'S RESPONSIBILITY TO DETERMINE THE EXACT VERTICAL AND HORIZONTAL LOCATION OF ALL EXISTING UNDERGROUND UTILITIES PRIOR TO COMMENCING CONSTRUCTION. NO REPRESENTATION IS MADE THAT ALL EXISTING UTILITIES ARE SHOWN HEREON. THE ENGINEER ASSUMES NO RESPONSIBILITY FOR UTILITIES NOT SHOWN IN THEIR PROPER LOCATION.
2. FOR ROADWAY WIDENING AND HALF STREET IMPROVEMENTS THE CONTRACTOR SHALL VERIFY CROSS SLOPES FROM EXISTING PAVEMENT SAWCUT LINE TO PROPOSED EDGE OF PAVEMENT OR PROJECTED LIP OF CURB PRIOR TO SUBGRADE PREPARATION AND CONSTRUCTION OF PROPOSED CURB LINE. IF MINIMUM OR MAXIMUM CROSS SLOPES DO NOT MEET AGENCY STANDARDS THE CONTRACTOR SHALL NOTIFY THE ENGINEER.

BENCHMARK

CITY OF LAS VEGAS BENCHMARK 7LV09 34SW6

RIVET AND ROUND PLATE IN THE TOP OF CURB AT THE SOUTHEAST CORNER OF DESERT MOON RD. AND SKY MSTA DR.
ELEVATION = 1011.422 METERS (NAVD '88)
ELEVATION = 3318.31 US SURVEY FEET (NAVD '88)

BASIS OF BEARINGS

NORTH 05°59'55" WEST, BEING THE BEARING OF THE WEST LINE OF SECTION 34, TOWNSHIP 20 SOUTH, RANGE 59 EAST, M.D.M., CITY OF LAS VEGAS, CLARK COUNTY, NEVADA, AS SHOWN BY MAP THEREOF ON FILE IN THE CLARK COUNTY, NEVADA RECORDER'S OFFICE IN BOOK 135, PAGE 71 OF PLATS.

FLOOD CERTIFICATION

I CERTIFY THAT THIS GRADING PLAN IS IN CONFORMANCE WITH THE APPROVED, TECHNICAL DRAINAGE STUDY DSS632 ON FILE AT CITY OF LAS VEGAS FOR THE SUBJECT PROJECT.

TIMOTHY M. MULROONEY, P.E. 22938 — DATE 5/8/19

TIMOTHY M. MULROONEY — Exp. 12/31/2019 — CIVIL — No. 22938 — STATE OF NEVADA — PROFESSIONAL ENGINEER — 5/8/19

FAST Call before you UnderGround 1-702-432-5300 FREEWAY & ARTERIAL SYSTEM OF TRANSPORTATION (F.A.S.T.)

AVOID HITTING OVERHEAD POWER LINES. IT'S COSTLY. CALL BEFORE YOU DO OVERHEAD 1-702-227-2929

Call before you Dig AVOID CUTTING UNDERGROUND UTILITY LINES. IT'S COSTLY. Call 811 OR 1-800-227-2600

SLATER HANIFAN GROUP
CONSULTING ENGINEERS & PLANNERS
5740 S. ARVILLE STREET #216, LAS VEGAS, NV 89118
PHONE (702) 284-5300 FAX (702) 284-5399

NO	DESCRIPTION	DATE	BY	APP DATE	APP
1	REV STORM DRAIN AND RETAINING WALLS	4-14-19	MA		
2	REV GRADING AND GATE	5-1-19	MA		

LAS VEGAS, NV

KB HOME
BRISTLE VALE - UNIT 2
GRADING PLAN II

S33 T20S R59E

DATE: 5/8/19
DRAFTER: OQ
DESIGNER: OQ
CHECKED: DSP
PROJECT NO. KBH1804-000

G-2
SHEET 5 OF 29

L19-00527
107Y5102-2

I:\kbh1804-000 summerlin -24 parcel 18m\dwg\engrav\phase 2\kbh1804-000 grd p2.dwg 5/8/2019 3:09 PM Oscar Quiroz

SEE SHEET G-1 FOR CONTINUATION

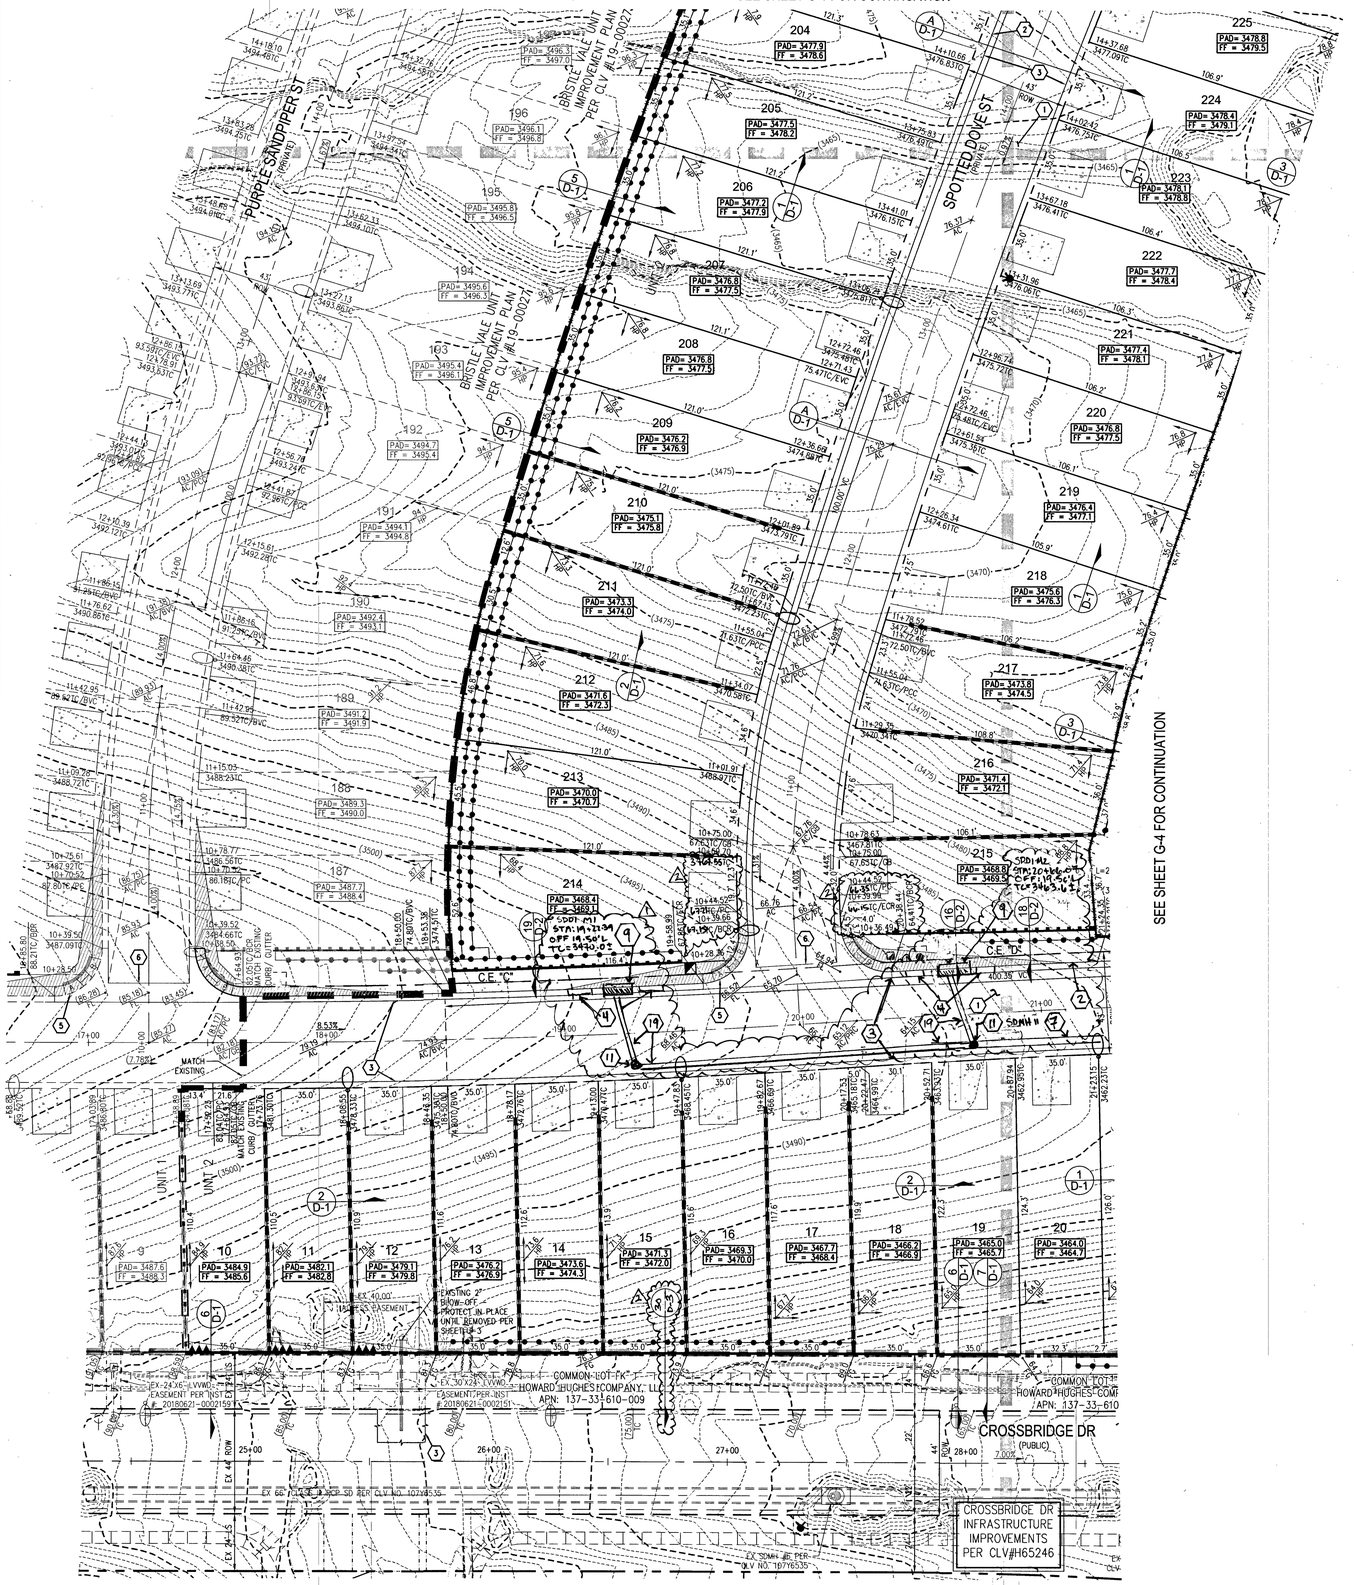

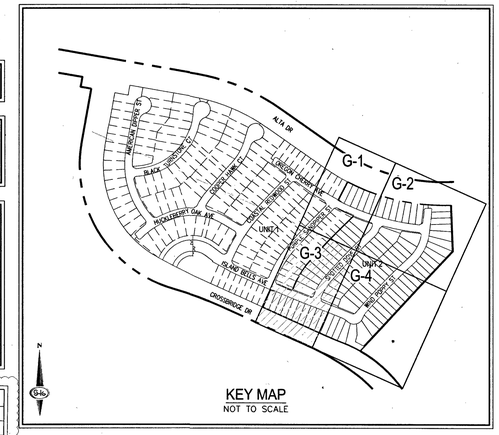

KEY MAP
NOT TO SCALE

SCALE – 1"=30' (0 30 60 FEET)

CALL SOUTHWEST GAS AT 702-651-2111 FOR STANDBY WHEN EXCAVATING OVER OR NEAR HIGH PRESSURE GAS LINES

SURVEY NOTE

OWNER RESPONSIBLE TO PROVIDE SURVEY MONUMENTATION AS SHOWN AND TO REPLACE ALL SURVEY MONUMENTATION DAMAGED, DISTURBED, DESTROYED, OR OBSCURED DURING CONSTRUCTION.

SOILS REPORT

SOILS REPORT BY SOUTHWEST GEOTECHNICAL
PROJECT NO. 182267 DATED 7/12/18

EARTHWORKS

EARTHWORK QUANTITIES (RAW):
CUT= 23,900 CU YDS
FILL= 51,700 CU YDS

EXPORTED MATERIAL TO BE DISPOSED OF AT AN APPROVED LICENSED DISPOSAL FACILITY OR AT A SITE WITH AN APPROVED AND ACTIVE GRADING PERMIT.

DRAINAGE IMPROVEMENT QUANTITIES

1.	48" TYPE III STORM DRAIN MANHOLE	EA	7
2.	24" RCP STORM DRAIN	EA	35
3.	30" RCP STORM DRAIN	LF	30
4.	42" RCP STORM DRAIN	LF	72
5.	5' TYPE "CM2" DROP INLET	EA	2
6.	10' TYPE "CM2" DROP INLET	EA	1
7.	12.5' TYPE "CM2" DROP INLET	EA	2
8.	15' TYPE "CM2" DROP INLET	EA	1
9.	8' WIDE CONCRETE VALLEY GUTTER	EA	2
10.	REMOVE 5'x2' NDOT TYPE 2A DROP INLET	EA	1

LEGAL DESCRIPTION

LYING WITHIN THE NORTH EAST QUARTER (NE1/4) OF SECTION 33, TOWNSHIP 20 SOUTH, RANGE 59 EAST M.D.M., CITY OF LAS VEGAS, CLARK COUNTY, NEVADA.

EASEMENT NOTES

1. ALL PRIVATE STREETS ARE P.U.E., PUBLIC SEWER EASEMENTS AND PUBLIC DRAINAGE EASEMENTS TO BE PRIVATELY MAINTAINED BY HOA.
2. ALL COMMON ELEMENTS ARE PUBLIC DRAINAGE EASEMENTS TO BE PRIVATELY MAINTAINED BY HOA.

CONSTRUCTION NOTES

1. INSTALL 2" ASPHALT PAVEMENT OVER 4" TYPE II AGGREGATE BASE
2. CONSTRUCT 4' WIDE SIDEWALK PER CCAUSD NO. 234 (5" THICK W/ 5" TYPE II AGGREGATE BASE)
3. INSTALL MODIFIED ROLL TYPE CURB PER CCAUSD NO. 217.1
4. INSTALL 10' "L" TYPE CURB TO MODIFIED ROLL CURB TRANSITION PER DETAIL 29, SHEET D-3
5. CONSTRUCT SIDEWALK RAMPS USING ARMOR TILE TRUNCATED DOMES OR EQUIVALENT PER DETAIL 28, SHEET D-3
6. CONSTRUCT 8' CROSS GUTTER PER CCAUSD NO. 228
7. INSTALL 30" RCP STORM DRAIN PIPE
8. INSTALL 42" RCP STORM DRAIN PIPE
9. INSTALL 12.5' TYPE "CM2" DROP INLET PER CCAUSD NO. 412.1 AND STORM WATER QUALITY MANAGEMENT STAMP PER CCAUSD NO. 421
10. INSTALL 15' TYPE "CM2" DROP INLET WITH ALTERNATE CONNECTION PER CCAUSD NO. 412.1 AND STORM WATER QUALITY MANAGEMENT STAMP PER CCAUSD NO. 421
11. INSTALL 48" TYPE III SDMH CCAUSD NO. 401, 402 & 406
12. REMOVE EX 4.5'X6' NDOT TYPE 2A DROP INLET AND APRON
13. REMOVE AND REINSTALL 8" WIDE SIDEWALK PER CCAUSD NO. 234
14. INSTALL 10 STEPS @ 4.1"
15. INSTALL WROUGHT IRON MAN GATE
16. INSTALL WROUGHT FENCE PER CCAUSD NO. 425.51
17. INSTALL THROUGH WALL DRAIN BLOCK PER DETAIL 24. SHEET D-2
18. SAWCUT AND MATCH EXISTING IMPROVEMENTS (3" AC/6" TYPE I OR SCARIFY NATIVE) PER CCAUSD NO 500.2. EXISTING STRIPING TO BE REPLACED
19. INSTALL 18" RCP STORM DRAIN PIPE
20. INSTALL 36" RCP STORM DRAIN PIPE
21. INSTALL 5' TYPE "CM2" DROP INLET PER CCAUSD NO. 412.1 AND STORM WATER QUALITY MANAGEMENT STAMP PER CCAUSD NO. 421
22. INSTALL 10' TYPE "CM2" DROP INLET PER CCAUSD NO. 412.1 AND STORM WATER QUALITY MANAGEMENT STAMP PER CCAUSD NO. 421

SEE SHEET C-3 FOR LEGEND, ABBREVIATIONS, & QUANTITIES

GRADING NOTES

1. SEE SHEETS 16-19 FOR RETAINING WALL ELEVATIONS.
2. FINAL GRADES ADJACENT TO STRUCTURES SHALL BE IN CONFORMANCE WITH IBC 2012, SECTION 2304.11.2.2.
3. THE CONTRACTOR SHALL VERIFY ALL CONDITIONS AND DIMENSIONS AND REPORT ALL DISCREPANCIES TO THE ENGINEER.
4. ALL IMPROVEMENTS TO BE PROTECTED FROM EROSION BY SWPPP.
5. MAXIMUM/MINIMUM SLOPES AND MINIMUM STREET SECTIONS NOT TO EXCEED THAT SHOWN ON GEOTECH REPORT.
6. SEE DETAIL SHEET FOR STREET SECTIONS AND DETAILS.
7. ALL PUBLIC AND PRIVATE DRAINAGE IMPROVEMENTS TO BE BONDED FOR AND INSPECTED.
8. CONSTRUCTION OF BLOCK WALLS REQUIRES A SEPARATE BUILDING PERMIT AND APPROVAL BY THE CITY OF LAS VEGAS BUILDING DEPARTMENT.
9. CONTRACTOR TO VERIFY LOCATION AND ELEVATION OF EXISTING UTILITY STRUCTURES AND FACILITIES AND NOTIFY ENGINEER OF ANY DISCREPANCIES PRIOR TO CONSTRUCTION. CONTRACTOR TO PROTECT IN PLACE DURING CONSTRUCTION ENGINEER/OWNER SHALL BE NOTIFIED OF PRIOR DAMAGE TO EXISTING FACILITIES PRIOR TO CONSTRUCTION. CONTRACTOR WILL BE RESPONSIBLE FOR REPAIR/REPLEPING FACILITIES IF ENGINEER/OWNER IS NOT NOTIFIED OF EXISTING DAMAGE PRIOR TO CONSTRUCTION COMMENCING.
10. NO STRUCTURE, VEGETATION, OR OBJECTS OF ANY KIND IS PERMITTED OVER TWENTY-FOUR (24) INCHES IN HEIGHT (MEASURED FROM THE TOP OF THE ADJACENT CURB IF CURB EXIST) WITHIN THE SIGHT VISIBILITY ZONES.

FLOOD ZONE

THE PROJECT SITE IS LOCATED WITHIN A FEMA DESIGNATED ZONE X (UNSHADED) AS DEPICTED ON FLOOD INSURANCE RATE MAP (FIRM) PANEL 32003C2125E & 32003C2150E, DATED SEPTEMBER 27, 2002. A ZONE X (UNSHADED) IS DESCRIBED AS AN AREA DETERMINED TO BE OUTSIDE THE 0.2% ANNUAL CHANCE FLOOD PLAIN.

DISCLAIMER NOTE

1. EXISTING UTILITY LOCATIONS SHOWN HEREON ARE APPROXIMATE ONLY. IT SHALL BE THE CONTRACTOR'S RESPONSIBILITY TO DETERMINE THE EXACT VERTICAL AND HORIZONTAL LOCATION OF ALL EXISTING UNDERGROUND UTILITIES PRIOR TO COMMENCING CONSTRUCTION. NO REPRESENTATION IS MADE THAT ALL EXISTING UTILITIES ARE SHOWN HEREON. THE ENGINEER ASSUMES NO RESPONSIBILITY FOR UTILITIES NOT SHOWN IN THEIR PROPER LOCATION.
2. FOR ROADWAY WIDENING AND HALF STREET IMPROVEMENTS THE CONTRACTOR SHALL VERIFY CROSS SLOPES FROM EXISTING PAVEMENT SAWCUT LINE TO PROPOSED EDGE OF PAVEMENT OR PROJECTED LIP OF CURB PRIOR TO SUBGRADE PREPARATION AND CONSTRUCTION OF PROPOSED CURB LINE. IF MINIMUM OR MAXIMUM CROSS SLOPES DO NOT MEET AGENCY STANDARDS THE CONTRACTOR SHALL NOTIFY THE ENGINEER.

BENCHMARK

CITY OF LAS VEGAS BENCHMARK 7LV09 34SW6

RIVET AND ROUND PLATE IN THE TOP OF CURB AT THE SOUTHEAST CORNER OF DESERT MOON RD. AND SKY VISTA DR.
ELEVATION = 1011.422 METERS (NAVD '88)
ELEVATION = 3318.31 US SURVEY FEET (NAVD '88)

BASIS OF BEARINGS

NORTH 05°59'55" WEST, BEING THE BEARING OF THE WEST LINE OF SECTION 34, TOWNSHIP 20 SOUTH, RANGE 59 EAST, M.D.M., CITY OF LAS VEGAS, CLARK COUNTY, NEVADA, AS SHOWN BY MAP THEREOF ON FILE IN THE CLARK COUNTY, NEVADA RECORDER'S OFFICE IN BOOK 135, PAGE 71 OF PLATS.

FLOOD CERTIFICATION

I CERTIFY THAT THIS GRADING PLAN IS IN CONFORMANCE WITH THE APPROVED TECHNICAL DRAINAGE STUDY DS5039 ON FILE AT CITY OF LAS VEGAS FOR THE SUBJECT PROJECT.

TIMOTHY MULROONEY, P.E. 22938 — 5/8/19 DATE

FAST Call before you UnderGround 1-702-432-5300 FREEWAY & ARTERIAL SYSTEM OF TRANSPORTATION (F.A.S.T)

AVOID HITTING OVERHEAD POWER LINES. IT'S COSTLY. CALL BEFORE YOU DO OVERHEAD 1-702-227-2929

Call before you Dig. AVOID CUTTING UNDERGROUND UTILITY LINES. IT'S COSTLY. Call 811 OR 1-800-227-2600

SLATER HANIFAN GROUP
CONSULTING ENGINEERS & PLANNERS
5740 S. ARVILLE STREET #216, LAS VEGAS, NV 89118
PHONE (702) 284-5300 FAX (702) 284-5399

NO	DESCRIPTION	DATE	BY	APP	APP DATE
1	PER STAFF & DRAFT MAP REVISIONS UNIT 2	3/14/19	PM	MD	3/27/19
2	REVISE GRADING	5/8/19	MD		

LAS VEGAS, NV

KB HOME
BRISTLE VALE - UNIT 2
GRADING PLAN III

S 33
R 59E

DATE: 5/8/19
DRAFTER: OQ
DESIGNER: OQ
CHECKED: DSP

PROJECT NO.
KBH1804-000

PROFESSIONAL ENGINEER — TIMOTHY M. MULROONEY — Exp. 12/31/2019 — CIVIL — No. 22938 — STATE OF NEVADA — 5/8/19

G-3
SHEET 6 OF 29

L19-00527
107Y5102-2

J:\kbh1804-000 summerlin v24 parcel 18\dwg\improv\phase 2\kbh1804-000 grd p2.dwg 5/8/2019 3:10 PM Oscar Quiroz

SCALE – 1"=30' (0, 30, 60 FEET)

CALL SOUTHWEST GAS AT 702-651-2111 FOR STANDBY WHEN EXCAVATING OVER OR NEAR HIGH PRESSURE GAS LINES

SURVEY NOTE

OWNER RESPONSIBLE TO PROVIDE SURVEY MONUMENTATION AS SHOWN AND TO REPLACE ALL SURVEY MONUMENTATION DAMAGED, DISTURBED, DESTROYED, OR OBSCURED DURING CONSTRUCTION.

SOILS REPORT

SOILS REPORT BY SOUTHWEST GEOTECHNICAL
PROJECT NO. 182267 DATED 7/12/18

EARTHWORKS

EARTHWORK QUANTITIES (RAW):
CUT= 23,900 CU YDS
FILL= 51,700 CU YDS

EXPORTED MATERIAL TO BE DISPOSED OF AT AN APPROVED LICENSED DISPOSAL FACILITY OR AT A SITE WITH AN APPROVED AND ACTIVE GRADING PERMIT.

DRAINAGE IMPROVEMENT QUANTITIES

1.	48" TYPE III STORM DRAIN MANHOLE	EA	7
2.	24" RCP STORM DRAIN	LF	35
3.	30" RCP STORM DRAIN	LF	30
4.	42" RCP STORM DRAIN	LF	72
5.	5' TYPE "CM2" DROP INLET	EA	2
6.	10' TYPE "CM2" DROP INLET	EA	1
7.	12.5' TYPE "CM2" DROP INLET	EA	2
8.	15' TYPE "CM2" DROP INLET	EA	1
9.	8' WIDE CONCRETE VALLEY GUTTER	EA	2
10.	REMOVE 5'x2' NDOT TYPE 2A DROP INLET	EA	1

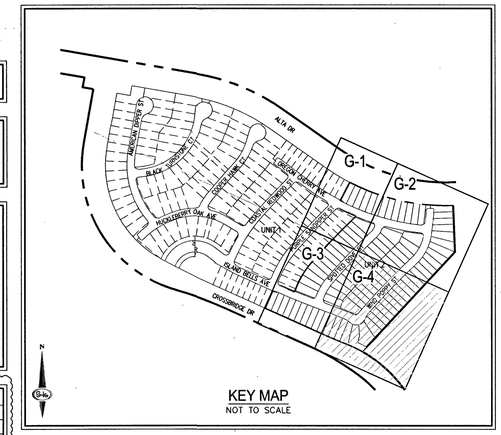

KEY MAP
NOT TO SCALE

LEGAL DESCRIPTION

LYING WITHIN THE NORTH EAST QUARTER (NE1/4) OF SECTION 33, TOWNSHIP 20 SOUTH, RANGE 59 EAST M.D.M., CITY OF LAS VEGAS, CLARK COUNTY, NEVADA.

EASEMENT NOTES

1. ALL PRIVATE STREETS ARE P.U.E., PUBLIC SEWER EASEMENTS AND PUBLIC DRAINAGE EASEMENTS TO BE PRIVATELY MAINTAINED BY HOA.
2. ALL COMMON ELEMENTS ARE PUBLIC DRAINAGE EASEMENTS TO BE PRIVATELY MAINTAINED BY HOA.

CONSTRUCTION NOTES

1. INSTALL 2" ASPHALT PAVEMENT OVER 4" TYPE II AGGREGATE BASE
2. CONSTRUCT 4' WIDE SIDEWALK PER CCAUSD NO. 234 (5" THICK W/ 5" TYPE II AGGREGATE BASE)
3. INSTALL MODIFIED ROLL TYPE CURB PER CCAUSD NO. 217.1
4. INSTALL 10' "L" TYPE CURB TO MODIFIED ROLL CURB TRANSITION PER DETAIL 29, SHEET D-3
5. CONSTRUCT SIDEWALK RAMPS USING ARMOR TILE TRUNCATED DOMES OR EQUIVALENT PER DETAIL 28, SHEET D-3
6. CONSTRUCT 8' CROSS GUTTER PER CCAUSD NO. 228
7. INSTALL 30" RCP STORM DRAIN PIPE
8. INSTALL 42" RCP STORM DRAIN PIPE
9. INSTALL 12.5' TYPE "CM2" DROP INLET PER CCAUSD NO. 412.1 AND STORM WATER QUALITY MANAGEMENT STAMP PER CCAUSD NO. 421
10. INSTALL 15' TYPE "CM2" DROP INLET WITH ALTERNATE CONNECTION PER CCAUSD NO. 412.1 AND STORM WATER QUALITY MANAGEMENT STAMP PER CCAUSD NO. 421
11. INSTALL 48" TYPE III SDMH CCAUSD NO. 401, 402 & 406
12. REMOVE EX 4.5'X6' NDOT TYPE 2A DROP INLET AND APRON
13. REMOVE AND REINSTALL 8" WIDE SIDEWALK PER CCAUSD NO. 234
14. INSTALL 10 STEPS @ 4.1"
15. INSTALL WROUGHT IRON MAN GATE
16. INSTALL WROUGHT FENCE PER CCAUSD NO. 425.S1
17. INSTALL THROUGH WALL DRAIN BLOCK PER DETAIL 24, SHEET D-2
18. SAWCUT AND MATCH EXISTING IMPROVEMENTS (3" AC/6" TYPE I OR SCARIFY NATIVE) PER CCAUSD NO 500.2. EXISTING STRIPING TO BE REPLACED
19. INSTALL 18" RCP STORM DRAIN PIPE
20. INSTALL 36" RCP STORM DRAIN PIPE
21. INSTALL 5' TYPE "CM2" DROP INLET PER CCAUSD NO. 412.1 AND STORM WATER QUALITY MANAGEMENT STAMP PER CCAUSD NO. 421
22. INSTALL 10' TYPE "CM2" DROP INLET PER CCAUSD NO. 412.1 AND STORM WATER QUALITY MANAGEMENT STAMP PER CCAUSD NO. 421

SEE SHEET C-3 FOR LEGEND, ABBREVIATIONS, & QUANTITIES

GRADING NOTES

1. SEE SHEETS 16-19 FOR RETAINING WALL ELEVATIONS.
2. FINAL GRADES ADJACENT TO STRUCTURES SHALL BE IN CONFORMANCE WITH IBC 2012, SECTION 2304.11.2.2.
3. THE CONTRACTOR SHALL VERIFY ALL CONDITIONS AND DIMENSIONS AND REPORT ALL DISCREPANCIES TO THE ENGINEER.
4. ALL IMPROVEMENTS TO BE PROTECTED FROM EROSION BY SWPPP.
5. MAXIMUM/MINIMUM SLOPES AND MINIMUM STREET SECTIONS NOT TO EXCEED THAT SHOWN ON GEOTECH REPORT.
6. SEE DETAIL SHEET FOR STREET SECTIONS AND DETAILS.
7. ALL PUBLIC AND PRIVATE DRAINAGE IMPROVEMENTS TO BE BONDED FOR AND INSPECTED.
8. CONSTRUCTION OF BLOCK WALLS REQUIRES A SEPARATE BUILDING PERMIT AND APPROVAL BY THE CITY OF LAS VEGAS BUILDING DEPARTMENT.
9. CONTRACTOR TO VERIFY LOCATION AND ELEVATION OF EXISTING UTILITY STRUCTURES AND FACILITIES AND NOTIFY ENGINEER OF ANY DISCREPANCIES PRIOR TO CONSTRUCTION. CONTRACTOR TO PROTECT IN PLACE DURING CONSTRUCTION ENGINEER/OWNER SHALL BE NOTIFIED OF PRIOR DAMAGE TO EXISTING FACILITIES PRIOR TO CONSTRUCTION. CONTRACTOR WILL BE RESPONSIBLE FOR REPAIR/REPLEPING FACILITIES IF ENGINEER/OWNER IS NOT NOTIFIED OF EXISTING DAMAGE PRIOR TO CONSTRUCTION COMMENCING.
10. NO STRUCTURE, VEGETATION, OR OBJECTS OF ANY KIND IS PERMITTED OVER TWENTY-FOUR (24) INCHES IN HEIGHT (MEASURED FROM THE TOP OF THE ADJACENT CURB IF CURB EXIST) WITHIN THE SIGHT VISIBILITY ZONES.

FLOOD ZONE

THE PROJECT SITE IS LOCATED WITHIN A FEMA DESIGNATED ZONE X (UNSHADED) AS DEPICTED ON FLOOD INSURANCE RATE MAP (FIRM) PANEL 320032C2125E & 320032C2150E, DATED SEPTEMBER 27, 2002. A ZONE X (UNSHADED) IS DESCRIBED AS AN AREA DETERMINED TO BE OUTSIDE THE 0.2% ANNUAL CHANCE FLOOD PLAIN.

DISCLAIMER NOTE

1. EXISTING UTILITY LOCATIONS SHOWN HEREON ARE APPROXIMATE ONLY. IT SHALL BE THE CONTRACTOR'S RESPONSIBILITY TO DETERMINE THE EXACT VERTICAL AND HORIZONTAL LOCATION OF ALL EXISTING UNDERGROUND UTILITIES PRIOR TO COMMENCING CONSTRUCTION. NO REPRESENTATION IS MADE THAT ALL EXISTING UTILITIES ARE SHOWN HEREON. THE ENGINEER ASSUMES NO RESPONSIBILITY FOR UTILITIES NOT SHOWN IN THEIR PROPER LOCATION.
2. FOR ROADWAY WIDENING AND HALF STREET IMPROVEMENTS THE CONTRACTOR SHALL VERIFY CROSS SLOPES FROM EXISTING PAVEMENT SAWCUT LINE TO PROPOSED EDGE OF PAVEMENT OR PROJECTED LIP OF CURB PRIOR TO SUBGRADE PREPARATION AND CONSTRUCTION OF PROPOSED CURB LINE. IF MINIMUM OR MAXIMUM CROSS SLOPES DO NOT MEET AGENCY STANDARDS THE CONTRACTOR SHALL NOTIFY THE ENGINEER.

BENCHMARK

CITY OF LAS VEGAS BENCHMARK 7LV09 345W6

RIVET AND ROUND PLATE IN THE TOP OF CURB AT THE SOUTHEAST CORNER OF DESERT MOON RD. AND SKY VISTA DR.
ELEVATION = 1011.422 METERS (NAVD '88)
ELEVATION = 3318.31 US SURVEY FEET (NAVD '88)

BASIS OF BEARINGS

NORTH 05°59'55" WEST, BEING THE BEARING OF THE WEST LINE OF SECTION 34, TOWNSHIP 20 SOUTH, RANGE 59 EAST, M.D.M., CITY OF LAS VEGAS, CLARK COUNTY, NEVADA, AS SHOWN BY MAP THEREOF ON FILE IN THE CLARK COUNTY, NEVADA RECORDER'S OFFICE IN BOOK 135, PAGE 71 OF PLATS.

FLOOD CERTIFICATION

I CERTIFY THAT THIS GRADING PLAN IS IN CONFORMANCE WITH THE APPROVED TECHNICAL DRAINAGE STUDY DS5039 ON FILE AT CITY OF LAS VEGAS FOR THE SUBJECT PROJECT.

TIM MULROONEY, P.E. 22938 — 9/11/19 DATE

FAST
Call before you UnderGround
1-702-432-5300
FREEWAY & ARTERIAL SYSTEM OF TRANSPORTATION (F.A.S.T)

AVOID HITTING OVERHEAD POWER LINES. IT'S COSTLY.
CALL BEFORE YOU DO OVERHEAD
1-702-227-2929

Call before you Dig
AVOID CUTTING UNDERGROUND UTILITY LINES. IT'S COSTLY.
Call 811
OR
1-800-227-2600

SLATER HANIFAN GROUP
CONSULTING ENGINEERS & PLANNERS
5740 S. ARVILLE STREET #216, LAS VEGAS, NV 89118
PHONE (702) 284-5300 FAX (702) 284-5399

NO.	DESCRIPTION	DATE	BY	APP.
1	REV. STORM DRAIN & RETAINING WALLS	07/17/19	PA	TMM

LAS VEGAS, NV

KB HOME
BRISTLE VALE - UNIT 2
GRADING PLAN IV

S:23 R:59E

DATE: 5/8/19
DRAFTER: OQ
DESIGNER: OQ
CHECKED: DSP

PROJECT NO.
KBH1804-000

PROFESSIONAL ENGINEER — STATE OF NEVADA — TIMOTHY M. MULROONEY — Exp. 12/31/2019 — CIVIL — No. 22938 — 9/11/19

G-4
SHEET 7 OF 29

L19-00527
107Y5102-2

J:\Kbh1804-000 summerlin v24 parcel l&m\dwg\improv\phase 2\kbh1804-000 grd p2.dwg 9/11/2019 12:22 PM Oscar Quiroz

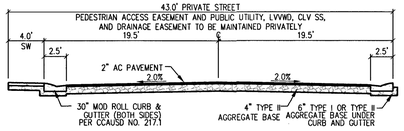

A. PRIVATE STREET SECTION

NOT TO SCALE

INTERIOR STREETS

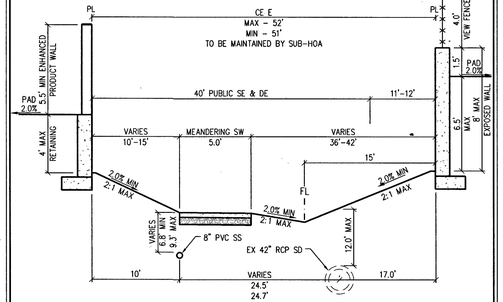

THIS DETAIL IS FOR REFERENCE ONLY AND DOES NOT CONSTITUTE A STRUCTURAL DESIGN

4. WALL SECTION

NOT TO SCALE

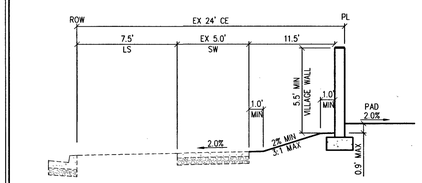

THIS DETAIL IS FOR REFERENCE ONLY AND DOES NOT CONSTITUTE A STRUCTURAL DESIGN

8. WALL SECTION

NOT TO SCALE

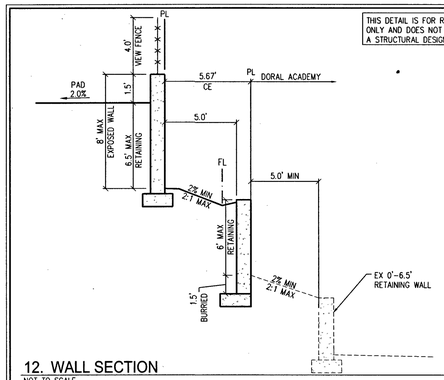

THIS DETAIL IS FOR REFERENCE ONLY AND DOES NOT CONSTITUTE A STRUCTURAL DESIGN

12. WALL SECTION

NOT TO SCALE

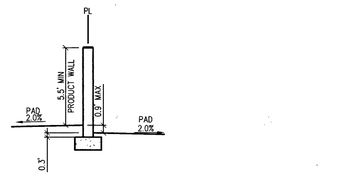

THIS DETAIL IS FOR REFERENCE ONLY AND DOES NOT CONSTITUTE A STRUCTURAL DESIGN

1. WALL SECTION

NOT TO SCALE

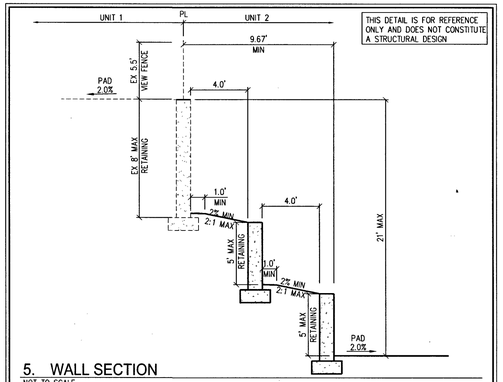

THIS DETAIL IS FOR REFERENCE ONLY AND DOES NOT CONSTITUTE A STRUCTURAL DESIGN

5. WALL SECTION

NOT TO SCALE

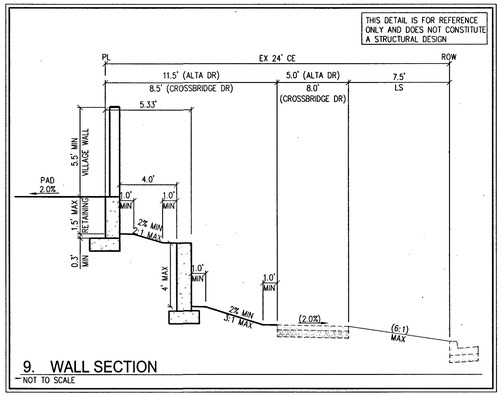

THIS DETAIL IS FOR REFERENCE ONLY AND DOES NOT CONSTITUTE A STRUCTURAL DESIGN

9. WALL SECTION

NOT TO SCALE

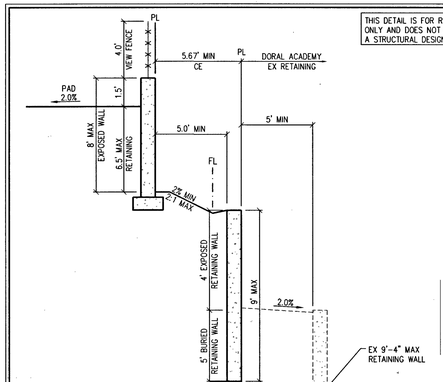

THIS DETAIL IS FOR REFERENCE ONLY AND DOES NOT CONSTITUTE A STRUCTURAL DESIGN

13. WALL SECTION

NOT TO SCALE

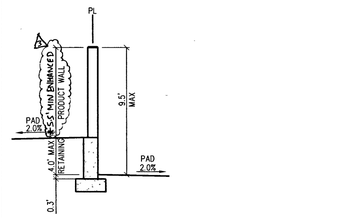

THIS DETAIL IS FOR REFERENCE ONLY AND DOES NOT CONSTITUTE A STRUCTURAL DESIGN

2. WALL SECTION

NOT TO SCALE

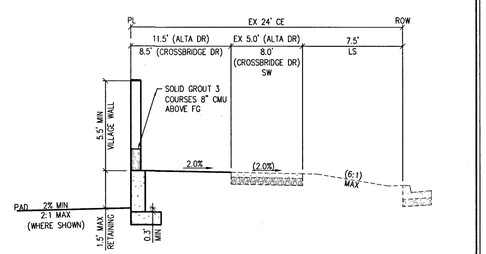

THIS DETAIL IS FOR REFERENCE ONLY AND DOES NOT CONSTITUTE A STRUCTURAL DESIGN

6. WALL SECTION

NOT TO SCALE

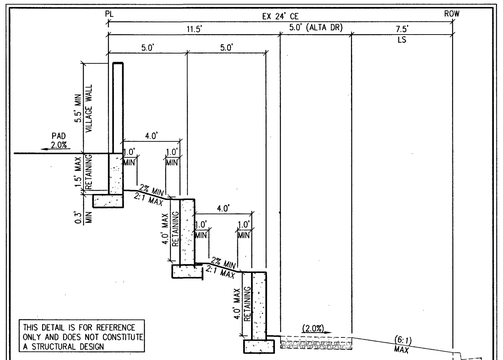

THIS DETAIL IS FOR REFERENCE ONLY AND DOES NOT CONSTITUTE A STRUCTURAL DESIGN

10. WALL SECTION

NOT TO SCALE

NOTE

*5.5' SCREEN WALL TO BE CONSTRUCTED FROM REAR OF LOT TO SIDE RETURN WALL. WHERE THE RETAINING WALL CONTINUES PAST THE RETURN WALL AND IS RETAINING 30"(2.5') OR MORE IN HEIGHT, 42"(3.5') HIGH WROUGHT IRON FENCE IS REQUIRED TO BE INSTALLED FOR FALL PROTECTION

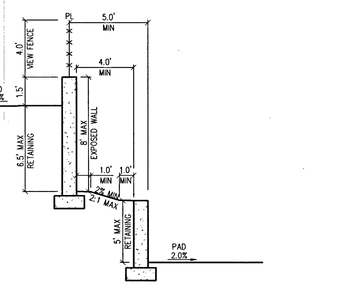

THIS DETAIL IS FOR REFERENCE ONLY AND DOES NOT CONSTITUTE A STRUCTURAL DESIGN

3. WALL SECTION

NOT TO SCALE

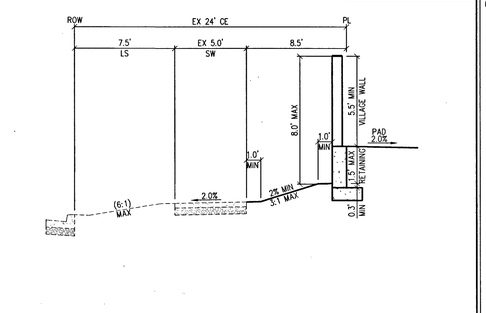

THIS DETAIL IS FOR REFERENCE ONLY AND DOES NOT CONSTITUTE A STRUCTURAL DESIGN

7. WALL SECTION

NOT TO SCALE

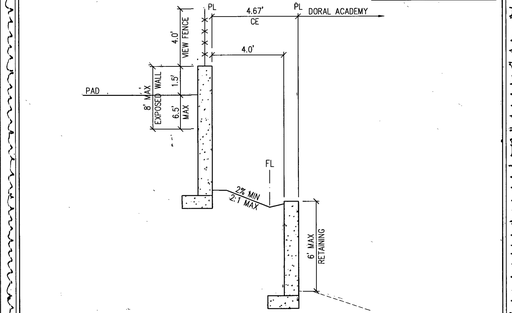

THIS DETAIL IS FOR REFERENCE ONLY AND DOES NOT CONSTITUTE A STRUCTURAL DESIGN

11. WALL SECTION

NOT TO SCALE

SLATER HANIFAN GROUP
CONSULTING ENGINEERS & PLANNERS
5740 S. ARVILLE STREET #216, LAS VEGAS, NV 89118
PHONE (702) 284-5300 FAX (702) 284-5399

NO.	DESCRIPTION	DATE	BY	APP.	APP. DATE
2	UPDATE WALL DETAIL	10/24/19	MK	PA	10/24/19
1	ADD NOTE FOR FALL PROTECTION	05/04/20	PA		

LAS VEGAS, NV

KB HOME

BRISTLE VALE - UNIT 2

DETAIL SHEET I

S33 T 20S R 59E

DATE: 5/8/19

DRAFTER: OQ

DESIGNER: OQ

CHECKED: DSP

PROJECT NO.
KBH1804-000

D-1

SHEET 8 OF 29

L19-00527
107Y5102-2

E:\kbh1804-000 summerlin v24 parcel 18m\dwg\improv\phase 2\kbh1804-000 dtl e2.dwg 5/8/2019 3:10 PM Oscar Quiroz

THIS DETAIL IS FOR REFERENCE ONLY AND DOES NOT CONSTITUTE A STRUCTURAL DESIGN

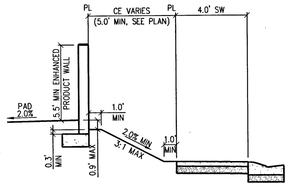

14. WALL SECTION
NOT TO SCALE

THIS DETAIL IS FOR REFERENCE ONLY AND DOES NOT CONSTITUTE A STRUCTURAL DESIGN

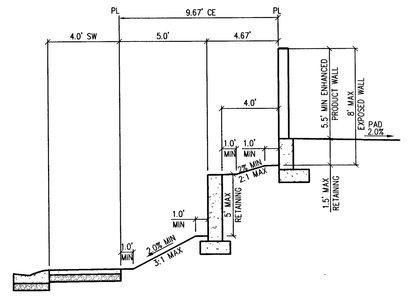

18. WALL SECTION
NOT TO SCALE

THIS DETAIL IS FOR REFERENCE ONLY AND DOES NOT CONSTITUTE A STRUCTURAL DESIGN

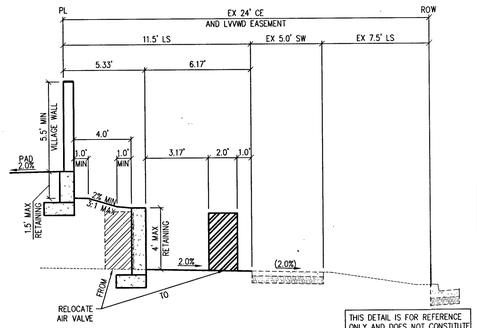

22. WALL SECTION & AIR VALVE RELOCATION
NOT TO SCALE

THIS DETAIL IS FOR REFERENCE ONLY AND DOES NOT CONSTITUTE A STRUCTURAL DESIGN

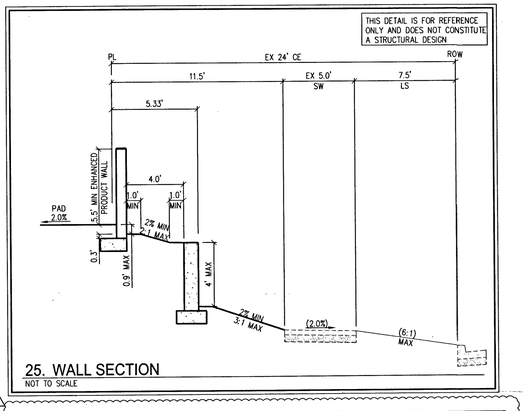

25. WALL SECTION
NOT TO SCALE

THIS DETAIL IS FOR REFERENCE ONLY AND DOES NOT CONSTITUTE A STRUCTURAL DESIGN

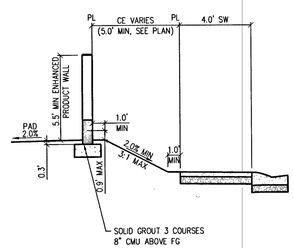

15. WALL SECTION
NOT TO SCALE

THIS DETAIL IS FOR REFERENCE ONLY AND DOES NOT CONSTITUTE A STRUCTURAL DESIGN

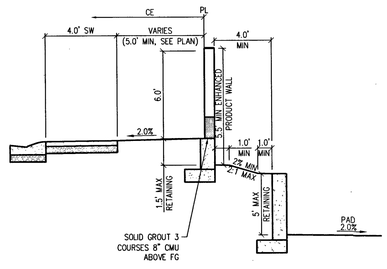

19. WALL SECTION
NOT TO SCALE

THIS DETAIL IS FOR REFERENCE ONLY AND DOES NOT CONSTITUTE A STRUCTURAL DESIGN

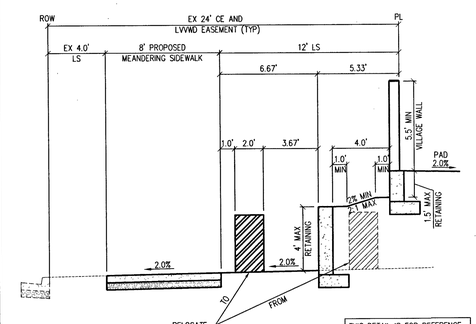

23. AIR VALVE RELOCATION
NOT TO SCALE

THIS DETAIL IS FOR REFERENCE ONLY AND DOES NOT CONSTITUTE A STRUCTURAL DESIGN

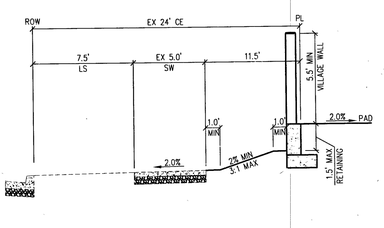

26. WALL SECTION
NOT TO SCALE

THIS DETAIL IS FOR REFERENCE ONLY AND DOES NOT CONSTITUTE A STRUCTURAL DESIGN

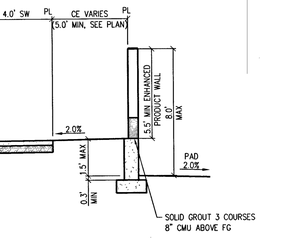

17. WALL SECTION
NOT TO SCALE

THIS DETAIL IS FOR REFERENCE ONLY AND DOES NOT CONSTITUTE A STRUCTURAL DESIGN

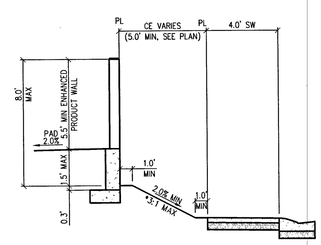

16. WALL SECTION
NOT TO SCALE

*2%-3% MAX IN LVVWD EASEMENT

THIS DETAIL IS FOR REFERENCE ONLY AND DOES NOT CONSTITUTE A STRUCTURAL DESIGN

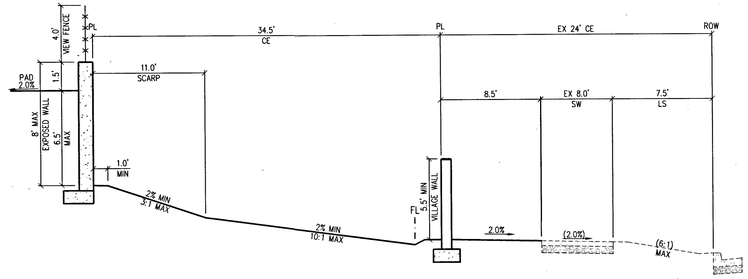

20. WALL SECTION
NOT TO SCALE

THIS DETAIL IS FOR REFERENCE ONLY AND DOES NOT CONSTITUTE A STRUCTURAL DESIGN

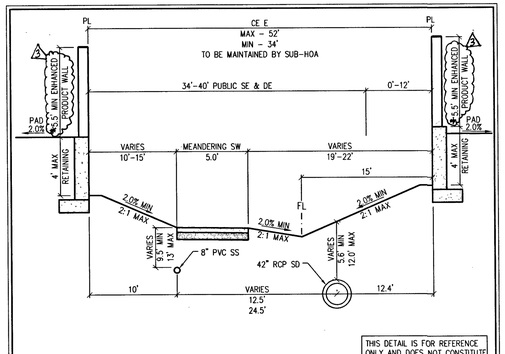

21. WALL SECTION
NOT TO SCALE

THIS DETAIL IS FOR REFERENCE ONLY AND DOES NOT CONSTITUTE A STRUCTURAL DESIGN

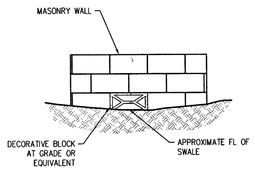

24. THROUGH WALL DRAIN
NOT TO SCALE

NOTE
*5.5' SCREEN WALL TO BE CONSTRUCTED FROM REAR OF LOT TO SIDE RETURN WALL. WHERE THE RETAINING WALL CONTINUES PAST THE RETURN WALL AND IS RETAINING 30"(2.5') OR MORE IN HEIGHT, 42"(3.5') HIGH WROUGHT IRON FENCE IS REQUIRED TO BE INSTALLED FOR FALL PROTECTION

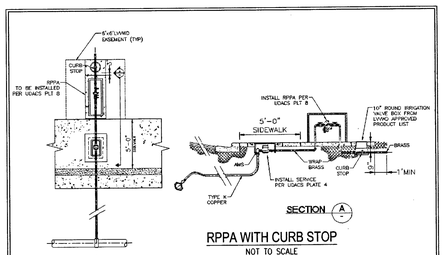

RPPA WITH CURB STOP
NOT TO SCALE

APPROVED FOR CONSTRUCTION

LAS VEGAS VALLEY WATER DISTRICT ENGINEERING SERVICES

PROJECT NO.: 136382 FIRST APPROVED DATE: 5/13/19

AVOID HITTING OVERHEAD POWER LINES. IT'S COSTLY.
CALL BEFORE YOU DO OVERHEAD
1-702-227-2929

FAST
Call before you UnderGround
1-702-432-5300
FREEWAY & ARTERIAL SYSTEM OF TRANSPORTATION (F.A.S.T)

Call before you Dig
AVOID CUTTING UNDERGROUND UTILITY LINES. IT'S COSTLY.
Call 811
OR
1-800-227-2600

NOTE
1. ALL CONSTRUCTION SHALL CONFORM TO THE LATEST EDITION OF THE UNIFORM STANDARD SPECIFICATIONS FOR CONSTRUCTION OF WATER AND WASTEWATER FACILITIES AND THE UNIFORM STANDARD DRAWINGS FOR PUBLIC WORKS CONSTRUCTION OFF-SITE IMPROVEMENTS FOR CLARK COUNTY, NEVADA AND INCORPORATED CITIES.
2. ALL CONSTRUCTION SHALL CONFORM TO THE LATEST EDITION OF THE UNIFORM STANDARD SPECIFICATIONS FOR CONSTRUCTION OF WATER AND WASTEWATER FACILITIES AND THE UNIFORM STANDARD DRAWINGS FOR PUBLIC WORKS CONSTRUCTION OFF-SITE IMPROVEMENTS FOR CLARK COUNTY, NEVADA AND INCORPORATED CITIES.

TIMOTHY M. MULROONEY
Exp. 12/31/2019
CIVIL
No. 22938
5/8/19

TIMOTHY M. MULROONEY
Exp. 12/31/19
CIVIL
No. 22938
5/6/20

SLATER HANIFAN GROUP
CONSULTING ENGINEERS & PLANNERS
5740 S. ARVILLE STREET #216, LAS VEGAS, NV 89118
PHONE (702) 284-5300 FAX (702) 284-5399

NO.	DESCRIPTION	DATE	BY	APP	APP DATE
1	ADD DETAIL NO. 26	5/13/19	DM	DM	5/13/19
2	ADD NOTE FOR FALL PROTECTION	5/6/19	DM	DM	5/6/19

LAS VEGAS, NV

KB HOME
BRISTLE VALE - UNIT 2
DETAIL SHEET II

S 33
T 20S
R 59E

DATE: 5/8/19
DRAFTER: OQ
DESIGNER: OQ
CHECKED: DSP
PROJECT NO.
KBH1804-000

D-2
SHEET 9 OF 29

L19-00527
107YS102-2

PRO.#:136382A QS:137-33-NE

J:\KBH1804-000 summerlin #24 parcel 18m\civil\mmcs\phase 2\kbh1804-000 d11 e2.dwg 5/8/2019 3:11 PM Oscar Quiroz

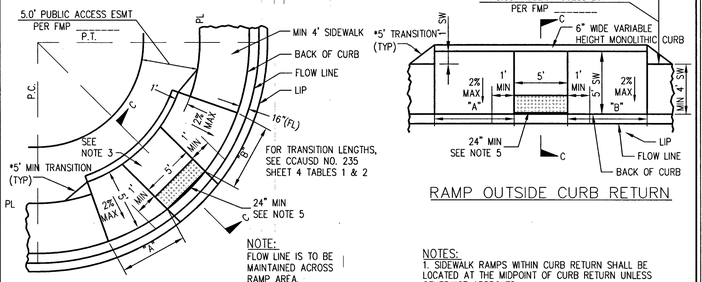

FOR TRANSITION LENGTHS, SEE CCAUSD NO. 235 SHEET 4 TABLES 1 & 2

RAMP IN CURB RETURN

NOTE:
FLOW LINE IS TO BE MAINTAINED ACROSS RAMP AREA.

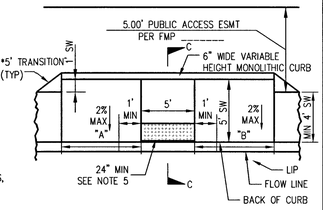

RAMP OUTSIDE CURB RETURN

NOTES:
1. SIDEWALK RAMPS WITHIN CURB RETURN SHALL BE LOCATED AT THE MIDPOINT OF CURB RETURN UNLESS OTHERWISE APPROVED.

2. SIDEWALK RAMPS OUTSIDE OF THE CURB RETURN SHALL BE LOCATED ADJACENT TO THE RETURN UNLESS OTHERWISE APPROVED.

3. RAMPS SHALL BE CONSTRUCTED WITH A ROUGH BROOM FINISH TRANSVERSE TO THE SLOPE OF THE RAMP.

4. WHEN CONSTRUCTING RAMP WHERE CURB & GUTTER EXISTS, COMPLETELY REMOVE INTERFERING PORTIONS OF EXISTING CURB & GUTTER.

5. DETECTABLE WARNING CONSISTING OF RAISED TRUNCATED DOMES WHICH COMPLY WITH DETAILS ON SHEET 4 OF CCAUSD NO. 235 AND CONTRASTING VISUALLY WITH ADJOINING SURFACES SHALL BE PLACED ON BOTTOM PORTION OF RAMP EXTENDING THE FULL WIDTH OF THE RAMP AND EXTENDING A MINIMUM DISTANCE OF 24 INCHES UP THE RAMP. COLOR SHALL BE "FEDERAL YELLOW" UNLESS OTHERWISE APPROVED.

6. A 5' PAD AT 2% MAX SLOPE SHALL BE PROVIDED ON THE DOWNHILL SIDE WHEN STREET SLOPE EXCEEDS 2% SLOPE.

7. "A" AND "B" ARE EQUAL TO 8' WHEN FLOWLINE GRADES IS BETWEEN -2% AND +2% FOR ALL OTHER TRANSITION LENGTHS, SEE CCAUSD NO. 235 SHEET 4 TABLE 1.

8. ALL CURB FLOW LINES SHALL BE WATER TESTED. ANY CURB THAT DOES NOT FLOW SHALL BE REMOVED AND REPLACED AS DIRECTED BY AGENCY AT THE SOLE EXPENSE OF THE CONTRACTOR.

* TRANSITION ONLY WHEN LESS THAN 5' WIDE SIDEWALK

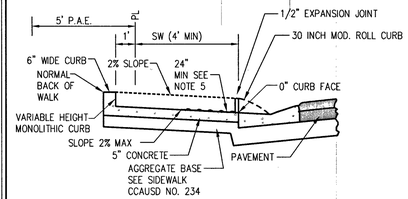

SECTION C-C

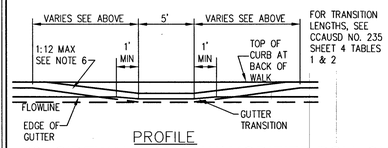

FOR TRANSITION LENGTHS, SEE CCAUSD NO. 235 SHEET 4 TABLES 1 & 2

PROFILE

28. SIDEWALK RAMP W/ MODIFIED ROLL CURB

NOT TO SCALE

NOT TO SCALE

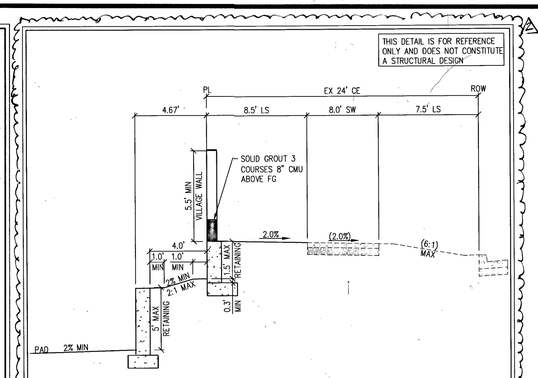

30. WALL SECTION

NOT TO SCALE

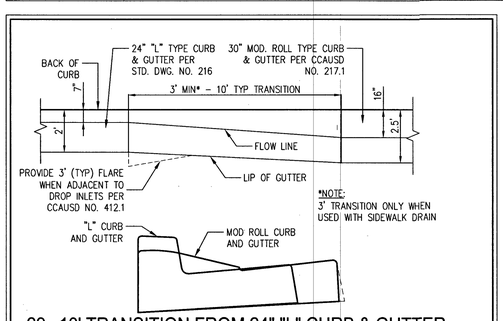

29. 10' TRANSITION FROM 24" "L" CURB & GUTTER TO MODIFIED 30" ROLL CURB & GUTTER

NOT TO SCALE

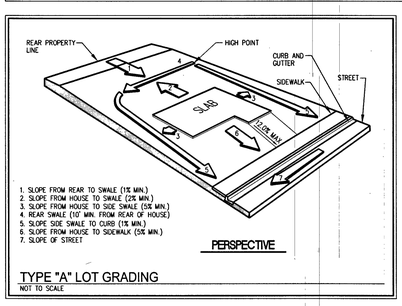

PERSPECTIVE

TYPE "A" LOT GRADING

NOT TO SCALE

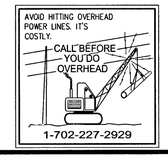

SLATER HANIFAN GROUP
CONSULTING ENGINEERS & PLANNERS
5740 S. ARVILLE STREET #216, LAS VEGAS, NV 89118
PHONE (702) 284-5300 FAX (702) 284-5399

NO.	DESCRIPTION	DATE	BY	APP.	APP. DATE
1	ADD WALL SECTION DETAIL	11/21/19	MG	DSP	11/21/19

LAS VEGAS, NV

KB HOME

BRISTLE VALE - UNIT 2

DETAIL SHEET III

S33 T20S R59E

DATE: 5/8/19

DRAFTER: OQ

DESIGNER: OQ

CHECKED: DSP

PROJECT NO.
KBH1804-000

PROFESSIONAL ENGINEER STATE OF NEVADA
TIMOTHY M. MULROONEY
Exp. 12/31/2019
CIVIL
No. 22938
5/8/19

D-3

SHEET 10 OF 29

L19-00527
107Y5102-2

J:\Kbh1804-000 summerlin v24 parcel 6\m\dwg\mmrcv\phase 2\kbh1804-000 dtl p2.dwg 5/8/2019 3:11 PM Oscar Quiroz

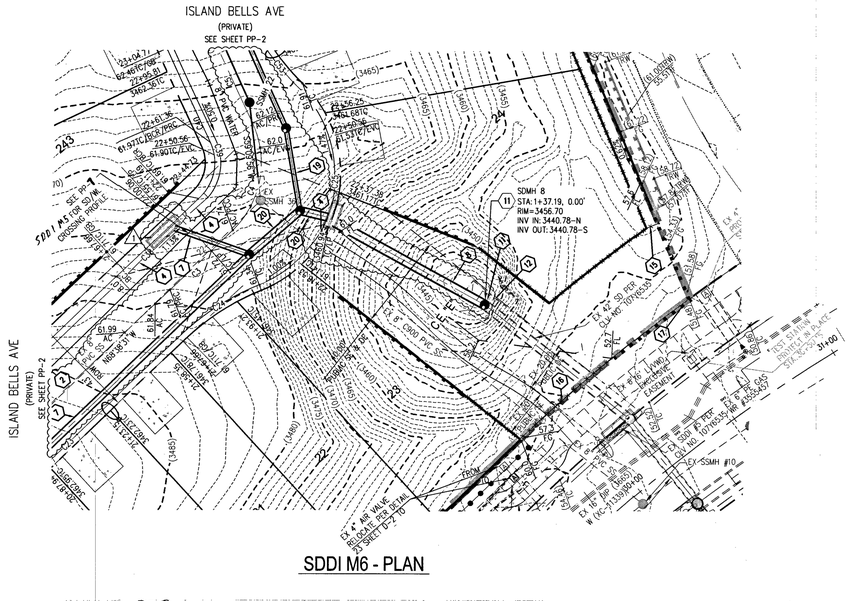
ISLAND BELLS AVE
(PRIVATE)
SEE SHEET PP-2
SDDI M6 - PLAN
SEE SHEET PP-1 FOR SD/MH CROSSING PROFILE
SDMH 8
STA:1+37.19, 0.00'
RIM=3456.70
INV IN: 3440.78-N
INV OUT: 3440.78-S
SDDI M6
STA:0+63.55, 21'L
RIM=3452.68
INV IN: 3450.68-SW
INV IN: 3451.19-NW
INV OUT: 3451.47-S
SDMH 9
STA:0+50.00, 0.00'
RIM=3461.06
INV IN: 3452.37-NE
INV IN: 3452.47-SW
INV OUT: 3451.47-S
STA:0+19.85
RIM=3461.70
INV IN: 3447.89-NE
INV IN: 3447.69-W
INV OUT: 3447.69-S
EX. 77.50 LF 42" RCP CLASS III SD @ S=0.40% (PUBLIC) Q100=85.500 CFS
EX. 42" SD PER CLARK COUNTY PROJECT NO. 107HS035
EX. 8" GRAV SS
EX. 4" AIR VALVE PER LOCATION DETAIL ON SHEET PP-2
EX. 16" AIR RELEASE
EX. 16" GATE VALVE
W (IC-713/80/249)

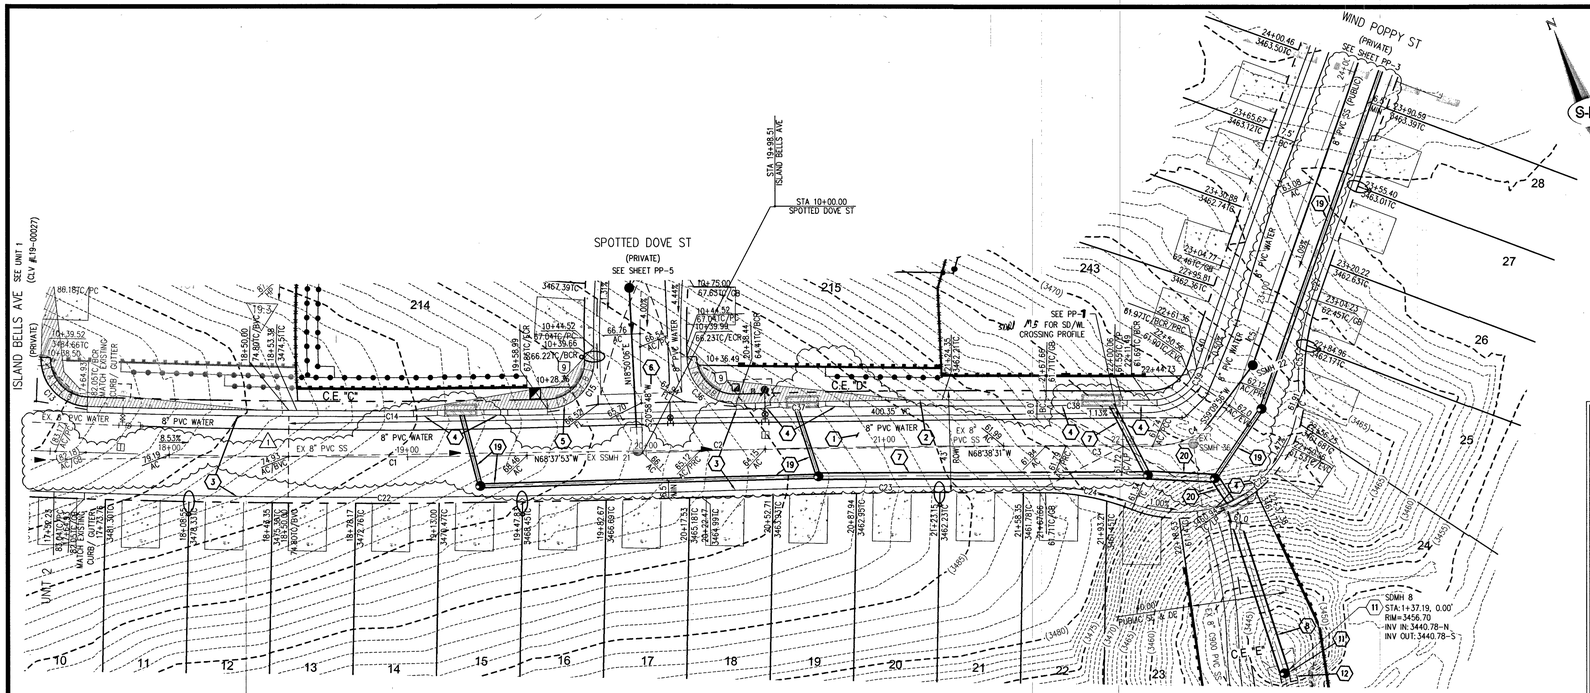

ISLAND BELLS AVE - PLAN
(PRIVATE)

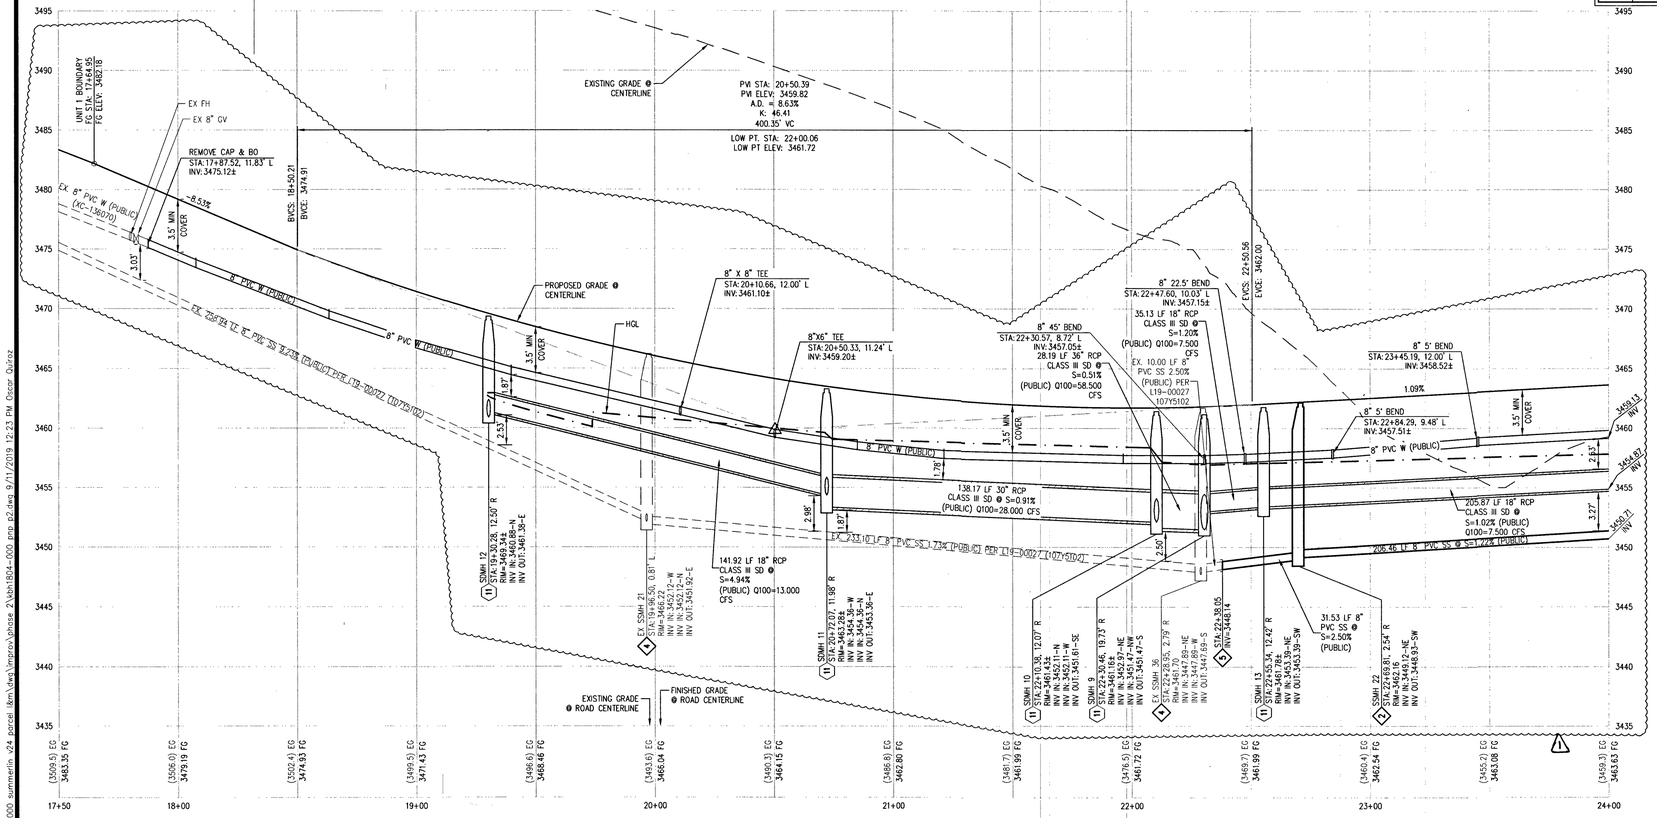

ISLAND BELLS AVE - PROFILE
HORIZ: 1" = 30'
VERT: 1" = 6'

CURVE TABLE				
CURVE	LENGTH	RADIUS	DELTA	TANGENT
C1	257.52'	3750.00'	3°56'05"	128.81'
C2	153.64'	3500.00'	2°30'54"	76.83'
C3	36.39'	1846.50'	1°07'45"	18.20'
C4	48.87'	39.50'	70°52'53"	28.11'
C5	431.08'	3805.00'	6°29'29"	215.77'
C13	31.48'	20.00'	90°11'39"	20.07'
C14	193.04'	3730.50'	2°57'54"	96.54'
C22	271.65'	3769.50'	4°07'44"	135.88'
C23	144.38'	3480.50'	2°22'37"	72.20'
C24	37.15'	100.00'	21°17'10"	18.79'
C25	105.23'	53.00'	113°45'42"	81.24'
C27	386.23'	3785.50'	5°50'45"	193.28'
C37	138.43'	3519.50'	2°15'13"	69.23'
C38	36.01'	1827.00'	1°07'45"	18.00'
C39	24.74'	20.00'	70°52'53"	14.23'
C40	433.29'	3824.50'	6°29'29"	216.88'
C53	37.09'	100.00'	21°14'55"	18.76'

SCALE - 1"=30' FEET

CALL SOUTHWEST GAS AT 702-651-2111 FOR STANDBY WHEN EXCAVATING OVER OR NEAR HIGH PRESSURE GAS LINES

RAMP TRANSITION LENGTHS FOR 1:12 SIDE SLOPES			
CASE NO.	GRADE % "B" TO "A"	"A" MIN.	"B" MIN.
1	-6 TO -5.01	4.5'	21.5'
2	-5 TO -4.01	4.5'	15.0'
3	-4 TO -3.01	4.5'	12.0'
4	-3 TO -2.01	4.5'	9.5'
5	-2 TO 2	8.0'	8.0'
6	2.01 TO 3	9.5'	4.5'
7	3.01 TO 4	12.0'	4.5'
8	4.01 TO 5	15.0'	4.5'
9	5.01 TO 6	21.5'	4.5'

SIDEWALK RAMPS USING AMOR TILE TRUNCATED DOMES OR EQUIVALENT PER CCAUSD NO. 235, CASE I

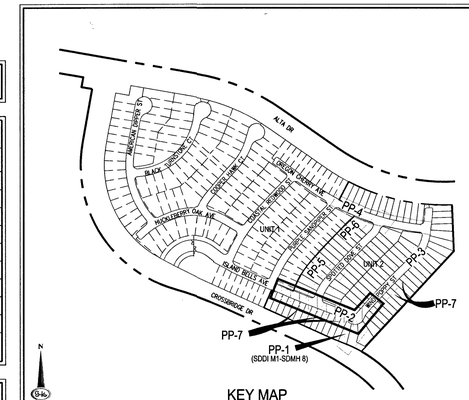

KEY MAP
NOT TO SCALE

LEGAL DESCRIPTION

LYING WITHIN THE NORTH EAST QUARTER (NE1/4) OF SECTION 33, TOWNSHIP 20 SOUTH, RANGE 59 EAST M.D.M., CITY OF LAS VEGAS, CLARK COUNTY, NEVADA.

EASEMENT NOTES

1. ALL PRIVATE STREETS ARE P.U.E., PUBLIC SEWER EASEMENTS AND PUBLIC DRAINAGE EASEMENTS TO BE PRIVATELY MAINTAINED BY HOA.
2. ALL COMMON ELEMENTS ARE PUBLIC DRAINAGE EASEMENTS TO BE PRIVATELY MAINTAINED BY HOA.

LVVWD NOTES

1. WATER PRESSURE ZONE 3665
2. MAINTAIN MINIMUM TWENTY-FOUR (24") INCH COVER PER UDACS SEC. 2.08.04. GRADING MUST BE COMPLETED PRIOR TO WATERLINE INSTALLATION

DROP INLET NOTE

WHERE 10 FEET PARALLEL SEPARATION IS NOT PRACTICABLE:
CAST-IN-PLACE MONOLITHIC POUR WITH WATERSTOP BETWEEN SLAB AND WALLS. BASE, WALLS AND TOP TO BE CONSTRUCTED WITH WATERSTOPS. CENTER BULB, OR FLAT SRIP. (VYNYLEX, GREENSTREAK PLASTIC PRODUCTS OR APPROVED EQUAL)

CONSTRUCTION NOTES

1. INSTALL 2" ASPHALT PAVEMENT OVER 4" TYPE II AGGREGATE BASE
2. CONSTRUCT 4' WIDE SIDEWALK PER CCAUSD NO. 234 (5" THICK W/ 5" TYPE II AGGREGATE BASE)
3. INSTALL MODIFIED ROLL TYPE CURB PER CCAUSD NO. 217.1
4. INSTALL 10' "L" TYPE CURB TO MODIFIED ROLL CURB TRANSITION PER DETAIL 29, SHEET D-3
5. CONSTRUCT SIDEWALK RAMPS USING ARMOR TILE TRUNCATED DOMES OR EQUIVALENT PER DETAIL 28, SHEET D-3
6. CONSTRUCT 8' CROSS GUTTER PER CCAUSD NO. 228
7. INSTALL 30" RCP STORM DRAIN PIPE
8. INSTALL 42" RCP STORM DRAIN PIPE
9. INSTALL 12.5' TYPE "CM2" DROP INLET PER CCAUSD NO. 412.1 AND STORM WATER QUALITY MANAGEMENT STAMP PER CCAUSD NO. 421
10. INSTALL 15' TYPE "CM2" DROP INLET WITH ALTERNATE CONNECTION PER CCAUSD NO. 412.1 AND STORM WATER QUALITY MANAGEMENT STAMP PER CCAUSD NO. 421
11. INSTALL 48" TYPE III SDMH CCAUSD NO. 401, 402 & 406
12. REMOVE EX 4.5'X6' NDOT TYPE 2A DROP INLET AND APRON
13. REMOVE AND REINSTALL 8" WIDE SIDEWALK PER CCAUSD NO. 234
14. INSTALL 10 STEPS @ 4.1'
15. INSTALL WROUGHT IRON MAN GATE
16. INSTALL WROUGHT FENCE PER CCAUSD NO. 425.51
17. INSTALL THROUGH WALL DRAIN BLOCK PER DETAIL 24, SHEET D-3
18. SAWCUT AND MATCH EXISTING IMPROVEMENTS (3" AC/6" TYPE I OR SCARIFY NATIVE) PER CCAUSD NO 500.2. EXISTING STRIPING TO BE REPLACED
19. INSTALL 18" RCP STORM DRAIN PIPE
20. INSTALL 36" RCP STORM DRAIN PIPE
21. INSTALL 5' TYPE "CM2" DROP INLET PER CCAUSD NO. 412.1 AND STORM WATER QUALITY MANAGEMENT STAMP PER CCAUSD NO. 421
22. INSTALL 10' TYPE "CM2" DROP INLET PER CCAUSD NO. 412.1 AND STORM WATER QUALITY MANAGEMENT STAMP PER CCAUSD NO. 421

SEE SHEET C-3 FOR LEGEND, ABBREVIATIONS, & QUANTITIES

SEWER NOTES

1. INSTALL 8" PVC SANITARY SEWER PER DCSWCS SD-15 & SD-17
2. INSTALL 48" DIAMETER SANITARY SEWER MANHOLE WITH PRECAST BASE PER DCSWCS SD-1A, SD-1B, SD-4, SD-9, AND SINGLE LID (24")
3. INSTALL 4" PVC SEWER LATERAL PER DCSWCS SD-22 & SD-25
4. EXISTING 48" DIAMETER SANITARY SEWER MANHOLE PER PHASE 1 IMPROVEMENT PLANS CLV #L19-00027 (107Y5102)
5. REMOVE CAP AND CONNECT TO EXISTING 8" SS
6. INSTALL SANITARY SEWER CLEANOUT WITH TRAFFIC RATED LID IN DRIVEWAY PER DCSWCS SD-26
7. INSTALL 4" C900 PVC SEWER LATERAL PER DCSWCS SD-22& SD-25 FOR LOT 54 ONLY
8. CONNECT SS LATERAL TO BRISTLE VALE UNIT 1 (CLV# 107Y5102-2) WYE FITTING
9. MANHOLE SHALL BE CORROSION PROTECTED WITH FIELD APPLIED COATING PER DCSWCS SECTION 3.16.B8

SEE SHEET C-3 FOR QUANTITIES AND ABBREVIATIONS

DISCLAIMER NOTE

1. EXISTING UTILITY LOCATIONS SHOWN HEREON ARE APPROXIMATE ONLY. IT SHALL BE THE CONTRACTOR'S RESPONSIBILITY TO DETERMINE THE EXACT VERTICAL AND HORIZONTAL LOCATION OF ALL EXISTING UNDERGROUND UTILITIES PRIOR TO COMMENCING CONSTRUCTION. NO REPRESENTATION IS MADE THAT ALL EXISTING UTILITIES ARE SHOWN HEREON. THE ENGINEER ASSUMES NO RESPONSIBILITY FOR UTILITIES NOT SHOWN IN THEIR PROPER LOCATION.
2. FOR ROADWAY WIDENING AND HALF STREET IMPROVEMENTS THE CONTRACTOR SHALL VERIFY CROSS SLOPES FROM EXISTING PAVEMENT SAWCUT LINE TO PROPOSED EDGE OF PAVEMENT OR PROJECTED LIP OF CURB PRIOR TO SUBGRADE PREPARATION AND CONSTRUCTION OF PROPOSED CURB LINE. IF MINIMUM OR MAXIMUM CROSS SLOPES DO NOT MEET AGENCY STANDARDS THE CONTRACTOR SHALL NOTIFY THE ENGINEER.

BENCHMARK

CITY OF LAS VEGAS BENCHMARK 7LV09 34SW6

RIVET AND ROUND PLATE IN THE TOP OF CURB AT THE SOUTHEAST CORNER OF DESERT MOON RD. AND SKY VISTA DR.
ELEVATION = 1011.422 METERS (NAVD '88)
ELEVATION = 3318.31 US SURVEY FEET (NAVD '88)

BASIS OF BEARINGS

NORTH 05°59'55" WEST, BEING THE BEARING OF THE WEST LINE OF SECTION 34, TOWNSHIP 20 SOUTH, RANGE 59 EAST, M.D.M., CITY OF LAS VEGAS, CLARK COUNTY, NEVADA, AS SHOWN BY MAP THEREOF ON FILE IN THE CLARK COUNTY, NEVADA RECORDER'S OFFICE IN BOOK 135, PAGE 71 OF PLATS.

APPROVED FOR CONSTRUCTION — FIRST APPROVAL 5/13/19

LAS VEGAS VALLEY WATER DISTRICT ENGINEERING SERVICES
PROJECT NO.: 136382 DATE: 9-23-19

FAST Call before you UnderGround 1-702-432-5300 FREEWAY & ARTERIAL SYSTEM OF TRANSPORTATION (F.A.S.T.)

AVOID HITTING OVERHEAD POWER LINES. IT'S COSTLY. CALL BEFORE YOU DO OVERHEAD 1-702-227-2929

Call before you Dig AVOID CUTTING UNDERGROUND UTILITY LINES. IT'S COSTLY. Call 811 OR 1-800-227-2600

SLATER HANIFAN GROUP
CONSULTING ENGINEERS & PLANNERS
5740 S. ARVILLE STREET #216, LAS VEGAS, NV 89118
PHONE (702) 284-5300 FAX (702) 284-5399

NO.	DESCRIPTION	DATE	BY	APP.
1	REV. STORM DRAIN & SS	07/17/19	PA	DSP

KB HOME
BRISTLE VALE - UNIT 2
PLAN & PROFILE - ISLAND BELLS AVE STA 17+50 TO 24+00
LAS VEGAS, NV
S33 R59E

DATE: 5/8/19
DRAFTER: OQ
DESIGNER: OQ
CHECKED: DSP
PROJECT NO.
KBH1804-000

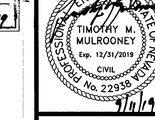

PP-2
SHEET 12 OF 29
L19-00527
107Y5102-2

PRO.#:136382A QS:137-33-NE

S:\kbh1804-000 summerlin -24 parcel 6&m\dwg\mpro\phase 2\kbh1804-000 pro p2.dwg 9/11/2019 12:23 PM Oscar Quiroz

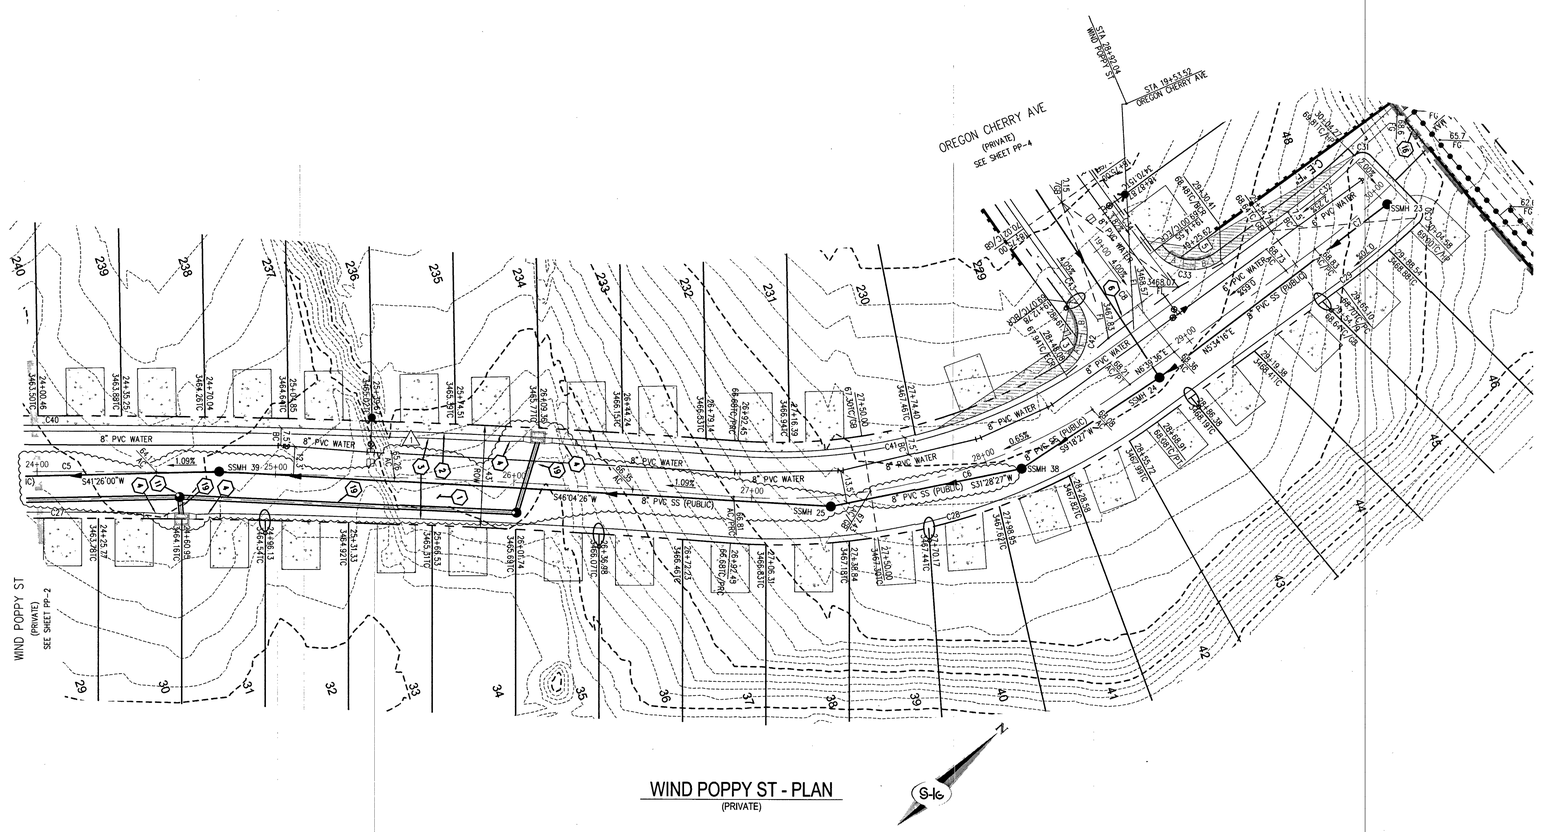

WIND POPPY ST - PLAN
(PRIVATE)

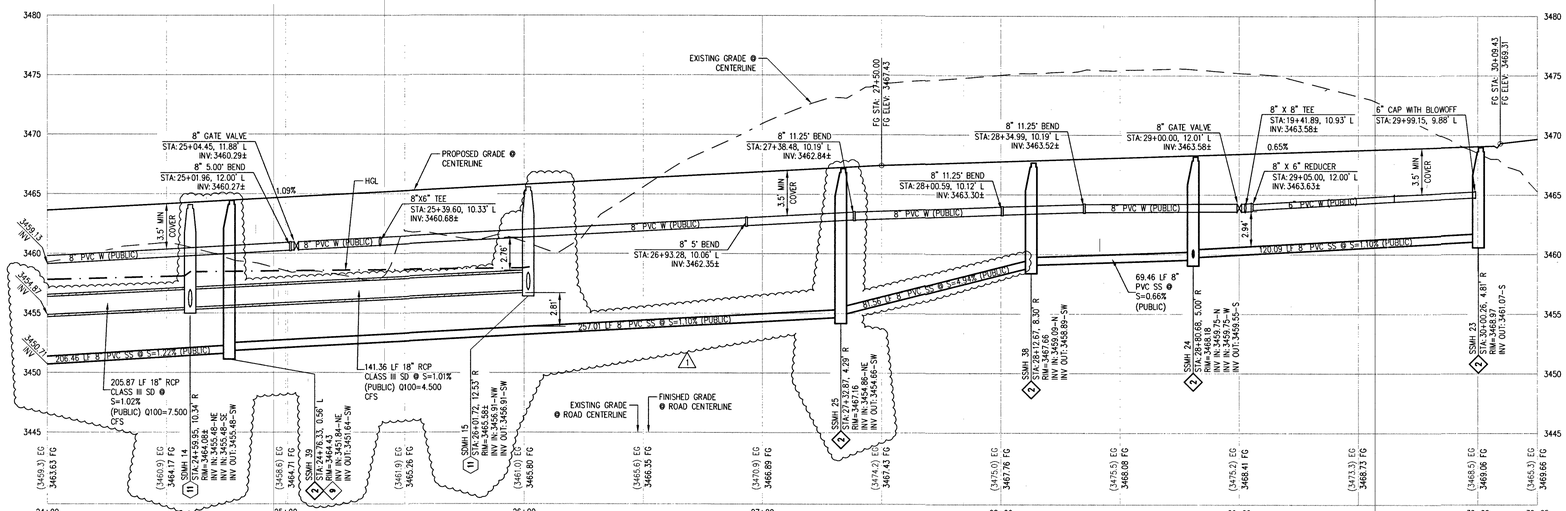

WIND POPPY ST - PROFILE
HORIZ: 1" = 30'
VERT: 1" = 6'

0 30 60
SCALE - 1"=30' FEET

CALL SOUTHWEST GAS AT 702-651-2111 FOR STANDBY WHEN EXCAVATING OVER OR NEAR HIGH PRESSURE GAS LINES

RAMP TRANSITION LENGTHS FOR 1:12 SIDE SLOPES

CASE NO.	GRADE % "B" TO "A"	"A" MIN.	"B" MIN.
1	-6 TO -5.01	4.5'	21.5'
2	-5 TO -4.01	4.5'	15.0'
3	-4 TO -3.01	4.5'	12.0'
4	-3 TO -2.01	4.5'	9.5'
5	-2 TO 2	8.0'	8.0'
6	2.01 TO 3	9.5'	4.5'
7	3.01 TO 4	12.0'	4.5'
8	4.01 TO 5	15.0'	4.5'
9	5.01 TO 6	21.5'	4.5'

SIDEWALK RAMPS USING AMOR TILE TRUNCATED DOMES OR EQUIVALENT PER CCAUSD NO. 235, CASE I

CURVE TABLE

CURVE	LENGTH	RADIUS	DELTA	TANGENT
C5	431.08'	3805.00'	6°29'29"	215.77'
C6	176.46'	250.00'	40°26'30"	92.09'
C7	41.83'	300.00'	7°59'20"	20.95'
C27	386.23'	3785.50'	5°50'45"	193.28'
C28	190.22'	269.50'	40°26'30"	99.27'
C29	42.24'	319.50'	7°34'31"	21.15'
C30	7.91'	5.00'	90°35'40"	5.05'
C31	7.80'	5.00'	89°20'42"	4.94'
C32	36.62'	280.50'	7°28'47"	18.34'
C40	433.29'	3824.50'	6°29'29"	216.88'
C41	143.50'	230.50'	35°40'08"	74.16'

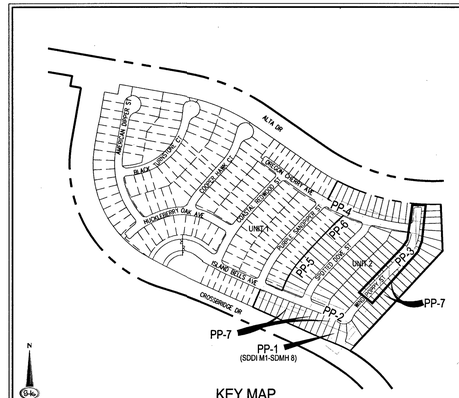

KEY MAP
NOT TO SCALE

LEGAL DESCRIPTION

LYING WITHIN THE NORTH EAST QUARTER (NE1/4) OF SECTION 33, TOWNSHIP 20 SOUTH, RANGE 59 EAST M.D.M., CITY OF LAS VEGAS, CLARK COUNTY, NEVADA.

EASEMENT NOTES

1. ALL PRIVATE STREETS ARE P.U.E., PUBLIC SEWER EASEMENTS AND PUBLIC DRAINAGE EASEMENTS TO BE PRIVATELY MAINTAINED BY HOA.
2. ALL COMMON ELEMENTS ARE PUBLIC DRAINAGE EASEMENTS TO BE PRIVATELY MAINTAINED BY HOA.

LVVWD NOTES

1. WATER PRESSURE ZONE 3665
2. MAINTAIN MINIMUM TWENTY-FOUR (24") INCH COVER PER UDACS SEC. 2.08.04. GRADING MUST BE COMPLETED PRIOR TO WATERLINE INSTALLATION

DROP INLET NOTE

WHERE 10 FEET PARALLEL SEPARATION IS NOT PRACTICABLE:
CAST-IN-PLACE MONOLITHIC POUR WITH WATERSTOP BETWEEN SLAB AND WALLS. BASE, WALLS AND TOP TO BE CONSTRUCTED WITH WATERSTOPS, CENTER BULB, OR FLAT SRIP. (VINYLEX, GREENSTREAK PLASTIC PRODUCTS OR APPROVED EQUAL)

CONSTRUCTION NOTES

1. INSTALL 2" ASPHALT PAVEMENT OVER 4" TYPE II AGGREGATE BASE
2. CONSTRUCT 4' WIDE SIDEWALK PER CCAUSD NO. 234 (5" THICK W/ 5" TYPE II AGGREGATE BASE)
3. INSTALL MODIFIED ROLL TYPE CURB PER CCAUSD NO. 217.1
4. INSTALL 10" "L" TYPE CURB TO MODIFIED ROLL CURB TRANSITION PER DETAIL 29, SHEET D-3
5. CONSTRUCT SIDEWALK RAMPS USING AMOR TILE TRUNCATED DOMES OR EQUIVALENT PER DETAIL 28, SHEET D-3
6. CONSTRUCT 8' CROSS GUTTER PER CCAUSD NO. 228
7. INSTALL 30" RCP STORM DRAIN PIPE
8. INSTALL 42" RCP STORM DRAIN PIPE
9. INSTALL 12.5' TYPE "CM2" DROP INLET PER CCAUSD NO. 412.1 AND STORM WATER QUALITY MANAGEMENT STAMP PER CCAUSD NO. 421
10. INSTALL 15' TYPE "CM2" DROP INLET WITH ALTERNATE CONNECTION PER CCAUSD NO. 412.1 AND STORM WATER QUALITY MANAGEMENT STAMP PER CCAUSD NO. 421
11. INSTALL 48" TYPE III SDMH CCAUSD NO. 401, 402 & 406
12. REMOVE EX 4.5'X6' NDOT TYPE 2A DROP INLET AND APRON
13. REMOVE AND REINSTALL 8" WIDE SIDEWALK PER CCAUSD NO. 234
14. INSTALL 10 STEPS @ 4.1"
15. INSTALL WROUGHT IRON MAN GATE
16. INSTALL WROUGHT FENCE PER CCAUSD NO. 425.S1
17. INSTALL THROUGH WALL DRAIN BLOCK PER DETAIL 24, SHEET D-2
18. SAWCUT AND MATCH EXISTING IMPROVEMENTS (3" AC/6" TYPE I) OR SCARIFY NATIVE PER CCAUSD NO 500.2. EXISTING SIDEWALK TO BE REPLACED
19. INSTALL 18" RCP STORM DRAIN PIPE
20. INSTALL 36" RCP STORM DRAIN PIPE
21. INSTALL 5' TYPE "CM2" DROP INLET PER CCAUSD NO. 412.1 AND STORM WATER QUALITY MANAGEMENT STAMP PER CCAUSD NO. 421
22. INSTALL 10' TYPE "CM2" DROP INLET PER CCAUSD NO. 412.1 AND STORM WATER QUALITY MANAGEMENT STAMP PER CCAUSD NO. 421

SEE SHEET C-3 FOR LEGEND, ABBREVIATIONS, & QUANTITIES

SEWER NOTES

1. INSTALL 8" PVC SANITARY SEWER PER DCSWCS SD-15 & SD-17
2. INSTALL 48" DIAMETER SANITARY SEWER MANHOLE WITH PRECAST BASE PER DCSWCS SD-1A, SD-1B, SD-4, SD-9, AND SINGLE LID (24")
3. INSTALL 4" PVC SEWER LATERAL PER DCSWCS SD-22 & SD-25
4. EXISTING 48" DIAMETER SANITARY SEWER MANHOLE PER PHASE 1 IMPROVEMENT PLANS CLV #L19-00027 (107YS102)
5. REMOVE CAP AND CONNECT TO EXISTING 8" SS
6. INSTALL SANITARY SEWER CLEANOUT WITH TRAFFIC RATED LID IN DRIVEWAY PER DCSWCS SD-26
7. INSTALL 4" C900 PVC SEWER LATERAL PER DCSWCS SD-22& SD-25 FOR LOT 54 ONLY
8. CONNECT SS LATERAL TO BRISTLE VALE UNIT 1 (CLV# 107YS102-2) WYE FITTING
9. MANHOLE SHALL BE CORROSION PROTECTED WITH FIELD APPLIED COATING PER DCSWCS SECTION 3.16.8B

SEE SHEET C-3 FOR QUANTITIES AND ABBREVIATIONS

DISCLAIMER NOTE

1. EXISTING UTILITY LOCATIONS SHOWN HEREON ARE APPROXIMATE ONLY. IT SHALL BE THE CONTRACTOR'S RESPONSIBILITY TO DETERMINE THE EXACT VERTICAL AND HORIZONTAL LOCATION OF ALL EXISTING UNDERGROUND UTILITIES PRIOR TO COMMENCING CONSTRUCTION. NO REPRESENTATION IS MADE THAT ALL EXISTING UTILITIES ARE SHOWN HEREON. THE ENGINEER ASSUMES NO RESPONSIBILITY FOR UTILITIES NOT SHOWN IN THEIR PROPER LOCATION.
2. FOR ROADWAY WIDENING AND HALF STREET IMPROVEMENTS THE CONTRACTOR SHALL VERIFY CROSS SLOPES FROM EXISTING PAVEMENT SAWCUT LINE TO PROPOSED EDGE OF PAVEMENT OR PROJECTED LIP OF CURB PRIOR TO SUBGRADE PREPARATION AND CONSTRUCTION OF PROPOSED CURB LINE. IF MINIMUM OR MAXIMUM CROSS SLOPES DO NOT MEET AGENCY STANDARDS THE CONTRACTOR SHALL NOTIFY THE ENGINEER.

BENCHMARK

CITY OF LAS VEGAS BENCHMARK 7LV09 34SW6

RIVET AND ROUND PLATE IN THE TOP OF CURB AT THE SOUTHEAST CORNER OF DESERT MOON RD. AND SKY VISTA DR.
ELEVATION = 1011.422 METERS (NAVD '88)
ELEVATION = 3318.31 US SURVEY FEET (NAVD '88)

BASIS OF BEARINGS

NORTH 05°59'55" WEST, BEING THE BEARING OF THE WEST LINE OF SECTION 34, TOWNSHIP 20 SOUTH, RANGE 59 EAST, M.D.M., CITY OF LAS VEGAS, CLARK COUNTY, NEVADA, AS SHOWN BY MAP THEREOF ON FILE IN THE CLARK COUNTY, NEVADA RECORDER'S OFFICE IN BOOK 135, PAGE 71 OF PLATS.

APPROVED FOR CONSTRUCTION FIRST APPROVAL 5/13/19
LAS VEGAS VALLEY WATER DISTRICT ENGINEERING SERVICES
PROJECT NO.: 136382 DATE: 9-23-19

FAST Call before you UnderGround 1-702-432-5300 FREEWAY & ARTERIAL SYSTEM OF TRANSPORTATION (F.A.S.T)

AVOID HITTING OVERHEAD POWER LINES. IT'S COSTLY. CALL BEFORE YOU DO OVERHEAD 1-702-227-2929

Call before you Dig AVOID CUTTING UNDERGROUND UTILITY LINES. IT'S COSTLY. Call 811 OR 1-800-227-2600

SLATER HANIFAN GROUP
CONSULTING ENGINEERS & PLANNERS
5740 S. ARVILLE STREET #216, LAS VEGAS, NV 89118
PHONE (702) 284-5300 FAX (702) 284-5399

NO.	DESCRIPTION	DATE	BY	APP.
1	PCC STORM DRAIN & SS	07/17/19	PA	5-23-19

LAS VEGAS, NV

KB HOME

BRISTLE VALE - UNIT 2

PLAN & PROFILE - WIND POPPY ST STA 24+00 TO 30+65

T 20S R 59E S 33

DATE: 5/8/19
DRAFTER: OQ
DESIGNER: OQ
CHECKED: DSP
PROJECT NO. KBH1804-000

PROFESSIONAL ENGINEER STATE OF NEVADA TIMOTHY M. MULROONEY Exp. 12/31/2019 CIVIL No. 22938
9/11/19

PP-3
SHEET 13 OF 29
L19-00527
107Y5102-2

PROJ#:136382A QS:137-33-NE

J:\Kbh1804-000 summerlin\24 parcel 1&m\dwg\improv\phase 2\kbh1804-000 prop p2.dwg 9/11/2019 12:23 PM Oscar Quiroz

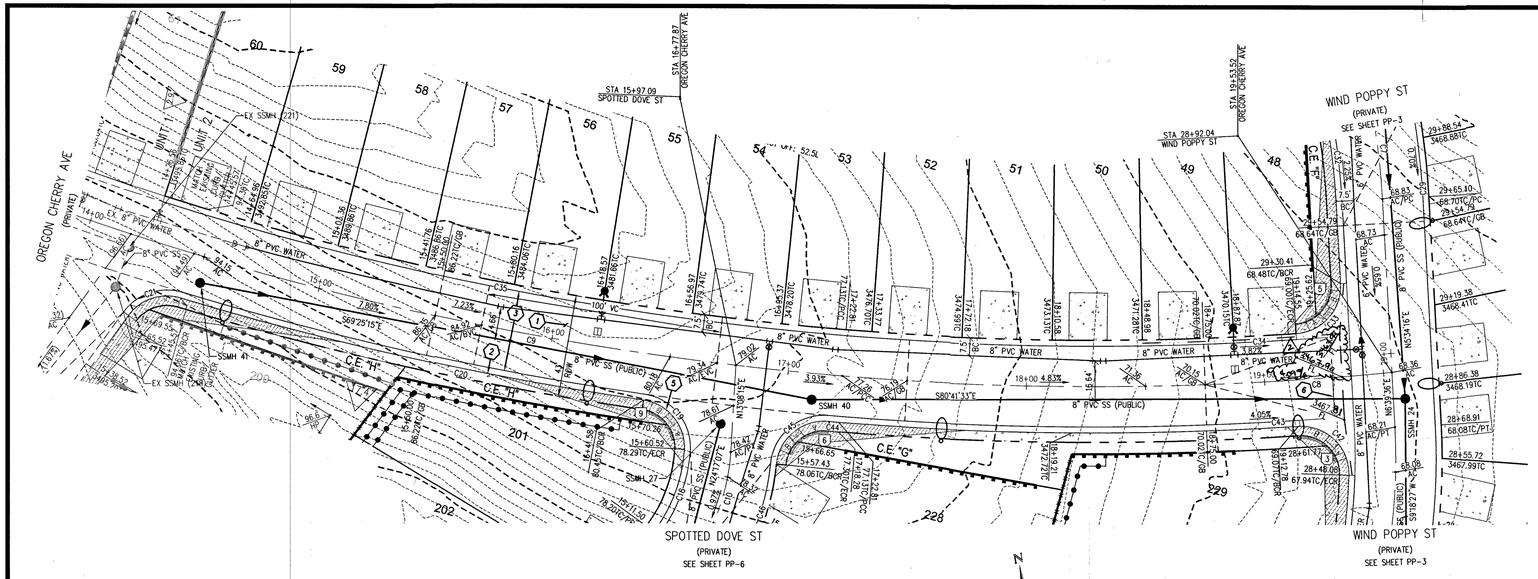

OREGON CHERRY AVE - PLAN
(PRIVATE)

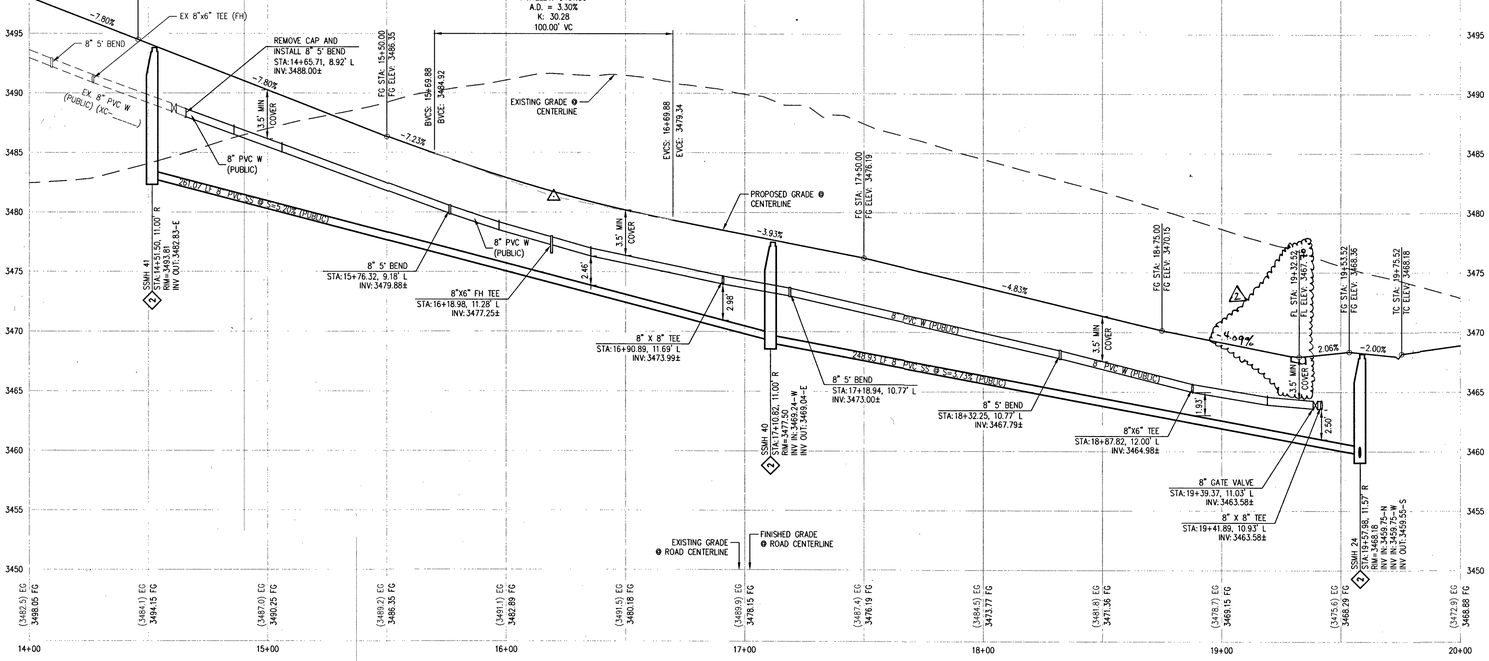

OREGON CHERRY AVE - PROFILE
HORIZ: 1" = 30'
VERT: 1" = 6'

0 30 60
SCALE – 1"=30' FEET

CALL SOUTHWEST GAS AT 702-651-2111 FOR STANDBY WHEN EXCAVATING OVER OR NEAR HIGH PRESSURE GAS LINES

RAMP TRANSITION LENGTHS FOR 1:12 SIDE SLOPES

CASE NO.	GRADE % "B" TO "A"	"A" MIN.	"B" MIN.
1	-6 TO -5.01	4.5'	21.5'
2	-5 TO -4.01	4.5'	15.0'
3	-4 TO -3.01	4.5'	12.0'
4	-3 TO -2.01	4.5'	9.5'
5	-2 TO 2	8.0'	8.0'
6	2.01 TO 3	9.5'	4.5'
7	3.01 TO 4	12.0'	4.5'
8	4.01 TO 5	15.0'	4.5'
9	5.01 TO 6	21.5'	4.5'

SIDEWALK RAMPS USING ARMOR TILE TRUNCATED DOMES OR EQUIVALENT PER CCAUSD NO. 235, CASE 1

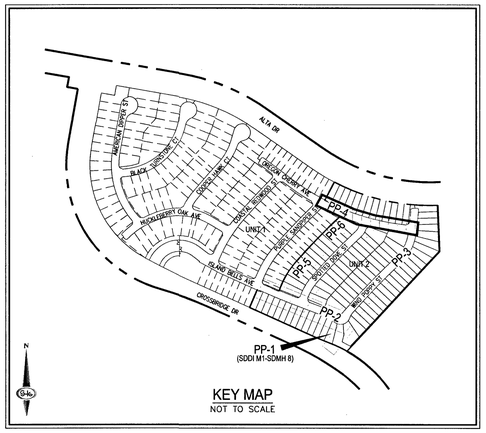

KEY MAP
NOT TO SCALE

CURVE TABLE

CURVE	LENGTH	RADIUS	DELTA	TANGENT
C8	230.71'	1298.50'	10°10'48"	115.66'
C9	277.23'	1298.50'	12°13'58"	139.14'
C20	198.95'	1318.00'	8°38'55"	99.66'
C21	24.63'	20.00'	70°34'13"	14.15'
C33	31.14'	20.00'	89°12'32"	19.73'
C34	188.86'	1279.00'	8°27'37"	94.60'
C35	291.80'	1279.00'	13°04'19"	146.54'
C42	33.33'	20.00'	95°29'10"	22.01'
C43	192.82'	1318.00'	8°22'57"	96.58'
C44	4.60'	1318.00'	0°12'00"	2.30'

LEGAL DESCRIPTION

LYING WITHIN THE NORTH EAST QUARTER (NE1/4) OF SECTION 33, TOWNSHIP 20 SOUTH, RANGE 59 EAST M.D.M., CITY OF LAS VEGAS, CLARK COUNTY, NEVADA.

EASEMENT NOTES

1. ALL PRIVATE STREETS ARE P.U.E., PUBLIC SEWER EASEMENTS AND PUBLIC DRAINAGE EASEMENTS TO BE PRIVATELY MAINTAINED BY HOA.
2. ALL COMMON ELEMENTS ARE PUBLIC DRAINAGE EASEMENTS TO BE PRIVATELY MAINTAINED BY HOA.

LVVWD NOTES

1. WATER PRESSURE ZONE 3665
2. MAINTAIN MINIMUM TWENTY-FOUR (24") INCH COVER PER UDACS SEC. 2.08.04. GRADING MUST BE COMPLETED PRIOR TO WATERLINE INSTALLATION

DROP INLET NOTE

WHERE 10 FEET PARALLEL SEPARATION IS NOT PRACTICABLE:
CAST-IN-PLACE MONOLITHIC POUR WITH WATERSTOP BETWEEN SLAB AND WALLS. BASE, WALLS AND TOP TO BE CONSTRUCTED WITH WATERSTOPS, CENTER BULB, OR FLAT STRIP (VINYLEX, GREENSTREAK PLASTIC PRODUCTS OR APPROVED EQUAL)

CONSTRUCTION NOTES

1. INSTALL 2" ASPHALT PAVEMENT OVER 4" TYPE II AGGREGATE BASE
2. CONSTRUCT 4' WIDE SIDEWALK PER CCAUSD NO. 234 (5" THICK W/ 5" TYPE II AGGREGATE BASE)
3. INSTALL MODIFIED ROLL TYPE CURB PER CCAUSD NO. 217.1
4. INSTALL 10' "L" TYPE CURB TO MODIFIED ROLL CURB TRANSITION PER DETAIL 29, SHEET D-3
5. CONSTRUCT SIDEWALK RAMPS USING ARMOR TILE TRUNCATED DOMES OR EQUIVALENT PER DETAIL 28, SHEET D-3
6. CONSTRUCT 8' CROSS GUTTER PER CCAUSD NO. 228
7. INSTALL 30" RCP STORM DRAIN PIPE
8. INSTALL 42" RCP STORM DRAIN PIPE
9. INSTALL 12.5' TYPE "CM2" DROP INLET PER CCAUSD NO. 412.1 AND STORM WATER QUALITY MANAGEMENT STAMP PER CCAUSD NO. 421
10. INSTALL 20' TYPE "CM2" DROP INLET WITH ALTERNATE CONNECTION PER CCAUSD NO. 412.1 AND STORM WATER QUALITY MANAGEMENT STAMP PER CCAUSD NO. 421
11. INSTALL 48" TYPE III SDMH CCAUSD NO. 401, 402 & 406
12. REMOVE EX 4.5'X6' NDOT TYPE 2A DROP INLET AND APRON
13. REMOVE AND REINSTALL 8' WIDE SIDEWALK PER CCAUSD NO. 234
14. INSTALL 10 STEPS @ 4.1'
15. INSTALL WROUGHT IRON MAN GATE
16. INSTALL WROUGHT FENCE PER CCAUSD NO. 425.S1
17. INSTALL THROUGH WALL DRAIN BLOCK PER DETAIL 24, SHEET D-2
18. SAWCUT AND MATCH EXISTING IMPROVEMENTS (3" AC/6" TYPE I OR SCARIFY NATIVE) PER CCAUSD NO 500.2. EXISTING STRIPING TO BE REPLACED

SEE SHEET C-3 FOR LEGEND, ABBREVIATIONS, & QUANTITIES

DISCLAIMER NOTE

1. EXISTING UTILITY LOCATIONS SHOWN HEREON ARE APPROXIMATE ONLY. IT SHALL BE THE CONTRACTOR'S RESPONSIBILITY TO DETERMINE THE EXACT VERTICAL AND HORIZONTAL LOCATION OF ALL EXISTING UNDERGROUND UTILITIES PRIOR TO COMMENCING CONSTRUCTION. NO REPRESENTATION IS MADE THAT ALL EXISTING UTILITIES ARE SHOWN HEREON. THE ENGINEER ASSUMES NO RESPONSIBILITY FOR UTILITIES NOT SHOWN IN THEIR PROPER LOCATION.
2. FOR ROADWAY WIDENING AND HALF STREET IMPROVEMENTS THE CONTRACTOR SHALL VERIFY CROSS SLOPES FROM EXISTING PAVEMENT SAWCUT LINE TO PROPOSED EDGE OF PAVEMENT OR PROJECTED LIP OF CURB PRIOR TO SUBGRADE PREPARATION AND CONSTRUCTION OF PROPOSED CURB LINE. IF MINIMUM OR MAXIMUM CROSS SLOPES DO NOT MEET AGENCY STANDARDS THE CONTRACTOR SHALL NOTIFY THE ENGINEER.

BENCHMARK

CITY OF LAS VEGAS BENCHMARK 7LV09 34SW6

RIVET AND ROUND PLATE IN THE TOP OF CURB AT THE SOUTHEAST CORNER OF DESERT MOON RD. AND SKY VISTA DR.
ELEVATION = 1011.422 METERS (NAVD '88)
ELEVATION = 3318.31 US SURVEY FEET (NAVD '88)

BASIS OF BEARINGS

NORTH 05°59'55" WEST, BEING THE BEARING OF THE WEST LINE OF SECTION 34 TOWNSHIP 20 SOUTH, RANGE 59 EAST, M.D.M., CITY OF LAS VEGAS, CLARK COUNTY, NEVADA, AS SHOWN BY MAP THEREOF ON FILE IN THE CLARK COUNTY, NEVADA RECORDER'S OFFICE IN BOOK 135, PAGE 71 OF PLATS.

APPROVED FOR CONSTRUCTION
LAS VEGAS VALLEY WATER DISTRICT ENGINEERING SERVICES MANAGER
PROJECT NO.: 136382 DATE: 5/13/19

FAST Call before you UnderGround 1-702-432-5300
FREEWAY & ARTERIAL SYSTEM OF TRANSPORTATION (F.A.S.T.)

AVOID HITTING OVERHEAD POWER LINES. IT'S COSTLY.
CALL BEFORE YOU DIG OVERHEAD
1-702-227-2929

Call before you Dig
AVOID CUTTING UNDERGROUND UTILITY LINES. IT'S COSTLY.
Call 811 OR 1-800-227-2600

SLATER HANIFAN GROUP
CONSULTING ENGINEERS & PLANNERS
5740 S. ARVILLE STREET #216, LAS VEGAS, NV 89118
PHONE (702) 284-5300 FAX (702) 284-5399

NO	DESCRIPTION	DATE	BY	APP	APP DATE
1	REVISE GRADING	11/01/19	MG	DSP	11/01/19

LAS VEGAS, NV

KB HOME
BRISTLE VALE - UNIT 2
PLAN & PROFILE - OREGON CHERRY AVE STA 14+00 TO 20+00

S33 T 20S R 59E

DATE: 5/8/19
DRAFTER: OQ
DESIGNER: OQ
CHECKED: DSP
PROJECT NO. KBH1804-000

TIMOTHY M. MULROONEY Exp. 12/31/2019 CIVIL No. 22938 STATE OF NEVADA PROFESSIONAL ENGINEER 5/8/19

PP-4
SHEET 14 OF 29

L19-00527
107Y5102-2

PRO.#:136382A QS:137-33-NE

J:\kbh1804-000 summerlin \24 parcel 1&m\dwg\improv\phase 2\kbh1804-000 prop p2.dwg 5/8/2019 3:13 PM Oscar Quiroz

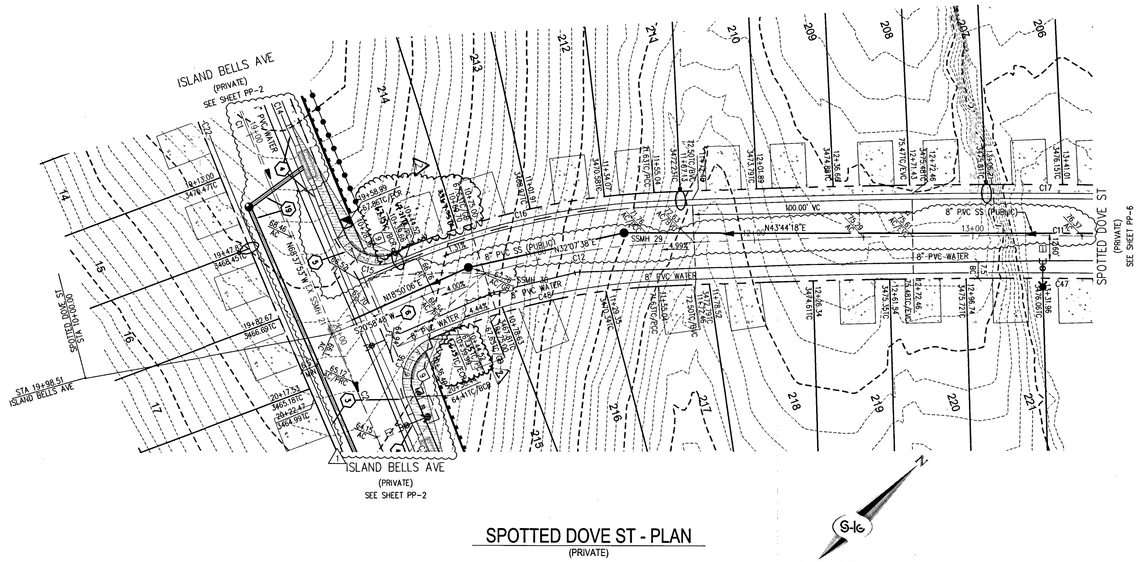

SPOTTED DOVE ST - PLAN
(PRIVATE)

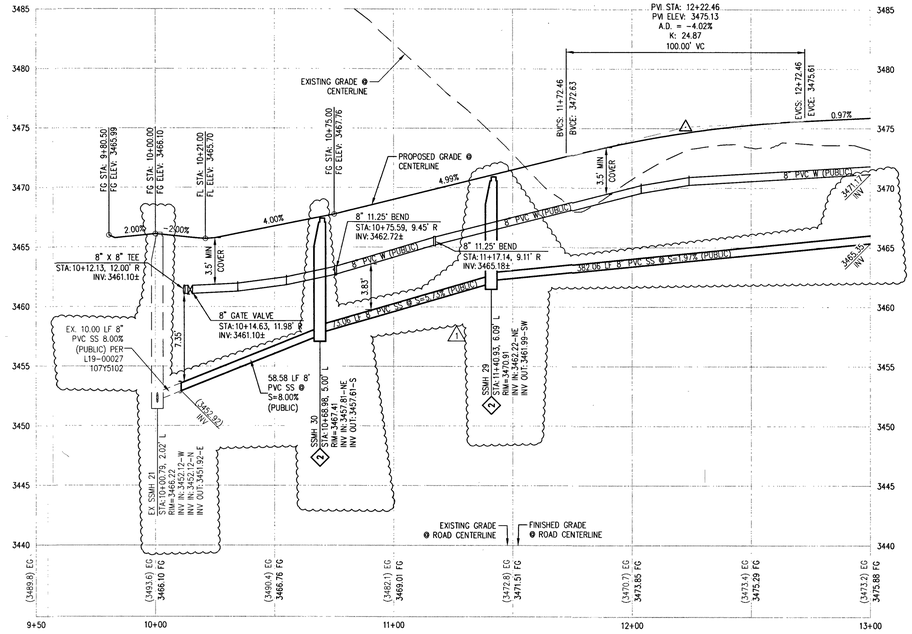

SPOTTED DOVE ST - PROFILE
HORIZ: 1" = 30'
VERT: 1" = 6'

SCALE - 1"=30' (0, 30, 60 FEET)

CALL SOUTHWEST GAS AT 702-651-2111 FOR STANDBY WHEN EXCAVATING OVER OR NEAR HIGH PRESSURE GAS LINES

RAMP TRANSITION LENGTHS FOR 1:12 SIDE SLOPES

CASE NO.	GRADE % "B" TO "A"	"A" MIN.	"B" MIN.
1	-6 TO -5.01	4.5'	21.5'
2	-5 TO -4.01	4.5'	15.0'
3	-4 TO -3.01	4.5'	12.0'
4	-3 TO -2.01	4.5'	9.5'
5	-2 TO 2	8.0'	8.0'
6	2.01 TO 3	9.5'	4.5'
7	3.01 TO 4	12.0'	4.5'
8	4.01 TO 5	15.0'	4.5'
9	5.01 TO 6	21.5'	4.5'

SIDEWALK RAMPS USING AMOR TILE TRUNCATED DOMES OR EQUIVALENT PER CCAUSD NO. 235, CASE I

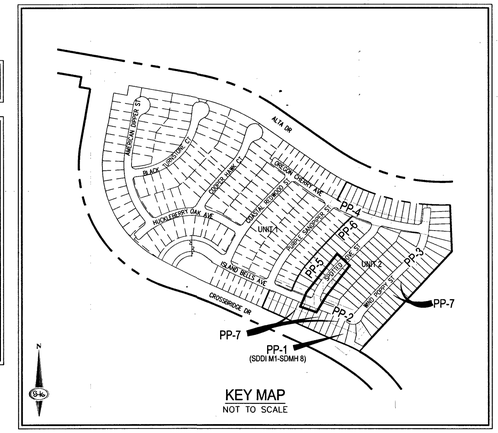

KEY MAP
NOT TO SCALE

CURVE TABLE

CURVE	LENGTH	RADIUS	DELTA	TANGENT
C11	356.46'	3416.90'	5°58'38"	178.39'
C12	110.52'	316.90'	19°58'54"	55.83'
C15	31.74'	20.00'	90°55'32"	20.33'
C16	122.19'	336.40'	20°48'42"	61.78'
C17	358.49'	3436.40'	5°58'38"	179.41'
C36	31.63'	20.00'	90°36'46"	20.22'
C47	354.43'	3397.40'	5°58'38"	177.37'
C48	103.72'	297.40'	19°58'54"	52.39'

LEGAL DESCRIPTION
LYING WITHIN THE NORTH EAST QUARTER (NE1/4) OF SECTION 33, TOWNSHIP 20 SOUTH, RANGE 59 EAST M.D.M., CITY OF LAS VEGAS, CLARK COUNTY, NEVADA.

EASEMENT NOTES
1. ALL PRIVATE STREETS ARE P.U.E., PUBLIC SEWER EASEMENTS AND PUBLIC DRAINAGE EASEMENTS TO BE PRIVATELY MAINTAINED BY HOA.
2. ALL COMMON ELEMENTS ARE PUBLIC DRAINAGE EASEMENTS TO BE PRIVATELY MAINTAINED BY HOA.

LVVWD NOTES
1. WATER PRESSURE ZONE 3665
2. MAINTAIN MINIMUM TWENTY-FOUR (24") INCH COVER PER UDACS SEC. 2.08.04. GRADING MUST BE COMPLETED PRIOR TO WATERLINE INSTALLATION

DROP INLET NOTE
WHERE 10 FEET PARALLEL SEPARATION IS NOT PRACTICABLE:
CAST-IN-PLACE MONOLITHIC POUR WITH WATERSTOP BETWEEN SLAB AND WALLS. BASE, WALLS AND TOP TO BE CONSTRUCTED WITH WATERSTOPS, CENTER BULB, OR FLAT SRIP. (VYNYLEX, GREENSTREAK PLASTIC PRODUCTS OR APPROVED EQUAL)

CONSTRUCTION NOTES
1. INSTALL 2" ASPHALT PAVEMENT OVER 4" TYPE II AGGREGATE BASE
2. CONSTRUCT 4' WIDE SIDEWALK PER CCAUSD NO. 234 (5" THICK W/ 5" TYPE II AGGREGATE BASE)
3. INSTALL MODIFIED ROLL TYPE CURB PER CCAUSD NO. 217.1
4. INSTALL 10" 1-1" TYPE CURB TO MODIFIED ROLL CURB TRANSITION PER DETAIL 29, SHEET D-3
5. CONSTRUCT SIDEWALK RAMPS USING ARMOR TILE TRUNCATED DOMES OR EQUIVALENT PER DETAIL 28, SHEET D-3
6. CONSTRUCT 8' CROSS GUTTER PER CCAUSD NO. 228
7. INSTALL 30" RCP STORM DRAIN PIPE
8. INSTALL 42" RCP STORM DRAIN PIPE
9. INSTALL 12.5' TYPE "CM2" DROP INLET PER CCAUSD NO. 412.1 AND STORM WATER QUALITY MANAGEMENT STAMP PER CCAUSD NO. 421
10. INSTALL 15' TYPE "CM2" DROP INLET WITH ALTERNATE CONNECTION PER CCAUSD NO. 412.1 AND STORM WATER QUALITY MANAGEMENT STAMP PER CCAUSD NO. 421
11. INSTALL 48" TYPE III SDMH CCAUSD NO. 401, 402 & 406
12. REMOVE EX 4.5'X6' NDOT TYPE 2A DROP INLET AND APRON
13. REMOVE AND REINSTALL 8' WIDE SIDEWALK PER CCAUSD NO. 234
14. INSTALL 10 STEPS @ 4.1'
15. INSTALL WROUGHT IRON MAN GATE
16. INSTALL WROUGHT FENCE PER CCAUSD NO. 425.S1
17. INSTALL THROUGH WALL DRAIN BLOCK PER DETAIL 24, SHEET D-2
18. SAWCUT AND MATCH EXISTING IMPROVEMENTS (3" AC/6" TYPE II OR SCARIFY NATIVE) PER CCAUSD NO 500.2. EXISTING SIDEWALK TO BE REPLACED
19. INSTALL 18" RCP STORM DRAIN PIPE
20. INSTALL 36" RCP STORM DRAIN PIPE
21. INSTALL 5' TYPE "CM2" DROP INLET PER CCAUSD NO. 412.1 AND STORM WATER QUALITY MANAGEMENT STAMP PER CCAUSD NO. 421
22. INSTALL 10' TYPE "CM2" DROP INLET PER CCAUSD NO. 412.1 AND STORM WATER QUALITY MANAGEMENT STAMP PER CCAUSD NO. 421

SEE SHEET C-3 FOR LEGEND, ABBREVIATIONS, & QUANTITIES

SEWER NOTES
1. INSTALL 8" PVC SANITARY SEWER PER DCSWCS SD-15 & SD-17
2. INSTALL 48" DIAMETER SANITARY SEWER MANHOLE WITH PRECAST BASE PER DCSWCS SD-1A, SD-1B, SD-4, SD-9, AND SINGLE LID (24")
3. INSTALL 4" PVC SEWER LATERAL PER DCSWCS SD-22 & SD-25
4. EXISTING 48" DIAMETER SANITARY SEWER MANHOLE PER PHASE 1 IMPROVEMENT PLANS CLV #L19-00027 (107Y5102)
5. REMOVE CAP AND CONNECT TO EXISTING 8" SS
6. INSTALL SANITARY SEWER CLEANOUT WITH TRAFFIC RATED LID IN DRIVEWAY PER DCSWCS SD-29
7. INSTALL 4" C900 PVC SEWER LATERAL PER DCSWCS SD-22& SD-25 FOR LOT 54 ONLY
8. CONNECT SS LATERAL TO BRISTLE VALE UNIT 1 (CLV# 107Y5102-2) TEE FITTING
9. MANHOLE SHALL BE CORROSION PROTECTED WITH FIELD APPLIED COATING PER DCSWCS SECTION 3.16.8B

SEE SHEET C-3 FOR QUANTITIES AND ABBREVIATIONS

DISCLAIMER NOTE
1. EXISTING UTILITY LOCATIONS SHOWN HEREON ARE APPROXIMATE ONLY. IT SHALL BE THE CONTRACTOR'S RESPONSIBILITY TO DETERMINE THE EXACT VERTICAL AND HORIZONTAL LOCATION OF ALL EXISTING UNDERGROUND UTILITIES PRIOR TO COMMENCING CONSTRUCTION. NO REPRESENTATION IS MADE THAT ALL EXISTING UTILITIES ARE SHOWN HEREON. THE ENGINEER ASSUMES NO RESPONSIBILITY FOR UTILITIES NOT SHOWN IN THEIR PROPER LOCATION.
2. FOR ROADWAY WIDENING AND HALF STREET IMPROVEMENTS THE CONTRACTOR SHALL VERIFY CROSS SLOPES FROM EXISTING PAVEMENT SAWCUT LINE TO PROPOSED EDGE OF PAVEMENT OR PROJECTED LIP OF CURB PRIOR TO SUBGRADE PREPARATION AND CONSTRUCTION OF PROPOSED CURB LINE. IF MINIMUM OR MAXIMUM CROSS SLOPES DO NOT MEET AGENCY STANDARDS THE CONTRACTOR SHALL NOTIFY THE ENGINEER.

BENCHMARK
CITY OF LAS VEGAS BENCHMARK 7LV09 34SW6

RIVET AND ROUND PLATE IN THE TOP OF CURB AT THE SOUTHEAST CORNER OF DESERT MOON RD. AND SKY VISTA DR.
ELEVATION = 1011.422 METERS (NAVD '88)
ELEVATION = 3318.31 US SURVEY FEET (NAVD '88)

BASIS OF BEARINGS
NORTH 05°59'55" WEST, BEING THE BEARING OF THE WEST LINE OF SECTION 34, TOWNSHIP 20 SOUTH, RANGE 59 EAST, M.D.M., CITY OF LAS VEGAS, CLARK COUNTY, NEVADA, AS SHOWN BY MAP THEREOF ON FILE IN THE CLARK COUNTY, NEVADA RECORDER'S OFFICE IN BOOK 135, PAGE 71 OF PLATS.

APPROVED FOR CONSTRUCTION — FIRST APPROVAL 5/15/19
LAS VEGAS VALLEY WATER DISTRICT ENGINEERING SERVICES
PROJECT NO.: 136382 DATE: 9-23-19

FAST Call before you UnderGround 1-702-432-5300 FREEWAY & ARTERIAL SYSTEM OF TRANSPORTATION (F.A.S.T)

AVOID HITTING OVERHEAD POWER LINES. IT'S COSTLY. CALL BEFORE YOU DO OVERHEAD 1-702-227-2929

Call before you Dig AVOID CUTTING UNDERGROUND UTILITY LINES. IT'S COSTLY. Call 811 OR 1-800-227-2600

SLATER HANIFAN GROUP
CONSULTING ENGINEERS & PLANNERS
5740 S. ARVILLE STREET #216, LAS VEGAS, NV 89118
PHONE (702) 284-5300 FAX (702) 284-5399

NO.	DESCRIPTION	DATE	BY	APP.	APP. DATE
1	REVISE SEWER PER CCAUSD COMMENTS	07/17/19	PA		
2	REVISE GRADE	9/19/19	NE		

LAS VEGAS, NV

KB HOME

BRISTLE VALE - UNIT 2

PLAN & PROFILE - SPOTTED DOVE ST STA 9+50 TO 13+00

S 33
T 20S
R 59E

DATE: 5/8/19
DRAFTER: OQ
DESIGNER: OQ
CHECKED: DSP

PROJECT NO.
KBH1804-000

PROFESSIONAL ENGINEER — TIMOTHY M. MULROONEY — Exp. 12/31/2019 — CIVIL — No. 22938 — STATE OF NEVADA
9/19/19

PP-5
SHEET 15 OF 29

L19-00527
107Y5102-2

PROJ.#:136382A QS:137-33-NE

J:\Kbh1804-000_summerlin_v24_parcel_l&m\Civil\dwg\Improv\phase 2\Kbh1804-000 prp_p2.dwg 9/11/2019 12:24 PM Oscar Ochoa

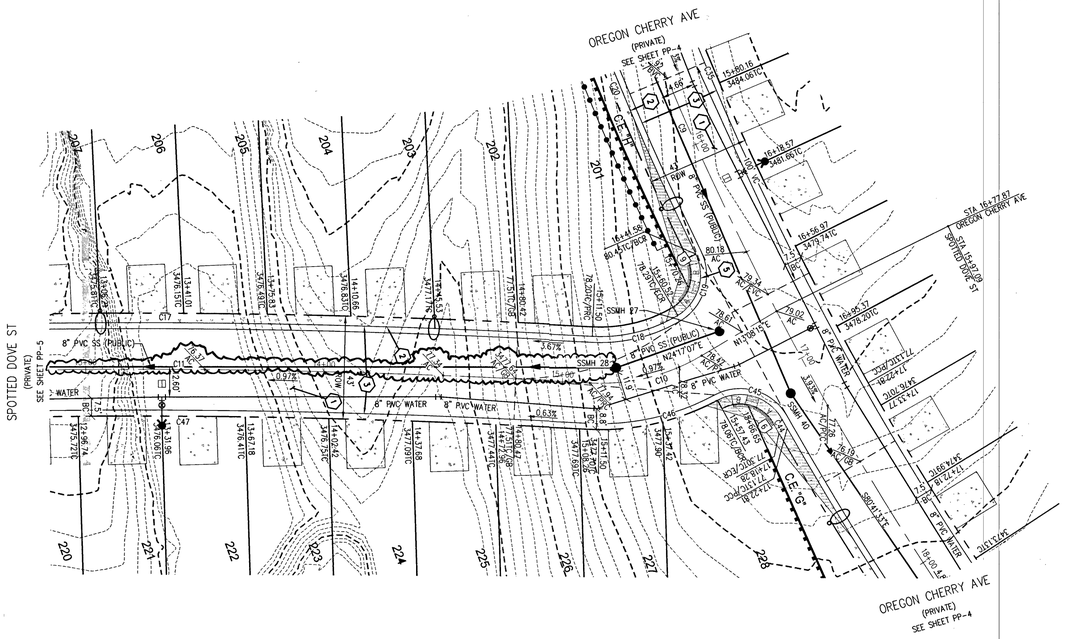

SPOTTED DOVE ST - PLAN
(PRIVATE)

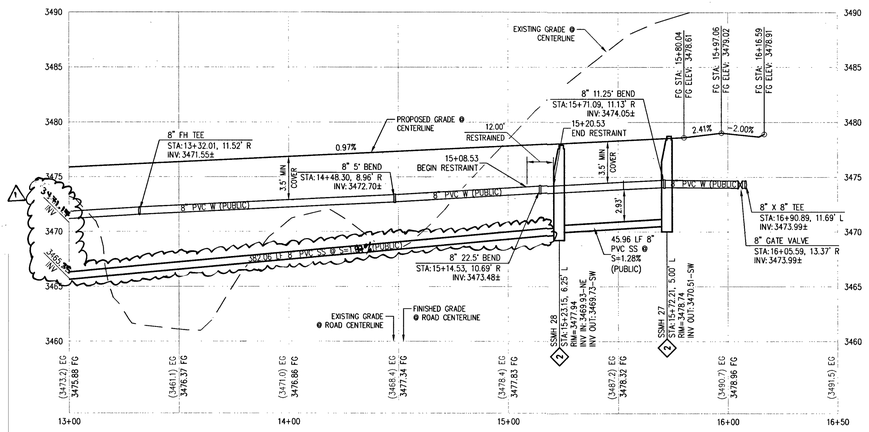

SPOTTED DOVE ST - PROFILE
HORIZ: 1" = 30'
VERT: 1" = 6'

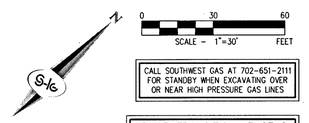

CALL SOUTHWEST GAS AT 702-651-2111 FOR STANDBY WHEN EXCAVATING OVER OR NEAR HIGH PRESSURE GAS LINES

RAMP TRANSITION LENGTHS
FOR 1:12 SIDE SLOPES

CASE NO.	GRADE % "B" TO "A"	"A" MIN.	"B" MIN.
1	-6 TO -5.01	4.5'	21.5'
2	-5 TO -4.01	4.5'	15.0'
3	-4 TO -3.01	4.5'	12.0'
4	-3 TO -2.01	4.5'	9.5'
5	-2 TO 2	8.0'	8.0'
6	2.01 TO 3	9.5'	4.5'
7	3.01 TO 4	12.0'	4.5'
8	4.01 TO 5	15.0'	4.5'
9	5.01 TO 6	21.5'	4.5'

SIDEWALK RAMPS USING ARMOR TILE TRUNCATED DOMES OR EQUIVALENT PER CCAUSD NO. 235, CASE 1

CURVE TABLE

CURVE	LENGTH	RADIUS	DELTA	TANGENT
C10	49.02'	83.10'	33°48'05"	25.25'
C11	356.46'	3416.90'	5°58'38"	178.39'
C17	358.49'	3436.40'	5°58'38"	179.41'
C18	37.72'	63.60'	33°58'55"	19.43'
C19	29.89'	20.00'	85°37'31"	18.53'
C45	31.16'	20.00'	89°15'40"	19.74'
C46	56.67'	102.60'	31°38'57"	29.08'
C47	354.43'	3397.40'	5°58'38"	177.37'

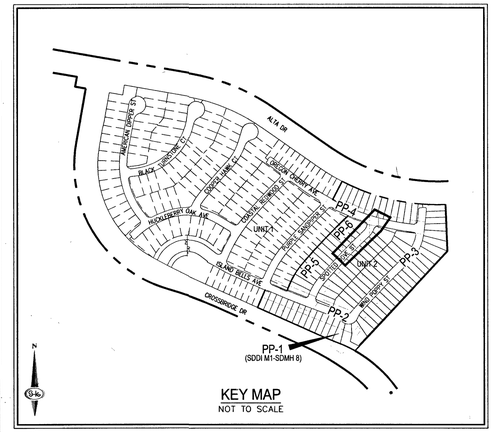

KEY MAP
NOT TO SCALE

LEGAL DESCRIPTION
LYING WITHIN THE NORTH EAST QUARTER (NE1/4) OF SECTION 33, TOWNSHIP 20 SOUTH, RANGE 59 EAST M.D.M., CITY OF LAS VEGAS, CLARK COUNTY, NEVADA.

EASEMENT NOTES
1. ALL PRIVATE STREETS ARE P.U.E., PUBLIC SEWER EASEMENTS AND PUBLIC DRAINAGE EASEMENTS TO BE PRIVATELY MAINTAINED BY HOA.
2. ALL COMMON ELEMENTS ARE PUBLIC DRAINAGE EASEMENTS TO BE PRIVATELY MAINTAINED BY HOA.

LVVWD NOTES
1. WATER PRESSURE ZONE 3665
2. MAINTAIN MINIMUM TWENTY-FOUR (24") INCH COVER PER UDACS SEC. 2.08.04. GRADING MUST BE COMPLETED PRIOR TO WATERLINE INSTALLATION

DROP INLET NOTE
WHERE 10 FEET PARALLEL SEPARATION IS NOT PRACTICABLE:
CAST-IN-PLACE MONOLITHIC POUR WITH WATERSTOP BETWEEN SLAB AND WALLS. BASE, WALLS AND TOP TO BE CONSTRUCTED WITH WATERSTOPS, CENTER BULB, OR FLAT SRIP (VINYLEX, GREENSTREAK PLASTIC PRODUCTS OR APPROVED EQUAL)

CONSTRUCTION NOTES
1. INSTALL 2" ASPHALT PAVEMENT OVER 4" TYPE II AGGREGATE BASE
2. CONSTRUCT 4' WIDE SIDEWALK PER CCAUSD NO. 234 (5" THICK W/ 5" TYPE II AGGREGATE BASE)
3. INSTALL MODIFIED ROLL TYPE CURB PER CCAUSD NO. 217.1
4. INSTALL 10" "L" TYPE CURB TO MODIFIED ROLL CURB TRANSITION PER DETAIL 29, SHEET D-3
5. CONSTRUCT SIDEWALK RAMPS USING ARMOR TILE TRUNCATED DOMES OR EQUIVALENT PER DETAIL 28, SHEET D-3
6. CONSTRUCT 8' CROSS GUTTER PER CCAUSD NO. 228
7. INSTALL 30" RCP STORM DRAIN PIPE
8. INSTALL 42" RCP STORM DRAIN PIPE
9. INSTALL 12.5' TYPE "CM2" DROP INLET PER CCAUSD NO. 412.1 AND STORM WATER QUALITY MANAGEMENT STAMP PER CCAUSD NO. 421
10. INSTALL 20' TYPE "CM2" DROP INLET WITH ALTERNATE CONNECTION PER CCAUSD NO. 412.1 AND STORM WATER QUALITY MANAGEMENT STAMP PER CCAUSD NO. 421
11. INSTALL 48" TYPE III SDMH CCAUSD NO. 401, 402 & 406
12. REMOVE EX 4.5'X6' NDOT TYPE 2A DROP INLET AND APRON
13. REMOVE AND REINSTALL 8' WIDE SIDEWALK PER CCAUSD NO. 234
14. INSTALL 10 STEPS @ 4.1'
15. INSTALL WROUGHT IRON MAN GATE
16. INSTALL WROUGHT FENCE PER CCAUSD NO. 425.S1
17. INSTALL THROUGH WALL DRAIN BLOCK PER DETAIL 24, SHEET D-2
18. SAWCUT AND MATCH EXISTING IMPROVEMENTS (3" AC/6" TYPE II OR SCARIFY NATIVE) PER CCAUSD NO 500.2. EXISTING STRIPING TO BE REPLACED
19. INSTALL 18" RCP STORM DRAIN PIPE
20. INSTALL 36" RCP STORM DRAIN PIPE
21. INSTALL 5' TYPE "CM2" DROP INLET PER CCAUSD NO. 412.1 AND STORM WATER QUALITY MANAGEMENT STAMP PER CCAUSD NO. 421
22. INSTALL 10' TYPE "CM2" DROP INLET PER CCAUSD NO. 412.1 AND STORM WATER QUALITY MANAGEMENT STAMP PER CCAUSD NO. 421

SEE SHEET C-3 FOR LEGEND, ABBREVIATIONS, & QUANTITIES

SEWER NOTES
1. INSTALL 8" PVC SANITARY SEWER PER DCSWCS SD-15 & SD-17
2. INSTALL 48" DIAMETER SANITARY SEWER MANHOLE WITH PRECAST BASE PER DCSWCS SD-1A, SD-1B, SD-4, SD-9, AND SINGLE LID (24")
3. INSTALL 4" PVC SEWER LATERAL PER DCSWCS SD-22 & SD-25
4. EXISTING 48" DIAMETER SANITARY SEWER MANHOLE PER PHASE 1 IMPROVEMENT PLANS CLV #L19-00027 (107Y5102)
5. REMOVE CAP AND CONNECT TO EXISTING 8" SS
6. INSTALL SANITARY SEWER CLEANOUT W/H TRAFFIC RATED LID IN DRIVEWAY PER DCSWCS SD-26
7. INSTALL 4" C900 PVC SEWER LATERAL PER DCSWCS SD-22& SD-25 FOR LOT 54 ONLY
8. CONNECT SS LATERAL TO BRISTLE VALE UNIT 1 (CLV# 107Y5102-2) WYE FITTING

SEE SHEET C-3 FOR QUANTITIES AND ABBREVIATIONS

DISCLAIMER NOTE
1. EXISTING UTILITY LOCATIONS SHOWN HEREON ARE APPROXIMATE ONLY. IT SHALL BE THE CONTRACTOR'S RESPONSIBILITY TO DETERMINE THE EXACT VERTICAL AND HORIZONTAL LOCATION OF ALL EXISTING UNDERGROUND UTILITIES PRIOR TO COMMENCING CONSTRUCTION. NO REPRESENTATION IS MADE THAT ALL EXISTING UTILITIES ARE SHOWN HEREON. THE ENGINEER ASSUMES NO RESPONSIBILITY FOR UTILITIES NOT SHOWN IN THEIR PROPER LOCATION.
2. FOR ROADWAY WIDENING AND HALF STREET IMPROVEMENTS THE CONTRACTOR SHALL VERIFY CROSS SLOPES FROM EXISTING PAVEMENT SAWCUT LINE TO PROPOSED EDGE OF PAVEMENT OR PROJECTED LIP OF CURB PRIOR TO SUBGRADE PREPARATION AND CONSTRUCTION OF PROPOSED CURB LINE. IF MINIMUM OR MAXIMUM CROSS SLOPES DO NOT MEET AGENCY STANDARDS THE CONTRACTOR SHALL NOTIFY THE ENGINEER.

BENCHMARK
CITY OF LAS VEGAS BENCHMARK 7LV09 34SW6
RIVET AND ROUND PLATE IN THE TOP OF CURB AT THE SOUTHEAST CORNER OF DESERT MOON RD AND SKY VISTA DR.
ELEVATION = 1011.422 METERS (NAVD '88)
ELEVATION = 3318.31 US SURVEY FEET (NAVD '88)

BASIS OF BEARINGS
NORTH 05°59'55" WEST, BEING THE BEARING OF THE WEST LINE OF SECTION 34, TOWNSHIP 20 SOUTH, RANGE 59 EAST, M.D.M., CITY OF LAS VEGAS, CLARK COUNTY, NEVADA, AS SHOWN BY MAP THEREOF ON FILE IN THE CLARK COUNTY, NEVADA RECORDER'S OFFICE IN BOOK 135, PAGE 71 OF PLATS.

APPROVED FOR CONSTRUCTION
LAS VEGAS VALLEY WATER DISTRICT ENGINEERING SERVICES MANAGER
PROJECT NO.: 136382 DATE: 5/13/19

FAST
Call before you UnderGround
1-702-432-5300
FREEWAY & ARTERIAL SYSTEM OF TRANSPORTATION (F.A.S.T.)

AVOID HITTING OVERHEAD POWER LINES. IT'S COSTLY.
CALL BEFORE YOU DIG OVERHEAD
1-702-227-2929

Call before you Dig
AVOID CUTTING UNDERGROUND UTILITY LINES. IT'S COSTLY.
Call 811
OR
1-800-227-2600

SLATER HANIFAN GROUP
CONSULTING ENGINEERS & PLANNERS
5740 S. ARVILLE STREET #216, LAS VEGAS, NV 89118
PHONE (702) 264-5300 FAX (702) 264-5399

NO.	DESCRIPTION	DATE	BY	APP.
1	REVISE STORM DRAIN, SEWER, CONSTRUCTION NOTES, AND SEWER NOTES	5/8/19	DK	DSP

LAS VEGAS, NV

KB HOME
BRISTLE VALE - UNIT 2
PLAN & PROFILE - SPOTTED DOVE ST STA 13+00 TO 16+50
S33 T20S R59E

DATE: 5/8/19
DRAFTER: OQ
DESIGNER: OQ
CHECKED: DSP
PROJECT NO.
KBH1804-000

PROFESSIONAL ENGINEER
TIMOTHY M. MULROONEY
Exp. 12/31/2019
CIVIL
STATE OF NEVADA
No. 22938
5/8/19

PP-6
SHEET 16 OF 29
L19-00527
107Y5102-2

PROJ#:136382A QS:137-33-NE

E:\kbh1804-000 summerlin_s24 parcel 8&1\dwg\mnoro\phase 2\kbh1804-000 prp p2.dwg 5/8/2019 3:14 PM Oscar Quiroz

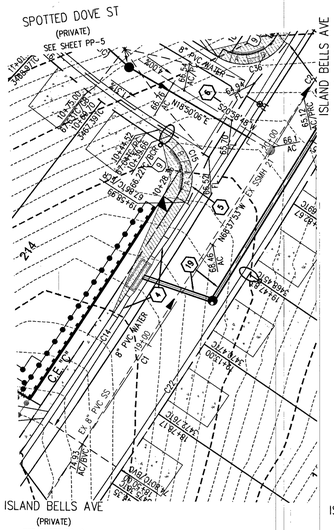

SDDI M1 - PLAN

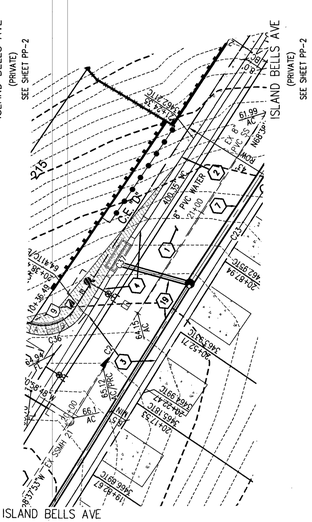

SDDI M2 - PLAN

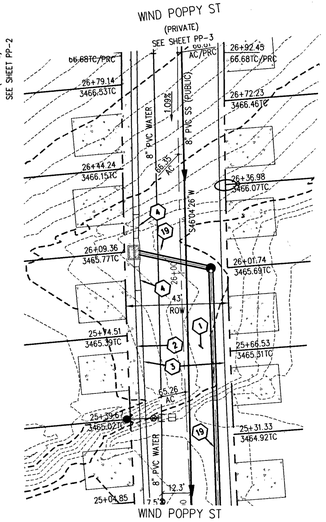

SDDI M3 - PLAN

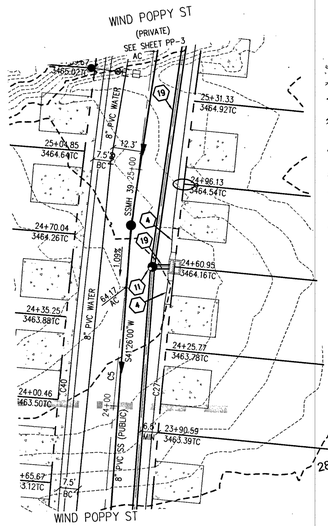

SDDI M4 - PLAN

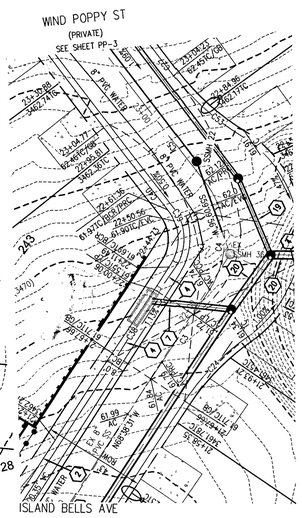

SDDI M5 - PLAN

CALL SOUTHWEST GAS AT 702-651-2111 FOR STANDBY WHEN EXCAVATING OVER OR NEAR HIGH PRESSURE GAS LINES

RAMP TRANSITION LENGTHS FOR 1:12 SIDE SLOPES			
CASE NO.	GRADE % "B" TO "A"	"A" MIN.	"B" MIN.
1	-6 TO -5.01	4.5'	21.5'
2	-5 TO -4.01	4.5'	15.0'
3	-4 TO -3.01	4.5'	12.0'
4	-3 TO -2.01	4.5'	9.5'
5	-2 TO 2	8.0'	8.0'
6	2.01 TO 3	9.5'	4.5'
7	3.01 TO 4	12.0'	4.5'
8	4.01 TO 5	15.0'	4.5'
9	5.01 TO 6	21.5'	4.5'

SIDEWALK RAMPS USING AMOR TILE TRUNCATED DOMES OR EQUIVALENT PER CCAUSD NO. 235, CASE I

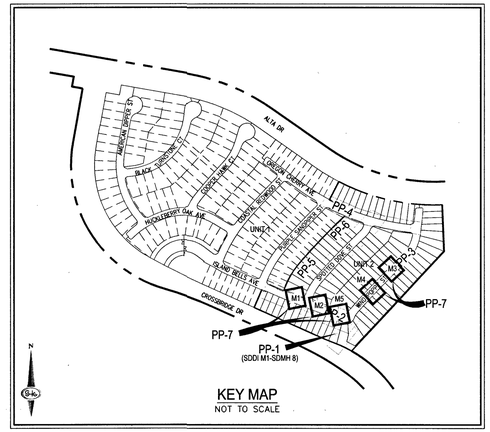

KEY MAP
NOT TO SCALE

LEGAL DESCRIPTION

LYING WITHIN THE NORTH EAST QUARTER (NE1/4) OF SECTION 33, TOWNSHIP 20 SOUTH, RANGE 59 EAST M.D.M., CITY OF LAS VEGAS, CLARK COUNTY, NEVADA.

EASEMENT NOTES

1. ALL PRIVATE STREETS ARE P.U.E., PUBLIC SEWER EASEMENTS AND PUBLIC DRAINAGE EASEMENTS TO BE PRIVATELY MAINTAINED BY HOA.
2. ALL COMMON ELEMENTS ARE PUBLIC DRAINAGE EASEMENTS TO BE PRIVATELY MAINTAINED BY HOA.

LVVWD NOTES

1. WATER PRESSURE ZONE 3665
2. MAINTAIN MINIMUM TWENTY-FOUR (24") INCH COVER PER UDACS SEC. 2.08.04. GRADING MUST BE COMPLETED PRIOR TO WATERLINE INSTALLATION

DROP INLET NOTE

WHERE 10 FEET PARALLEL SEPARATION IS NOT PRACTICABLE:
CAST-IN-PLACE MONOLITHIC POUR WITH WATERSTOP BETWEEN SLAB AND WALLS. BASE, WALLS AND TOP TO BE CONSTRUCTED WITH WATERSTOPS, CENTER BULB, OR FLAT SRIP. (VINYLEX, GREENSTREAK PLASTIC PRODUCTS OR APPROVED EQUAL)

CONSTRUCTION NOTES

1. INSTALL 2" ASPHALT PAVEMENT OVER 4" TYPE II AGGREGATE BASE
2. CONSTRUCT 4' WIDE SIDEWALK PER CCAUSD NO. 234 (5" THICK W/ 5" TYPE II AGGREGATE BASE)
3. INSTALL MODIFIED ROLL TYPE CURB PER CCAUSD NO. 217.1
4. INSTALL 10' "L" TYPE CURB TO MODIFIED ROLL CURB TRANSITION PER DETAIL 29, SHEET D-3
5. CONSTRUCT SIDEWALK RAMPS USING ARMOR TILE TRUNCATED DOMES OR EQUIVALENT PER DETAIL 28, SHEET D-3
6. CONSTRUCT 8' CROSS GUTTER PER CCAUSD NO. 228
7. INSTALL 30" RCP STORM DRAIN PIPE
8. INSTALL 42" RCP STORM DRAIN PIPE
9. INSTALL 12.5' TYPE "CM2" DROP INLET PER CCAUSD NO. 412.1 AND STORM WATER QUALITY MANAGEMENT STAMP PER CCAUSD NO. 421
10. INSTALL 15' TYPE "CM2" DROP INLET WITH ALTERNATE CONNECTION PER CCAUSD NO. 412.1 AND STORM WATER QUALITY MANAGEMENT STAMP PER CCAUSD NO. 421
11. INSTALL 48" TYPE III SDMH CCAUSD NO. 401, 402 & 406
12. REMOVE EX 4.5'X6' NDOT TYPE 2A DROP INLET AND APRON
13. REMOVE AND REINSTALL 8" WIDE SIDEWALK PER CCAUSD NO. 234
14. INSTALL 10 STEPS @ 4.1"
15. INSTALL WROUGHT IRON MAN GATE
16. INSTALL WROUGHT FENCE PER CCAUSD NO. 425.S1
17. INSTALL THROUGH WALL DRAIN BLOCK PER DETAIL 24, SHEET D-2
18. SAWCUT AND MATCH EXISTING IMPROVEMENTS (3" AC/6" TYPE II OR SCARIFY NATIVE) PER CCAUSD NO 500.2. EXISTING STRIPING TO BE REPLACED
19. INSTALL 18" RCP STORM DRAIN PIPE
20. INSTALL 36" RCP STORM DRAIN PIPE
21. INSTALL 5' TYPE "CM2" DROP INLET PER CCAUSD NO. 412.1 AND STORM WATER QUALITY MANAGEMENT STAMP PER CCAUSD NO. 421
22. INSTALL 10' TYPE "CM2" DROP INLET PER CCAUSD NO. 412.1 AND STORM WATER QUALITY MANAGEMENT STAMP PER CCAUSD NO. 421

SEE SHEET C-3 FOR LEGEND, ABBREVIATIONS, & QUANTITIES

SEWER NOTES

1. INSTALL 8" PVC SANITARY SEWER PER DCSWCS SD-15 & SD-17
2. INSTALL 48" DIAMETER SANITARY SEWER MANHOLE WITH PRECAST BASE PER DCSWCS SD-1A, SD-1B, SD-4, SD-9, AND SINGLE LID (24")
3. INSTALL 4" PVC SEWER LATERAL PER DCSWCS SD-22 & SD-25
4. EXISTING 48" DIAMETER SANITARY SEWER MANHOLE PER PHASE 1 IMPROVEMENT PLANS CLV #L19-00027 (107Y5102)
5. REMOVE CAP AND CONNECT TO EXISTING 8" SS
6. INSTALL SANITARY SEWER CLEANOUT WITH TRAFFIC RATED LID IN DRIVEWAY PER DCSWCS SD-26
7. INSTALL 4" C900 PVC SEWER LATERAL PER DCSWCS SD-22& SD-25 FOR LOT 54 ONLY
8. CONNECT SS LATERAL TO BRISTLE VALE UNIT 1 (CLV# 107Y5102-2) WYE FITTING
9. MANHOLE SHALL BE CORROSION PROTECTED WITH FIELD APPLIED COATING PER DCSWCS SECTION 3.16.8B

SEE SHEET C-3 FOR QUANTITIES AND ABBREVIATIONS

DISCLAIMER NOTE

1. EXISTING UTILITY LOCATIONS SHOWN HEREON ARE APPROXIMATE ONLY. IT SHALL BE THE CONTRACTOR'S RESPONSIBILITY TO DETERMINE THE EXACT VERTICAL AND HORIZONTAL LOCATION OF ALL EXISTING UNDERGROUND UTILITIES PRIOR TO COMMENCING CONSTRUCTION. NO REPRESENTATION IS MADE THAT ALL EXISTING UTILITIES ARE SHOWN HEREON. THE ENGINEER ASSUMES NO RESPONSIBILITY FOR UTILITIES NOT SHOWN IN THEIR PROPER LOCATION.
2. FOR ROADWAY WIDENING AND HALF STREET IMPROVEMENTS THE CONTRACTOR SHALL VERIFY CROSS SLOPES FROM EXISTING PAVEMENT SAWCUT LINE TO PROPOSED EDGE OF PAVEMENT OR PROJECTED LIP OF CURB PRIOR TO SUBGRADE PREPARATION AND CONSTRUCTION OF PROPOSED CURB LINE. IF MINIMUM OR MAXIMUM CROSS SLOPES DO NOT MEET AGENCY STANDARDS THE CONTRACTOR SHALL NOTIFY THE ENGINEER.

BENCHMARK

CITY OF LAS VEGAS BENCHMARK 7LV09 34SW6

RIVET AND ROUND PLATE IN THE TOP OF CURB AT THE SOUTHEAST CORNER OF DESERT MOON RD. AND SKY VISTA DR.
ELEVATION = 1011.422 METERS (NAVD '88)
ELEVATION = 3318.31 US SURVEY FEET (NAVD '88)

BASIS OF BEARINGS

NORTH 05°59'55" WEST, BEING THE BEARING OF THE WEST LINE OF SECTION 34, TOWNSHIP 20 SOUTH, RANGE 59 EAST, M.D.M., CITY OF LAS VEGAS, CLARK COUNTY, NEVADA, AS SHOWN BY MAP THEREOF ON FILE IN THE CLARK COUNTY, NEVADA RECORDER'S OFFICE IN BOOK 135, PAGE 71 OF PLATS.

APPROVED FOR CONSTRUCTION

LAS VEGAS VALLEY WATER DISTRICT ENGINEERING SERVICES
PROJECT NO.: 136382 DATE: 9-23-19

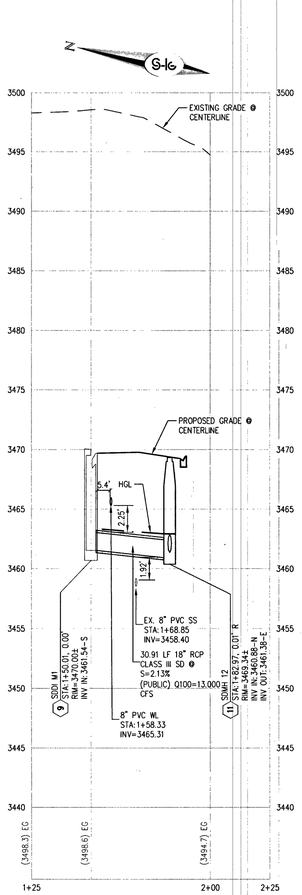

HORIZ: 1" = 30'
VERT: 1" = 6'

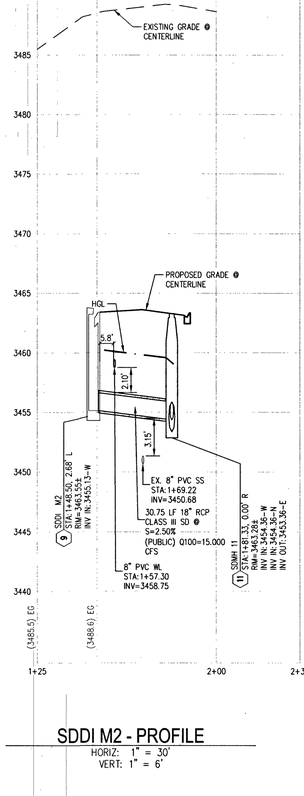

SDDI M2 - PROFILE
HORIZ: 1" = 30'
VERT: 1" = 6'

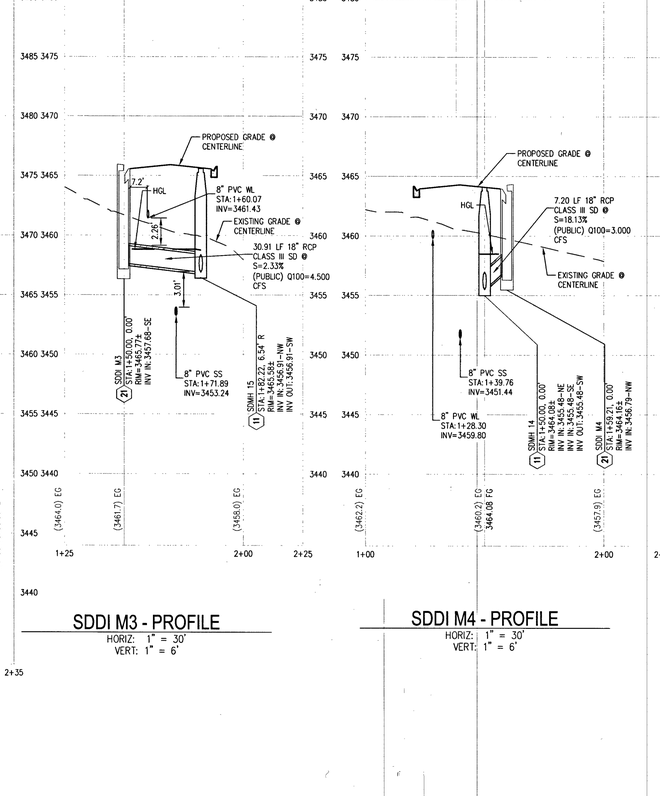

SDDI M3 - PROFILE
HORIZ: 1" = 30'
VERT: 1" = 6'

SDDI M4 - PROFILE
HORIZ: 1" = 30'
VERT: 1" = 6'

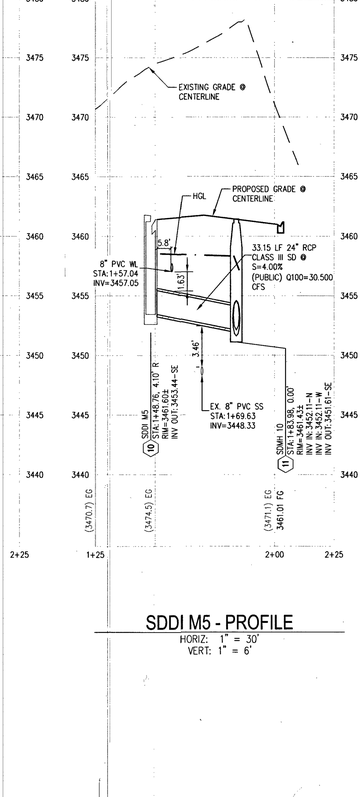

SDDI M5 - PROFILE
HORIZ: 1" = 30'
VERT: 1" = 6'

SLATER HANIFAN GROUP
CONSULTING ENGINEERS & PLANNERS
5740 S. ARVILLE STREET #216, LAS VEGAS, NV 89118
PHONE (702) 284-5300 FAX (702) 284-5399

NO.	DESCRIPTION	DATE	BY	APP.
1	ADD SHEET PP-7 TO PLAN SET	9/11/19	PA	MMW

LAS VEGAS, NV

KB HOME

BRISTLE VALE - UNIT 2

PLAN & PROFILE - SDDI M1 - SDDI M5

S 33
T 20S
R 59E

DATE: 5/8/19
DRAFTER: OQ
DESIGNER: OQ
CHECKED: DSP

PROJECT NO.
KBH1804-000

PP-7
SHEET 16B OF 29

L19-00527
107Y5102-2

PROJ.#:136382A QS:137-33-NE

J:\kbh1804-000 summerlin v24 parcel 18m\dwg\improv\phase 2\kbh1804-000 prp p2.dwg 9/11/2019 12:26 PM Oscar Quiroz

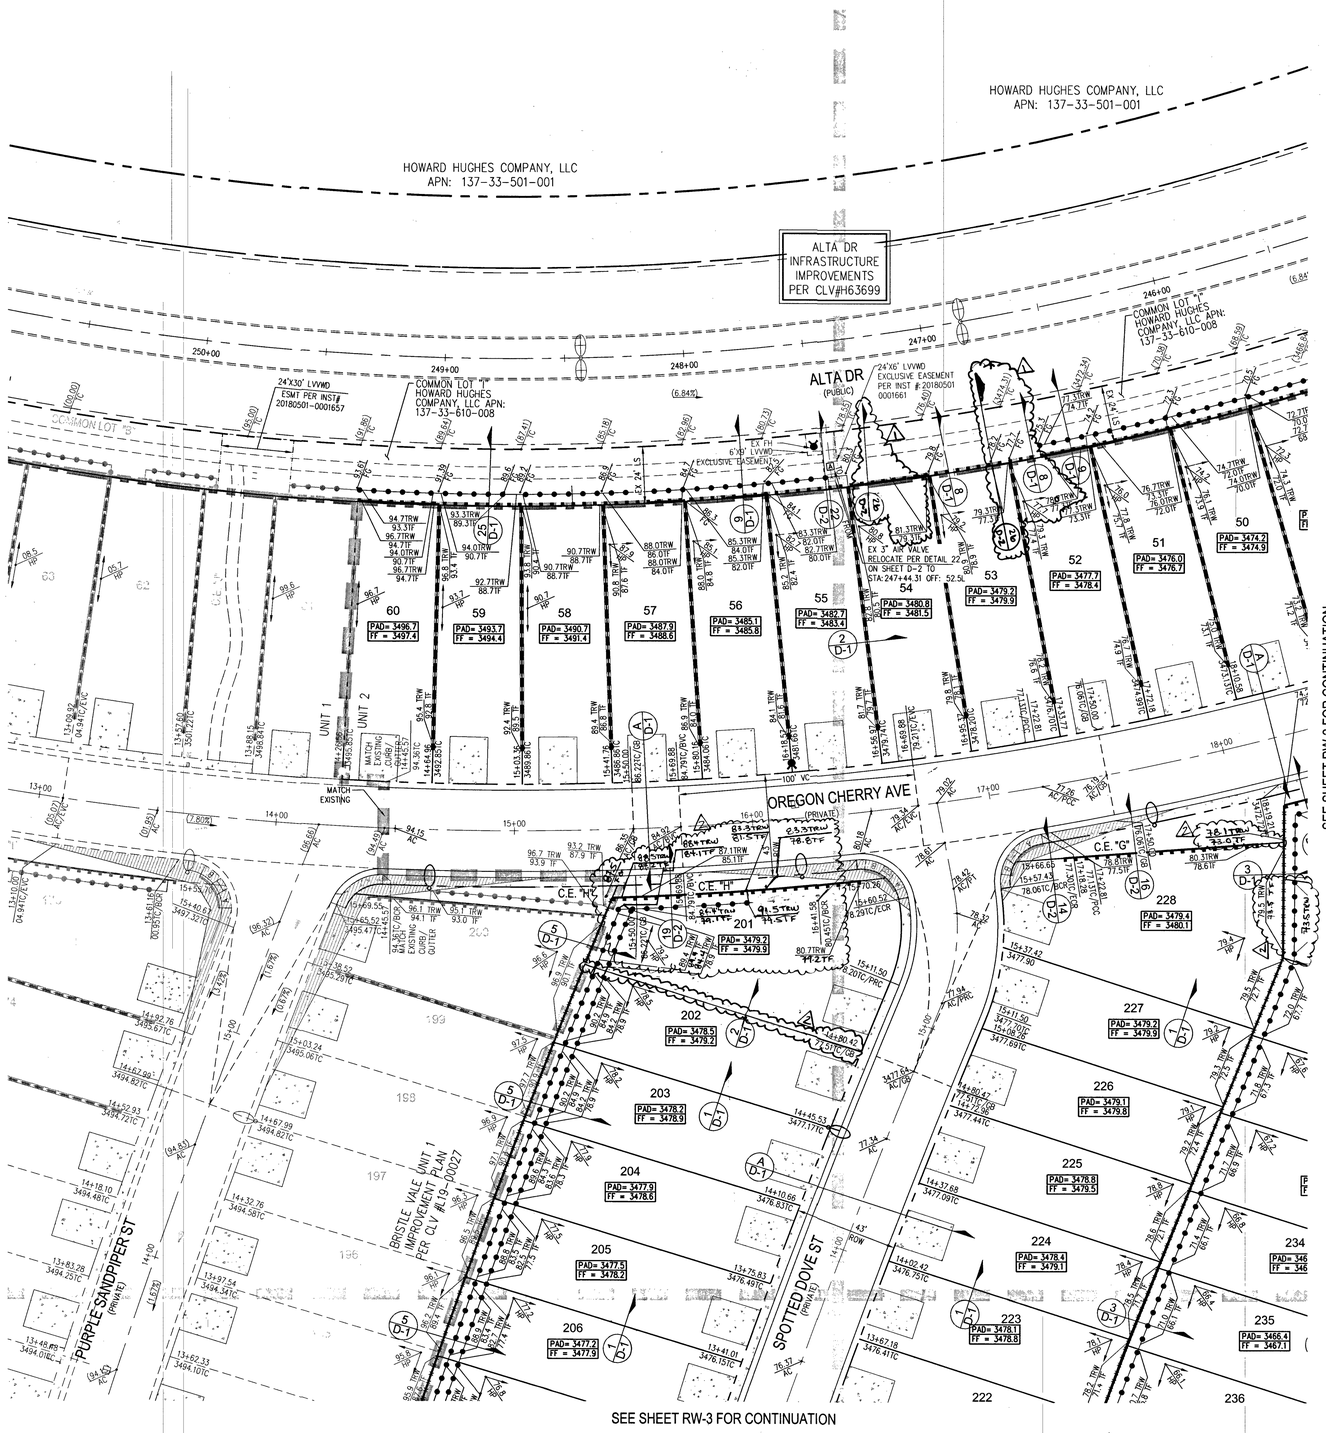

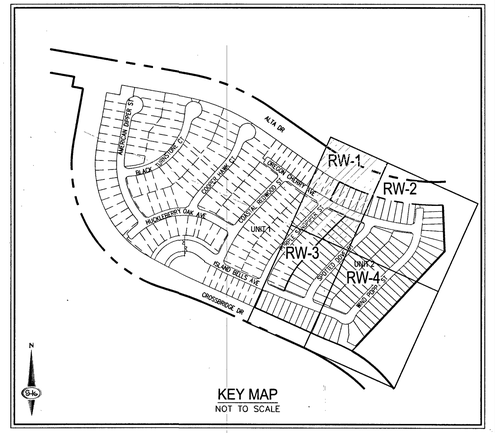

KEY MAP
NOT TO SCALE

SCALE – 1"=30' (0, 30, 60 FEET)

BASIS OF BEARINGS

NORTH 05°59'55" WEST, BEING THE BEARING OF THE WEST LINE OF SECTION 34, TOWNSHIP 20 SOUTH, RANGE 59 EAST, M.D.M., CITY OF LAS VEGAS, CLARK COUNTY, NEVADA, AS SHOWN BY MAP THEREOF ON FILE IN THE CLARK COUNTY, NEVADA RECORDER'S OFFICE IN BOOK 135, PAGE 71 OF PLATS.

BENCHMARK

CITY OF LAS VEGAS BENCHMARK 7LV09 34SW6

RIVET AND ROUND PLATE IN TME TOP OF CURB AT THE SOUTHEAST CORNER OF DESERT MOON RD. AND SKY VISTA DR.
ELEVATION = 1011.422 METERS (NAVD '88)
ELEVATION = 3318.31 US SURVEY FEET (NAVD '88)

Call before you DigUnderGround
1-702-432-5300
FREEWAY & ARTERIAL SYSTEM OF TRANSPORTATION (F.A.S.T.)

AVOID HITTING OVERHEAD POWER LINES. IT'S COSTLY.
CALL BEFORE YOU DO OVERHEAD
1-702-227-2929

Call before you Dig
AVOID CUTTING UNDERGROUND UTILITY LINES. IT'S COSTLY.
Call 811 OR 1-800-227-2600

SLATER HANIFAN GROUP
CONSULTING ENGINEERS & PLANNERS
5740 S. ARVILLE STREET #216, LAS VEGAS, NV 89118
PHONE (702) 284-5300 FAX (702) 284-5399

NO	DESCRIPTION	DATE	BY	APP. DATE	APP.
1	REVISE RETAINING WALLS	7/16/19	TM	7/16/19	
2	REVISE GRADING	11/14/19	MJE	11/14/19	

LAS VEGAS, NV

KB HOME

BRISTLE VALE - UNIT 2

RETAINING WALL PLAN I

S 33
T 20S
R 59E

DATE: 5/8/19
DRAFTER: OQ
DESIGNER: OQ
CHECKED: DSP

PROJECT NO.
KBH1804-000

PROFESSIONAL ENGINEER — TIMOTHY M. MULROONEY — Exp. 12/31/2019 — CIVIL — STATE OF NEVADA — No. 22938
5/8/19

RW-1
SHEET 17 OF 29

L19-00527
107Y5102-2

x:\kbh1804-000 summerlin v24 parcel 18\dwg\improv\phase 2\kbh1804-000 wall p2.dwg, 5/8/2019 3:15 PM, Oscar Quiroz

0 30 60
SCALE - 1"=30' FEET

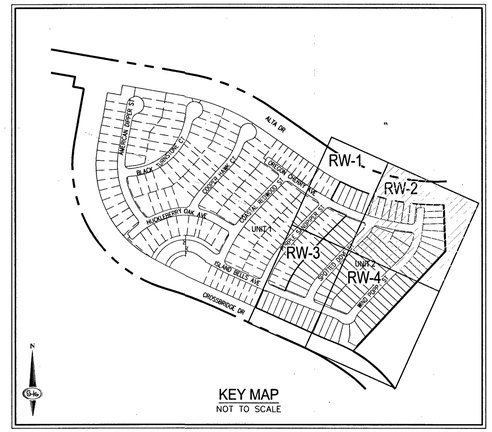

KEY MAP
NOT TO SCALE

BASIS OF BEARINGS

NORTH 05°59'55" WEST, BEING THE BEARING OF THE WEST LINE OF SECTION 34, TOWNSHIP 20 SOUTH, RANGE 59 EAST, M.D.M., CITY OF LAS VEGAS, CLARK COUNTY, NEVADA, AS SHOWN BY MAP THEREOF ON FILE IN THE CLARK COUNTY, NEVADA RECORDER'S OFFICE IN BOOK 135, PAGE 71 OF PLATS.

BENCHMARK

CITY OF LAS VEGAS BENCHMARK 7LV09 34SW6

RIVET AND ROUND PLATE IN THE TOP OF CURB AT THE SOUTHEAST CORNER OF DESERT MOON RD. AND SKY VISTA DR.
ELEVATION = 1011.422 METERS (NAVD '88)
ELEVATION = 3318.31 US SURVEY FEET (NAVD '88)

FAST
Call before you UnderGround
1-702-432-5300
FREEWAY & ARTERIAL SYSTEM OF TRANSPORTATION (F.A.S.T.)

AVOID HITTING OVERHEAD POWER LINES. IT'S COSTLY.
CALL BEFORE YOU DIG OVERHEAD
1-702-227-2929

Call before you Dig
AVOID CUTTING UNDERGROUND UTILITY LINES. IT'S COSTLY.
Call 811
OR
1-800-227-2600

SLATER HANIFAN GROUP
CONSULTING ENGINEERS & PLANNERS
5740 S. ARVILLE STREET #216, LAS VEGAS, NV 89118
PHONE (702) 284-5300 FAX (702) 284-5399

NO.	DESCRIPTION	DATE	BY	APP
1	REVISE RETAINING WALLS	06/11/19	PA	TM
2	BASIC GRADING	11/19/19	MG	TM

LAS VEGAS, NV

KB HOME
BRISTLE VALE - UNIT 2
RETAINING WALL PLAN II

S 33
T 20S
R 59E

DATE: 5/8/19
DRAFTER: OQ
DESIGNER: OQ
CHECKED: DSP

PROJECT NO.
KBH1804-000

PROFESSIONAL ENGINEER
TIMOTHY M. MULROONEY
Exp. 12/31/2019
CIVIL
No. 22938
STATE OF NEVADA
5/8/19

RW-2
SHEET 18 OF 29

L19-00527
107Y5102-2

J:\kbh1804-000 summerlin_v24 parcel I&m\dwg\improv\phase 2\kbh1804-000 wall p2.dwg 5/8/2019 3:16 PM Oscar Quiroz

SEE SHEET RW-1 FOR CONTINUATION

SEE SHEET RW-4 FOR CONTINUATION

SCALE – 1"=30' (0 30 60 FEET)

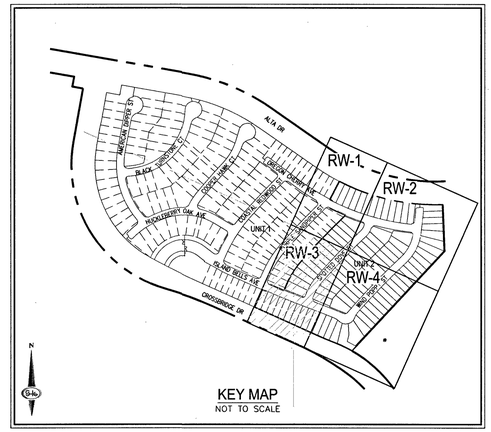

BASIS OF BEARINGS

NORTH 05°59'55" WEST, BEING THE BEARING OF THE WEST LINE OF SECTION 34, TOWNSHIP 20 SOUTH, RANGE 59 EAST, M.D.M., CITY OF LAS VEGAS, CLARK COUNTY, NEVADA, AS SHOWN BY MAP THEREOF ON FILE IN THE CLARK COUNTY, NEVADA RECORDER'S OFFICE IN BOOK 135, PAGE 71 OF PLATS.

BENCHMARK

CITY OF LAS VEGAS BENCHMARK 7LV09 34SW6

RIVET AND ROUND PLATE IN THE TOP OF CURB AT THE SOUTHEAST CORNER OF DESERT MOON RD. AND SKY VISTA DR.
ELEVATION = 1011.422 METERS (NAVD '88)
ELEVATION = 3318.31 US SURVEY FEET (NAVD '88)

FAST Call before you UnderGround 1-702-432-5300 FREEWAY & ARTERIAL SYSTEM OF TRANSPORTATION (F.A.S.T.)

AVOID HITTING OVERHEAD POWER LINES. IT'S COSTLY. CALL BEFORE YOU DO OVERHEAD 1-702-227-2929

Call before you Dig AVOID CUTTING UNDERGROUND UTILITY LINES. IT'S COSTLY. Call 811 OR 1-800-227-2600

SLATER HANIFAN GROUP
CONSULTING ENGINEERS & PLANNERS
5740 S. ARVILLE STREET #216, LAS VEGAS, NV 89118
PHONE (702) 284-5300 FAX (702) 284-5399

NO	DESCRIPTION	DATE	BY	APP.
1	REVISE RETAINING WALLS & GRADE PADS	09/11/19	PA	TH
2	REVISE GRADING	11-20-19	PA	TH

LAS VEGAS, NV

KB HOME

BRISTLE VALE - UNIT 2

RETAINING WALL PLAN III

S 33 T 20S R 59E

DATE: 5/8/19
DRAFTER: OQ
DESIGNER: OQ
CHECKED: DSP

PROJECT NO.
KBH1804-000

PROFESSIONAL ENGINEER — TIMOTHY M. MULROONEY — Exp. 12/31/2019 — CIVIL — No. 22938 — STATE OF NEVADA
5/8/19

RW-3
SHEET 19 OF 29

L19-00527
107YS102-2

I:\kbh1804-000 summerlin -v24 parcel 18m\dwg\improv\phase 2\kbh1804-000 wall p2.dwg 5/8/2019 3:16 PM Oscar Quiroz

SEE SHEET RW-2 FOR CONTINUATION

SEE SHEET RW-3 FOR CONTINUATION

SCALE = 1"=30' (0, 30, 60 FEET)

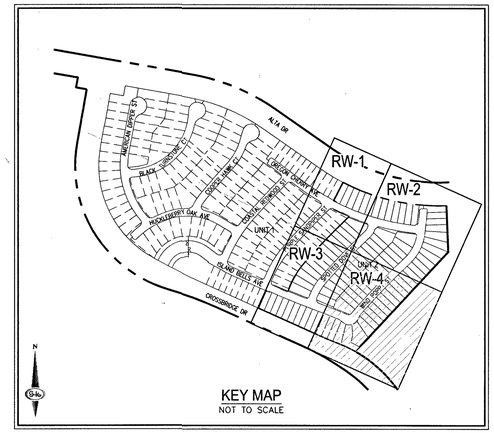

KEY MAP
NOT TO SCALE

BASIS OF BEARINGS

NORTH 05°59'55" WEST, BEING THE BEARING OF THE WEST LINE OF SECTION 34, TOWNSHIP 20 SOUTH, RANGE 59 EAST, M.D.M., CITY OF LAS VEGAS, CLARK COUNTY, NEVADA, AS SHOWN BY MAP THEREOF ON FILE IN THE CLARK COUNTY, NEVADA RECORDER'S OFFICE IN BOOK 135, PAGE 71 OF PLATS.

BENCHMARK

CITY OF LAS VEGAS BENCHMARK 7LV09 34SW6

RIVET AND ROUND PLATE IN THE TOP OF CURB AT THE SOUTHEAST CORNER OF DESERT MOON RD. AND SKY MISTA DR.
ELEVATION = 1011.422 METERS (NAVD '88)
ELEVATION = 3318.31 US SURVEY FEET (NAVD '88)

DORAL ACADEMY RED ROCK ELEMENTARY & UPPER/HIGH SCHOOL
APN: 137-34-219-001

SPOTTED DOVE ST (PRIVATE)

WIND POPPY ST (PRIVATE)

ISLAND BELLS AVE (PRIVATE)

CROSSBRIDGE DR (PUBLIC)

COMMON LOT "K"
HOWARD HUGHES COMPANY, LLC
APN: 137-33-610-009

CROSSBRIDGE DR INFRASTRUCTURE IMPROVEMENTS PER CLV#H65246

FAST Call before you UnderGround 1-702-432-5300 FREEWAY & ARTERIAL SYSTEM OF TRANSPORTATION (F.A.S.T)

AVOID HITTING OVERHEAD POWER LINES. IT'S COSTLY. CALL BEFORE YOU DO OVERHEAD 1-702-227-2929

Call before you Dig AVOID CUTTING UNDERGROUND UTILITY LINES. IT'S COSTLY. Call 811 OR 1-800-227-2600

SLATER HANIFAN GROUP
CONSULTING ENGINEERS & PLANNERS
5740 S. ARVILLE STREET #216, LAS VEGAS, NV 89118
PHONE (702) 284-5300 FAX (702) 284-5399

NO.	DESCRIPTION	DATE	BY	APP.	APP. DATE
1	REVISE RETAINING WALLS & PROP. INVERTS	09/11/19	PA	Wesley	

LAS VEGAS, NV

KB HOME
BRISTLE VALE - UNIT 2
RETAINING WALL PLAN IV

S 33
T 20S
R 59E

DATE: 5/8/19
DRAFTER: OQ
DESIGNER: OQ
CHECKED: DSP

PROJECT NO.
KBH1804-000

PROFESSIONAL ENGINEER — STATE OF NEVADA — TIMOTHY M. MULROONEY — Exp. 12/31/2019 — CIVIL — No. 22938 — 5/8/19

RW-4
SHEET 20 OF 29

L19-00527
107Y5102-2

J:\kbh1804-000 summerlin -j24 parcel 18\mr\dwg\Xrefs\xrefs 2\kbh1804-000 wall p2.dwg 5/8/2019 3:17 PM Oscar Quiroz

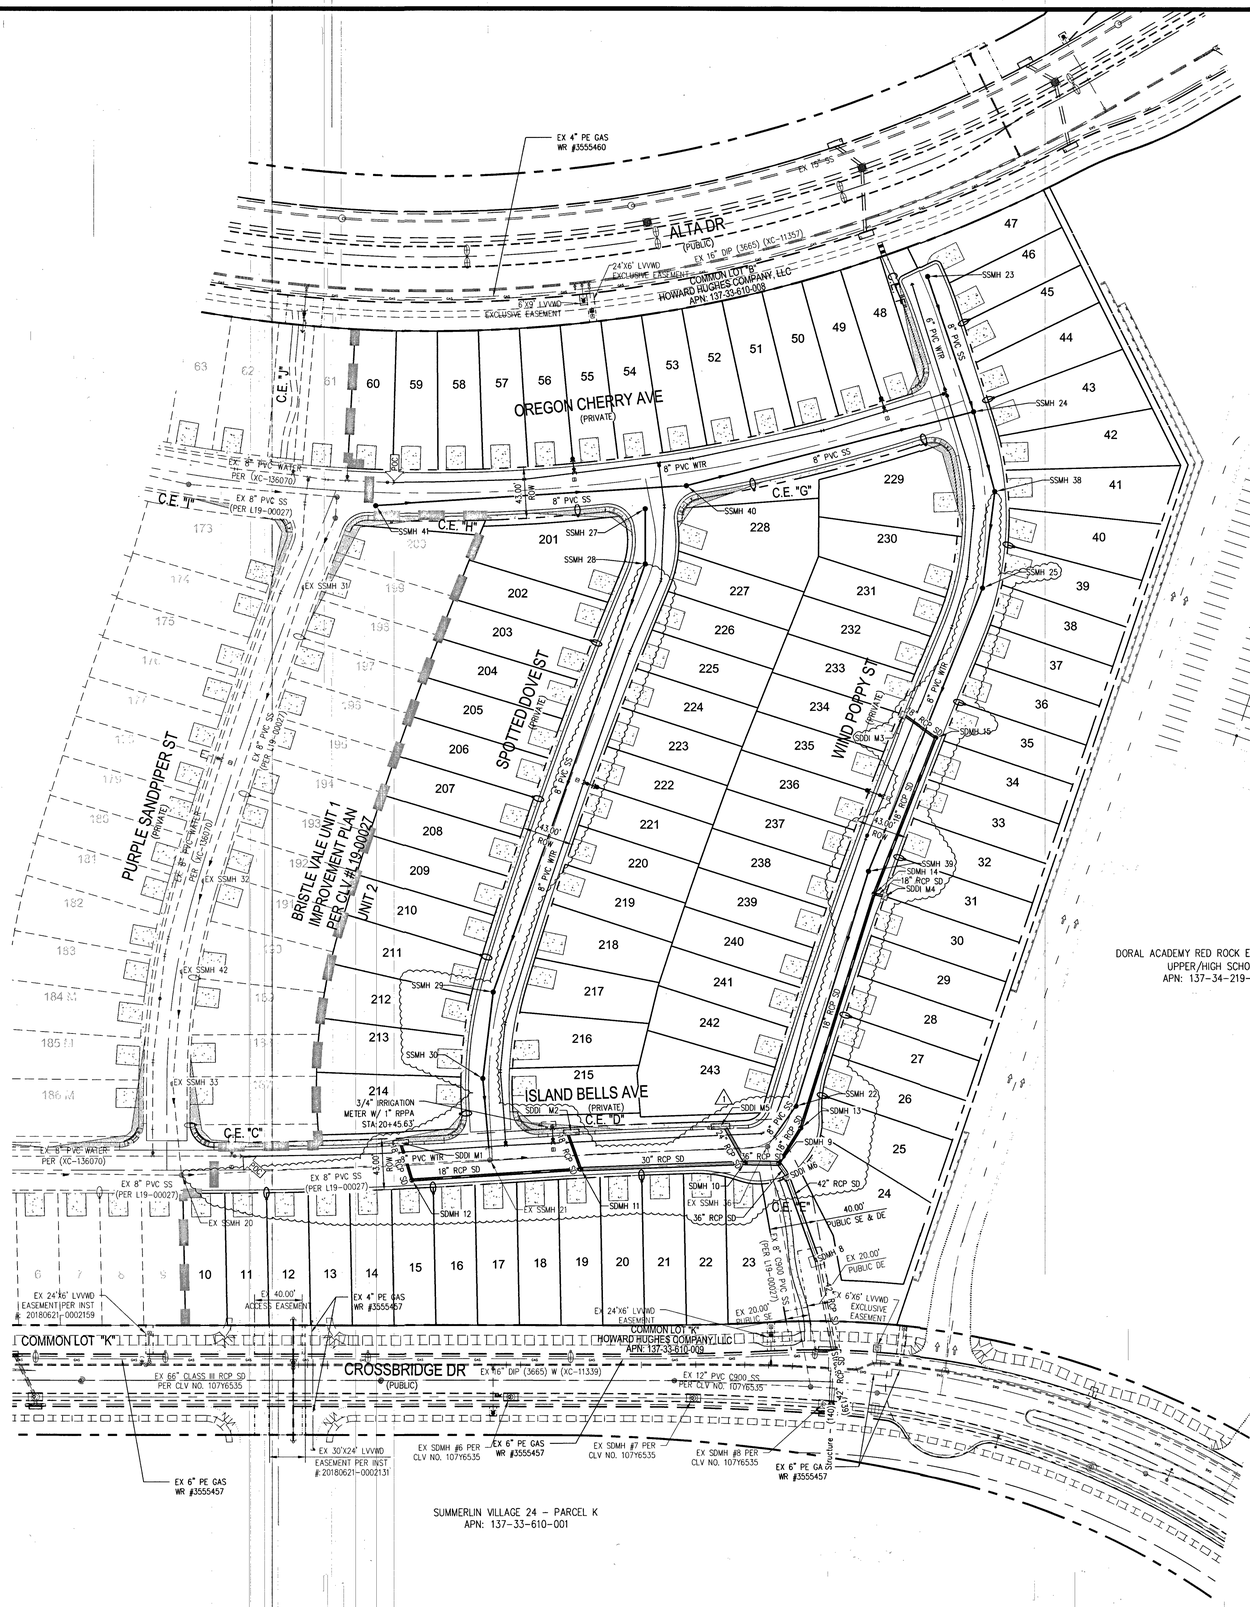

N

S-H-G

0 60 120

SCALE – 1"=60' FEET

NOTE

ALL PRIVATE STREETS ARE PUBLIC UTILITY, CLV SEWER & PUBLIC DRAINAGE EASEMENTS TO BE PRIVATELY MAINTAINED BY HOA.

DISCLAIMER NOTE

EXISTING UTILITY LOCATIONS SHOWN HEREON ARE APPROXIMATE ONLY. IT SHALL BE THE CONTRACTOR'S RESPONSIBILITY TO DETERMINE THE EXCEPT VERTICAL AND HORIZONTAL LOCATION OF ALL EXISTING UNDERGROUND UTILITIES PRIOR TO COMMENCING CONSTRUCTION. NO REPRESENTATION IS MADE THAT ALL EXISTING UTILITIES ARE SHOWN HEREON. THE ENGINEER ASSUMES NO RESPONSIBILITY FOR UTILITIES NOT SHOWN IN THEIR PROPER LOCATION.

EXISTING SERVICES

IF ANY OF THE EXISTING SERVICES ARE INCORRECTLY LOCATED OR NOT USED FOR ANY REASON, THE DEVELOPER SHALL ABANDON THE LATERALS AT THE CONNECTION TO THE ACTIVE MAIN IN ACCORDANCE WITH THE UDACS STANDARDS, & AT THE DEVELOPER'S EXPENSE.

ESTIMATED AVERAGE DAILY SEWER CONTRIBUTIONS

94 UNITS X 250 GPD/UNIT = 23,500 GPD = 0.02350 MGD
TOTAL PEAK FLOW = 0.03725 X 3.75 (PEAK FACTOR) = 0.1397 MGD

FIRE SPRINKLER SYSTEMS SHALL BE PLUMBED TO THE MASTER TOILET. NO EXCEPTIONS ALLOWED

STATIC PRESSURE NOTE

EXCESS PRESSURE FOR LOTS 12-53 AND 201-243

THIS PROPERTY MAY HAVE STATIC WATER PRESSURE IN EXCESS OF 80 PSI. THE UNIFORM PLUMBING CODE REQUIRES THAT INDIVIDUAL, ON-SITE (PRIVATE), PRESSURE-REDUCING VALVES BE INSTALLED WHENEVER THE PRESSURE EXCEEDS 80 PSI. PRV'S ARE THE DEVELOPER'S RESPONSIBILITY AND WILL NOT BE INSPECTED OR INCLUDED IN THE ACCEPTANCE OF LVVWD UTILITIES.

EASEMENT NOTES

1. ALL PRIVATE STREETS ARE P.U.E., PUBLIC SEWER EASEMENTS AND PUBLIC DRAINAGE EASEMENTS TO BE PRIVATELY MAINTAINED BY HOA.
2. ALL COMMON ELEMENTS ARE PUBLIC DRAINAGE EASEMENTS TO BE PRIVATELY MAINTAINED.

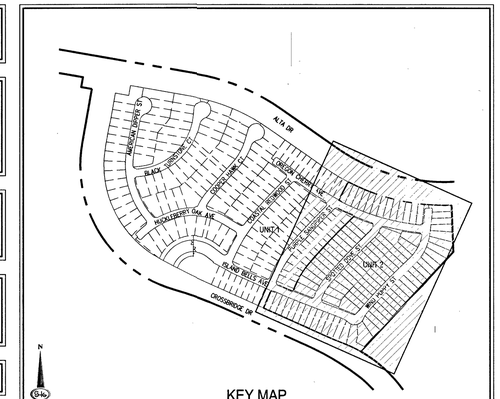

KEY MAP
NOT TO SCALE

FIRE FLOW CALCULATIONS

FIRE FLOW 1,500 GPM AT 20 P.S.I. RESIDUAL.

USE/OCCUPANCY	SINGLE FAMILY
TYPE OF CONSTRUCTION (IBC)	TYPE V-B
SQUARE FOOTAGE	<3600
LARGEST AREA BETWEEN 4 HOUR WALLS	N/A
BUILDING HEIGHT	<35
NO OF STORIES INCLUDING BASEMENT	2
FIRE SPRINKLER	YES (13D)
NO OF HYDRANTS INSTALLED	5

SOUTHWEST GAS APPROVAL

SOUTHWEST GAS CORPORATION — DATE 9/12

TO ENSURE LVVWD ACCESS WITHIN EASEMENT

ALL ABOVE GROUND OBSTRUCTIONS INCLUDING BUT NOT LIMITED TO LANDSCAPE BOULDERS, FENCES/WALLS, AND SIGNS ARE STRICTLY PROHIBITED WITHIN EASEMENT.

APPROVAL

LAS VEGAS FIRE AND RESCUE — DATE 9/12/19

WATER NOTES

REDUCED PRESSURE PRINCIPLE ASSEMBLY (1) 1"

APPROVED REDUCED PRESSURE PRINCIPLE ASSEMBLY(S) SHALL BE INSTALLED PER THE UDACS PLATE NO. 8. NO WATER SHALL BE TAKEN FROM A SERVICE REQUIRING BACKFLOW PREVENTION UNTIL THE REDUCED PRESSURE PRINCIPLE ASSEMBLY HAS BEEN SUCCESSFULLY TESTED BY THE LVVWD. ANY BLOCK WALL OR OTHER FENCE MATERIAL SHALL BE DESIGNED AND CONSTRUCTED AROUND THE OUTSIDE OF THE EASEMENT(S) TO ALLOW THE DISTRICT DIRECT ACCESS FROM THE ADJACENT RIGHT-OF-WAY. EASEMENTS SHALL BE CLEARLY MARKED OR STAKED PRIOR TO THE START OF CONSTRUCTION.

APPROVED FOR CONSTRUCTION

LAS VEGAS VALLEY WATER DISTRICT ENGINEERING SERVICES — 9-23-19

PROJECT NO 136382 FIRST APPROVED DATE: 5/13/19
LVVWD APPROVED FIRE FLOW 1,500 GPM AT 20 PSI RESIDUAL
MAXIMUM AVAILABLE FIRE SPRINKLER FLOW 30 GPM

FAST — Call before you UnderGround 1-702-432-5300 FREEWAY & ARTERIAL SYSTEM OF TRANSPORTATION (F.A.S.T)

AVOID HITTING OVERHEAD POWER LINES. IT'S COSTLY. CALL BEFORE YOU DO OVERHEAD 1-702-227-2929

Call before you Dig — AVOID CUTTING UNDERGROUND UTILITY LINES. IT'S COSTLY. Call 811 OR 1-800-227-2600

SLATER HANIFAN GROUP
a Westwood team
5740 S. ARVILLE STREET #216, LAS VEGAS, NV 89118
PHONE (702) 284-5300
FAX (702) 284-5399

NO.	DESCRIPTION	DATE	BY	APP	APP DATE
1	LAND, STORM DRAIN, AND SEWER	07/17/19	PA		

LAS VEGAS, NV

KB HOME

BRISTLE VALE - UNIT 2

MASTER UTILITY PLAN

S 33 T 20S R 59E

DATE: 5/8/19
DRAFTER: OQ
DESIGNER: OQ
CHECKED: DSP

PROJECT NO.
KBH1804-000

TIMOTHY M. MULROONEY — Exp. 12/31/2019 — CIVIL — No. 22938 — STATE OF NEVADA — PROFESSIONAL ENGINEER
9/11/19

MU-1

SHEET 21 OF 29

L19-00527
107Y5102-2

PROJ#:136382A QS:137-33-NE

J:\kbh1804-000 summerlin (24 parcel (4em \dwg\mprov\phase 2\kbh1804-000 mul #2.dwg 9/11/2019 1:51 PM Preston Aygl

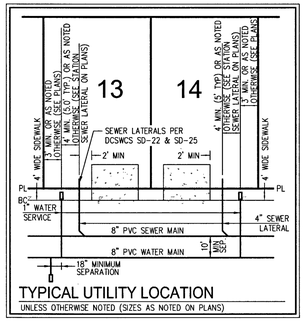

TYPICAL UTILITY LOCATION

UNLESS OTHERWISE NOTED (SIZES AS NOTED ON PLANS)

NOTES:
1. SEE DCSWCS SD-22 & SD-23 FOR SEWER LATERALS.
2. CURB SHALL BE STAMPED WITH AN "S" PER DCSWCS SD-25.
3. SEPARATION FROM WATER MAIN TO BE IN COMPLIANCE WITH UDACS SECTION 2.22.03.

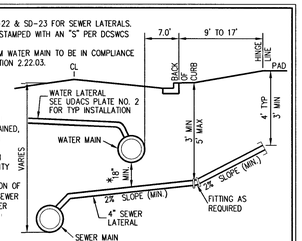

* IF 18" SEPARATION CANNOT BE MAINTAINED, THE ENTIRE SEWER LATERAL TO BE CONSTRUCTED WITH C900 WATER QUALITY MATERIALS AND A MINIMUM SEPARATION OF 6" BETWEEN THE SEWER LATERAL AND WATER MAIN MUST BE MAINTAINED.

TYPICAL WATER & SEWER LATERAL DETAIL

PER UDACS SECT. 2.22

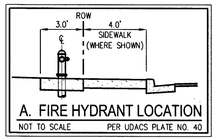

A. FIRE HYDRANT LOCATION

NOT TO SCALE PER UDACS PLATE NO. 40

NOTE

ALL PRIVATE STREETS ARE PUBLIC UTILITY, CLV SEWER & PUBLIC DRAINAGE EASEMENTS TO BE PRIVATELY MAINTAINED BY HOA.

DISCLAIMER NOTE

EXISTING UTILITY LOCATIONS SHOWN HEREON ARE APPROXIMATE ONLY. IT SHALL BE THE CONTRACTOR'S RESPONSIBILITY TO DETERMINE THE EXCEPT VERTICAL AND HORIZONTAL LOCATION OF ALL EXISTING UNDERGROUND UTILITIES PRIOR TO COMMENCING CONSTRUCTION. NO REPRESENTATION IS MADE THAT ALL EXISTING UTILITIES ARE SHOWN HEREON. THE ENGINEER ASSUMES NO RESPONSIBILITY FOR UTILITIES NOT SHOWN IN THEIR PROPER LOCATION.

STATIC PRESSURE NOTE

EXCESS PRESSURE FOR LOTS 12-53 AND 201-243

THIS PROPERTY MAY HAVE STATIC PRESSURE IN EXCESS OF 80 PSI. THE UNIFORM PLUMBING CODE REQUIRES THAT INDIVIDUAL, ON-SITE (PRIVATE), PRESSURE REDUCING VALVES (PRV) BE INSTALLED WHENEVER THE PRESSURE EXCEEDS 80 PSI. PRV'S ARE THE DEVELOPER'S RESPONSIBILITY AND WILL NOT BE INSPECTED OR INCLUDED IN THE ACCEPTANCE OF LVVWD FACILITIES.

ABANDONED VAVLVES CUT AND CAP

ALL VALVES TO BE ABANDONED SHALL BE ABANDONED IN THE CLOSED POSITION, UNLESS SHOWN OTHERWISE, BY REMOVING A MINIMUM OF THE TOP TWENTY-FOUR (24) INCHES OF THE VALVE BOX, AND THEN FILLING THE BOTTOM OF THE BOX WITH A MINIMUM OF EIGHT (8) INCHES OF SAND OR TYPE II AGGREGATE BASE, THE REMAINING PORTION OF THE VALVE BOX SHALL BE FILLED WITH CONCRETE HAVING A COMPRESSIVE STRENGTH OF AT LEAST TWO THOUSAND (2000) PSI. THE LATERAL MUST BE CUT WITHIN ONE (1) FOOT OF THE ABANDONED VALVE, OR AS SHOWN ON PLANS, AND CAPPED, IN ACCORDANCE WITH THE PROVISION OF UDACS PLATE NO. 31.

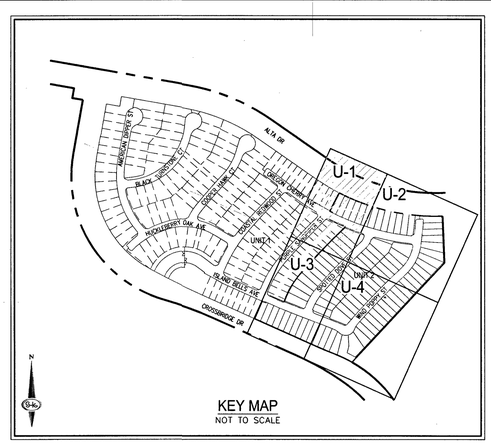

KEY MAP

NOT TO SCALE

0 30 60

SCALE - 1"=30' FEET

FIRE FLOW CALCULATIONS

FIRE FLOW 1,500 GPM AT 20 P.S.I. RESIDUAL.

USE/OCCUPANCY	SINGLE FAMILY
TYPE OF CONSTRUCTION (IBC)	TYPE V-B
SQUARE FOOTAGE	<3600
LARGEST AREA BETWEEN 4 HOUR WALLS	N/A
BUILDING HEIGHT	<35
NO OF STORIES INCLUDING BASEMENT	2
FIRE SPRINKLER	YES (13D)
NO OF HYDRANTS INSTALLED	5

BENCHMARK

CITY OF LAS VEGAS BENCHMARK 7LV09 34SW6

RIVET AND ROUND PLATE IN THE TOP OF CURB AT THE SOUTHEAST CORNER OF DESERT MOON RD. AND SKY VISTA DR.
ELEVATION = 1011.422 METERS (NAVD '88)
ELEVATION = 3318.31 US SURVEY FEET (NAVD '88)

BASIS OF BEARINGS

NORTH 05°59'55" WEST, BEING THE BEARING OF THE WEST LINE OF SECTION 34, TOWNSHIP 20 SOUTH, RANGE 59 EAST, M.D.M., CITY OF LAS VEGAS, CLARK COUNTY, NEVADA, AS SHOWN BY MAP THEREOF ON FILE IN THE CLARK COUNTY, NEVADA RECORDER'S OFFICE IN BOOK 135, PAGE 71 OF PLATS.

EASEMENT NOTES

1. ALL PRIVATE STREETS ARE P.U.E., PUBLIC SEWER EASEMENTS AND PUBLIC DRAINAGE EASEMENTS TO BE PRIVATELY MAINTAINED BY HOA.
2. ALL COMMON ELEMENTS ARE PUBLIC DRAINAGE EASEMENTS TO BE PRIVATELY MAINTAINED.

LVVWD NOTES

1. FIRE SPRINKLER SYSTEMS SHALL BE PLUMBED TO THE MASTER TOILET. NO EXCEPTIONS ALLOWED
2. SERVICE LATERALS FOR LOTS: 10 AND 60 WILL BE TAPPED ON EXISTING MAIN BY OWNER CONTRACTOR UNDER DIRECTION OF THE LVVWD
3. DROP INLET NOTE
WHERE 10 FEET PARALLEL SEPARATION IS NOT PRACTICABLE

CAST-IN-PLACE MONOLITHIC POUR WITH WATERSTOP BETWEEN SLAB AND WALLS. BASE, WALLS AND TOP TO BE CONSTRUCTED WITH WATERSTOPS, CENTER BULB, OR FLAT STRIP (VINYLEX, GREENSTREAK PLASTIC PRODUCTS OR APPROVED EQUAL)

4. PROTECT IN PLACE AND ADJUST LVVWD EXISTING FACILITIES TO FINISHED GRADE PER UDACS. ALL LVVWD FACILITIES SHALL BE ACCESSIBLE AT ALL TIMES

WATER NOTES

1. INSTALL 8" PVC WATER PIPE (3665 WPZ)
2. INSTALL 6" PVC WATER PIPE (3665 WPZ)
3. INSTALL 5' BEND PER UDACS PLATE NO. 31
4. INSTALL 11.25' BEND PER UDACS PLATE NO. 31
5. INSTALL 22.5' BEND PER UDACS PLATE NO. 31
6. INSTALL 45' BEND PER UDACS PLATE NO. 31
7. INSTALL CAP AND 2" BLOWOFF VALVE PER UDACS PLATE NO. 36
8. INSTALL 8"x6" REDUCER PER UDACS PLATE NO. 30
9. INSTALL 6" GATE VALVE WITH VALVE BOX PER UDACS PLATE NO. 30 & 39
10. INSTALL 8"x8" TEE PER UDACS PLATE NO. 31
11. INSTALL FIRE HYDRANT ASSEMBLY W/6" GATE VALVE PER UDACS PLATE NO. 40
12. INSTALL 8"x6" TEE PER UDACS PLATE NO. 31
13. INSTALL 1" COPPER SERVICE W/ 3/4" IRRIGATION METER AND 1" RPPA PER UDACS PLATE NO. 4 & 8. SEE DETAIL ON SHEET D-2 FIELD VERIFY LOCATION. REMOVE CAP AND BLOW OFF VALVE PER UDACS PLATE NO. 36 & CONNECT TO EX. 8" PVC WATER PIPE
14. INSTALL 2-4" SCH-90 PVC (IRRIGATION) SLEEVES
15. INSTALL 1" COPPER SERVICE W/ 3/4" METER PER UDACS PLATE NO. 1

SEWER NOTES

1. INSTALL 8" PVC SANITARY SEWER PER DCSWCS SD-15 & SD-17
2. INSTALL 48" DIAMETER SANITARY SEWER MANHOLE WITH PRECAST BASE PER DCSWCS SD-1A, SD-1B, SD-4, SD-9, AND SINGLE LID (24")
3. INSTALL 4" PVC SEWER LATERAL PER DCSWCS SD-22 & SD-25.
4. EXISTING 48" DIAMETER SANITARY SEWER MANHOLE PER PHASE 1 IMPROVEMENT PLANS CLV #L19-00027 (107Y5102)
5. REMOVE CAP AND CONNECT TO EXISTING 8" SS
6. INSTALL SANITARY SEWER CLEANOUT WITH TRAFFIC RATED LID IN DRIVEWAY PER DCSWCS SD-26
7. INSTALL 4" C900 PVC SEWER LATERAL PER DCSWCS SD-22& SD-25 FOR LOT 54 ONLY.
8. CONNECT SS LATERAL TO BRISTLE VALE UNIT 1 (CLV# (107Y5102)). WYE FITTING
9. MANHOLE SHALL BE CORROSION PROTECTED WITH FIELD APPLIED COATING PER DCSWCS SECTION 3.6.6B.

SEE SHEET C-3 FOR QUANTITIES AND ABBREVIATIONS

TO ENSURE LVVWD ACCESS WITHIN EASEMENT

ALL ABOVE GROUND OBSTRUCTIONS INCLUDING BUT NOT LIMITED TO LANDSCAPE BOULDERS, FENCES/WALLS, AND SIGNS ARE STRICTLY PROHIBITED WITHIN EASEMENT.

WATER NOTES

REDUCED PRESSURE PRINCIPLE ASSEMBLY (1) 1"
APPROVED REDUCED PRESSURE PRINCIPLE ASSEMBLY(S) SHALL BE INSTALLED PER THE UDACS PLATE NO. 8. NO WATER SHALL BE TAKEN FROM A SERVICE REQUIRING BACKFLOW PREVENTION UNTIL THE REDUCED PRESSURE PRINCIPLE ASSEMBLY HAS BEEN SUCCESSFULLY TESTED BY THE LVVWD. ANY BLOCK WALL OR OTHER FENCE MATERIAL SHALL BE DESIGNED AND CONSTRUCTED AROUND THE OUTSIDE OF THE EASEMENT(S) TO ALLOW THE DISTRICT DIRECT ACCESS FROM THE ADJACENT RIGHT-OF-WAY. EASEMENTS SHALL BE CLEARLY MARKED OR STAKED PRIOR TO THE START OF CONSTRUCTION.

GENERAL NOTES

1. FOR FIRE HYDRANT LOCATION, TYPICAL UTILITY LOCATION, AND TYPICAL SEWER LATERAL DETAIL SEE SHEET U-1
2. ALL SEWER/STORM DRAIN CROSSING WATER LINES MUST COMPLY WITH UDACS SECTION 2.22
3. NOTE: INSTALL PIPELINE MARKER BALLS, PER UDACS PLATE NO. 15
4. DEPTH OF COVER DURING CONSTRUCTION MAINTAIN MINIMUM TWENTY FOUR (24) INCH COVER PER UDACS SECTION 2.08.04. GRADING MUST BE COMPLETED PRIOR TO WATERLINE INSTALLATION.
5. ALL ABOVE GROUND UTILITY APPURTENANCES SHALL CONFORM TO THE REQUIREMENTS OF TITLE 19.06 & 19.08.
6. THE LVVWD CANNOT GUARANTEE A WATERTIGHT SHUTDOWN WHERE CONNECTIONS OR REPAIRS TO EXISTING FACILITIES ARE REQUIRED. THE CONTRACTOR SHALL ENSURE ALL LABOR AND EQUIPMENT IS AVAILABLE TO REMOVE REMAINING WATER. COORDINATION WITH INSPECTION DIVISION MUST TAKE PLACE PRIOR TO ANY TRIAL SHUTDOWN.CONTRACTOR TO INSTALL TEMPORARY SERVICE TO ENSURE PROPER SHUTDOWN IN THE EVENT NO OTHER APPURTENANCES ARE AVAILABLE.
* WATER TIGHT MANHOLE

FOR ALL DRY UTILITIES CROSSINGS

8. MAINTAIN MINIMUM 12" VERTICAL SEPARATION AT ALL POINTS OF CROSSING FOR DRY UTILITIES
9. MAINTAIN MINIMUM 3' PARALLEL SEPARATION FOR DRY UTILITIES.
10. ANY EXCAVATION AT BACK OF CURB MUST REMAIN OPEN FOR INSPECTION OF COPPER SERVICE LATERALS. ANY COPPER SERVICE LATERAL KINKED, BENT OR OTHERWISE DAMAGED MUST BE REPLACED FROM THE MAIN TO THE ANGLE METER STOP FOR DRY UTILITIES.

WATER MAIN JOINT DEFLECTION (PVC, 4"-24")

PVC PIPE SHALL BE DEFLECTED AT THE JOINT ONLY. THE MAXIMUM ALLOWABLE DEFLECTION SHALL BE ONE (1) DEGREE PER JOINT WITH A MINIMUM RADIUS OF CURVATURE OF 1,150 FEET, PER UDACS 2.07.01 AND 2.07.02.

FOR CHANGES IN DIRECTION EXCEEDING THE MAXIMUM ALLOWABLE JOINT DEFLECTION, FITTINGS SHALL BE USED.

APPROVAL

LAS VEGAS FIRE AND RESCUE — DATE 5/9/19

APPROVED FOR CONSTRUCTION

LAS VEGAS VALLEY WATER DISTRICT ENGINEERING SERVICES

PROJECT NO. 136382 FIRST APPROVED DATE: 5/13/19
LVVWD APPROVED FIRE FLOW 1,500 GPM AT 20 PSI RESIDUAL
MAXIMUM AVAILABLE FIRE SPRINKLER FLOW 30 GPM

SOUTHWEST GAS APPROVAL

SOUTHWEST GAS CORPORATION — DATE 5/9/19

FAST Call before you UnderGround 1-702-432-5300 FREEWAY & ARTERIAL SYSTEM OF TRANSPORTATION (F.A.S.T)

AVOID HITTING OVERHEAD POWER LINES. IT'S COSTLY. CALL BEFORE YOU DO OVERHEAD 1-702-227-2929

Call before you Dig AVOID CUTTING UNDERGROUND UTILITY LINES. IT'S COSTLY. Call 811 OR 1-800-227-2600

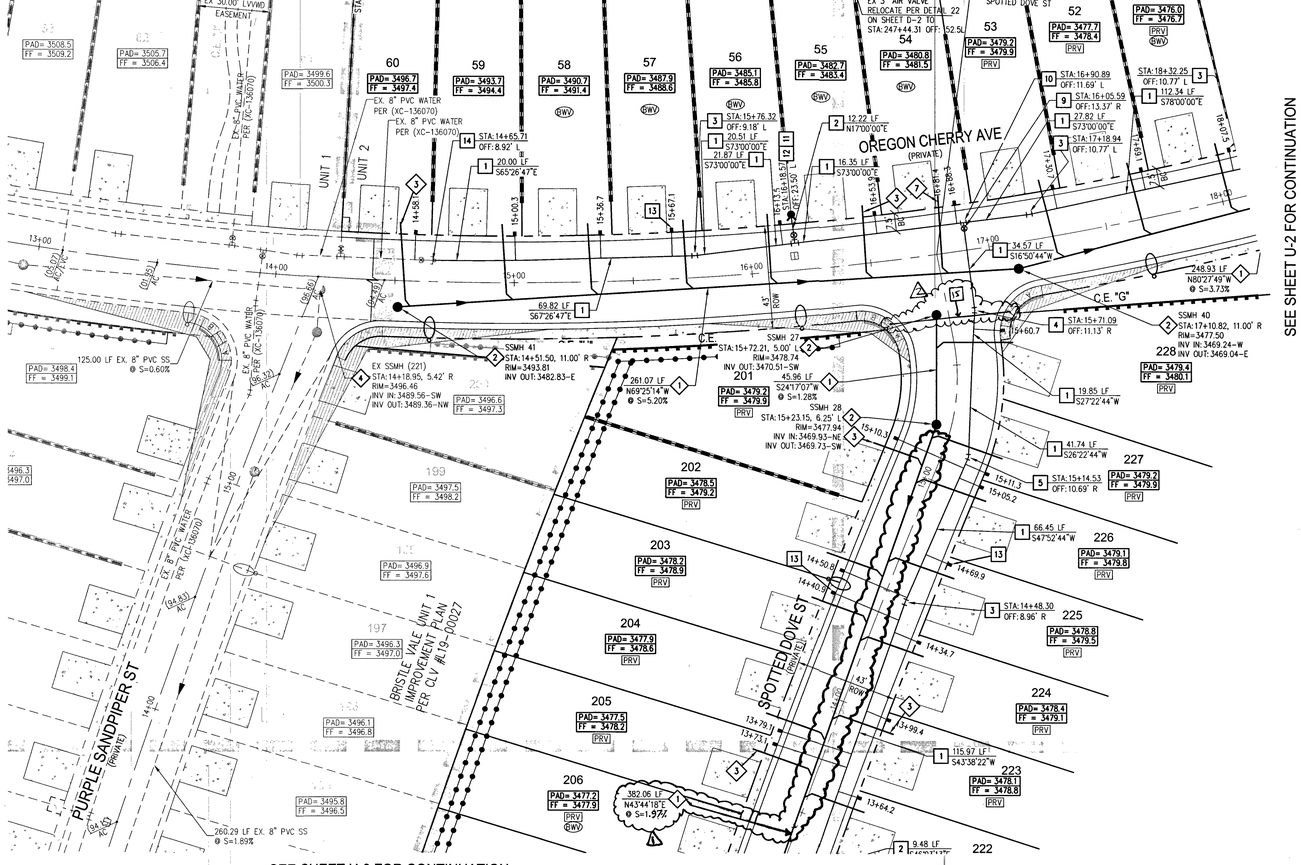

SEE SHEET U-3 FOR CONTINUATION

SEE SHEET U-2 FOR CONTINUATION

SLATER HANIFAN GROUP
CONSULTING ENGINEERS & PLANNERS
5740 S. ARVILLE STREET #216, LAS VEGAS, NV 89118
PHONE (702) 284-5300 FAX (702) 284-5399

NO.	DESCRIPTION	DATE	BY	APP.	APP. DATE
1	REVISE STORM DRAIN AND SEWER PER CLV COMMENTS	5/8/19	PA	[illegible]	[illegible]

LAS VEGAS, NV

KB HOME

BRISTLE VALE - UNIT 2

UTILITY PLAN I

33 20S 59E

DATE: 5/8/19
DRAFTER: OQ
DESIGNER: OQ
CHECKED: DSP

PROJECT NO.
KBH1804-000

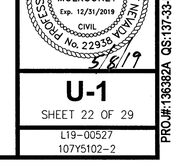

5/8/19

U-1

SHEET 22 OF 29

L19-00527
107Y5102-2

PROJ.#:136382A QS:137-33-NE

I:\kbh1804-000 summerlin_v24 parcel l&m\dwg\mercy\chase 2\kbh1804-000 util p2.dwg 5/8/2019 3:18 PM Oscar Quiroz

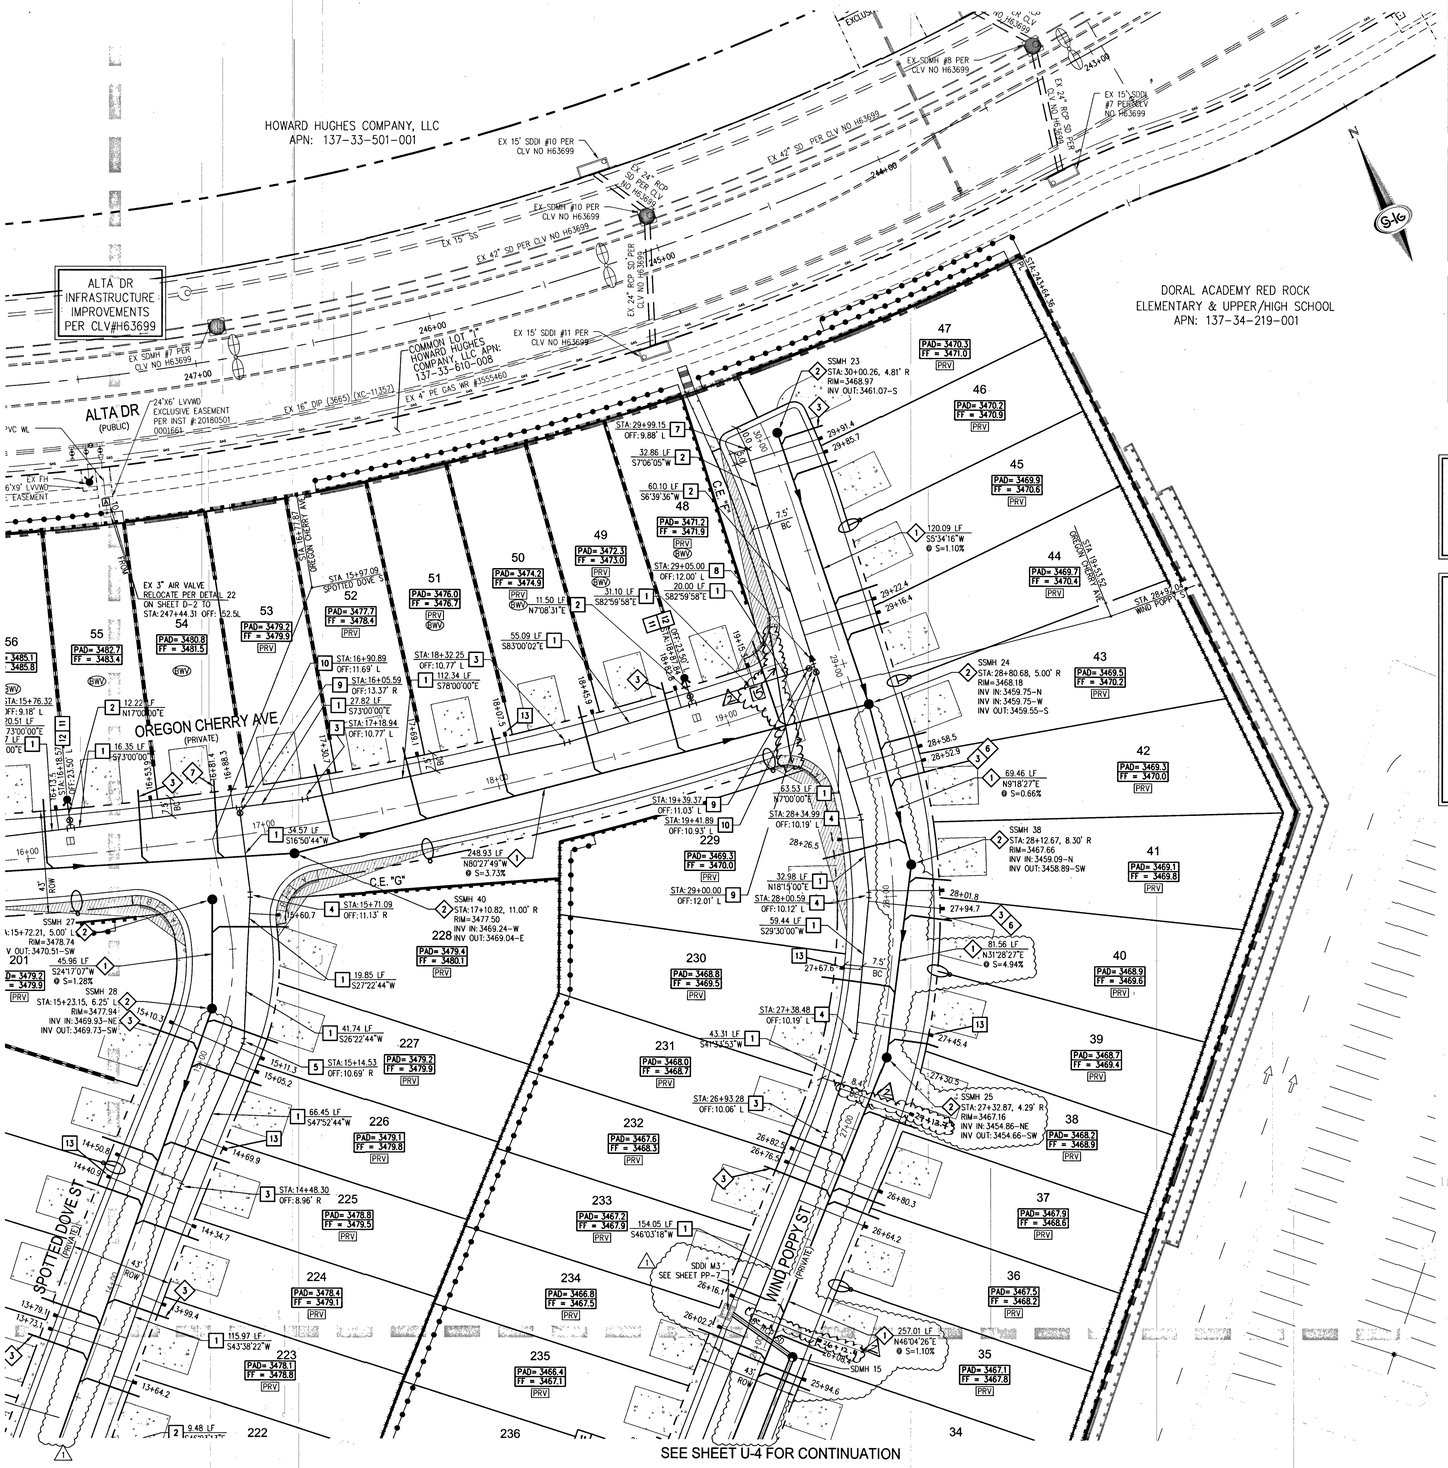

NOTE

ALL PRIVATE STREETS ARE PUBLIC UTILITY, CLV SEWER & PUBLIC DRAINAGE EASEMENTS TO BE PRIVATELY MAINTAINED BY HOA.

DISCLAIMER NOTE

EXISTING UTILITY LOCATIONS SHOWN HEREON ARE APPROXIMATE ONLY. IT SHALL BE THE CONTRACTOR'S RESPONSIBILITY TO DETERMINE THE EXCEPT VERTICAL AND HORIZONTAL LOCATION OF ALL EXISTING UNDERGROUND UTILITIES PRIOR TO COMMENCING CONSTRUCTION. NO REPRESENTATION IS MADE THAT ALL EXISTING UTILITIES ARE SHOWN HEREON. THE ENGINEER ASSUMES NO RESPONSIBILITY FOR UTILITIES NOT SHOWN IN THEIR PROPER LOCATION.

STATIC PRESSURE NOTE

EXCESS PRESSURE FOR LOTS 12-53 AND 201-243

THIS PROPERTY MAY HAVE STATIC PRESSURE IN EXCESS OF 80 PSI. THE UNIFORM PLUMBING CODE REQUIRES THAT INDIVIDUAL, ON-SITE (PRIVATE), PRESSURE REDUCING VALVES (PRV) BE INSTALLED WHENEVER THE PRESSURE EXCEEDS 80 PSI. PRV'S ARE THE DEVELOPER'S RESPONSIBILITY AND WILL NOT BE INSPECTED OR INCLUDED IN THE ACCEPTANCE OF LVVWD FACILITIES.

ABANDONED VAVLVES CUT AND CAP

ALL VALVES TO BE ABANDONED SHALL BE ABANDONED IN THE CLOSED POSITION, UNLESS SHOWN OTHERWISE, BY REMOVING A MINIMUM OF THE TOP TWENTY-FOUR (24) INCHES OF THE VALVE BOX, AND THEN FILLING THE BOTTOM OF THE BOX WITH A MINIMUM OF EIGHT (8) INCHES OF SAND OR TYPE II AGGREGATE BASE. THE REMAINING PORTION OF THE VALVE BOX SHALL BE FILLED WITH CONCRETE HAVING A COMPRESSIVE STRENGTH OF AT LEAST TWO THOUSAND (2000) PSI. THE LATERAL MUST BE CUT WITHIN ONE (1) FOOT OF THE ABANDONED VALVE, OR AS SHOWN ON PLANS, AND CAPPED, IN ACCORDANCE WITH THE PROVISION OF UDACS PLATE NO. 31.

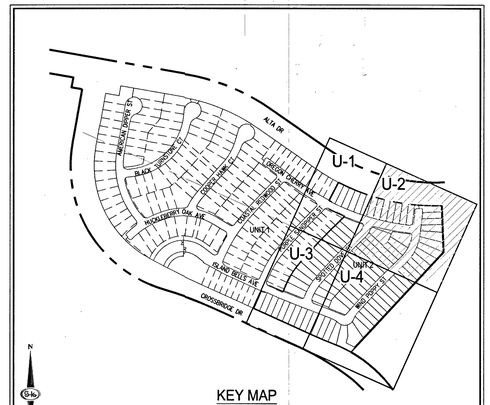

SCALE - 1"=30' (0, 30, 60 FEET)

EASEMENT NOTES

1. ALL PRIVATE STREETS ARE P.U.E., PUBLIC SEWER EASEMENTS AND PUBLIC DRAINAGE EASEMENTS TO BE PRIVATELY MAINTAINED BY HOA.
2. ALL COMMON ELEMENTS ARE PUBLIC DRAINAGE EASEMENTS TO BE PRIVATELY MAINTAINED.

LVVWD NOTES

1. FIRE SPRINKLER SYSTEMS SHALL BE PLUMBED TO THE MASTER TOILET. NO EXCEPTIONS ALLOWED
2. SERVICE LATERALS FOR LOTS: 10 AND 60 WILL BE TAPPED ON EXISTING MAIN BY OWNER CONTRACTOR UNDER DIRECTION OF THE LVVWD
3. DROP INLET NOTE
   WHERE 10 FEET PARALLEL SEPARATION IS NOT PRACTICABLE:
   CAST-IN-PLACE MONOLITHIC POUR WITH WATERSTOP BETWEEN SLAB AND WALLS. BASE WALLS AND TOP TO BE CONSTRUCTED WITH WATERSTOPS, CENTER BULB, OR FLAT STRIP. (VINYLEX, GREENSTREAK PLASTIC PRODUCTS OR APPROVED EQUAL)
4. PROTECT IN PLACE AND ADJUST LVVWD EXISTING FACILITIES TO FINISHED GRADE PER UDACS. ALL LVVWD FACILITIES SHALL BE ACCESSIBLE AT ALL TIMES

FIRE FLOW CALCULATIONS

FIRE FLOW 1,500 GPM AT 20 P.S.I. RESIDUAL.

USE/OCCUPANCY	SINGLE FAMILY
TYPE OF CONSTRUCTION (IBC)	TYPE V-B
SQUARE FOOTAGE	<3600
LARGEST AREA BETWEEN 4 HOUR WALLS	N/A
BUILDING HEIGHT	<35
NO OF STORIES INCLUDING BASEMENT	2
FIRE SPRINKLER	YES (130)
NO OF HYDRANTS INSTALLED	5

BENCHMARK

CITY OF LAS VEGAS BENCHMARK 7LV09 34SW6

RIVET AND ROUND PLATE IN THE TOP OF CURB AT THE SOUTHEAST CORNER OF DESERT MOON RD. AND SKY VISTA DR.
ELEVATION = 1011.422 METERS (NAVD '88)
ELEVATION = 3318.31 US SURVEY FEET (NAVD '88)

BASIS OF BEARINGS

NORTH 05°59'55" WEST, BEING THE BEARING OF THE WEST LINE OF SECTION 34, TOWNSHIP 20 SOUTH, RANGE 59 EAST, M.D.M., CITY OF LAS VEGAS, CLARK COUNTY, NEVADA, AS SHOWN BY MAP THEREOF ON FILE IN THE CLARK COUNTY, NEVADA RECORDER'S OFFICE IN BOOK 135, PAGE 71 OF PLATS.

WATER NOTES

1. INSTALL 8" PVC WATER PIPE (3665 WP2)
2. INSTALL 6" PVC WATER PIPE (3665 WP2)
3. INSTALL 5° BEND PER UDACS PLATE NO. 31
4. INSTALL 11.25° BEND PER UDACS PLATE NO. 31
5. INSTALL 22.5° BEND PER UDACS PLATE NO. 31
6. INSTALL 45° BEND PER UDACS PLATE NO. 31
7. INSTALL CAP AND 2" BLOWOFF VALVE PER UDACS PLATE NO. 36
8. INSTALL 8"X6" REDUCER PER UDACS PLATE NO. 30
9. INSTALL 8" GATE VALVE WITH VALVE BOX PER UDACS PLATE NO. 30 & 39
10. INSTALL 8"X8" TEE PER UDACS PLATE NO. 31
11. INSTALL FIRE HYDRANT ASSEMBLY W/6" GATE VALVE PER UDACS PLATE NO. 40
12. INSTALL 8"X6" TEE PER UDACS PLATE NO. 31
13. INSTALL 1" COPPER SERVICE W/ 3/4" IRRIGATION METER AND 1" RPPA PER UDACS PLATE NO. 4 & 8. SEE DETAIL ON SHEET D-2
14. FIELD VERIFY LOCATION, REMOVE CAP AND BLOW OFF VALVE PER UDACS PLATE NO. 36 & CONNECT TO EX. 8" PVC WATER PIPE
15. INSTALL 2"-45° SCH40 PVC IRRIGATION SLEEVES
16. INSTALL 1" COPPER SERVICE W/ 3/4" METER PER UDACS PLATE NO. 1

SEWER NOTES

1. INSTALL 8" PVC SANITARY SEWER PER DCSWCS SD-15 & SD-17
2. INSTALL 48" DIAMETER SANITARY SEWER MANHOLE WITH PRECAST BASE PER DCSWCS SD-1A, SD-1B, SD-4, SD-9, AND SINGLE LID (24")
3. INSTALL 4" PVC SEWER LATERAL PER DCSWCS SD-22 & SD-25.
4. EXISTING 48" DIAMETER SANITARY SEWER MANHOLE PER UNIT 1 IMPROVEMENT PLANS CLV #L19-00027 (107Y5102)
5. REMOVE CAP AND CONNECT TO EXISTING 8" SS
6. INSTALL SANITARY SEWER CLEANOUT WITH TRAFFIC RATED LID IN DRIVEWAY PER DCSWCS SD-26
7. INSTALL 4" C900 PVC SEWER LATERAL PER DCSWCS SD-22& SD-25 FOR LOT 54 ONLY
8. CONNECT SS LATERAL TO BRISTLE VALE UNIT 1 (CLV# 107Y5102) AVE EXTING
9. MANHOLE SHALL BE CORROSION PROTECTED WITH FIELD APPLIED COATING PER DCSWCS SECTION 3.16.B8

SEE SHEET C-3 FOR QUANTITIES AND ABBREVIATIONS

GENERAL NOTES

1. FOR FIRE HYDRANT LOCATION, TYPICAL UTILITY LOCATION, AND TYPICAL SEWER LATERAL DETAIL SEE SHEET U-1
2. ALL SEWER/STORM DRAIN CROSSING WATER LINES MUST COMPLY WITH UDACS SECTION 2.22
3. NOTE: INSTALL PIPELINE MARKER BALLS, PER UDACS PLATE NO. 15
4. DEPTH OF COVER DURING CONSTRUCTION MAINTAIN MINIMUM TWENTY FOUR (24) INCH COVER PER UDACS SECTION 2.08.04. GRADING MUST BE COMPLETED PRIOR TO WATERLINE INSTALLATION.
5. ALL ABOVE GROUND UTILITY APPURTENANCES SHALL CONFORM TO THE REQUIREMENTS OF TITLE 19.06 & 19.08.
6. THE LVVWD CANNOT GUARANTEE A WATERTIGHT SHUTDOWN WHERE CONNECTIONS OR REPAIRS TO EXISTING FACILITIES ARE REQUIRED. THE CONTRACTOR SHALL ENSURE ALL LABOR AND EQUIPMENT IS AVAILABLE TO REMOVE REMAINING WATER. COORDINATION WITH INSPECTION DIVISION MUST TAKE PLACE PRIOR TO ANY TRIAL SHUTDOWN.CONTRACTOR TO INSTALL TEMPORARY SERVICE TO ENSURE PROPER SHUTDOWN IN THE EVENT NO OTHER APPURTENANCES ARE AVAILABLE.
   * WATER TIGHT MANHOLE

FOR ALL DRY UTILITIES CROSSINGS

8. MAINTAIN MINIMUM 12" VERTICAL SEPARATION AT ALL POINTS OF CROSSING FOR DRY UTILITIES.
9. MAINTAIN MINIMUM 3' PARALLEL SEPARATION FOR DRY UTILITIES.
10. ANY EXCAVATION AT BACK OF CURB MUST REMAIN OPEN FOR INSPECTION OF COPPER SERVICE LATERALS. ANY COPPER SERVICE LATERAL KINKED, BENT OR OTHERWISE DAMAGED MUST BE REPLACED FROM THE MAIN TO THE ANGLE METER STOP FOR DRY UTILITIES.

TO ENSURE LVVWD ACCESS WITHIN EASEMENT

ALL ABOVE GROUND OBSTRUCTIONS INCLUDING BUT NOT LIMITED TO LANDSCAPE BOULDERS, FENCES/WALLS, AND SIGNS ARE STRICTLY PROHIBITED WITHIN EASEMENT.

WATER NOTES

REDUCED PRESSURE PRINCIPLE ASSEMBLY (1) 1"
APPROVED REDUCED PRESSURE PRINCIPLE ASSEMBLY(S) SHALL BE INSTALLED PER THE UDACS PLATE NO. 8. NO WATER SHALL BE TAKEN FROM A SERVICE REQUIRING BACKFLOW PREVENTION UNTIL THE REDUCED PRESSURE PRINCIPLE ASSEMBLY HAS BEEN SUCCESSFULLY TESTED BY THE LVVWD. ANY BLOCK WALL OR OTHER FENCE MATERIAL SHALL BE DESIGNED AND CONSTRUCTED AROUND THE OUTSIDE OF THE EASEMENT(S) TO ALLOW THE DISTRICT DIRECT ACCESS FROM THE ADJACENT RIGHT-OF-WAY. EASEMENTS SHALL BE CLEARLY MARKED OR STAKED PRIOR TO THE START OF CONSTRUCTION.

APPROVAL

LAS VEGAS FIRE AND RESCUE — 9/12/19 DATE

APPROVED FOR CONSTRUCTION

LAS VEGAS VALLEY WATER DISTRICT ENGINEERING SERVICES — 9-23-19

PROJECT NO. 136382 FIRST APPROVED DATE: 3/13/19
LVVWD APPROVED FIRE FLOW 1,500 GPM AT 20 PSI RESIDUAL
MAXIMUM AVAILABLE FIRE SPRINKLER FLOW 30 GPM

SOUTHWEST GAS APPROVAL

SOUTHWEST GAS CORPORATION — 9/12 DATE

FAST Call before you UnderGround 1-702-432-5300 FREEWAY & ARTERIAL SYSTEM OF TRANSPORTATION (F.A.S.T)

AVOID HITTING OVERHEAD POWER LINES. IT'S COSTLY. CALL BEFORE YOU DO OVERHEAD 1-702-227-2929

Call before you Dig AVOID CUTTING UNDERGROUND UTILITY LINES. IT'S COSTLY. Call 811 OR 1-800-227-2600

SLATER HANIFAN GROUP
CONSULTING ENGINEERS & PLANNERS
5740 S. ARVILLE STREET #216, LAS VEGAS, NV 89118
PHONE (702) 284-5300 FAX (702) 284-5399

NO.	DESCRIPTION	DATE	BY	APP.	APP. DATE
1	REVISE STORM DRAIN AND SEWER	09/17/19	PA	MH	9-23-19
2	ADD IRRIGATION SLEEVES AND	11/20/19	MH	MH	11/21/19
3	WATER NOTE, UPDATE WATER METER LOCATIONS.				

LAS VEGAS, NV

KB HOME
BRISTLE VALE - UNIT 2
UTILITY SHEET II

23S 59E

DATE: 5/8/19
DRAFTER: OQ
DESIGNER: OQ
CHECKED: DSP
PROJECT NO. KBH1804-000

TIMOTHY M. MULROONEY, Exp. 12/31/2019, CIVIL, No. 22938, PROFESSIONAL ENGINEER — 9/11/19

U-2
SHEET 23 OF 29
L19-00527
107Y5102-2

PROJ#:136382A QS:137-33-NE

I:\kbh1804-000 summerlin \24 parcel 1&m\dwg\improv\phase 2\kbh1804-000 ut1 p2.dwg 9/11/2019 12:27 PM Oscar Quiroz

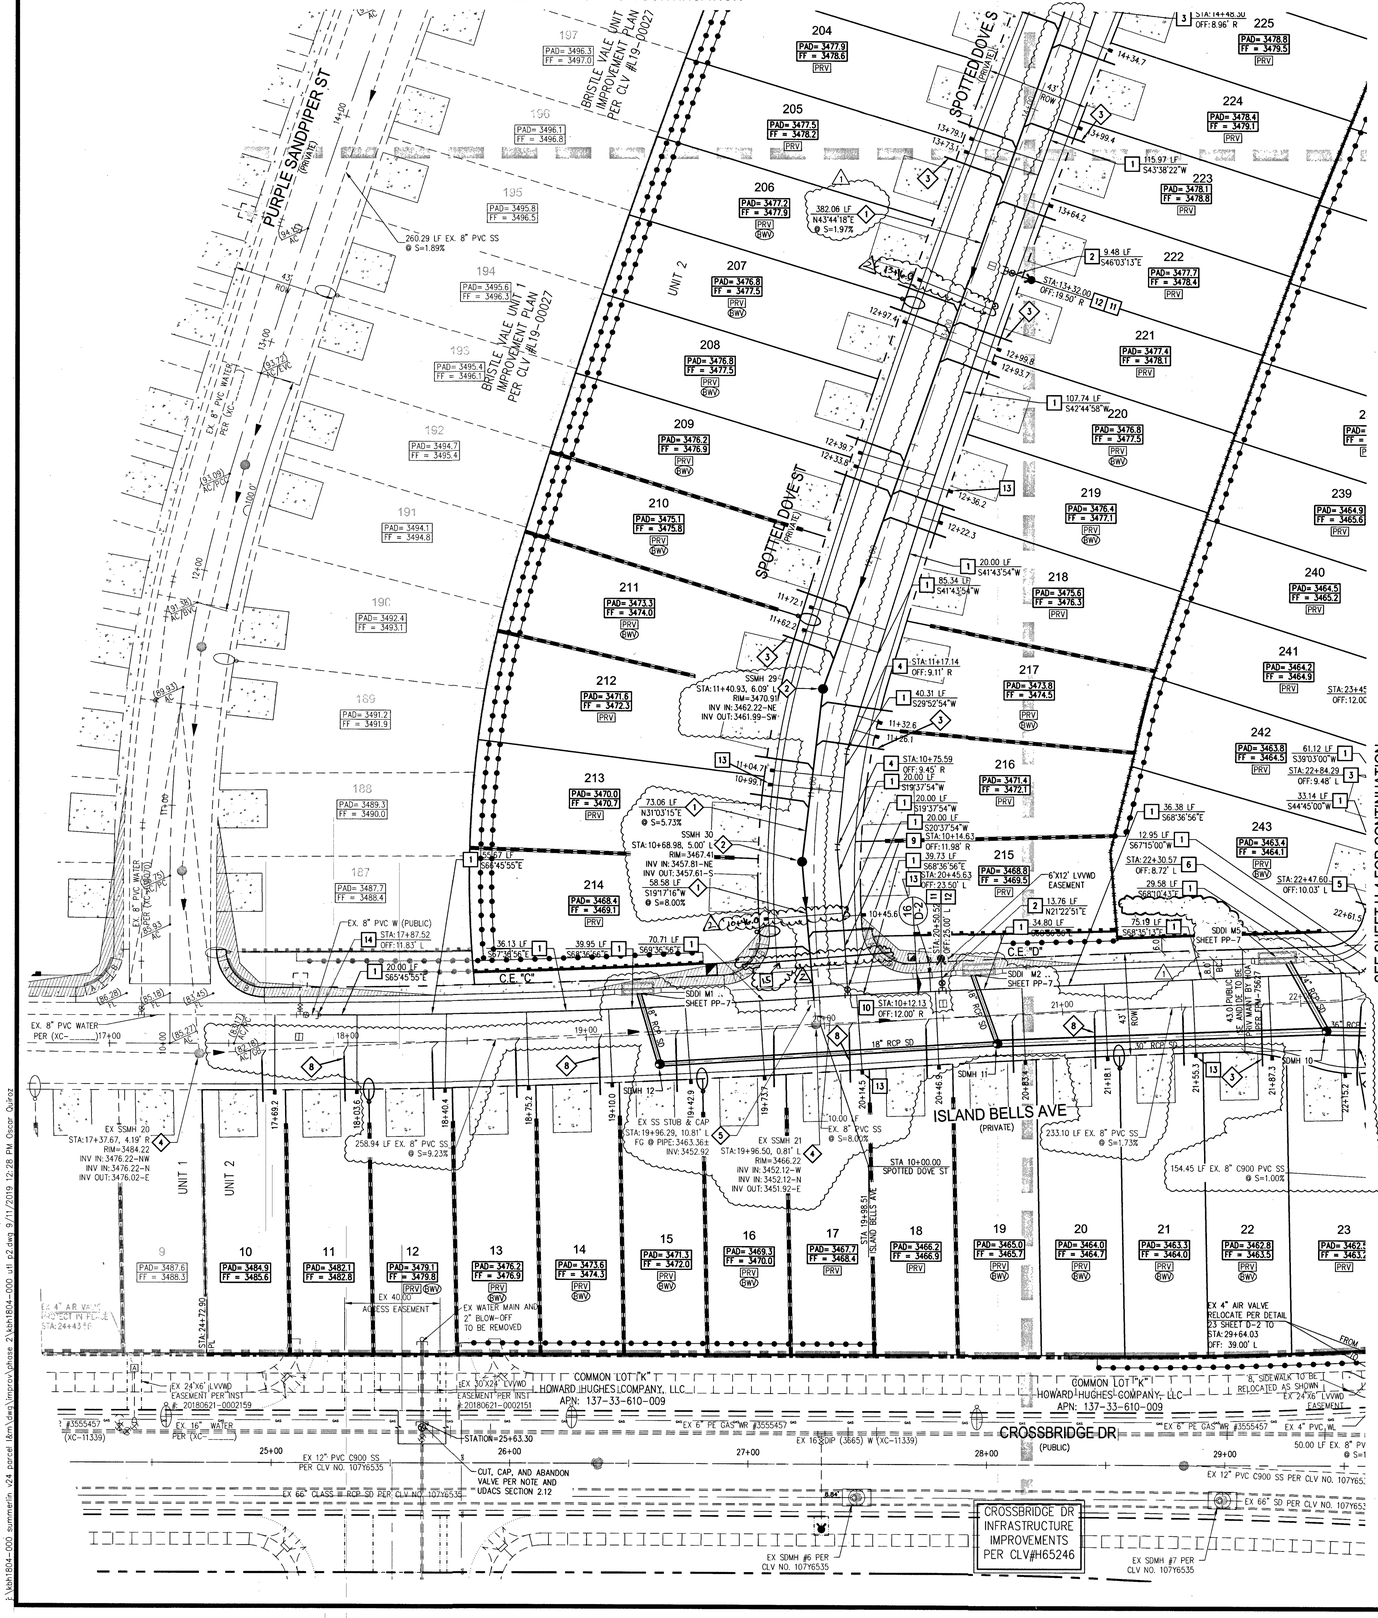

NOTE

ALL PRIVATE STREETS ARE PUBLIC UTILITY, CLV SEWER & PUBLIC DRAINAGE EASEMENTS TO BE PRIVATELY MAINTAINED BY HOA.

DISCLAIMER NOTE

EXISTING UTILITY LOCATIONS SHOWN HEREON ARE APPROXIMATE ONLY. IT SHALL BE THE CONTRACTOR'S RESPONSIBILITY TO DETERMINE THE EXCEPT VERTICAL AND HORIZONTAL LOCATION OF ALL EXISTING UNDERGROUND UTILITIES PRIOR TO COMMENCING CONSTRUCTION. NO REPRESENTATION IS MADE THAT ALL EXISTING UTILITIES ARE SHOWN HEREON. THE ENGINEER ASSUMES NO RESPONSIBILITY FOR UTILITIES NOT SHOWN IN THEIR PROPER LOCATION.

STATIC PRESSURE NOTE

EXCESS PRESSURE FOR LOTS 12-53 AND 201-243

THIS PROPERTY MAY HAVE STATIC PRESSURE IN EXCESS OF 80 PSI. THE UNIFORM PLUMBING CODE REQUIRES THAT INDIVIDUAL, ON-SITE (PRIVATE), PRESSURE REDUCING VALVES (PRV) BE INSTALLED WHENEVER THE PRESSURE EXCEEDS 80 PSI. PRV'S ARE THE DEVELOPER'S RESPONSIBILITY AND WILL NOT BE INSPECTED OR INCLUDED IN THE ACCEPTANCE OF LVVWD FACILITIES.

ABANDONED VAVLVES CUT AND CAP

ALL VALVES TO BE ABANDONED SHALL BE ABANDONED IN THE CLOSED POSITION, UNLESS SHOWN OTHERWISE, BY REMOVING A MINIMUM OF THE TOP TWENTY-FOUR (24) INCHES OF THE VALVE BOX, AND THEN FILLING THE BOTTOM OF THE BOX WITH A MINIMUM OF EIGHT (8) INCHES OF SAND OR TYPE II AGGREGATE BASE. THE REMAINING PORTION OF THE VALVE BOX SHALL BE FILLED WITH CONCRETE HAVING A COMPRESSIVE STRENGTH OF AT LEAST TWO THOUSAND (2000) PSI. THE LATERAL MUST BE CUT WITHIN ONE (1) FOOT OF THE ABANDONED VALVE, OR AS SHOWN ON PLANS, AND CAPPED, IN ACCORDANCE WITH THE PROVISION OF UDACS PLATE NO. 31.

EASEMENT NOTES

1. ALL PRIVATE STREETS ARE P.U.E., PUBLIC SEWER EASEMENTS AND PUBLIC DRAINAGE EASEMENTS TO BE PRIVATELY MAINTAINED BY HOA.
2. ALL COMMON ELEMENTS ARE PUBLIC DRAINAGE EASEMENTS TO BE PRIVATELY MAINTAINED.

LVVWD NOTES

1. FIRE SPRINKLER SYSTEMS SHALL BE PLUMBED TO THE MASTER TOILET. NO EXCEPTIONS ALLOWED
2. SERVICE LATERALS FOR LOTS: 10 AND 60 WILL BE TAPPED ON EXISTING MAIN BY OWNER CONTRACTOR UNDER DIRECTION OF THE LVVWD
3. DROP INLET NOTE
WHERE 10 FEET PARALLEL SEPARATION IS NOT PRACTICABLE,
CAST-IN-PLACE MONOLITHIC POUR WITH WATERSTOP BETWEEN SLAB AND WALLS. BASE, WALLS AND TOP TO BE CONSTRUCTED WITH WATERSTOPS, CENTER BULB, OR FLAT STRIP. (VINYLEX, GREENSTREAK PLASTIC PRODUCTS OR APPROVED EQUAL)
4. PROTECT IN PLACE AND ADJUST LVVWD EXISTING FACILITIES TO FINISHED GRADE PER UDACS. ALL LVVWD FACILITIES SHALL BE ACCESSIBLE AT ALL TIMES

FIRE FLOW CALCULATIONS

FIRE FLOW 1,500 GPM AT 20 P.S.I. RESIDUAL.

USE/OCCUPANCY	SINGLE FAMILY
TYPE OF CONSTRUCTION (IBC)	TYPE V-B
SQUARE FOOTAGE	<3600
LARGEST AREA BETWEEN 4 HOUR WALLS	N/A
BUILDING HEIGHT	<35
NO OF STORIES INCLUDING BASEMENT	2
FIRE SPRINKLER	YES (13D)
NO OF HYDRANTS INSTALLED	5

BENCHMARK

CITY OF LAS VEGAS BENCHMARK 7LV09 34SW6

RIVET AND ROUND PLATE IN THE TOP OF CURB AT THE SOUTHEAST CORNER OF DESERT MOON RD. AND SKY VISTA DR.
ELEVATION = 1011.422 METERS (NAVD '88)
ELEVATION = 3318.31 US SURVEY FEET (NAVD '88)

BASIS OF BEARINGS

NORTH 05°59'55" WEST, BEING THE BEARING OF THE WEST LINE OF SECTION 34, TOWNSHIP 20 SOUTH, RANGE 59 EAST, M.D.M., CITY OF LAS VEGAS, CLARK COUNTY, NEVADA, AS SHOWN BY MAP THEREOF ON FILE IN THE CLARK COUNTY, NEVADA RECORDER'S OFFICE IN BOOK 135, PAGE 71 OF PLATS.

WATER NOTES

1. INSTALL 8" PVC WATER PIPE (3665 WPZ)
2. INSTALL 6" PVC WATER PIPE (3665 WPZ)
3. INSTALL 5' BEND PER UDACS PLATE NO. 31
4. INSTALL 11.25° BEND PER UDACS PLATE NO. 31
5. INSTALL 22.5° BEND PER UDACS PLATE NO. 31
6. INSTALL 45° BEND PER UDACS PLATE NO. 31
7. INSTALL CAP AND 2" BLOWOFF VALVE PER UDACS PLATE NO. 36
8. INSTALL 8"x6" REDUCER PER UDACS PLATE NO. 30
9. INSTALL 8" GATE VALVE WITH VALVE BOX PER UDACS PLATE NO. 30 & 39
10. INSTALL 8"x8" TEE PER UDACS PLATE NO. 31
11. INSTALL FIRE HYDRANT ASSEMBLY W/6" GATE VALVE PER UDACS PLATE NO. 40
12. INSTALL 8"x6" TEE PER UDACS PLATE NO. 31
13. INSTALL 1" COPPER SERVICE W/ 3/4" IRRIGATION METER AND 1" RPPA PER UDACS PLATE NO. 4 & 6. SEE DETAIL ON SHEET D-2
14. FIELD VERIFY LOCATION, REMOVE CAP AND BLOW OFF VALVE PER UDACS PLATE NO. 36 & CONNECT TO EX 8" PVC WATER PIPE
15. [INSTALL 2-4" SCH-80 PVC IRRIGATION SLEEVES]
16. INSTALL 1" COPPER SERVICE W/ 3/4" METER PER UDACS PLATE NO. 1

SEWER NOTES

1. INSTALL 8" PVC SANITARY SEWER PER DCSWCS SD-15 & SD-17
2. INSTALL 48" DIAMETER SANITARY SEWER MANHOLE WITH PRECAST BASE PER DCSWCS SD-1A, SD-1B, SD-4, SD-9, AND SINGLE LID (24")
3. INSTALL 4" PVC SEWER LATERAL PER DCSWCS SD-22 & SD-25.
4. EXISTING 48" DIAMETER SANITARY SEWER MANHOLE PER UNIT 1 IMPROVEMENT PLANS CLV #L19-00027 (107Y5102)
5. REMOVE CAP AND CONNECT TO EXISTING 8" SS
6. INSTALL SANITARY SEWER CLEANOUT WITH TRAFFIC RATED LID IN DRIVEWAY PER DCSWCS SD-26
7. INSTALL 4" C900 PVC SEWER LATERAL PER DCSWCS SD-22& SD-25 FOR LOT 54 ONLY
8. CONNECT SS LATERAL TO BRISTLE VALE UNIT 1 (CLV# 107YS102) WYE FITTING
9. MANHOLE SHALL BE CORROSION PROTECTED WITH FIELD APPLIED COATING PER DCSWCS SECTION 3.16.8B

SEE SHEET C-3 FOR QUANTITIES AND ABBREVIATIONS

GENERAL NOTES

1. FOR FIRE HYDRANT LOCATION, TYPICAL UTILITY LOCATION, AND TYPICAL SEWER LATERAL DETAIL SEE SHEET U-1
2. ALL SEWER/STORM DRAIN CROSSING WATER LINES MUST COMPLY WITH UDACS SECTION 2.22
3. NOTE: INSTALL PIPELINE MARKER BALLS, PER UDACS PLATE NO. 15
4. DEPTH OF COVER DURING CONSTRUCTION MAINTAIN MINIMUM TWENTY FOUR (24) INCH COVER PER UDACS SECTION 2.08.04. GRADING MUST BE COMPLETED PRIOR TO WATERLINE INSTALLATION.
5. ALL ABOVE GROUND UTILITY APPURTENANCES SHALL CONFORM TO THE REQUIREMENTS OF TITLE 19.06 & 19.08.
6. THE LVVWD CANNOT GUARANTEE A WATERTIGHT SHUTDOWN WHERE CONNECTIONS OR REPAIRS TO EXISTING FACILITIES ARE REQUIRED. THE CONTRACTOR SHALL ENSURE ALL LABOR AND EQUIPMENT IS AVAILABLE TO REMOVE REMAINING WATER. COORDINATION WITH INSPECTION DIVISION MUST TAKE PLACE PRIOR TO ANY TRIAL SHUTDOWN.CONTRACTOR TO INSTALL TEMPORARY SERVICE TO ENSURE PROPER SHUTDOWN IN THE EVENT NO OTHER APPURTENANCES ARE AVAILABLE.
   - WATER TIGHT MANHOLE

FOR ALL DRY UTILITIES CROSSINGS

8. MAINTAIN MINIMUM 12" VERTICAL SEPARATION AT ALL POINTS OF CROSSING FOR DRY UTILITIES.
9. MAINTAIN MINIMUM 3' PARALLEL SEPARATION FOR DRY UTILITIES.
10. ANY EXCAVATION AT BACK OF CURB MUST REMAIN OPEN FOR INSPECTION OF COPPER SERVICE LATERALS. ANY COPPER SERVICE LATERAL KINKED, BENT OR OTHERWISE DAMAGED MUST BE REPLACED FROM THE MAIN TO THE ANGLE METER STOP FOR DRY UTILITIES.

TO ENSURE LVVWD ACCESS WITHIN EASEMENT

ALL ABOVE GROUND OBSTRUCTIONS INCLUDING BUT NOT LIMITED TO LANDSCAPE BOULDERS, FENCES/WALLS, AND SIGNS ARE STRICTLY PROHIBITED WITHIN EASEMENT.

WATER NOTES

REDUCED PRESSURE PRINCIPLE ASSEMBLY (1) 1"

APPROVED REDUCED PRESSURE PRINCIPLE ASSEMBLY(S) SHALL BE INSTALLED PER THE UDACS PLATE NO. 8. NO WATER SHALL BE TAKEN FROM A SERVICE REQUIRING BACKFLOW PREVENTION UNTIL THE REDUCED PRESSURE PRINCIPLE ASSEMBLY HAS BEEN SUCCESSFULLY TESTED BY THE LVVWD. ANY BLOCK WALL OR OTHER FENCE MATERIAL SHALL BE DESIGNED AND CONSTRUCTED AROUND THE OUTSIDE OF THE EASEMENT(S) TO ALLOW THE DISTRICT DIRECT ACCESS FROM THE ADJACENT RIGHT-OF-WAY. EASEMENTS SHALL BE CLEARLY MARKED OR STAKED PRIOR TO THE START OF CONSTRUCTION.

APPROVAL

LAS VEGAS FIRE AND RESCUE — 9/12/19 DATE

APPROVED FOR CONSTRUCTION

LAS VEGAS VALLEY WATER DISTRICT ENGINEERING SERVICES — 9-23-19

PROJECT NO. 136382 FIRST APPROVED DATE: 5/13/19
LVVWD APPROVED FIRE FLOW 1,500 GPM AT 20 PSI RESIDUAL
MAXIMUM AVAILABLE FIRE SPRINKLER FLOW 30 GPM

SOUTHWEST GAS APPROVAL

SOUTHWEST GAS CORPORATION — 9/12 DATE

FAST Call before you UnderGround 1-702-432-5300 FREEWAY & ARTERIAL SYSTEM OF TRANSPORTATION (F.A.S.T.)

AVOID HITTING OVERHEAD POWER LINES. IT'S COSTLY. CALL BEFORE YOU DO OVERHEAD 1-702-227-2929

Call before you Dig AVOID CUTTING UNDERGROUND UTILITY LINES. IT'S COSTLY. Call 811 OR 1-800-227-2600

SLATER HANIFAN GROUP
CONSULTING ENGINEERS & PLANNERS
5740 S. ARVILLE STREET #216, LAS VEGAS, NV 89118
PHONE (702) 284-5300 FAX (702) 284-5399

NO.	DESCRIPTION	DATE	BY	APP.	APP. DATE
1	REVISE STORM DRAIN AND SEWER	10/17/19	PA	[illegible]	10/17/19
2	ADD IRRIGATION SLEEVES PER UVVWD	11/21/19	NE	[illegible]	11/21/19
	NOTE: UPDATE WATER LATERAL				

LAS VEGAS, NV

KB HOME
BRISTLE VALE - UNIT 2
UTILITY SHEET III

S 33 T 20S R 59E

DATE: 5/8/19
DRAFTER: OQ
DESIGNER: OQ
CHECKED: DSP

PROJECT NO.
KBH1804-000

TIMOTHY M. MULROONEY — Exp. 12/31/2019 — CIVIL — No. 22936 — STATE OF NEVADA
9/11/19

U-3
SHEET 24 OF 29

L19-00527
107YS102-2

PROJ#:136382A QS:137.33-NE

J:\KBH1804-000 summerlin 2Q1 parcel 1\em\cad\xrefs\Utilities 2\KBH1804-000_util #2.dwg 9/11/2019 12:28 PM Oscar Quiroz

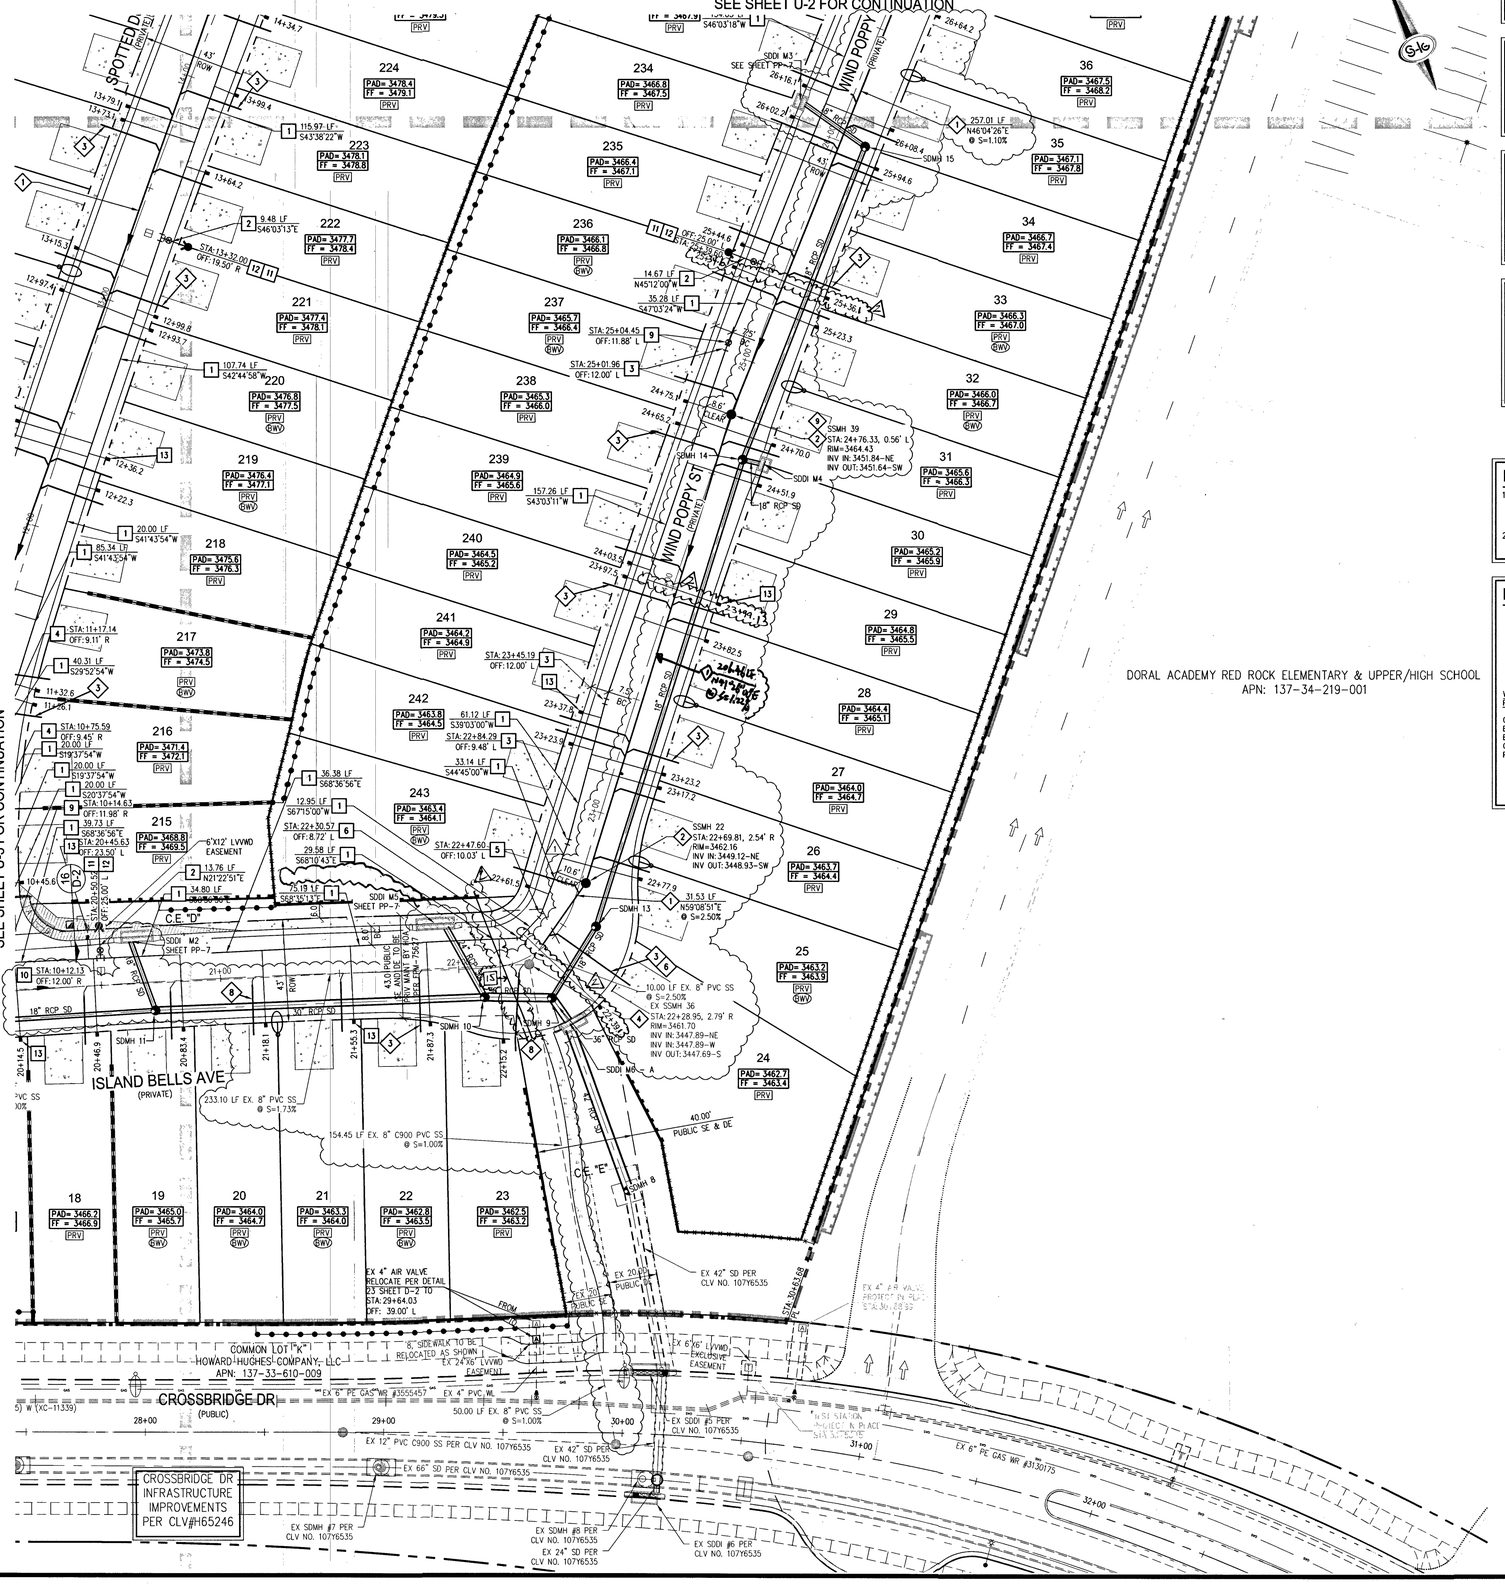

NOTE

ALL PRIVATE STREETS ARE PUBLIC UTILITY, CLV SEWER & PUBLIC DRAINAGE EASEMENTS TO BE PRIVATELY MAINTAINED BY HOA.

DISCLAIMER NOTE

EXISTING UTILITY LOCATIONS SHOWN HEREON ARE APPROXIMATE ONLY. IT SHALL BE THE CONTRACTOR'S RESPONSIBILITY TO DETERMINE THE EXCEPT VERTICAL AND HORIZONTAL LOCATION OF ALL EXISTING UNDERGROUND UTILITIES PRIOR TO COMMENCING CONSTRUCTION. NO REPRESENTATION IS MADE THAT ALL EXISTING UTILITIES ARE SHOWN HEREON. THE ENGINEER ASSUMES NO RESPONSIBILITY FOR UTILITIES NOT SHOWN IN THEIR PROPER LOCATION.

STATIC PRESSURE NOTE

EXCESS PRESSURE FOR LOTS 12-53 AND 201-243

THIS PROPERTY MAY HAVE STATIC PRESSURE IN EXCESS OF 80 PSI. THE UNIFORM PLUMBING CODE REQUIRES THAT INDIVIDUAL, ON-SITE (PRIVATE), PRESSURE REDUCING VALVES (PRV) BE INSTALLED WHENEVER THE PRESSURE EXCEEDS 80 PSI. PRV'S ARE THE DEVELOPER'S RESPONSIBILITY AND WILL NOT BE INSPECTED OR INCLUDED IN THE ACCEPTANCE OF LVVWD FACILITIES.

ABANDONED VAVLVES CUT AND CAP

ALL VALVES TO BE ABANDONED SHALL BE ABANDONED IN THE CLOSED POSITION, UNLESS SHOWN OTHERWISE, BY REMOVING A MINIMUM OF THE TOP TWENTY-FOUR (24) INCHES OF THE VALVE BOX, AND THEN FILLING THE BOTTOM OF THE BOX WITH A MINIMUM OF EIGHT (8) INCHES OF SAND OR TYPE II AGGREGATE BASE. THE REMAINING PORTION OF THE VALVE BOX SHALL BE FILLED WITH CONCRETE HAVING A COMPRESSIVE STRENGTH OF AT LEAST TWO THOUSAND (2000) PSI. THE LATERAL MUST BE CUT WITHIN ONE (1) FOOT OF THE ABANDONED VALVE, OR AS SHOWN ON PLANS, AND CAPPED, IN ACCORDANCE WITH THE PROVISION OF UDACS PLATE NO. 31.

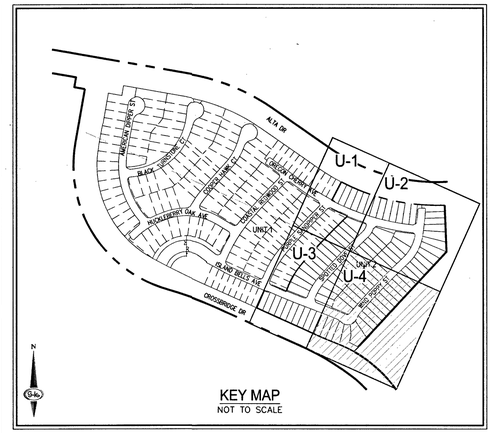

SCALE - 1"=30' (0, 30, 60 FEET)

EASEMENT NOTES

1. ALL PRIVATE STREETS ARE P.U.E., PUBLIC SEWER EASEMENTS AND PUBLIC DRAINAGE EASEMENTS TO BE PRIVATELY MAINTAINED BY HOA.
2. ALL COMMON ELEMENTS ARE PUBLIC DRAINAGE EASEMENTS TO BE PRIVATELY MAINTAINED.

FIRE FLOW CALCULATIONS

FIRE FLOW 1,500 GPM AT 20 P.S.I. RESIDUAL.

USE/OCCUPANCY	SINGLE FAMILY
TYPE OF CONSTRUCTION (IBC)	TYPE V-B
SQUARE FOOTAGE	<3600
LARGEST AREA BETWEEN 4 HOUR WALLS	N/A
BUILDING HEIGHT	<35
NO OF STORIES INCLUDING BASEMENT	2
FIRE SPRINKLER	YES (13D)
NO OF HYDRANTS INSTALLED	5

BENCHMARK

CITY OF LAS VEGAS BENCHMARK 7LV09 345W6

RIVET AND ROUND PLATE IN THE TOP OF CURB AT THE SOUTHEAST CORNER OF DESERT MOON RD. AND SKY VISTA DR.

ELEVATION = 1011.422 METERS (NAVD '88)

ELEVATION = 3318.31 US SURVEY FEET (NAVD '88)

BASIS OF BEARINGS

NORTH 05°59'55" WEST, BEING THE BEARING OF THE WEST LINE OF SECTION 34, TOWNSHIP 20 SOUTH, RANGE 59 EAST, M.D.M., CITY OF LAS VEGAS, CLARK COUNTY, NEVADA, AS SHOWN BY MAP THEREOF ON FILE IN THE CLARK COUNTY, NEVADA RECORDER'S OFFICE IN BOOK 135, PAGE 71 OF PLATS.

LVVWD NOTES

1. FIRE SPRINKLER SYSTEMS SHALL BE PLUMBED TO THE MASTER TOILET. NO EXCEPTIONS ALLOWED
2. SERVICE LATERALS FOR LOTS: 10 AND 60 WILL BE TAPPED ON EXISTING MAIN BY OWNER CONTRACTOR UNDER DIRECTION OF THE LVVWD
3. DROP INLET NOTE

WHERE 10 FEET PARALLEL SEPARATION IS NOT PRACTICABLE:

CAST-IN-PLACE MONOLITHIC POUR WITH WATERSTOP BETWEEN SLAB AND WALLS. BASE, WALLS AND TOP TO BE CONSTRUCTED WITH WATERSTOPS, CENTER BULB, OR FLAT STRIP, (VINYLEX, GREENSTREAK PLASTIC PRODUCTS OR APPROVED EQUAL)

4. PROTECT IN PLACE AND ADJUST LVVWD EXISTING FACILITIES TO FINISHED GRADE PER UDACS. ALL LVVWD FACILITIES SHALL BE ACCESSIBLE AT ALL TIMES

WATER NOTES

1. INSTALL 8" PVC WATER PIPE (3665 WPZ)
2. INSTALL 6" PVC WATER PIPE (3665 WPZ)
3. INSTALL 5' BEND PER UDACS PLATE NO. 31
4. INSTALL 11.25° BEND PER UDACS PLATE NO. 31
5. INSTALL 22.5° BEND PER UDACS PLATE NO. 31
6. INSTALL 45° BEND PER UDACS PLATE NO. 31
7. INSTALL CAP AND 2" BLOWOFF VALVE PER UDACS PLATE NO. 36
8. INSTALL 8"x6" REDUCER PER UDACS PLATE NO. 30
9. INSTALL 8" GATE VALVE WITH VALVE BOX PER UDACS PLATE NO. 30 & 39
10. INSTALL 8"x8" TEE PER UDACS PLATE NO. 31
11. INSTALL FIRE HYDRANT ASSEMBLY W/6" GATE VALVE PER UDACS PLATE NO. 40
12. INSTALL 8"x6" TEE PER UDACS PLATE NO. 31
13. INSTALL 1" COPPER SERVICE W/ 3/4" IRRIGATION METER AND 1" RPPA PER UDACS PLATE NO. 4 & 8. SEE DETAIL ON SHEET D-2
14. FIELD VERIFY LOCATION, REMOVE CAP AND BLOW OFF VALVE PER UDACS PLATE NO. 36 & CONNECT TO EX 8" PVC WATER PIPE
15. INSTALL 2-3/4" SCH-40 PVC IRRIGATION SLEEVES
16. INSTALL 1" COPPER SERVICE W/ 3/4" METER PER UDACS PLATE NO. 1

SEWER NOTES

1. INSTALL 8" PVC SANITARY SEWER PER DCSWCS SD-15 & SD-17
2. INSTALL 48" DIAMETER SANITARY SEWER MANHOLE WITH PRECAST BASE PER DCSWCS SD-1A, SD-1B, SD-4, SD-9, AND SINGLE LID (24")
3. INSTALL 4" PVC SEWER LATERAL PER DCSWCS SD-22 & SD-25.
4. EXISTING 48" DIAMETER SANITARY SEWER MANHOLE PER UNIT 1 IMPROVEMENT PLANS CLV #19-00027 (107Y5102)
5. REMOVE CAP AND CONNECT TO EXISTING 8" SS
6. INSTALL SANITARY SEWER CLEANOUT WITH TRAFFIC RATED LID IN DRIVEWAY PER DCSWCS SD-26
7. INSTALL 4" C900 PVC SEWER LATERAL PER DCSWCS SD-22& SD-25 FOR LOT 54 ONLY
8. CONNECT SS LATERAL TO BRISTLE VALE UNIT 1 (CLV# 107Y5102) POS TUTING
9. MANHOLE SHALL BE CORROSION PROTECTED WITH FIELD APPLIED COATING PER DCSWCS SECTION 3.16.8B

SEE SHEET C-3 FOR QUANTITIES AND ABBREVIATIONS

GENERAL NOTES

1. FOR FIRE HYDRANT LOCATION, TYPICAL UTILITY LOCATION, AND TYPICAL SEWER LATERAL DETAIL SEE SHEET U-1
2. ALL SEWER/STORM DRAIN CROSSING WATER LINES MUST COMPLY WITH UDACS SECTION 2.22
3. NOTE: INSTALL PIPELINE MARKER BALLS, PER UDACS PLATE NO. 15
4. DEPTH OF COVER DURING CONSTRUCTION MAINTAIN MINIMUM TWENTY FOUR (24) INCH COVER PER UDACS SECTION 2.08.04. GRADING MUST BE COMPLETED PRIOR TO WATERLINE INSTALLATION.
5. ALL ABOVE GROUND UTILITY APPURTENANCES SHALL CONFORM TO THE REQUIREMENTS OF TITLE 19.06 & 19.08.
6. THE LVVWD CANNOT GUARANTEE A WATERTIGHT SHUTDOWN WHERE CONNECTIONS OR REPAIRS TO EXISTING FACILITIES ARE REQUIRED. THE CONTRACTOR SHALL ENSURE ALL LABOR AND EQUIPMENT IS AVAILABLE TO REMOVE REMAINING WATER. COORDINATION WITH INSPECTION DIVISION MUST TAKE PLACE PRIOR TO ANY TRIAL SHUTDOWN.CONTRACTOR TO INSTALL TEMPORARY SERVICE TO ENSURE PROPER SHUTDOWN IN THE EVENT NO OTHER APPURTENANCES ARE AVAILABLE.
   - WATER TIGHT MANHOLE

FOR ALL DRY UTILITIES CROSSINGS

8. MAINTAIN MINIMUM 12" VERTICAL SEPARATION AT ALL POINTS OF CROSSING FOR DRY UTILITIES.
9. MAINTAIN MINIMUM 3' PARALLEL SEPARATION FOR DRY UTILITIES.
10. ANY EXCAVATION AT BACK OF CURB MUST REMAIN OPEN FOR INSPECTION OF COPPER SERVICE LATERALS. ANY COPPER SERVICE LATERAL KINKED, BENT OR OTHERWISE DAMAGED MUST BE REPLACED FROM THE MAIN TO THE ANGLE METER STOP FOR DRY UTILITIES.

TO ENSURE LVVWD ACCESS WITHIN EASEMENT

ALL ABOVE GROUND OBSTRUCTIONS INCLUDING BUT NOT LIMITED TO LANDSCAPE BOULDERS, FENCES/WALLS, AND SIGNS ARE STRICTLY PROHIBITED WITHIN EASEMENT.

WATER NOTES

REDUCED PRESSURE PRINCIPLE ASSEMBLY (1) 1"

APPROVED REDUCED PRESSURE PRINCIPLE ASSEMBLY(S) SHALL BE INSTALLED PER THE UDACS PLATE NO. 8. NO WATER SHALL BE TAKEN FROM A SERVICE REQUIRING BACKFLOW PREVENTION UNTIL THE REDUCED PRESSURE PRINCIPLE ASSEMBLY HAS BEEN SUCCESSFULLY TESTED BY THE LVVWD. ANY BLOCK WALL OR OTHER FENCE MATERIAL SHALL BE DESIGNED AND CONSTRUCTED AROUND THE OUTSIDE OF THE EASEMENT(S) TO ALLOW THE DISTRICT DIRECT ACCESS FROM THE ADJACENT RIGHT-OF-WAY. EASEMENTS SHALL BE CLEARLY MARKED OR STAKED PRIOR TO THE START OF CONSTRUCTION.

APPROVAL

LAS VEGAS FIRE AND RESCUE — DATE 9/12/19

SOUTHWEST GAS APPROVAL

SOUTHWEST GAS CORPORATION — DATE 9/12

APPROVED FOR CONSTRUCTION

LAS VEGAS VALLEY WATER DISTRICT ENGINEERING SERVICES — 9-23-19

PROJECT NO. 136382 FIRST APPROVED DATE: 5/13/19

LVVWD APPROVED FIRE FLOW 1,500 GPM AT 20 PSI RESIDUAL

MAXIMUM AVAILABLE FIRE SPRINKLER FLOW 50 GPM

FAST Call before you UnderGround 1-702-432-5300 FREEWAY & ARTERIAL SYSTEM OF TRANSPORTATION (F.A.S.T.)

AVOID HITTING OVERHEAD POWER LINES. IT'S COSTLY. CALL BEFORE YOU DO OVERHEAD 1-702-227-2929

Call before you Dig AVOID CUTTING UNDERGROUND UTILITY LINES. IT'S COSTLY. Call 811 OR 1-800-227-2600

SLATER HANIFAN GROUP
CONSULTING ENGINEERS & PLANNERS
5740 S. ARVILLE STREET #216, LAS VEGAS, NV 89118
PHONE (702) 284-5300 FAX (702) 284-5399

NO.	DESCRIPTION	DATE	BY	APP.	APP. DATE
1	REVISE STORM DRAIN AND SEWER	07/17/19	PA		
2	REVISE LOCATION SLEEVES AND UPDATE WATER AND SEWER NOTES	08/20/19	MF		

LAS VEGAS, NV

KB HOME

BRISTLE VALE - UNIT 2

UTILITY SHEET IV

S 33 T 20S R 59E

DATE: 5/8/19

DRAFTER: OQ

DESIGNER: OQ

CHECKED: DSP

PROJECT NO. KBH1804-000

TIMOTHY M. MULROONEY — Exp. 12/31/2019 — CIVIL — No. 22938 — STATE OF NEVADA — PROFESSIONAL ENGINEER — 9/11/19

U-4

SHEET 25 OF 29

L19-00527
107Y5102-2

PROJ#:136382A QS:137-33-NE

J:\kbh1804-000 summerlin (24 parcel 16)\civil\dwg\improv\phase 2\kbh1804-000 utl sh2.dwg 9/11/2019 12:28 PM Oscar Quiroz

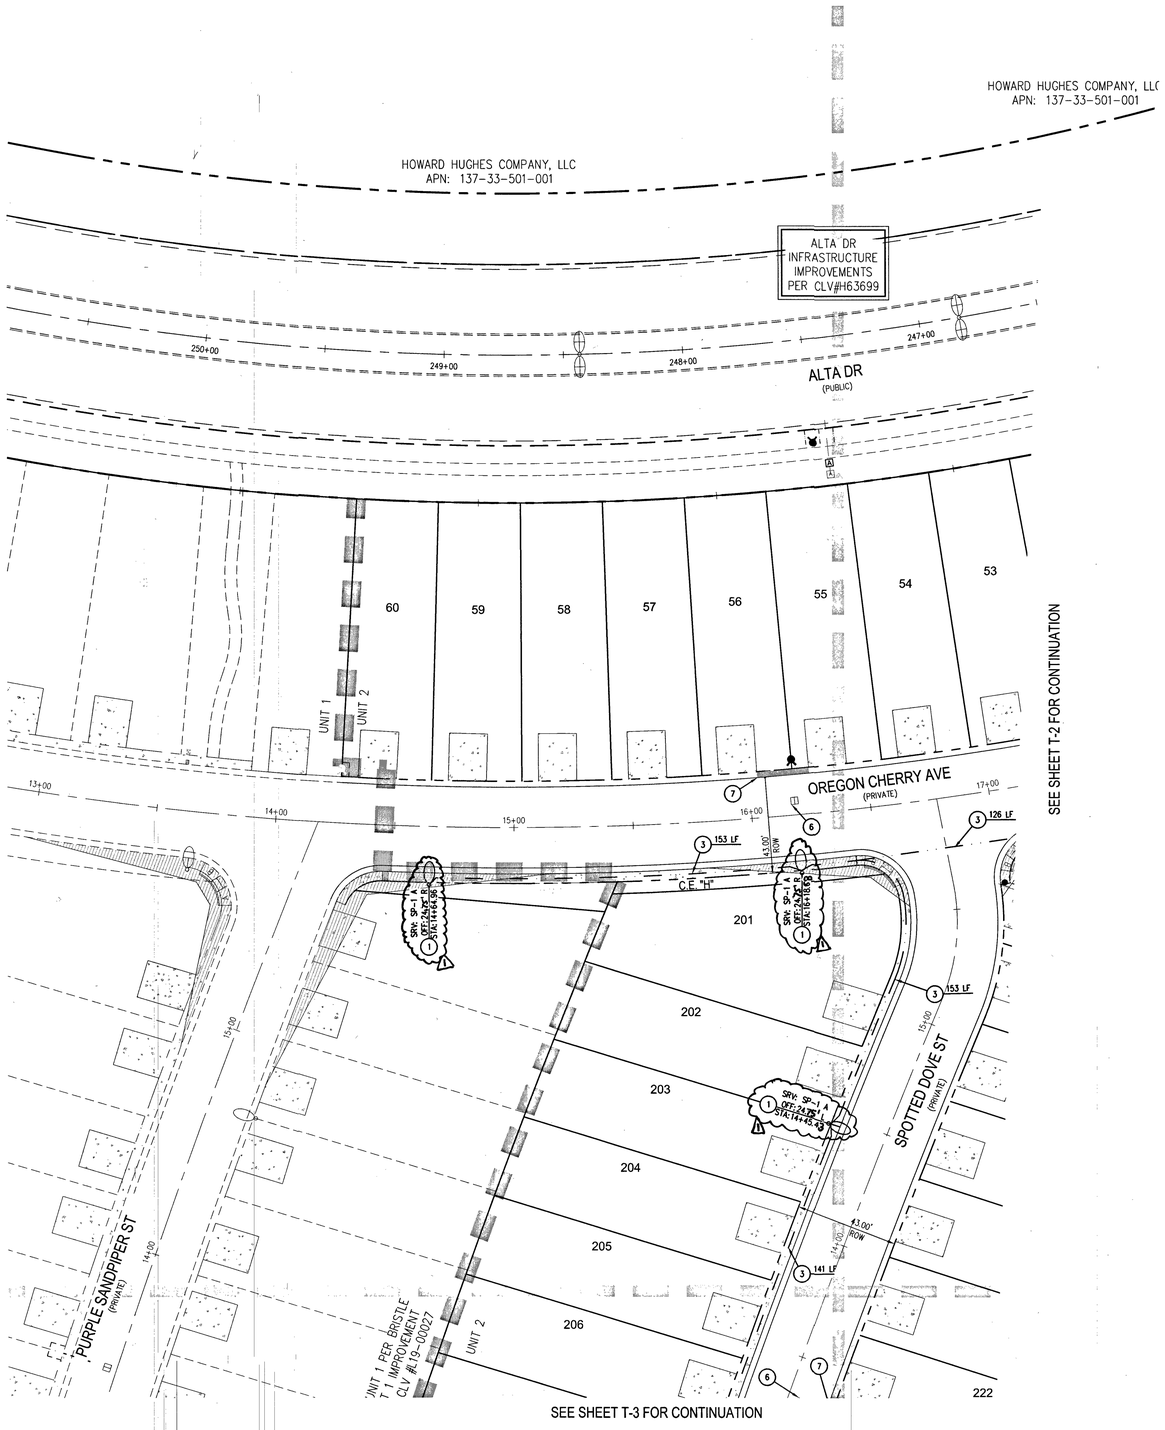

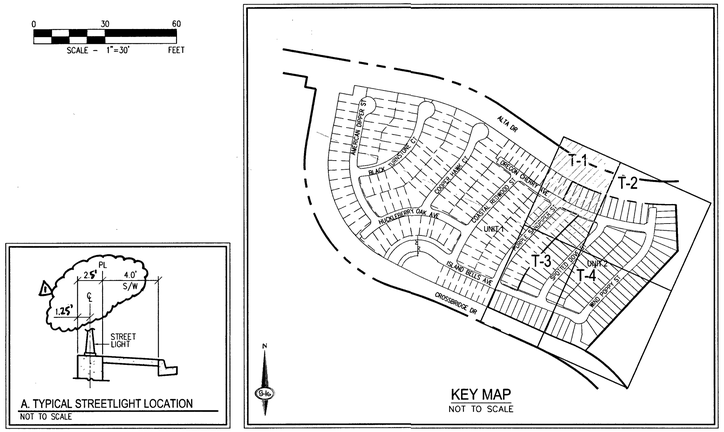

A. TYPICAL STREETLIGHT LOCATION
NOT TO SCALE

KEY MAP
NOT TO SCALE

ELECTRICAL NOTES

1. ALL UNDERGROUND CONDUIT SHALL BE TYPE RNC (RIGID NONMETALLIC CONDUIT), SCHEDULE 40 PVC AND SHALL BE INSTALLED PER DETAIL THIS SHEET. ABOVE GRADE CONDUIT SHALL BE TYPE RMC (RIGID METALLIC CONDUIT). CONDUIT RISERS SHALL BE TYPE RMC WITH PVC COATING OR TAPE WRAP. ALL CONDUIT WHICH WOULD OTHERWISE BE EMPTY SHALL INCLUDE A NYLON PULLSTRING AND 1#8 FOR LOCATING PURPOSES.
2. ALL CONDUCTOR SHALL BE STRANDED, 600V, TYPE THW INSULATED COPPER.
3. THE ELECTRICAL CONTRACTOR SHALL FURNISH AND INSTALL ALL ELECTRICAL COMPONENTS AND HARDWARE AS REQUIRED BY THE NATIONAL ELECTRICAL CODE, LATEST EDITION, AND SHALL COMPLY WITH THE REQUIREMENTS OF THE INSPECTING AUTHORITY HAVING JURISDICTION.

BENCHMARK

CITY OF LAS VEGAS BENCHMARK 7LV09 34SW6

RIVET AND ROUND PLATE IN THE TOP OF CURB AT THE SOUTHEAST CORNER OF DESERT MOON RD. AND SKY VISTA DR.

ELEVATION = 1011.422 METERS (NAVD '88)
ELEVATION = 3318.31 US SURVEY FEET (NAVD '88)

ELECTRICAL SERVICE NOTES

SP1: 200 AMP, SINGLE PHASE, 3 WIRE, 120/240V PAD MOUNTED SERVICE PEDESTAL. FEEDER FROM N.P.CO. POINT OF CONNECTION TO BE 2'C, 2#4/0 THW, 1#4/0 WHITE THW (COPPER). TRANSFORMER TO SERVICE PEDESTAL DISTANCES GREATER THAN 250 FEET FOR SPECIFIED CONDUCTORS MUST BE APPROVED BY ENGINEER. SERVICE PEDESTAL SHALL BE LOCATED A MINIMUM OF 30 FEET FROM THE TRANSFORMER. THE FOLLOWING SHALL BE INCLUDED IN THE SERVICE PEDESTAL:
(2) 60 AMP, 240V, 2-POLE CIRCUIT BREAKERS,
(2) 60 AMP, 240V, 2-POLE LIGHTING CONTACTORS,
(2) TEST SWITCHES (ONE FOR EACH CONTACTOR), PHOTOELECTRICAL CONTROL,
(1) 15 AMP, 120V, SINGLE POLE CIRCUIT BREAKER FOR LIGHTING CONTROLS.
CONTRACTOR TO PROVIDE (2) 1-1/4" CONDUITS FROM SERVICE PEDESTAL TO FIRST STREETLIGHTING PULLBOX. SERVICE PEDESTAL SHALL COMPLY WITH CLARK COUNTY AREA UNIFORM STANDARD DRAWINGS 330, 331, 332.1 AND 335.1.

BASIS OF BEARINGS

NORTH 05°59'55" WEST, BEING THE BEARING OF THE WEST LINE OF SECTION 34, TOWNSHIP 20 SOUTH, RANGE 59 EAST, M.D.M., CITY OF LAS VEGAS, CLARK COUNTY, NEVADA, AS SHOWN BY MAP THEREOF ON FILE IN THE CLARK COUNTY, NEVADA RECORDER'S OFFICE IN BOOK 135, PAGE 71 OF PLATS.

GENERAL NOTES

1. REPLACE ALL TRAFFIC CONTROL DEVICES (SIGNS AND/OR PAVEMENT MARKINGS), UNDER CLARK COUNTY'S JURISDICTION, THAT ARE DISTURBED, DESTROYED, MOVED OR MODIFIED BY TRENCHING ACTIVITIES TO CLARK COUNTY'S SATISFACTION. ALL MATERIAL USED SHALL MEET CLARK COUNTY'S SPECIFICATIONS OR WILL WILL BE AN APPROVED EQUIVALENT.
2. IN THE EVENT THAT THE TRAFFIC SIGNAL CONDUITS, LOOP DETECTORS OR ASSOCIATED EQUIPMENT ARE DAMAGED BY CONTRACTOR, THE CONTRACTOR WILL HIRE AN IMSA LEVEL II ELECTRICAL CONTRACTOR TO MAKE REPAIRS PER UNIFORM SPECIFICATION NO. 623.G.01.02
3. NO STRUCTURE, VEGETATION, OR OBJECTS OF ANY KIND IS PERMITTED OVER TWENTY-FOUR (24) INCHES IN HEIGHT (MEASURED FROM THE TOP OF THE ADJACENT CURB IF CURB EXIST) WITHIN THE SIGHT VISIBILITY ZONES.
4. ALL ONSITE PRIVATE STREETS ARE P.U.E.S, CLV PUBLIC SEWER EASEMENTS AND PUBLIC DRAINAGE EASEMENTS TO BE PRIVATELY MAINTAINED.

SIGN LEGEND

	9" STREET NAME SIGN (D-3, BROWN WITH WHITE LETTERS, 2 PER POLE) PER SUMMERLIN IMPROVEMENT STANDARDS RS-1 [MAIN ST]
STOP	30" OR 36" STOP SIGN W/POST (R1-1) SIZE PER PLAN
FIRE LANE	TYPE A SIGN PER "SOUTHERN NEVADA FIRE CODE AMENDMENTS" SECTION 503.3
SPEED LIMIT 25	SPEED LIMIT (R2-1) - 24"x30"
	REFLECTIVE RAISED PAVEMENT MARKERS
	100W STREETLIGHT
	EXISTING 250W STREETLIGHT
	NO. 3-1/2 PULL BOX (STREET LIGHT)
P	P30 FIBER OPTIC PULL BOX (FAST)
	STREETLIGHT SERVICE PEDESTAL
	IRRIGATION SERVICE PEDESTAL
	TRAFFIC SIGN (AS INDICATED)
	TYPE IIIB BARRICADE PER CCAUSD NO. 601 FOR TEMPORARY USE
ER	18"X18" END OF ROAD MARKERS (OM4-1) (RED REFLECTIVE DIAMONDS) PER CCAUSD NO. 601
	SIGHT VISIBILITY ZONE

SEE SHEET C-3 FOR ABBREVIATIONS AND QUANTITIES

TRAFFIC NOTES

1. INSTALL 100W HPS STREET LIGHT WITH DECORATIVE POLE PER SUMMERLIN STANDARDS, FOUNDATION PER CCAUSD # 313, 314, 319, 320 & 321
2. INSTALL NO. 3-1/2 PULLBOX PER CCAUSD # 326
3. INSTALL 1-1/4" STREET LIGHT CONDUIT CONTAINING 2-#4, 1-#8 GND
4. INSTALL 125 AMP SERVICE PEDESTAL PER CCAUSD # 331 & 332.S2 (FOR IRRIGATION)
5. INSTALL SIGN PER PLAN (SEE LEGEND FOR SIGN DESCRIPTION)
6. INSTALL BLUE COLORED REFLECTIVE RAISED PAVEMENT MARKER
7. PAINT CURB RED 15' BOTH DIRECTION OF FIRE HYDRANT FOR A TOTAL OF 30' (WHEN CURB LENGTH PERMITTED)
8. EXISTING NO. 3-1/2 PULLBOX PER CLV L19-00027 (BRISTLE VALE-UNIT 1)
9. INSTALL 200 AMP SERVICE PEDESTAL PER CCAUSD #331, 332.S2 AND SUMMERLIN IMPROVEMENT STANDARD DETAIL FOR SINGLE SERVICE PEDESTAL (E-17)

SEE SHEET C-3 FOR ABBREVIATIONS, QUANTITIES & ADDITIONAL LEGEND

APPROVAL

LAS VEGAS FIRE AND RESCUE — 5/9/19 DATE

FAST
Call before you UnderGround
1-702-432-5300
FREEWAY & ARTERIAL SYSTEM OF TRANSPORTATION (F.A.S.T)

AVOID HITTING OVERHEAD POWER LINES. IT'S COSTLY.
CALL BEFORE YOU DO OVERHEAD
1-702-227-2929

Call before you Dig
AVOID CUTTING UNDERGROUND UTILITY LINES. IT'S COSTLY.
Call 811 OR
1-800-227-2600

SLATER HANIFAN GROUP
a Westwood team
5740 S. ARVILLE STREET #216, LAS VEGAS, NV 89118
PHONE (702) 284-5300
FAX (702) 284-5399

NO	DESCRIPTION	DATE	BY	APP	APP DATE
1	UPDATE TYPICAL STREETLIGHT LOCATION SECTION AND STREETLIGHTS LOCATION	05/7/19	PA		

LAS VEGAS, NV

KB HOME
BRISTLE VALE - UNIT 2
TRAFFIC PLAN I

S33 T20S R59E

DATE: 5/8/19
DRAFTER: OQ
DESIGNER: OQ
CHECKED: DSP
PROJECT NO.
KBH1804-000

PROFESSIONAL ENGINEER — TIMOTHY M. MULROONEY — Exp. 12/31/2019 — CIVIL — No. 22958 — STATE OF NEVADA — PROFESSIONAL ENGINEER — 5/8/19

T-1
SHEET 26 OF 29

L19-00527
107Y5102-2

J:\KBH1804-000 summerlin 424 parcel 18\dwg\mmron\phase 2\KBH1804-000 t-1 p2.dwg 5/8/2019 3:20 PM Oscar Quiroz

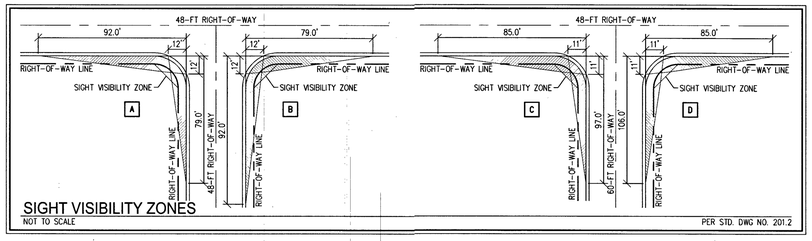

SIGHT VISIBILITY ZONES

NOT TO SCALE

PER STD. DWG NO. 201.2

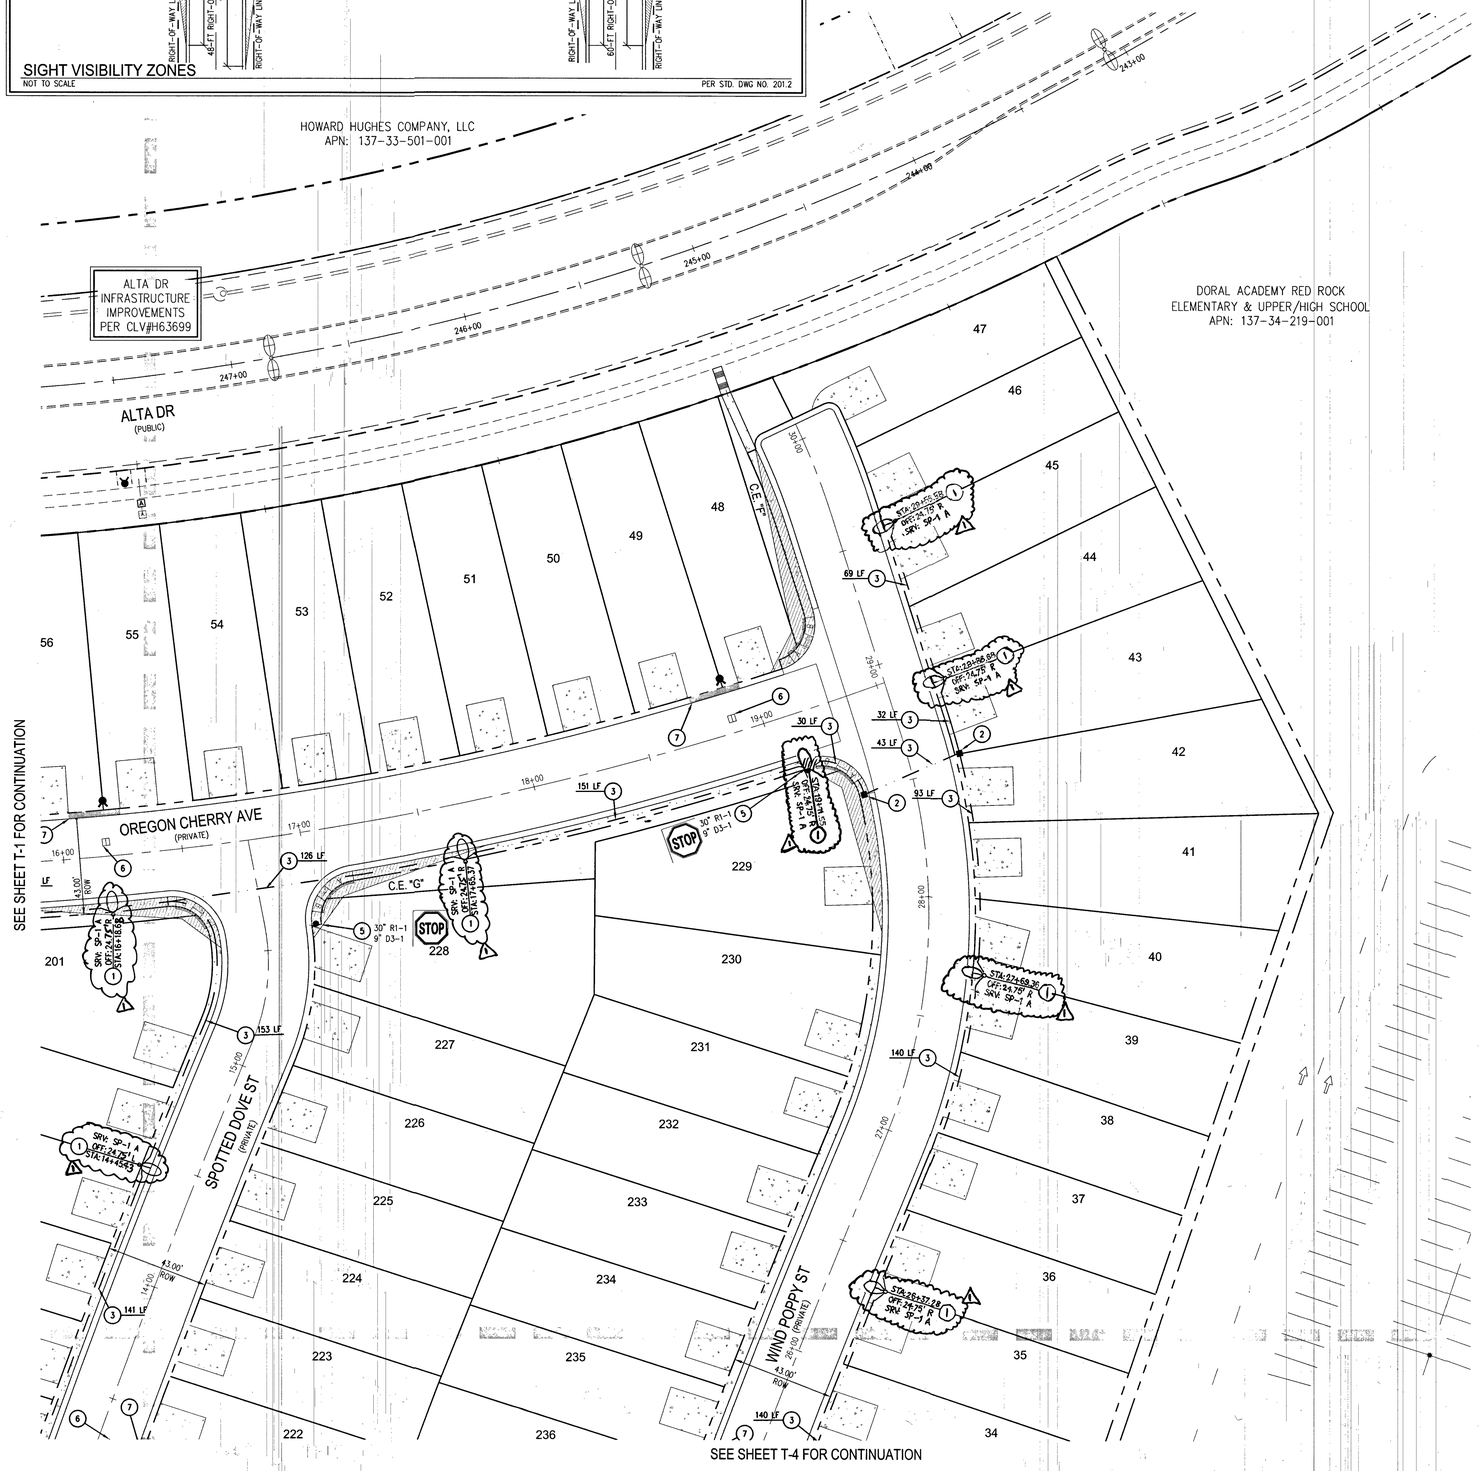

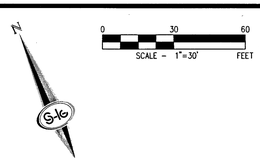

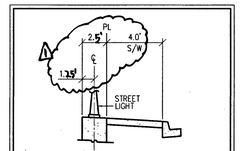

A. TYPICAL STREETLIGHT LOCATION

NOT TO SCALE

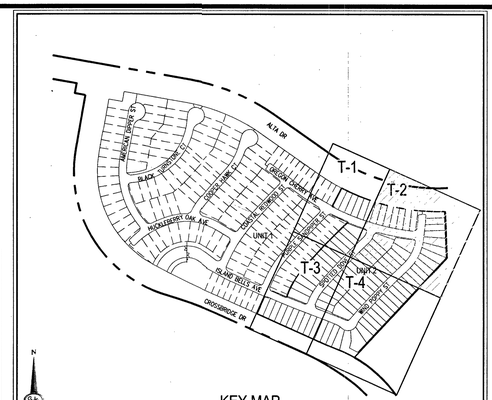

KEY MAP

NOT TO SCALE

ELECTRICAL NOTES

1. ALL UNDERGROUND CONDUIT SHALL BE TYPE RNC (RIGID NONMETALLIC CONDUIT), SCHEDULE 40 PVC AND SHALL BE INSTALLED PER DETAIL THIS SHEET. ABOVE GRADE CONDUIT SHALL BE TYPE RMC (RIGID METALLIC CONDUIT). CONDUIT RISERS SHALL BE TYPE RMC WITH PVC COATING OR TAPE WRAP. ALL CONDUIT WHICH WOULD OTHERWISE BE EMPTY SHALL INCLUDE A NYLON PULLSTRING AND 1#8 FOR LOCATING PURPOSES.
2. ALL CONDUCTOR SHALL BE STRANDED, 600V, TYPE THW INSULATED COPPER.
3. THE ELECTRICAL CONTRACTOR SHALL FURNISH AND INSTALL ALL ELECTRICAL COMPONENTS AND HARDWARE AS REQUIRED BY THE NATIONAL ELECTRICAL CODE, LATEST EDITION, AND SHALL COMPLY WITH THE REQUIREMENTS OF THE INSPECTING AUTHORITY HAVING JURISDICTION.

ELECTRICAL SERVICE NOTES

SP1: 200 AMP, SINGLE PHASE, 3 WIRE, 120/240V PAD MOUNTED SERVICE PEDESTAL. FEEDER FROM N.P.C.O. POINT OF CONNECTION TO BE 2"C., 2#4/0 THW, 1#4/0 WHITE THW (COPPER). TRANSFORMER TO SERVICE PEDESTAL DISTANCES GREATER THAN 250 FEET FOR SPECIFIED CONDUCTORS MUST BE APPROVED BY ENGINEER. SERVICE PEDESTAL SHALL BE LOCATED A MINIMUM OF 30 FEET FROM THE TRANSFORMER. THE FOLLOWING SHALL BE INCLUDED IN THE SERVICE PEDESTAL:
- (2) 60 AMP, 240V, 2-POLE CIRCUIT BREAKERS,
- (2) 60 AMP, 240V, 2-POLE LIGHTING CONTACTORS,
- (2) TEST SWITCHES (ONE FOR EACH CONTACTOR), PHOTOELECTRICAL CONTROL,
- (1) 15 AMP, 120V, SINGLE POLE CIRCUIT BREAKER FOR LIGHTING CONTROLS.

CONTRACTOR TO PROVIDE (2) 1-1/4" CONDUITS FROM SERVICE PEDESTAL TO FIRST STREETLIGHTING PULLBOX. SERVICE PEDESTAL SHALL COMPLY WITH CLARK COUNTY AREA UNIFORM STANDARD DRAWINGS 330, 331, 332.1 AND 335.1.

GENERAL NOTES

1. REPLACE ALL TRAFFIC CONTROL DEVICES (SIGNS AND/OR PAVEMENT MARKINGS), UNDER CLARK COUNTY'S JURISDICTION, THAT ARE DISTURBED, DESTROYED, MOVED OR MODIFIED BY TRENCHING ACTIVITIES TO CLARK COUNTY'S SATISFACTION. ALL MATERIAL USED SHALL MEET CLARK COUNTY'S SPECIFICATIONS OR WILL WILL BE AN APPROVED EQUIVALENT.
2. IN THE EVENT THAT THE TRAFFIC SIGNAL CONDUITS, LOOP DETECTORS OR ASSOCIATED EQUIPMENT ARE DAMAGED BY CONTRACTOR, THE CONTRACTOR WILL HIRE AN IMSA LEVEL II ELECTRICAL CONTRACTOR TO MAKE REPAIRS PER UNIFORM SPECIFICATION NO. 623.G.01.02
3. NO STRUCTURE, VEGETATION, OR OBJECTS OF ANY KIND IS PERMITTED OVER TWENTY-FOUR (24) INCHES IN HEIGHT (MEASURED FROM THE TOP OF THE ADJACENT CURB IF CURB EXIST) WITHIN THE SIGHT VISIBILITY ZONES.
4. ALL ONSITE PRIVATE STREETS ARE P.U.E.'S, CLV PUBLIC SEWER EASEMENTS AND PUBLIC DRAINAGE EASEMENTS TO BE PRIVATELY MAINTAINED.

TRAFFIC NOTES

1. INSTALL 100W HPS STREET LIGHT WITH DECORATIVE POLE PER SUMMERLIN STANDARDS, FOUNDATION PER CCAUSD # 313, 314, 319, 320 & 321
2. INSTALL NO. 3-1/2 PULLBOX PER CCAUSD # 326
3. INSTALL 1-1/4" STREET LIGHT CONDUIT CONTAINING 2-#4, 1-#8 GND
4. INSTALL 125 AMP SERVICE PEDESTAL PER CCAUSD # 331 & 332.S2 (FOR IRRIGATION)
5. INSTALL SIGN PER PLAN (SEE LEGEND FOR SIGN DESCRIPTION)
6. INSTALL BLUE COLORED REFLECTIVE RAISED PAVEMENT MARKER
7. PAINT CURB RED 15' BOTH DIRECTION OF FIRE HYDRANT FOR A TOTAL OF 30' (WHEN CURB LENGTH PERMITTED)
8. EXISTING NO. 3-1/2 PULLBOX PER CLV L19-00027 (BRISTLE VALE-UNIT 1)
9. INSTALL 200 AMP SERVICE PEDESTAL PER CCAUSD #331, 332.S2 AND SUMMERLIN IMPROVEMENT STANDARD DETAIL FOR SINGLE SERVICE PEDESTAL (E-17)

SEE SHEET C-3 FOR ABBREVIATIONS, QUANTITIES & ADDITIONAL LEGEND

BENCHMARK

CITY OF LAS VEGAS BENCHMARK 7LV09 34SW6

RIVET AND ROUND PLATE IN THE TOP OF CURB AT THE SOUTHEAST CORNER OF DESERT MOON RD. AND SKY VISTA DR.
ELEVATION = 1011.422 METERS (NAVD '88)
ELEVATION = 3318.31 US SURVEY FEET (NAVD '88)

BASIS OF BEARINGS

NORTH 05°59'55" WEST, BEING THE BEARING OF THE WEST LINE OF SECTION 34, TOWNSHIP 20 SOUTH, RANGE 59 EAST, M.D.M., CITY OF LAS VEGAS, CLARK COUNTY, NEVADA, AS SHOWN BY MAP THEREOF ON FILE IN THE CLARK COUNTY, NEVADA RECORDER'S OFFICE IN BOOK 135, PAGE 71 OF PLATS.

SIGN LEGEND

- 9" STREET NAME SIGN (D-3, BROWN WITH WHITE LETTERS, 2 PER POLE) PER SUMMERLIN IMPROVEMENT STANDARDS RS-1 (MAIN ST)
- 30" OR 36" STOP SIGN W/POST (R1-1) SIZE PER PLAN
- TYPE A SIGN PER "SOUTHERN NEVADA FIRE CODE AMENDMENTS" SECTION 503.3
- SPEED LIMIT 25 — SPEED LIMIT (R2-1) – 24"x30"
- REFLECTIVE RAISED PAVEMENT MARKERS
- 100W STREETLIGHT
- EXISTING 250W STREETLIGHT
- NO. 3-1/2 PULL BOX (STREET LIGHT)
- P30 FIBER OPTIC PULL BOX (FAST)
- STREETLIGHT SERVICE PEDESTAL
- IRRIGATION SERVICE PEDESTAL
- TRAFFIC SIGN (AS INDICATED)
- TYPE IIIB BARRICADE PER CCAUSD NO. 601 FOR TEMPORARY USE
- ER — 18"X18" END OF ROAD MARKERS (OM4-1) (RED REFLECTIVE DIAMONDS) PER CCAUSD NO. 601
- SIGHT VISIBILITY ZONE

SEE SHEET C-3 FOR ABBREVIATIONS AND QUANTITIES

APPROVAL

LAS VEGAS FIRE AND RESCUE — DATE 5/9/19

FAST Call before you UnderGround 1-702-432-5300 FREEWAY & ARTERIAL SYSTEM OF TRANSPORTATION (F.A.S.T.)

AVOID HITTING OVERHEAD POWER LINES. IT'S COSTLY. CALL BEFORE YOU DO OVERHEAD 1-702-227-2929

Call before you Dig. AVOID CUTTING UNDERGROUND UTILITY LINES. IT'S COSTLY. Call 811 OR 1-800-227-2600

SLATER HANIFAN GROUP
a Westwood team
5740 S. ARVILLE STREET #216, LAS VEGAS, NV 89118
PHONE (702) 284-5300 FAX (702) 284-5399

NO	DESCRIPTION	DATE	BY	APP'D	APP DATE
1	UPDATE TYPICAL STREETLIGHT LOCATION SECTION AND STREETLIGHTS LOCATION	07/17/19	PA		

LAS VEGAS, NV

KB HOME

BRISTLE VALE - UNIT 2

TRAFFIC PLAN II

S 33
T 20S
R 59E

DATE: 5/8/19
DRAFTER: OQ
DESIGNER: OQ
CHECKED: DSP
PROJECT NO.
KBH1804-000

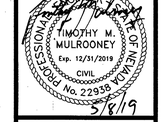

T-2

SHEET 27 OF 29

L19-00527
107Y5102-2

X:\Kbh1804-000 summerlin -24 parcel 18\civil\mmroo\drawings 2\kbh1804-000 tf p2.dwg 5/8/2019 3:20 PM Orson Quiroz

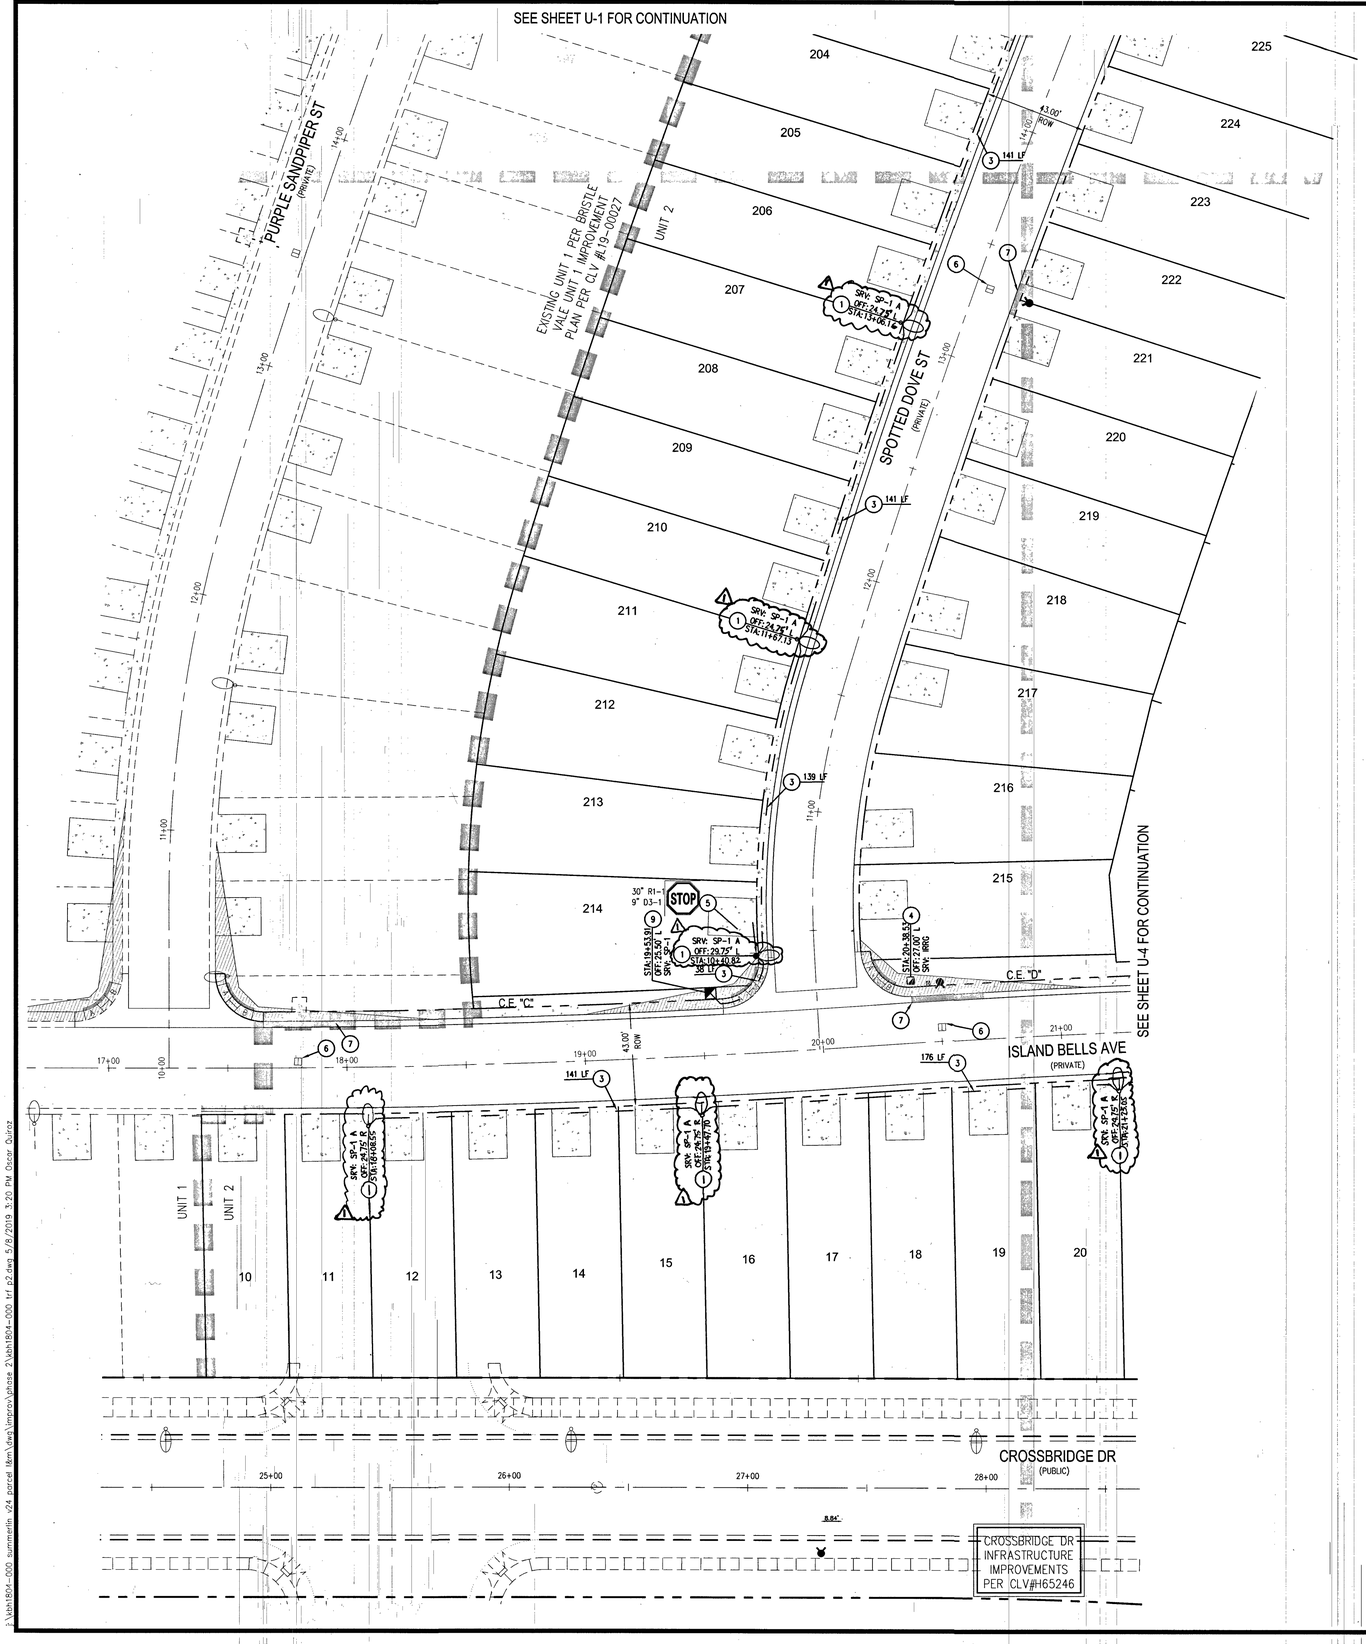

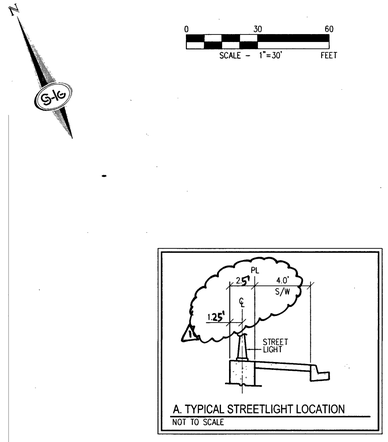

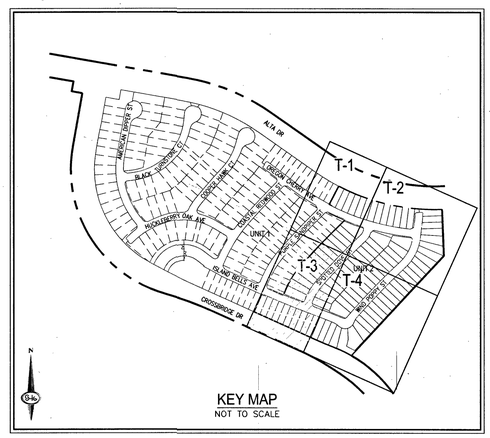

ELECTRICAL NOTES

1. ALL UNDERGROUND CONDUIT SHALL BE TYPE RNC (RIGID NONMETALLIC CONDUIT), SCHEDULE 40 PVC AND SHALL BE INSTALLED PER DETAIL THIS SHEET. ABOVE GRADE CONDUIT SHALL BE TYPE RMC (RIGID METALLIC CONDUIT). CONDUIT RISERS SHALL BE TYPE RMC WITH PVC COATING OR TAPE WRAP. ALL CONDUIT WHICH WOULD OTHERWISE BE EMPTY SHALL INCLUDE A NYLON PULLSTRING AND 1#8 FOR LOCATING PURPOSES.
2. ALL CONDUCTOR SHALL BE STRANDED, 600V, TYPE THW INSULATED COPPER.
3. THE ELECTRICAL CONTRACTOR SHALL FURNISH AND INSTALL ALL ELECTRICAL COMPONENTS AND HARDWARE AS REQUIRED BY THE NATIONAL ELECTRICAL CODE, LATEST EDITION, AND SHALL COMPLY WITH THE REQUIREMENTS OF THE INSPECTING AUTHORITY HAVING JURISDICTION.

BENCHMARK

CITY OF LAS VEGAS BENCHMARK 7LV09 34SW6

RIVET AND ROUND PLATE IN THE TOP OF CURB AT THE SOUTHEAST CORNER OF DESERT MOON RD. AND SKY VISTA DR.

ELEVATION = 1011.422 METERS (NAVD '88)
ELEVATION = 3318.31 US SURVEY FEET (NAVD '88)

ELECTRICAL SERVICE NOTES

SP1: 200 AMP, SINGLE PHASE, 3 WIRE, 120/240V PAD MOUNTED SERVICE PEDESTAL FEEDER FROM N.P.C.O. POINT OF CONNECTION TO BE 2"C. 2#4/0 THW, 1#4/0 WHITE THW (COPPER). TRANSFORMER TO SERVICE PEDESTAL DISTANCES GREATER THAN 250 FEET FOR SPECIFIED CONDUCTORS MUST BE APPROVED BY ENGINEER. SERVICE PEDESTAL SHALL BE LOCATED A MINIMUM OF 30 FEET FROM THE TRANSFORMER. THE FOLLOWING SHALL BE INCLUDED IN THE SERVICE PEDESTAL:
(2) 60 AMP, 240V, 2-POLE CIRCUIT BREAKERS,
(2) 60 AMP, 240V, 2-POLE LIGHTING CONTACTORS,
(2) TEST SWITCHES (ONE FOR EACH CONTACTOR), PHOTOELECTRICAL CONTROL,
(1) 15 AMP, 120V, SINGLE POLE CIRCUIT BREAKER FOR LIGHTING CONTROLS CONTRACTOR TO PROVIDE (2) 1-1/4" CONDUITS FROM SERVICE PEDESTAL TO FIRST STREETLIGHTING PULLBOX. SERVICE PEDESTAL SHALL COMPLY WITH CLARK COUNTY AREA UNIFORM STANDARD DRAWINGS 330, 331, 332.1 AND 335.1.

BASIS OF BEARINGS

NORTH 05°59'55" WEST, BEING THE BEARING OF THE WEST LINE OF SECTION 34, TOWNSHIP 20 SOUTH, RANGE 59 EAST, M.D.M., CITY OF LAS VEGAS, CLARK COUNTY, NEVADA, AS SHOWN BY MAP THEREOF ON FILE IN THE CLARK COUNTY, NEVADA RECORDER'S OFFICE IN BOOK 135, PAGE 71 OF PLATS.

GENERAL NOTES

1. REPLACE ALL TRAFFIC CONTROL DEVICES (SIGNS AND/OR PAVEMENT MARKINGS), UNDER CLARK COUNTY'S JURISDICTION, THAT ARE DISTURBED, DESTROYED, MOVED OR MODIFIED BY TRENCHING ACTIVITIES TO CLARK COUNTY'S SATISFACTION. ALL MATERIAL USED SHALL MEET CLARK COUNTY'S SPECIFICATIONS OR WILL WILL BE AN APPROVED EQUIVALENT.
2. IN THE EVENT THAT THE TRAFFIC SIGNAL CONDUITS, LOOP DETECTORS OR ASSOCIATED EQUIPMENT ARE DAMAGED BY CONTRACTOR, THE CONTRACTOR WILL HIRE AN IMSA LEVEL II ELECTRICAL CONTRACTOR TO MAKE REPAIRS PER UNIFORM SPECIFICATION NO. 623.C.01.02
3. NO STRUCTURE, VEGETATION, OR OBJECTS OF ANY KIND IS PERMITTED OVER TWENTY-FOUR (24) INCHES IN HEIGHT (MEASURED FROM THE TOP OF THE ADJACENT CURB IF CURB EXIST) WITHIN THE SIGHT VISIBILITY ZONES.
4. ALL ONSITE PRIVATE STREETS ARE P.U.E.S, CLV PUBLIC SEWER EASEMENTS AND PUBLIC DRAINAGE EASEMENTS TO BE PRIVATELY MAINTAINED.

SIGN LEGEND

- 9" STREET NAME SIGN (D-3, BROWN WITH WHITE LETTERS, 2 PER POLE) PER SUMMERLIN IMPROVEMENT STANDARDS RS-1 (MAIN ST)
- 30" OR 36" STOP SIGN W/POST (R1-1) SIZE PER PLAN
- TYPE A SIGN PER "SOUTHERN NEVADA FIRE CODE AMENDMENTS" SECTION 503.3
- SPEED LIMIT 25 — SPEED LIMIT (R2-1) - 24"x30"
- REFLECTIVE RAISED PAVEMENT MARKERS
- 100W STREETLIGHT
- EXISTING 250W STREETLIGHT
- NO. 3-1/2 PULL BOX (STREET LIGHT)
- P30 FIBER OPTIC PULL BOX (FAST)
- STREETLIGHT SERVICE PEDESTAL
- IRRIGATION SERVICE PEDESTAL
- TRAFFIC SIGN (AS INDICATED)
- TYPE IIIB BARRICADE PER CCAUSD NO. 601 FOR TEMPORARY USE
- ER — 18"X18" END OF ROAD MARKERS (OM4-1) (RED REFLECTIVE DIAMONDS) PER CCAUSD NO. 601
- SIGHT VISIBILITY ZONE

SEE SHEET C-3 FOR ABBREVIATIONS AND QUANTITIES

TRAFFIC NOTES

1. INSTALL 100W HPS STREET LIGHT WITH DECORATIVE POLE PER SUMMERLIN STANDARDS, FOUNDATION PER CCAUSD # 313, 314, 319, 320 & 321
2. INSTALL NO. 3-1/2 PULLBOX PER CCAUSD # 326
3. INSTALL 1-1/4" STREET LIGHT CONDUIT CONTAINING 2-#4, 1-#8 GND
4. INSTALL 125 AMP SERVICE PEDESTAL PER CCAUSD # 331 & 332.S2 (FOR IRRIGATION)
5. INSTALL SIGN PER PLAN (SEE LEGEND FOR SIGN DESCRIPTION)
6. INSTALL BLUE COLORED REFLECTIVE RAISED PAVEMENT MARKER
7. PAINT CURB RED 15' BOTH DIRECTION OF FIRE HYDRANT FOR A TOTAL OF 30' (WHEN CURB LENGTH PERMITTED)
8. EXISTING NO. 3-1/2 PULLBOX PER CLV L19-00027 (BRISTLE VALE-UNIT 1)
9. INSTALL 200 AMP SERVICE PEDESTAL PER CCAUSD #331, 332.S2 AND SUMMERLIN IMPROVEMENT STANDARD DETAIL FOR SINGLE SERVICE PEDESTAL (E-17)

SEE SHEET C-3 FOR ABBREVIATIONS, QUANTITIES & ADDITIONAL LEGEND

APPROVAL

LAS VEGAS FIRE AND RESCUE — DATE 5/9/19

FAST
Call before you UnderGround
1-702-432-5300
FREEWAY & ARTERIAL SYSTEM OF TRANSPORTATION (F.A.S.T.)

AVOID HITTING OVERHEAD POWER LINES. IT'S COSTLY.
CALL BEFORE YOU DO OVERHEAD
1-702-227-2929

Call before you Dig
AVOID CUTTING UNDERGROUND UTILITY LINES. IT'S COSTLY.
Call 811
OR
1-800-227-2600

SLATER HANIFAN GROUP
a Westwood team
5740 S. ARVILLE STREET #216, LAS VEGAS, NV 89118
PHONE (702) 284-5300
FAX (702) 284-5399

NO	DESCRIPTION	DATE	BY	APP.	APP. DATE
1	UPDATE INFRASTRUCTURE LOCATION, SECTION AND STREETLIGHT LOCATION	05/17/19	TM		

LAS VEGAS, NV

KB HOME
BRISTLE VALE - UNIT 2
TRAFFIC PLAN III

S33
T 20S
R 59E

DATE: 5/8/19
DRAFTER: OQ
DESIGNER: OQ
CHECKED: DSP

PROJECT NO.
KBH1804-000

PROFESSIONAL ENGINEER
TIMOTHY M. MULROONEY
Exp. 12/31/2019
CIVIL
No. 22938
STATE OF NEVADA
5/8/19

T-3
SHEET 28 OF 29

L19-00527
107Y5102-2

J:\KBH1804-000 summerlin_IX\ parcel 16\civil\version\sheets #2\KBH1804-000_tr1 p2.dwg 5/8/2019 3:20 PM Oscar Quiroz

SEE SHEET T-2 FOR CONTINUATION

SEE SHEET T-3 FOR CONTINUATION

DORAL ACADEMY RED ROCK ELEMENTARY & UPPER/HIGH SCHOOL
APN: 137-34-219-001

SCALE – 1"=30' (0, 30, 60 FEET)

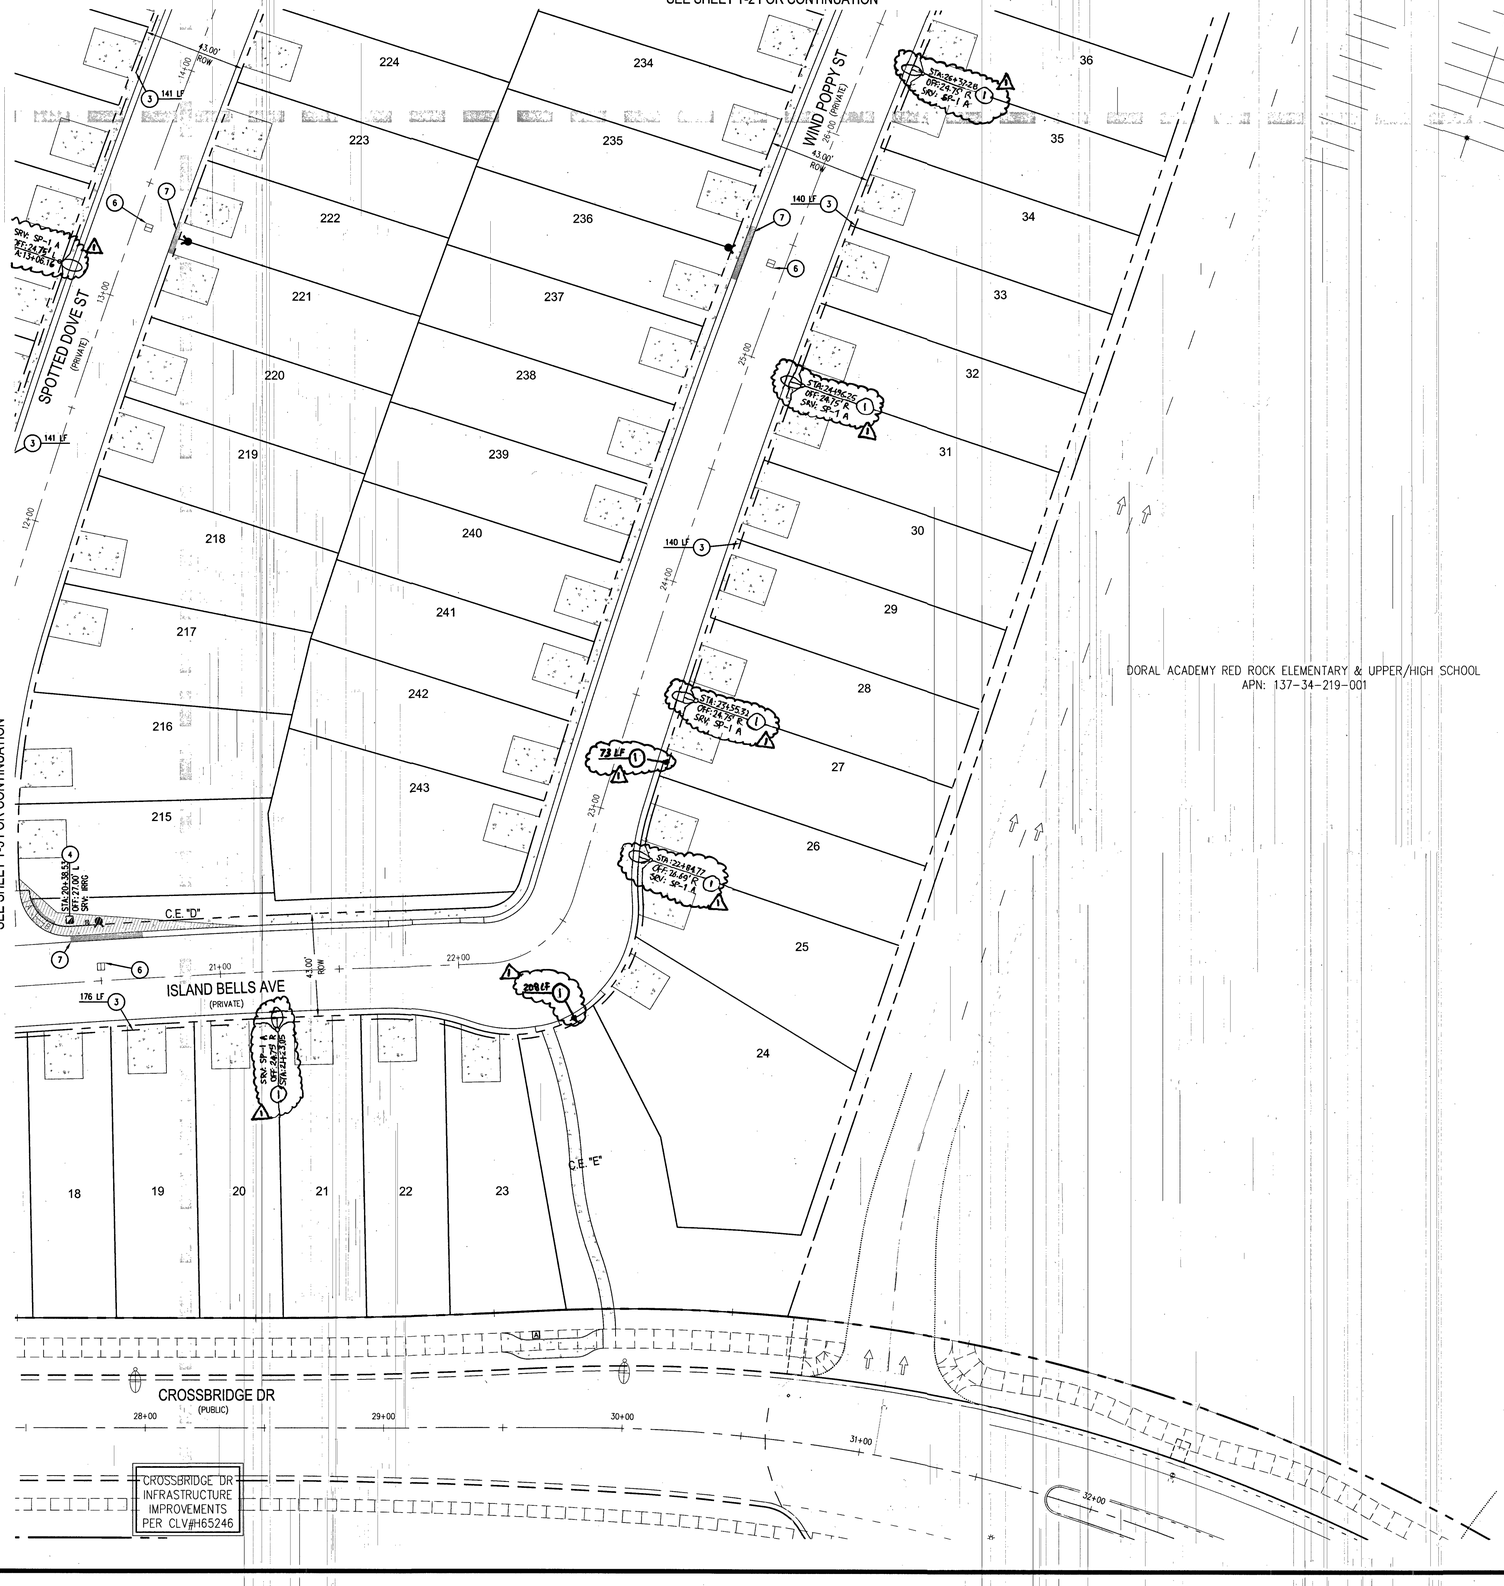

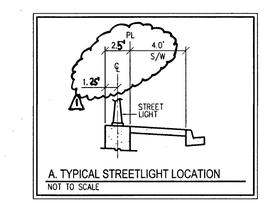

A. TYPICAL STREETLIGHT LOCATION
NOT TO SCALE

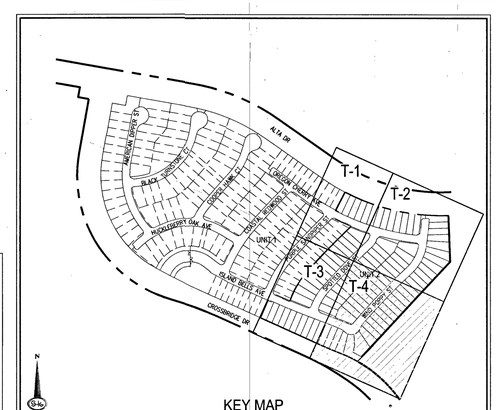

KEY MAP
NOT TO SCALE

ELECTRICAL NOTES

1. ALL UNDERGROUND CONDUIT SHALL BE TYPE RNC (RIGID NONMETALLIC CONDUIT), SCHEDULE 40 PVC AND SHALL BE INSTALLED PER DETAIL THIS SHEET. ABOVE GRADE CONDUIT SHALL BE TYPE RMC (RIGID METALLIC CONDUIT). CONDUIT RISERS SHALL BE TYPE RMC WITH PVC COATING OR TAPE WRAP. ALL CONDUIT WHICH WOULD OTHERWISE BE EMPTY SHALL INCLUDE A NYLON PULLSTRING AND TAG FOR LOCATING PURPOSES.
2. ALL CONDUCTOR SHALL BE STRANDED, 600V, TYPE THW INSULATED COPPER.
3. THE ELECTRICAL CONTRACTOR SHALL FURNISH AND INSTALL ALL ELECTRICAL COMPONENTS AND HARDWARE AS REQUIRED BY THE NATIONAL ELECTRICAL CODE, LATEST EDITION, AND SHALL COMPLY WITH THE REQUIREMENTS OF THE INSPECTING AUTHORITY HAVING JURISDICTION.

BENCHMARK

CITY OF LAS VEGAS BENCHMARK 7LV09 34SW6

RIVET AND ROUND PLATE IN THE TOP OF CURB AT THE SOUTHEAST CORNER OF DESERT MOON RD. AND SKY VISTA DR.

ELEVATION = 1011.422 METERS (NAVD '88)
ELEVATION = 3318.31 US SURVEY FEET (NAVD '88)

ELECTRICAL SERVICE NOTES

SP1: 200 AMP, SINGLE PHASE, 3 WIRE, 120/240V PAD MOUNTED SERVICE PEDESTAL. FEEDER FROM N.P.CO. POINT OF CONNECTION TO BE 2'C, 2#4/0 THW, 1#4/0 WHITE THW (COPPER). TRANSFORMER TO SERVICE PEDESTAL DISTANCES GREATER THAN 250 FEET FOR SPECIFIED CONDUCTORS MUST BE APPROVED BY ENGINEER. SERVICE PEDESTAL SHALL BE LOCATED A MINIMUM OF 30 FEET FROM THE TRANSFORMER. THE FOLLOWING SHALL BE INCLUDED IN THE SERVICE PEDESTAL:
(2) 60 AMP, 240V, 2-POLE CIRCUIT BREAKERS,
(2) 60 AMP, 240V, 2-POLE LIGHTING CONTACTORS,
(2) TEST SWITCHES (ONE FOR EACH CONTACTOR), PHOTOELECTRICAL CONTROL,
(1) 15 AMP, 120V, SINGLE POLE CIRCUIT BREAKER FOR LIGHTING CONTROLS.
CONTRACTOR TO PROVIDE (2) 1-1/4" CONDUITS FROM SERVICE PEDESTAL TO FIRST STREETLIGHTING PULLBOX. SERVICE PEDESTAL SHALL COMPLY WITH CLARK COUNTY AREA UNIFORM STANDARD DRAWINGS 330, 331, 332.1 AND 335.1.

BASIS OF BEARINGS

NORTH 05°59'55" WEST, BEING THE BEARING OF THE WEST LINE OF SECTION 34, TOWNSHIP 20 SOUTH, RANGE 59 EAST, M.D.M., CITY OF LAS VEGAS, CLARK COUNTY, NEVADA, AS SHOWN BY MAP THEREOF ON FILE IN THE CLARK COUNTY, NEVADA RECORDER'S OFFICE IN BOOK 135, PAGE 71 OF PLATS.

GENERAL NOTES

1. REPLACE ALL TRAFFIC CONTROL DEVICES (SIGNS AND/OR PAVEMENT MARKINGS), UNDER CLARK COUNTY'S JURISDICTION, THAT ARE DISTURBED, DESTROYED, MOVED OR MODIFIED BY TRENCHING ACTIVITIES TO CLARK COUNTY'S SATISFACTION. ALL MATERIAL USED SHALL MEET CLARK COUNTY'S SPECIFICATIONS OR WILL WILL BE AN APPROVED EQUIVALENT.
2. IN THE EVENT THAT THE TRAFFIC SIGNAL CONDUITS, LOOP DETECTORS OR ASSOCIATED EQUIPMENT ARE DAMAGED BY CONTRACTOR, THE CONTRACTOR WILL HIRE AN IMSA LEVEL II ELECTRICAL CONTRACTOR TO MAKE REPAIRS PER UNIFORM SPECIFICATION NO. 623.G.01.02
3. NO STRUCTURE, VEGETATION, OR OBJECTS OF ANY KIND IS PERMITTED OVER TWENTY-FOUR (24) INCHES IN HEIGHT (MEASURED FROM THE TOP OF THE ADJACENT CURB IF CURB EXIST) WITHIN THE SIGHT VISIBILITY ZONES.
4. ALL ONSITE PRIVATE STREETS ARE P.U.E.S, CLV PUBLIC SEWER EASEMENTS AND PUBLIC DRAINAGE EASEMENTS TO BE PRIVATELY MAINTAINED.

SIGN LEGEND

- 9" STREET NAME SIGN (0-3, BROWN WITH WHITE LETTERS, 2 PER POLE) PER SUMMERLIN IMPROVEMENT STANDARDS RS-1 (MAIN ST)
- STOP — 30" OR 36" STOP SIGN W/POST (R1-1) SIZE PER PLAN
- FIRE LANE — TYPE A SIGN PER "SOUTHERN NEVADA FIRE CODE AMENDMENTS" SECTION 503.3
- SPEED LIMIT 25 — SPEED LIMIT (R2-1) – 24"x30"
- REFLECTIVE RAISED PAVEMENT MARKERS
- 100W STREETLIGHT
- EXISTING 250W STREETLIGHT
- NO. 3-1/2 PULL BOX (STREET LIGHT)
- P30 FIBER OPTIC PULL BOX (FAST)
- STREETLIGHT SERVICE PEDESTAL
- IRRIGATION SERVICE PEDESTAL
- TRAFFIC SIGN (AS INDICATED)
- TYPE WB BARRICADE PER CCAUSD NO. 601 FOR TEMPORARY USE
- ER — 18"X18" END OF ROAD MARKERS (OM4-1) (RED REFLECTIVE DIAMONDS) PER CCAUSD NO. 601
- SIGHT VISIBILITY ZONE

SEE SHEET C-3 FOR ABBREVIATIONS AND QUANTITIES

TRAFFIC NOTES

1. INSTALL 100W HPS STREET LIGHT WITH DECORATIVE POLE PER SUMMERLIN STANDARDS, FOUNDATION PER CCAUSD # 313, 314, 319, 320 & 321
2. INSTALL NO. 3-1/2 PULLBOX PER CCAUSD # 326
3. INSTALL 1-1/4" STREET LIGHT CONDUIT CONTAINING 2-#4, 1-#8 GND
4. INSTALL 125 AMP SERVICE PEDESTAL PER CCAUSD # 331 & 332.S2 (FOR IRRIGATION)
5. INSTALL SIGN PER PLAN (SEE LEGEND FOR SIGN DESCRIPTION)
6. INSTALL BLUE COLORED REFLECTIVE RAISED PAVEMENT MARKER
7. PAINT CURB RED 15' BOTH DIRECTION OF FIRE HYDRANT FOR A TOTAL OF 30' (WHEN CURB LENGTH PERMITTED)
8. EXISTING NO. 3-1/2 PULLBOX PER CLV L19-00027 (BRISTLE VALE-UNIT 1)
9. INSTALL 200 AMP SERVICE PEDESTAL PER CCAUSD #331, 332.S2 AND SUMMERLIN IMPROVEMENT STANDARD DETAIL FOR SINGLE SERVICE PEDESTAL (E-17)

SEE SHEET C-3 FOR ABBREVIATIONS, QUANTITIES & ADDITIONAL LEGEND

APPROVAL
LAS VEGAS FIRE AND RESCUE — DATE 5/9/19

FAST
Call before you UnderGround
1-702-432-5300
FREEWAY & ARTERIAL SYSTEM OF TRANSPORTATION (F.A.S.T.)

AVOID HITTING OVERHEAD POWER LINES. IT'S COSTLY.
CALL BEFORE YOU DO OVERHEAD
1-702-227-2929

Call before you Dig
AVOID CUTTING UNDERGROUND UTILITY LINES. IT'S COSTLY.
Call 811 OR 1-800-227-2600

SLATER HANIFAN GROUP
a Westwood team
5740 S. ARVILLE STREET #216, LAS VEGAS, NV 89118
PHONE (702) 284-5300 FAX (702) 284-5399

NO	DESCRIPTION	DATE	BY	APP. DATE	APP.
1	UPDATE INTRO, STREETLIGHT LOCATION, SECTION AND STREET(S) LOCATION	07/11/19			

KB HOME
BRISTLE VALE - UNIT 2
TRAFFIC PLAN IV
LAS VEGAS, NV
S 33 T 20S R 59E

DATE: 5/8/19
DRAFTER: OQ
DESIGNER: OQ
CHECKED: DSP
PROJECT NO. KBH1804-000

TIMOTHY M. MULROONEY Exp. 12/31/2019 CIVIL No. 22938 STATE OF NEVADA PROFESSIONAL ENGINEER
5/8/19

T-4
SHEET 29 OF 29
L19-00527
107Y5102-2

J:\kbh1804-000 summerlin v24 pprice (dan_dean)\mmpcs\phase 2\kbh1804-000 tr1 r2.dwg 5/8/2019 3:21 PM Oscar Quiroz

NOTE: POLE TO STEEL BASE PLATE AND MAST ARM TO FIXTURE CONNECTION DETAILS SHALL BE PROVIDED BY THE MANUFACTURER AND DETERMINED THROUGH THE SHOP DRAWING REVIEW PROCESS.

PROVIDE 1/2" THREADED PLUG IN POLE CAP FOR PHOTOCELL MOUNTING.

NOTE: PHOTO EYE AND WIRING FOR BREAKER TO BE PER C.L.V. STANDARDS. CABINET LOCATIONS PER CORNER MUST BE LOCATED AWAY FROM TRAFFIC AND WITH LANDSCAPE PLAN CONSIDERATION.

REVISED	APPROVALS (INITIALS)		
2/2/93	HHP	GCW	CLV
DATE	OMR		

CUT OFF LUMINAIRE - LARGE

CUT OFF LUMINAIRE - SMALL

PROVIDE SLOTS IN FIXTURE ATTACHMENT FOR 10° +/- HORIZONTAL FIXTURE ADJUSTMENT SIDE TO SIDE. FIXTURE SHALL SET LEVEL FRONT TO BACK AND SIDE TO SIDE WHEN INSTALLED

SECTION A-A

SECTION B-B

PROVIDE SLOTS AND CLEARANCE TO POLE FOR ADJUSTMENT OF ARM

TOP DETAIL FOR DOUBLE ARM

PROVIDE 1/2" THREADED PLUG IN POLE CAP FOR PHOTOCELL MOUNTING.

CONCRETE POLE

SECTION C-C

SLOT (2") FOR POLE ROTATION ADJUSTMENT

CHAMFER 0.23 × SIDE

2¼" × 7½" MIN. HANDHOLE (SHOWN 90° ROTATED)

GROUND LUG (TYP)

I.D. TAG ON HANDHOLE COVER

VANDAL RESISTANT BOLTS

BARE #4 COPPER WIRE

1½" CONCRETE OVER "J" BOLT

1"R (TYP.)

FUSES AND SPLICES STUFFING SPACE

GREASE BEFORE POURING CAP

GROUND CONNECTOR

6" CONCRETE CAP

SEE FOUNDATION DWG E-26

1¼" P/C. CONDUIT

GROUND PLATE

30" DIA.

TYPE 4 SINGLE ARM

TYPE 3 SINGLE ARM

TYPE 2 DOUBLE OR SINGLE ARM

TYPE 1 DOUBLE OR SINGLE ARM

NOTE:

ALL INTERNAL AND EXTERNAL METALLIC COMPONENTS OF POLE, REINFORCING STEEL MOUNTING PLATE, HANDHOLE & POLE CAP SHALL BE ELECTRICALLY BONDED TOGETHER TO GROUND.

	"B"	"B"	"D"	"E"	"F"	"R"	SHAFT BASE	FOOTING	CUTOFF LUMINAIRE
TYPE 1	16"	16"	1"	8'	41'-9"	2.16	10-1/4"	30"Ø X 6'6"	LARGE
TYPE 2A	14"	14"	3/4"	8'	31'-2"	2.16	9-3/16"	30"Ø X 5'6"	LARGE
TYPE 2B	14"	14"	3/4"	5'	30'-7"	1.64	9-3/16"	30"Ø X 5'6"	LARGE
TYPE 3	14"	14"	3/4"	5'	26'4.5"	1.64	8-5/8"	30"Ø X 4'4"	SMALL
TYPE 4	14"	14"	3/4"	3'	16'11.5"	1.29	7-3/4"	30"Ø X 4'0"	SMALL

RECOMMENDED BY: DAVID H. MALPASS 7445 R.P.E.

APPROVED BY: C.L.V. CITY ENGINEER R.P.E. # 7569

SUMMERLIN STANDARD DRAWINGS

STREET LIGHT POLE, ARM AND FIXTURE DETAIL

DATE 8-88 | DWG. NO. E-2 | PAGE NO. 1 OF 1

SERVICE PEDESTAL ENCLOSURE, 12 GA. SHEET METAL BODY AND EQUIPMENT MOUNTING PANEL, 14 GA. FRONT COVER(S) AND 16 GA. MIN. FOR ALL OTHER PANELS. ALL SHEET METAL SHALL BE FINISHED WITH ZINC CHROMATE PRIMER AND SUMMERLIN GRAY BAKED ENAMEL OR POWDER COAT FINISH. METERING SECTION PER P.U.E.S.E.R. STANDARDS.

UTILITY METER SECTION, 100, 125 OR 200 AMP AS NEEDED, 120/240 VOLT, 1 PHASE, 3 WIRE. THE SECTION SHALL HAVE A HINGED COVER WITH PADLOCK TAB.

CIRCUIT BREAKER DISTRIBUTION SECTION, 100, 125 OR 200 AMP AS NEEDED, 120/240 VOLT, 1 PHASE, 3 WIRE. THE SECTION SHALL BE COMPLETE WITH SEPARATE DEAD FRONT, COPPER BUSSING, SPACE FOR A MINIMUM OF TEN FULL SIZE (1") GE TYPE PLUG-IN CIRCUIT BREAKERS (EXCLUDING MAIN BREAKER), COPPER NEUTRAL/GROUNDING BUS AND MAIN BREAKER AS SPECIFIED BY THE ENGINEER. THE SECTION SHALL BE FACTORY WIRED TO THE METER SECTION WITH THE APPROPRIATE SIZE COPPER CONDUCTORS.

EQUIPMENT MOUNTING PANEL, 12" H X 12" W MIN. OPEN OR ENCLOSED, FOR LIGHTING CONTACTORS AS NEEDED.

DISTRIBUTION AND EQUIPMENT SECTION COVER WITH PADLOCK TAB.

UTILITY METER SECTION

CIRCUIT BREAKER DISTRIBUTION SECTION

EQUIPMENT MOUNTING PANEL

UTILITY SERVICE ENTRANCE CONDUCTOR PULL SPACE PER SERVING UTILITY REQUIREMENTS.

PULL SPACE ACCESS DOOR WITH HANDLE, PER SERVING UTILITY

SEPARATE PEDESTAL ENCLOSURE MOUNTING BASE (OPTIONAL)

BASE AND ENCLOSURE WIDTH (16" TYP.)

BASE DEPTH (16" TYP.)

ENCLOSURE DEPTH (12" TYP.)

TYPICAL MOUNTING BASE DETAIL

(DIMENSIONS MAY VARY DEPENDING ON MANUFACTURER)

REVISED	APPROVALS (INITIALS)		
5-10-99	HHP	GCW	CLV
DATE	OMR		

RECOMMENDED BY: Thomas J. Kelly #6367 R.P.E.#

APPROVED BY: CITY PLANNING ENGINEER P.E. NO. 4784

SUMMERLIN STANDARD DRAWINGS

SINGLE METER SERVICE PEDESTAL

DATE | DWG. NO. E-17 | PAGE NO. 1 OF 1

STREET LIGHT POLE FOUNDATIONS

30" DIA.

OPTIONAL SQUARE FOOTING

#6 REBAR - 8 REQ'D.

#3 TIES - 12" O.C.

USE TEMPLATE PROVIDED BY MFR.

1"R (TYP.)

1½" CONCRETE OVER "J" BOLT

6" CONCRETE CAP (ROUND)

GROUND CONNECTOR

#3 TIES

#6 REBAR

CONDUIT - AS REQ'D.

ANCHOR BOLTS - 4 REQ'D.

#4 COPPER GROUND WIRE

CONCRETE BASE

STANDARD GROUND PLATE

	DEPTH "D"	ANCHOR BOLT
TYPE 1	5'6"	1¼" × 44" × 4"
TYPE 2	5'6"	1" × 36" × 4"
TYPE 3	4'6"	1" × 36" × 4"
TYPE 4	4'0"	1" × 30" × 4"

	DEPTH "D"	ANCHOR BOLTS
TYPE 5	12'-0"	1¾" × 60" × 6"
TYPE 6	10'-6"	1¼" × 44" × 4"

NOTE:

1. ALL CONCRETE SHALL BE TYPE V CONCRETE CLASS SHALL BE IN ACCORDANCE WITH THE LATEST EDITION OF THE UNIFORM STANDARD SPECIFICATIONS FOR PUBLIC WORKS CONSTRUCTION OFF-SITE IMPROVEMENTS, CLARK COUNTY AREA, NEVADA.
2. PLACE CONCRETE AGAINST UNDISTURBED EARTH OR 95% COMPACTED BACKFILL (10' MIN. RADIUS AROUND FOUNDATION)
3. CALCULATION SHEETS AND DETAILS WILL BE SUBMITTED, SIGNED AND SEALED BY A REGISTERED PROFESSIONAL ENGINEER. TO CLV FOR REVIEW AND APPROVAL FOR FOUNDATION DESIGNS OTHER THAN SHOWN PER THIS STANDARD.

REVISED	APPROVALS (INITIALS)		
6-10-99	HHP	GCW	CLV
DATE	OMR	CWF	CE

REVISED	APPROVALS (INITIALS)		
2/2/93	HHP	GCW	CLV
DATE	OMR		

RECOMMENDED BY: DAVID H. MALPASS 7445 R.P.E.

APPROVED BY: C.L.V. CITY ENGINEER R.P.E. # 7569

SUMMERLIN STANDARD DRAWINGS

FOUNDATION

DATE 8-88 | DWG. NO. E-26 | PAGE NO. 1 OF 1

SLATER HANIFAN GROUP
a Westwood team
5740 S. ARVILLE STREET #216, LAS VEGAS, NV 89118
PHONE (702) 264-5300
FAX (702) 264-5399

NO.	DESCRIPTION	DATE	BY	APP. DATE	APP.
1	ADD SHEET E-5 TO PLAN SET	07/17/19	PA		

LAS VEGAS, NV

BRISTLE VALE - UNIT 2
TRAFFIC PLAN V

S 33
T 20S
R 60E

DATE: 5/8/19
DRAFTER: OQ
DESIGNER: OQ
CHECKED: DSP

PROJECT NO.
KBH1804-000

PROFESSIONAL ENGINEER — STATE OF NEVADA — TIMOTHY M. MULROONEY — Exp. 12/31/2019 — CIVIL — No. 22936 — 9/11/19

T-5
SHEET 29B OF 29

L19-00527
107Y5102-2

J:\KBH1804-000 summerlin v24 parcel 18\em\dwg\improv\phase 2\KBH1804-000 trf p2.dwg 9/11/2019 12:29 PM Oscar Quiroz

LEGEND

- EXISTING GAS MAIN
- EXISTING GAS SERVICE
- GAS LINE TO BE ABANDONED
- STEEL RISER
- ANODELESS RISER
- GASLIGHT
- GAS VALVE
- EXCESS FLOW VALVE
- RELIEF VALVE
- COUPLINGS
- BOND OVER
- TEST POINT
- INSULATOR
- REGULATOR STATION
- RECTIFIER
- ANODE
- SCADA
- METER SET ASSEMBLY
- PURGE POINT
- BRANCH,CVT,LINE STOPPER
- GAS LINE TO BE ABANDONED
- PROPOSED GAS MAIN
- PROPOSED GAS SERVICE
- EXISTING EASEMENT
- ROW LINE
- PROPERTY LINE
- STREET CENTERLINE
- EDGE OF PAVEMENT
- CABLE LINE - UNDERGROUND — CATV
- ELECTRIC - OVERHEAD — OHE
- ELECTRIC - UNDERGROUND — UGE
- FIBER OPTIC - UNDERGROUND — FO
- PHONE - OVERHEAD — OHT
- PHONE - UNDERGROUND — UGT
- RECLAIMED WATER — RW
- SEWER — S
- STORMWATER — SD
- WATER — W
- UTILITY PEDESTALS
- FIRE HYDRANT
- MANHOLE
- WATER VALVE
- SURVEY MONUMENT
- POWER POLE
- GAS FLOW ARROW — FLOW

N

N.T.S.

SHEET INDEX MAP

SHEET INDEX

1	COVER SHEET
2	SIGNATURE SHEET
3	NOTES AND STANDARD DETAILS
4	NOTES AND STANDARD DETAILS
5	DETAIL SHEET
6	PLAN SHEET
7	PLAN SHEET

N

N.T.S.

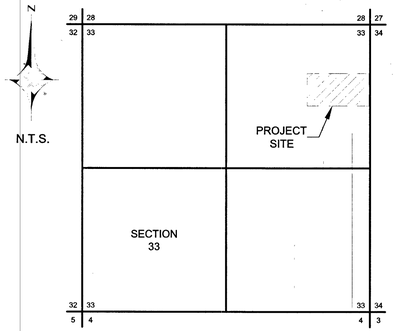

LOCATION MAP

T20S R59E S33

Total footage located in Public ROW 28'

APPROVED FOR CONSTRUCTION

THIS APPROVAL IS FOR WORK IN CLV R/W OR CLV EASEMENTS ONLY. OBTAINING PERMISSIONS OR EASEMENTS FOR WORK SHOWN ON PRIVATE PROPERTY IS THE RESPONSIBILITY OF THE UTILITY.

SEE COVER OF CIVIL PLAN
APPROVAL DATE

Hansen Dwg

CUSTOMER 94

811 Know what's **below.** **Call** before you dig.

SOUTHWEST GAS CORPORATION

Southwest Gas Corporation Confidential and Proprietary Information

For Reference Only - Not Valid for Line Locating Purposes. No representation or warranty is made for the adequacy, accuracy or completeness of the information or depictions shown. **This information is protected from further disclosure under the federal Freedom of Information Act and the Protected Critical Infrastructure Information Act of 2002, and Nevada Revised Statutes § 239C.**

This document may not be copied, distributed, or shared to any other person or entity in any manner or form without prior written consent of Southwest Gas Corporation.

REVISIONS

NO.	DESCRIPTION	BY	DATE	APPVD.
1	DEVELOPER'S WET UTILITY ALIGNMENT CHANGED	JW	8/20/2019	

PERMIT INFORMATION	ISOLATION AREA	LOCATION	ATLAS OR TILE
CITY OF LAS VEGAS TAX CODE 02-0200	ISO_21_DIST_323	T205 R59E S33 M.D.M.	X561Y516

D_W_VALLEY

SYSTEM MAOP: 60

SYSTEM MOP: 55

SYSTEM MAOP:

SYSTEM MOP:

JOB TYPE

- HP SERVICE ☐
- DISTRIBUTION ☒
- FEEDER ☐
- TRANS. BY DEF ☐
- TRANS > 20% ☐

WR NO. 3811882 (INST)

RELATED WR NO.S 3814077 (ABND)

ENGINEER/TECHNICIAN	JALANIA WRIGHT	PHONE:	(702)365-2188
ACCOUNT REP.	TONY VANCHIERI	PHONE:	(702)365-2038
PROJECT CONTACT	ARIC BONNER	PHONE:	(702)236-4671
SHEET NO. 1 OF 7	SCALE N.T.S.	DATE	08/20/2019
DWN. BY BC&F	CHKD. BY JW	APPVD. BY	BWJ

S BRISTLE VALE UNIT 2

L19-00527
107Y5102-2

PRESSURE TEST PERFORMED BY AND VERIFIED BY SIGNATURES

I HAVE **PERFORMED** THE PRESSURE TESTS AS SHOWN ON THE AS-BUILT AND IN ACCORDANCE WITH THE OPERATIONS MANUAL.

I HAVE **VERIFIED** THE PRESSURE TESTS AS SHOWN ON THE AS-BUILT AND IN ACCORDANCE WITH THE OPERATIONS MANUAL.

PRESSURE TEST #____ PERFORMED BY_____ DATE _____

SWG VERIFIED BY_____ DATE _____

PURGE PLAN PERFORMED BY SIGNATURES

PURGE PLAN WAS COMPLETED IN ACCORDANCE WITH THE OPERATIONS MANUAL GUIDELINES:

PERFORMED BY_____ DATE _____ SHEET#_____

LOCATION _____

PIPE JOINER VISUAL INSPECTION CERTIFICATION

I HAVE VISUALLY INSPECTED ALL HEATED FUSIONS, SOLVENT, CEMENT, MECHANICAL JOINTS, AND WELDS THAT I HAVE PERFORMED

NAME _____ PJQ# _____

2ND VISUAL INSPECTION CERTIFICATION

I HAVE VISUALLY INSPECTED ALL HEATED FUSIONS, SOLVENT, CEMENT AND MECHANICAL JOINTS THAT HAVE BEEN PERFORMED (INSPECTION OF FINAL JOINT ON PLASTIC PIPE ONLY)

NAME _____ PJQ# _____

CONSTRUCTION

INSPECTOR _____ PJQ# _____

FOREMAN _____ PJQ# _____

REVIEWED BY _____ PJQ# _____

AS-BUILT DRAWING-PRESSURE TEST DATA TEST # ____

DESCRIPTION: TEST MEDIUM: AIR, NITROGEN, WATER, NATURAL GAS — TEST METHOD: GAUGE, CHART, SOAP

TEST POINTS

PIPE DIA.

TOTAL LENGTH

PIPE TYPE GAUGE SN#

MIN. DURATION PRESS REC SN#

PRESSURE (ALL TESTS) (START) (STOP)

PRESSURE (CHART ONLY) (MIN) (MAX)

TIME (START) (STOP)

DATE (START) (STOP)

INTERMEDIATE LEAK TEST YES NO

LEAK SURVEY WR# (NATURAL GAS TEST ONLY)

ANY LEAKS OR FAILURES ON A TEST YES NO

IF YES, NOTE THE LEAKS AND FAILURES AND THEIR DISPOSITION:

PERFORMED BY (PRINT NAME AND EMPLOYEE # OR CONTRACTOR #):

AS-BUILT DRAWING-PRESSURE TEST DATA TEST # ____

DESCRIPTION: TEST MEDIUM: AIR, NITROGEN, WATER, NATURAL GAS — TEST METHOD: GAUGE, CHART, SOAP

TEST POINTS

PIPE DIA.

TOTAL LENGTH

PIPE TYPE GAUGE SN#

MIN. DURATION PRESS REC SN#

PRESSURE (ALL TESTS) (START) (STOP)

PRESSURE (CHART ONLY) (MIN) (MAX)

TIME (START) (STOP)

DATE (START) (STOP)

INTERMEDIATE LEAK TEST YES NO

LEAK SURVEY WR# (NATURAL GAS TEST ONLY)

ANY LEAKS OR FAILURES ON A TEST YES NO

IF YES, NOTE THE LEAKS AND FAILURES AND THEIR DISPOSITION:

PERFORMED BY (PRINT NAME AND EMPLOYEE # OR CONTRACTOR #):

AS-BUILT DRAWING-PRESSURE TEST DATA TEST # ____

DESCRIPTION: TEST MEDIUM: AIR, NITROGEN, WATER, NATURAL GAS — TEST METHOD: GAUGE, CHART, SOAP

TEST POINTS

PIPE DIA.

TOTAL LENGTH

PIPE TYPE GAUGE SN#

MIN. DURATION PRESS REC SN#

PRESSURE (ALL TESTS) (START) (STOP)

PRESSURE (CHART ONLY) (MIN) (MAX)

TIME (START) (STOP)

DATE (START) (STOP)

INTERMEDIATE LEAK TEST YES NO

LEAK SURVEY WR# (NATURAL GAS TEST ONLY)

ANY LEAKS OR FAILURES ON A TEST YES NO

IF YES, NOTE THE LEAKS AND FAILURES AND THEIR DISPOSITION:

PERFORMED BY (PRINT NAME AND EMPLOYEE # OR CONTRACTOR #):

811 Know what's **below.** **Call** before you dig.

SOUTHWEST GAS CORPORATION

Southwest Gas Corporation Confidential and Proprietary Information

For Reference Only - Not Valid for Line Locating Purposes. No representation or warranty is made for the adequacy, accuracy or completeness of the information or depictions shown. **This information is protected from further disclosure under the federal Freedom of Information Act and the Protected Critical Infrastructure Information Act of 2002, and Nevada Revised Statutes § 239C.**

This document may not be copied, distributed, or shared to any other person or entity in any manner or form without prior written consent of Southwest Gas Corporation.

REVISIONS

NO.	DESCRIPTION	BY	DATE	APPVD.
1	DEVELOPER'S WET UTILITY ALIGNMENT CHANGED	JW	8/20/2019	

PERMIT INFORMATION	ISOLATION AREA	LOCATION	ATLAS OR TILE
CITY OF LAS VEGAS TAX CODE 02-0200	ISO_21_DIST_323	T205 R59E S33 M.D.M.	X561Y516

D_W_VALLEY

SYSTEM MAOP: 60

SYSTEM MOP: 55

SYSTEM MAOP:

SYSTEM MOP:

JOB TYPE

HP SERVICE ☐

DISTRIBUTION ☒

FEEDER ☐

TRANS. BY DEF ☐

TRANS > 20% ☐

WR NO. 3811882 (INST)

RELATED WR NO.S 3814077 (ABND)

ENGINEER/TECHNICIAN	JALANIA WRIGHT	PHONE: (702)365-2188
ACCOUNT REP.	TONY VANCHIERI	PHONE: (702)365-2038
PROJECT CONTACT	ARIC BONNER	PHONE: (702)236-4671
SHEET NO. 2 OF 7	SCALE N.T.S.	DATE 08/20/2019
DWN. BY BC&F	CHKD. BY JW	APPVD. BY BWJ

S BRISTLE VALE UNIT 2

L19-00527
107Y5102-2

GENERAL NOTES:

1. SUGGESTED GAS LOCATIONS ARE TO CLEAR SUBSTRUCTURES LOCATED IN THE FIELD.
2. ALL PIPELINE CONSTRUCTION SHALL CONFORM TO APPLICABLE JURISDICTION SPECIFICATIONS.
3. DO NOT SCALE THIS DRAWING.
4. CHANGE IN PROPOSED MAIN LOCATION MUST BE AUTHORIZED BY SWG ENGINEER PRIOR TO INSTALLATION.
5. GAS MAINS SHALL BE PURGED PER OPERATIONS MANUAL.
6. ALL EXISTING UTILITY LOCATIONS TO BE VERIFIED PRIOR TO START OF CONSTRUCTION.
7. CONTACT ENGINEERING FOR BYPASS INFORMATION.
8. ALL MAIN TIE-INS REQUIRING TEES ARE TO BE FULL-FLOW TEES UNLESS OTHERWISE STATED.
9. ALL SHORING REQUIREMENTS SHALL CONFORM TO APPLICABLE PORTIONS OF THE OPERATIONS MANUAL.
10. REQUEST FOR SURVEYING AND/OR STAKING WILL BE SUBMITTED TO ENGINEERING 72 HOURS IN ADVANCE, MINIMUM.
11. PROPOSED MAIN SHOULD END 3' PAST THE LAST SERVICE FOR MAIN NOT BEING STUBBED FOR FUTURE PHASE(S).
12. MINIMUM TEST DURATION REQUIREMENTS AND GUIDELINES FOR MAIN INSTALLATION IN SYSTEMS <60 PSIG ARE:
    A. MINIMUM TEST DURATION IS 8 HOURS FOR PIPES 1-1/4-INCHES OR GREATER, WITH FOOTAGES BETWEEN 3,001 FEET AND 10,000 FEET
    B. ALL FOOTAGES GREATER THAN 3,000 FEET REQUIRE A CHART
    C. CONSTRUCTION SHALL CONTACT ENGINEERING FOR MINIMUM TEST DURATIONS IF THE FOOTAGE TO BE TESTED EXCEEDS 10,000 FEET
13. TRENCHING AND BACKFILL TO CONFORM WITH RTC STANDARD 500.2, 503, AND UNIFORM STANDARD SPECIFICATION SECTION 208.
14. MAINTAIN MINIMUM 12" VERTICAL SEPARATION AT ALL POINTS OF CROSSING.
15. MAINTAIN A MINIMUM 3' PARALLEL SEPARATION.
16. ANY EXCAVATION EXPOSING LVVWD FACILITIES 24" IN DIAMETER AND LARGER MUST REMAIN OPEN UNTIL INSPECTED BY LVVWD. NO BACKFILL MATERIAL IS TO BE PLACED IN THE EXCAVATION UNTIL APPROVED BY THE LVVWD INSPECTOR. ANY DAMAGE TO THE FACILITIES MUST BE REPORTED TO LVVWD IMMEDIATELY. CONTRACTOR TO CALL (702) 258-7171 TO SCHEDULE LVVWD INSPECTION.

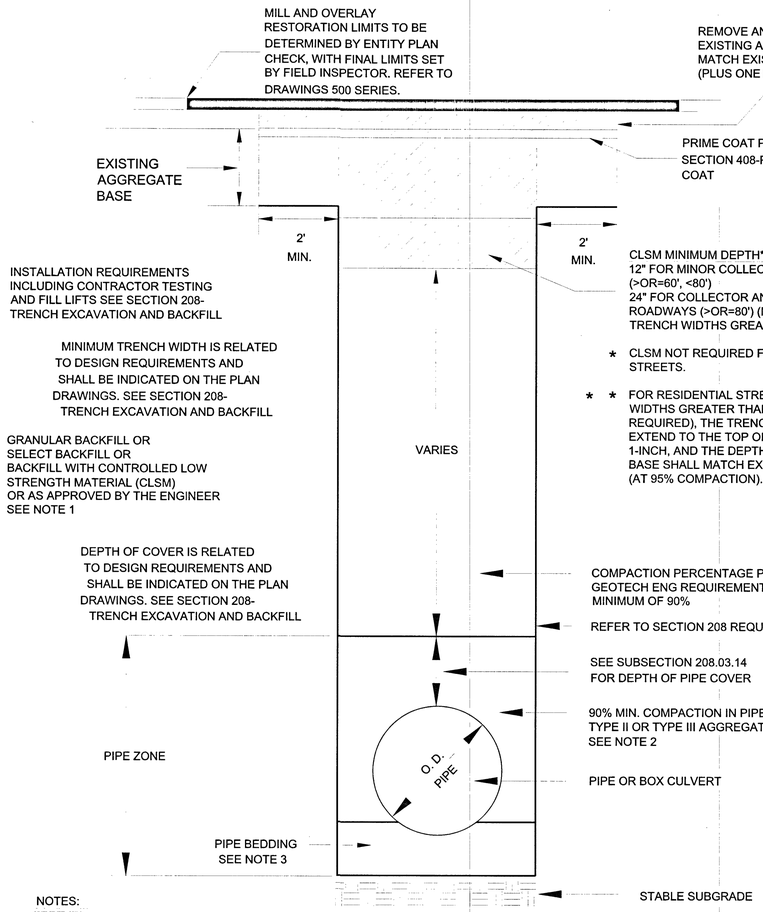

NOTES:

1. NO STONES OR LUMPS GREATER THAN 3" PERMITTED IN TRENCH 2' OR LESS IN WIDTH.
2. TRENCH WIDTH, BEDDING, SUBGRADE AND PIPE ZONE REQUIREMENTS FOR UTILITY INSTALLATIONS SHALL CONFORM TO THE RESPECTIVE ENTITY REQUIREMENTS.
3. CRUSHED ROCK MAY BE USED FOR PIPE BEDDING ONLY IF MATERIAL USE HAS BEEN SPECIFICALLY APPROVED BY THE GOVERNING AGENCY. SEE STANDARD DRAWING NO. 505 FOR PIPE BEDDING METHODS.
4. LAS VEGAS VALLEY WATER DISTRICT REQUIRES PIPE BEDDING AND BACKFILL WITHIN THE PIPE ZONE TO BE OF THE SAME MATERIAL.

RTC STD DWG 503

ABBREVIATIONS:

AA	ALDYL-A PIPE
ABND	ABANDONED
AC	ASPHALTIC CONCRETE
AC#	ACCELERATED CONSTRUCTION
ACP	ASBESTOS CEMENT PIPE
APN	ASSESSOR PARCEL NUMBER
BLVD	BOULEVARD
BM	BENCHMARK
BO	BLOW OFF
BTU	BRITISH THERMAL UNIT
CIP	CAST IRON PIPE
CL	CENTERLINE
CMP	CORRUGATED METAL PIPE
CP	CATHODIC PROTECTION
D	INSIDE DIAMETER
DDCA	DESIGN DATA COLLECTION APPLICATION
DET	DETAIL
DIP	DUCTICLE IRON PIPE
DIA	DIAMETER
DIMP	DISTRIBUTION INTEGRITY MANAGEMENT PROGRAM
DP	DESIGN PRESSURE
DWG	DRAWING
EFV	EXCESS FLOW VALVE
EG	EXISTING GRADE
ELEC	ELECTRICAL
ELEV	ELEVATION
EMS	ELECTRONIC MARKING SYSTEM
E.P	END POINT
EPR	ELECTRONIC PRESSURE RECORDERS
ESMT	EASEMENT
EX	EXISTING
FERC	FEDERAL ENERGY REGULATORY COMMISSION
FH	FIRE HYDRANT
GIR	GAS INFRASTRUCTURE REPLACEMENT
GPR	GAS PRESSURE REGULATOR
HCA	HIGH CONSEQUENCE AREA
HDD	HEATING DEGREE DAY
HDPE	HIGH DENSITY POLYETHYLENE PIPE
HP	HIGH PRESSURE
HOP	HISTORIC OPERATING PRESSURE
HVTT	HIGH VOLUME TAPPING TEE
IN	INCH(ES)
IPS	IRON PIPE SIZE
JT	JOINT TRENCH
MAOP	MAXIMUM ALLOWABLE OPERATING PRESSURE
M&C	MEASUREMENTS & CONTROL
MCFH	THOUSAND CUBIC FEET PER HOUR
MH	MANHOLE
MOP	MAXIMUM OPERATING PRESSURE
MP	MANUFACTURER'S PRESSURE RATING
MSA	METER SET ASSEMBLY
MVP	MAPPING VERIFICATION PROCEDURE
NAP	NOT A PART
NTSB	NATIONAL TRANSPORTATION SAFETY BOARD
NTS	NOT TO SCALE
OC	ON CENTER
OD	OUTSIDE DIAMETER
OH	OVERHEAD
OHE	OVERHEAD ELECTRIC
P	POWER
PAOP	POTENTIONAL ALLOWABLE OPERATING PRESSURE
PCC	PORTLAND CEMENT CONCRETE
PE	POLYETHYLENE PIPE
PH	POT HOLE
PHMSA	PIPELINE & HAZARDOUS MATERIALS SAFETY ADMINISTRATION
PL	PROPERTY LINE
PIC	POTENTIAL IMPACT CIRCLE
PLS	PRESSURE LIMITING STATION
P.O.B	POINT OF BEGINNING
PP	POWER POLE
PROP	PROPOSED
PQF	PREQUALIFIED FITTING
PSIG	POUNDS PER SQUARE INCH (GAUGE)
PVC	POLYVINYL CHLORIDE
PUE	PUBLIC UTILITY EASEMENT
RC	REINFORCED CONCRETE
RCP	REINFORCED CONCRETE PIPE
ROW	RIGHT OF WAY
SCADA	SUPERVISORY CONTROL AND DATA ACQUISITION
SD	STORM DRAIN
SDMH	STORM DRAIN MANHOLE
SDR	STANDARD DIMENSION RATIO
SF	SQUARE FOOT
SHT	SHEET
SLSV	SERVICE LINE SHUT-OFF VALVE
SMYS	SPECIFIED MAXIMUM YIELD STRENGTH
SS	SANITARY SEWER
SST	STAINLESS STEEL
ST	STREET
STA	STATION
STL	STEEL
SWG	SOUTHWEST GAS
TDS	TEST DATA SHEET
TEL	TELEPHONE
TB	THRUST BLOCK
TOP	TOP OF PIPE
TP	TEST POINT
TS	TECHNICAL SERVICE NOTE
TRIMP	TRANSMISSION INTEGRITY MANAGAMENT PROGRAM
TYP	TYPICAL
U.E.	UTILITY EASEMENT
UGE	UNDERGROUND ELECTRIC
UOC	UNUSUAL OPERATING CONDITION
USD	UNIFORM STANDARD DRAWING
UGT	UNDERGROUND TELEPHONE
VCP	VITRIFIED CLAY PIPE
VERT	VERTICAL
VG	VALLEY GUTTER
VSP	VINTAGE STEEL PIPE
W	WATER
WMS	WORK MANAGEMENT SYSTEM
WR	WORK REQUEST
WT	WALL THICKNESS
WV	WATER VALVE
YD	YARD(S)

CATHODIC PROTECTION NOTES:

1. NO STEEL WITHIN PROJECT LIMITS. NO CP ACTION REQUIRED.

DESIGN PIPE SUMMARY

DESIGN QTY.	DESCRIPTION
2,513'	2" PE8100
2,037'	4" PE8100

ABANDON PIPE SUMMARY

ABANDON QTY.	DESCRIPTION
31'	4" PE8100
11'	2" PE8100

Know what's **below.** **Call** before you dig.

SOUTHWEST GAS CORPORATION

Southwest Gas Corporation Confidential and Proprietary Information

For Reference Only - Not Valid for Line Locating Purposes. No representation or warranty is made for the adequacy, accuracy or completeness of the information or depictions shown. **This information is protected from further disclosure under the federal Freedom of Information Act and the Protected Critical Infrastructure Information Act of 2002, and Nevada Revised Statutes § 239C.**

This document may not be copied, distributed, or shared to any other person or entity in any manner or form without prior written consent of Southwest Gas Corporation.

REVISIONS

NO.	DESCRIPTION	BY	DATE	APPVD.
1	DEVELOPER'S WET UTILITY ALIGNMENT CHANGED	JW	8/20/2019	

PERMIT INFORMATION	ISOLATION AREA	LOCATION	ATLAS OR TILE
CITY OF LAS VEGAS TAX CODE 02-0200	ISO_21_DIST_323	T205 R59E S33 M.D.M.	X561Y516

D_W_VALLEY

SYSTEM MAOP: 60
SYSTEM MOP: 55
SYSTEM MAOP:
SYSTEM MOP:

JOB TYPE

HP SERVICE ☐
DISTRIBUTION ☒
FEEDER ☐
TRANS. BY DEF ☐
TRANS > 20% ☐

WR NO. 3811882 (INST)

RELATED WR NO.S 3814077 (ABND)

ENGINEER/TECHNICIAN	JALANIA WRIGHT	PHONE:	(702)365-2188
ACCOUNT REP.	TONY VANCHIERI	PHONE:	(702)365-2038
PROJECT CONTACT	ARIC BONNER	PHONE:	(702)236-4671
SHEET NO. 3 OF 7	SCALE N.T.S.	DATE	08/20/2019
DWN. BY BC&F	CHKD. BY JW	APPVD. BY	BWJ

S BRISTLE VALE UNIT 2

TYPICAL SWPPP BMPs DETAILS

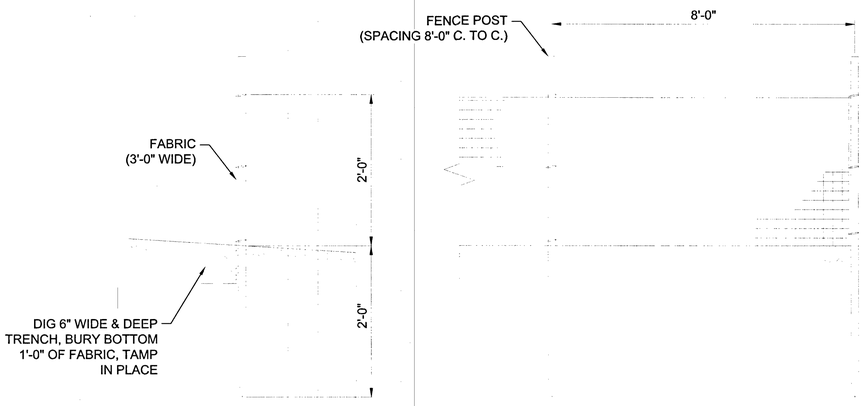

1/4 SILT FENCE
NOT TO SCALE

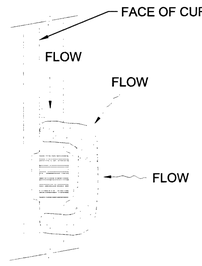

2/4 FIBER ROLL
NOT TO SCALE

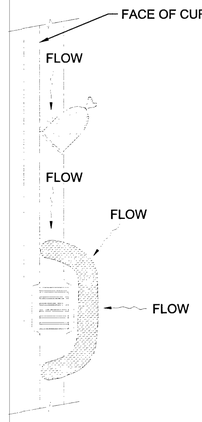

3/4 SAND BAG / ROLL
NOT TO SCALE

STORMWATER NOTES

1. SOUTHWEST GAS CORPORATION, IT'S CONTRACTOR, AND/OR THEIR AUTHORIZED AGENTS SHALL INSTALL ONE OF THE APPROPRIATE BMPs FOR THE PROTECTION OF EXISTING STORM DRAIN INLETS, WITHIN OR SIGNIFICANTLY NEAR ANY IMPROVED RIGHT-OF-WAY, FROM DEBRIS AND SEDIMENT RESULTING FROM CONSTRUCTION OF NATURAL GAS FACILITIES.
2. SOUTHWEST GAS CORPORATION, IT'S CONTRACTOR, AND/OR THEIR AUTHORIZED AGENTS SHALL EACH DAY REMOVE ALL SEDIMENT, MUD, CONSTRUCTION DEBRIS, OR OTHER POTENTIAL POLLUTANTS THAT MAY HAVE BEEN DISCHARGED TO, OR ACCUMULATED IN, THE PUBLIC RIGHTS OF WAY OF CLARK COUNTY AS A RESULT OF CONSTRUCTION ACTIVITIES ASSOCIATED WITH THIS SITE DEVELOPMENT OR CONSTRUCTION PROJECT. SUCH MATERIALS SHALL BE PREVENTED FROM ENTERING THE STORM SEWER SYSTEM, USING BEST MANAGEMENT PRACTICES DETAILED ON THIS SHEET.
3. ADDITIONAL CONSTRUCTION SITE DISCHARGE BEST MANAGEMENT PRACTICES MAY BE REQUIRED OF SOUTHWEST GAS CORPORATION, IT'S CONTRACTOR, AND/OR THEIR AUTHORIZED AGENTS DUE TO UNFORESEEN EROSION PROBLEMS OR IF THE LISTED BMPs ON THIS SHEET DO NOT MEET THE PERFORMANCE STANDARDS SPECIFIED IN THE CLARK COUNTY CODE - CHAPTER 24.40/STORM SEWER SYSTEM DISCHARGE AND THE LAS VEGAS VALLEY CONSTRUCTION SITE BMP GUIDANCE MANUAL.
4. ACCUMULATED SEDIMENT IN BMPs SHALL BE REMOVED WITHIN SEVEN DAYS AFTER A STORMWATER RUNOFF EVENT OR PRIOR TO THE NEXT ANTICIPATED STORM EVENT, WHICHEVER IS EARLIER. SEDIMENT MUST BE REMOVED WHEN BMP DESIGN CAPACITY HAS BEEN REDUCED BY 50 PERCENT OR MORE.

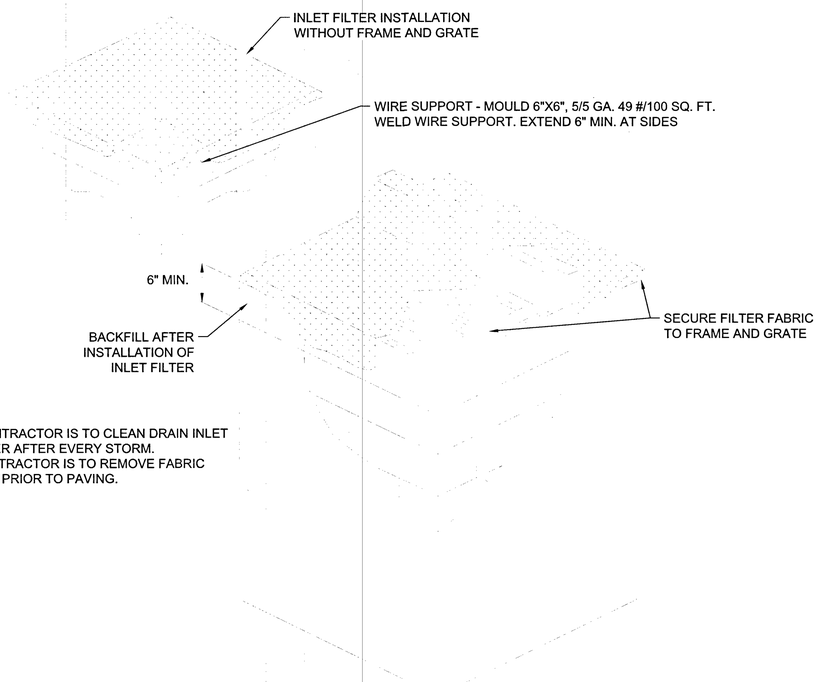

NOTE:
1. CONTRACTOR IS TO CLEAN DRAIN INLET FILTER AFTER EVERY STORM.
2. CONTRACTOR IS TO REMOVE FABRIC JUST PRIOR TO PAVING.

4/4 DRAIN INLET FILTER
NOT TO SCALE

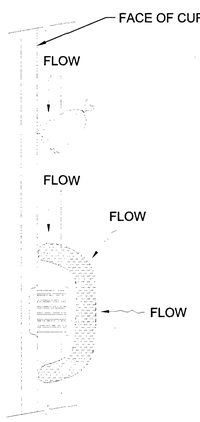

5/4 GRAVEL BAG / ROLL
NOT TO SCALE

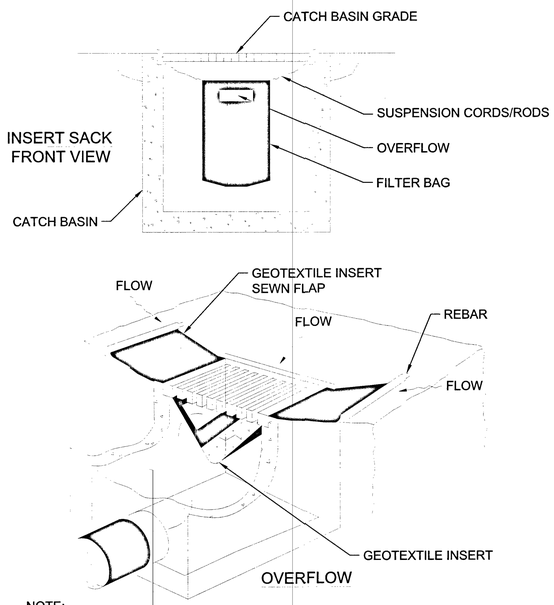

NOTE:
RECESSED CURB INLET MUST BE BLOCKED WHEN USING FILTER FABRIC INLET SACKS.
SIZE OF FILTER FABRIC INLET SACK TO BE DETERMINED BY MANUFACTURER.

6/4 SEDIMENT FILTER BAG
NOT TO SCALE

811 Know what's **below.** **Call** before you dig.

SOUTHWEST GAS CORPORATION

Southwest Gas Corporation Confidential and Proprietary Information

For Reference Only - Not Valid for Line Locating Purposes. No representation or warranty is made for the adequacy, accuracy or completeness of the information or depictions shown. **This information is protected from further disclosure under the federal Freedom of Information Act and the Protected Critical Infrastructure Information Act of 2002, and Nevada Revised Statutes § 239C.**

This document may not be copied, distributed, or shared to any other person or entity in any manner or form without prior written consent of Southwest Gas Corporation.

REVISIONS

NO.	DESCRIPTION	BY	DATE	APPVD.
1	DEVELOPER'S WET UTILITY ALIGNMENT CHANGED	JW	8/20/2019	

PERMIT INFORMATION	ISOLATION AREA	LOCATION	ATLAS OR TILE
CITY OF LAS VEGAS TAX CODE 02-0200	ISO_21_DIST_323	T205 R59E S33 M.D.M.	X561Y516

D_W_VALLEY	
SYSTEM MAOP:	60
SYSTEM MOP:	55
SYSTEM MAOP:	
SYSTEM MOP:	

JOB TYPE
HP SERVICE ☐
DISTRIBUTION ☒
FEEDER ☐
TRANS. BY DEF ☐
TRANS > 20% ☐

WR NO. 3811882 (INST)

RELATED WR NO.S 3814077 (ABND)

ENGINEER/TECHNICIAN	JALANIA WRIGHT	PHONE:	(702)365-2188
ACCOUNT REP.	TONY VANCHIERI	PHONE:	(702)365-2038
PROJECT CONTACT	ARIC BONNER	PHONE:	(702)236-4671
SHEET NO. 4 OF 7	SCALE N.T.S.	DATE	08/20/2019
DWN. BY BC&F	CHKD. BY JW	APPVD. BY	BWJ

S BRISTLE VALE UNIT 2

L19-00527
107Y5102-2

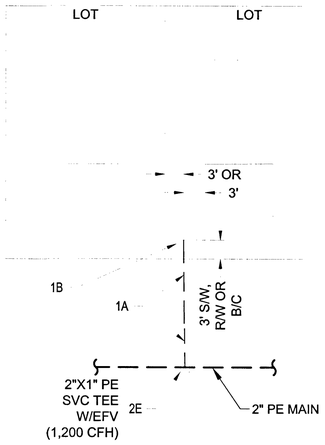

TYPICAL RESIDENTIAL SINGLE SERVICE LATERAL DETAIL

5A / -

N.T.S.

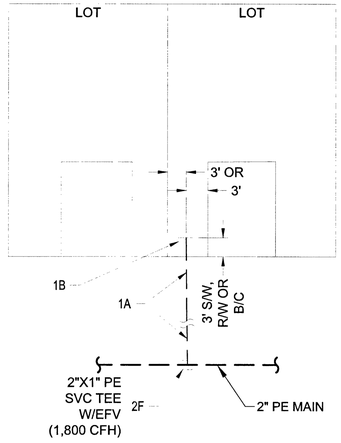

TYPICAL RESIDENTIAL BRANCH SERVICE LATERAL DETAIL

5B / -

N.T.S.

1 1/4" AND BELOW, DISTRIBUTION MATERIALS LIST						
CODE	DESIGN QTY.	AS-BUILT QTY.	STOCK ID	DESCRIPTION	SEAM	COATING
1A	2,037'	0'	101-8526	1" PE 8100 PIPE	N/A	N/A
1B	64	1 0	850-8773	CAP 1" LYCO	N/A	N/A

2" AND BELOW, DISTRIBUTION MATERIALS LIST						
CODE	DESIGN QTY.	AS-BUILT QTY.	STOCK ID	DESCRIPTION	SEAM	COATING
2E	34	0	160-8577	TEE TAP 2" W/1200EFV	N/A	N/A
2F	30	0	160-8394	TEE TAP 2" W/1800 EFV	N/A	N/A

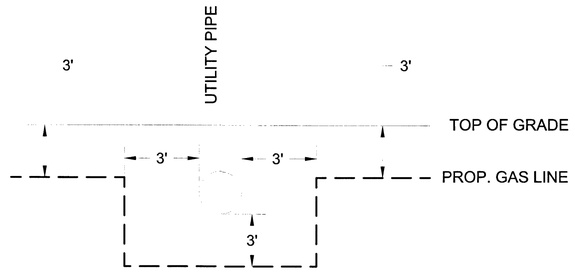

TYPICAL UTILITY CROSSING DETAIL

N.T.S.

Know what's **below.** **Call** before you dig.

SOUTHWEST GAS CORPORATION

Southwest Gas Corporation Confidential and Proprietary Information

For Reference Only - Not Valid for Line Locating Purposes. No representation or warranty is made for the adequacy, accuracy or completeness of the information or depictions shown. **This information is protected from further disclosure under the federal Freedom of Information Act and the Protected Critical Infrastructure Information Act of 2002, and Nevada Revised Statutes § 239C.**

This document may not be copied, distributed, or shared to any other person or entity in any manner or form without prior written consent of Southwest Gas Corporation.

REVISIONS			
NO.	DESCRIPTION	BY	DATE APPVD.
1	DEVELOPER'S WET UTILITY ALIGNMENT CHANGED	JW	8/20/2019

PERMIT INFORMATION	ISOLATION AREA	LOCATION	ATLAS OR TILE
CITY OF LAS VEGAS TAX CODE 02-0200	ISO_21_DIST_323	T205 R59E S33 M.D.M.	X561Y516

D_W_VALLEY

SYSTEM MAOP: 60

SYSTEM MOP: 55

SYSTEM MAOP:

SYSTEM MOP:

JOB TYPE

HP SERVICE ☐

DISTRIBUTION ☒

FEEDER ☐

TRANS. BY DEF ☐

TRANS > 20% ☐

WR NO.

3811882 (INST)

RELATED WR NO.S

3814077 (ABND)

ENGINEER/TECHNICIAN	JALANIA WRIGHT		PHONE: (702)365-2188
ACCOUNT REP.	TONY VANCHIERI		PHONE: (702)365-2038
PROJECT CONTACT	ARIC BONNER		PHONE: (702)236-4671
SHEET NO. 5 OF 7		SCALE N.T.S.	DATE 08/20/2019
DWN. BY BC&F		CHKD. BY JW	APPVD. BY BWJ

S BRISTLE VALE UNIT 2

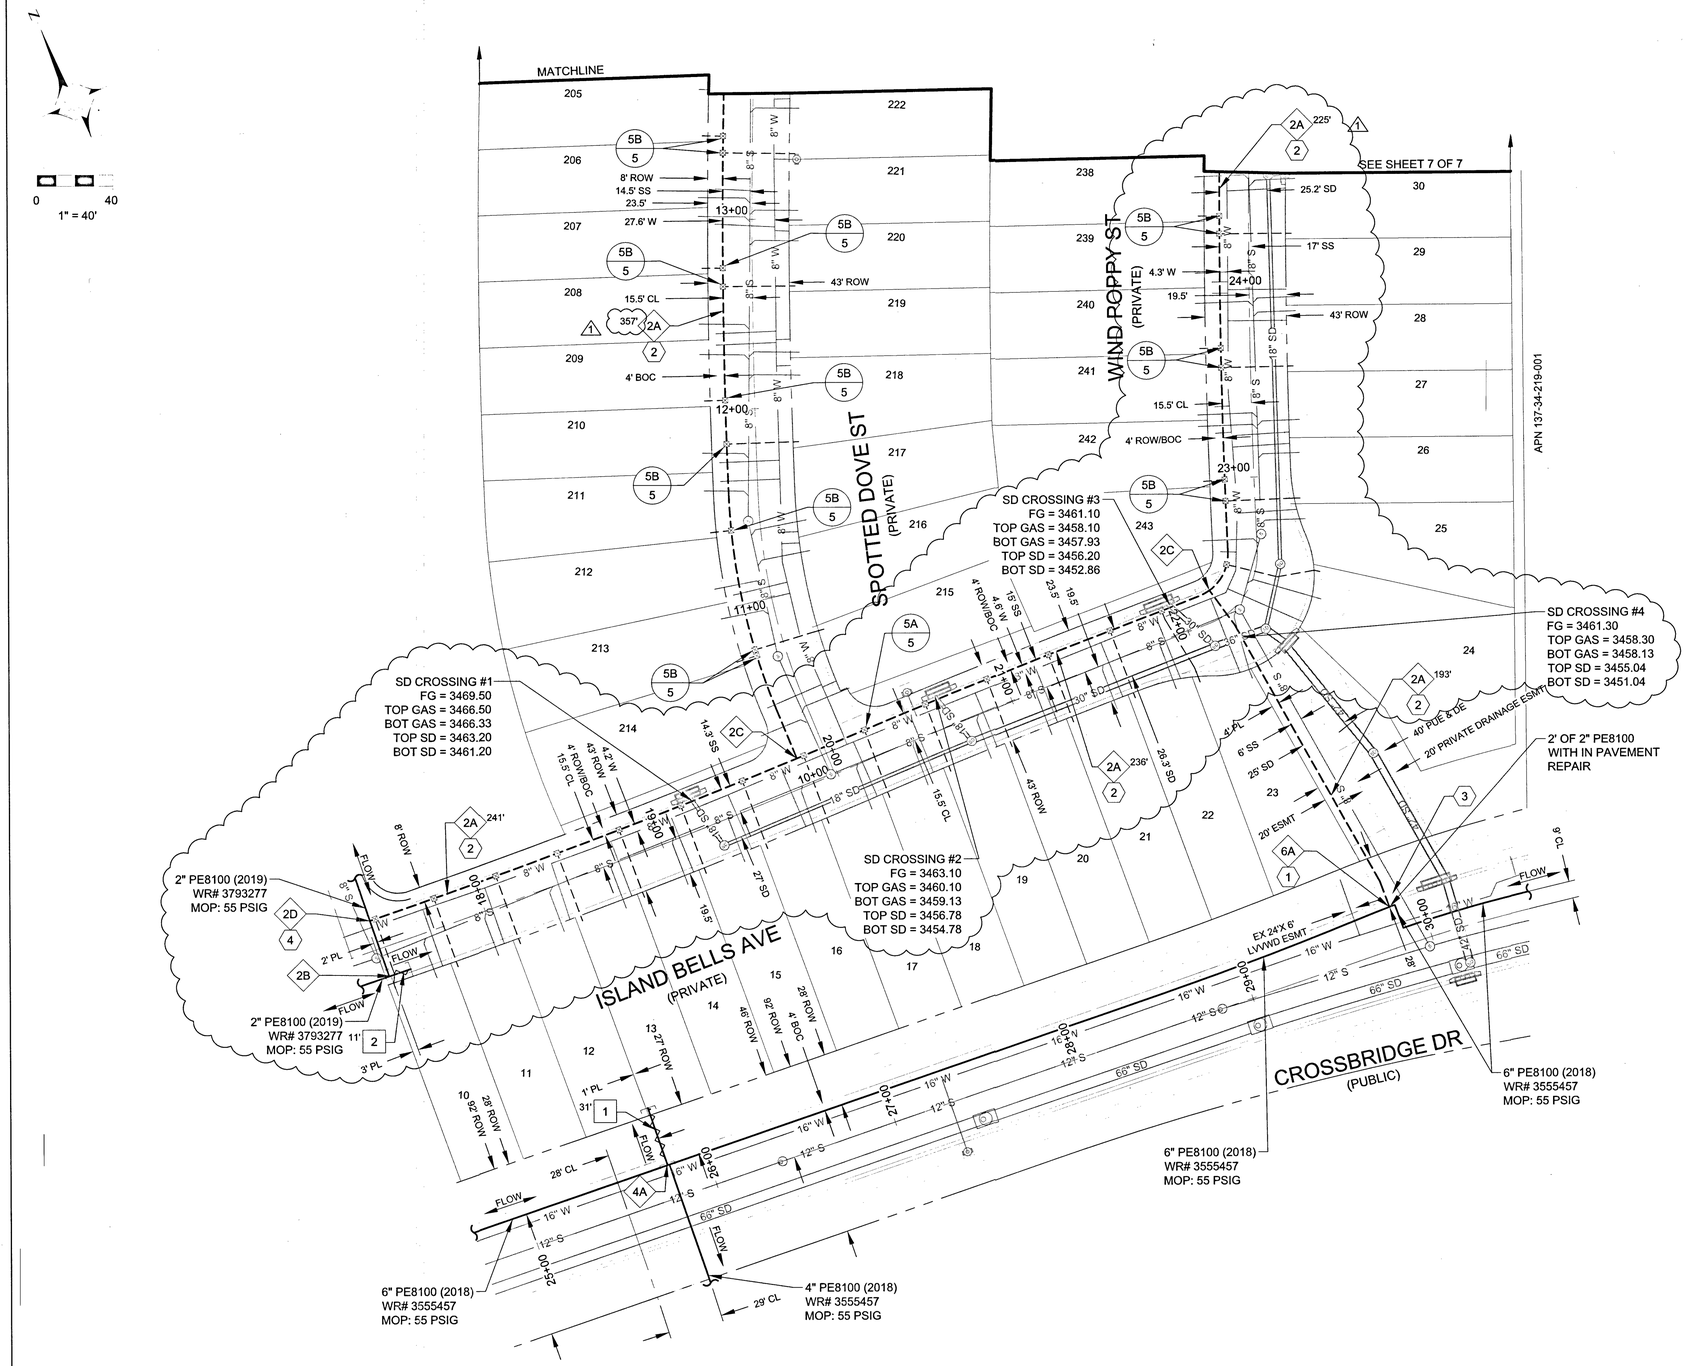

6" DISTRIBUTION MATERIALS LIST

CODE	DESIGN QTY.	AS-BUILT QTY.	STOCK ID	DESCRIPTION	SEAM	COATING
6A	1	0	160-8175	TEE TAPPING HIGH VOLUME 6"X2"	N/A	N/A

4" DISTRIBUTION MATERIALS LIST

CODE	DESIGN QTY.	AS-BUILT QTY.	STOCK ID	DESCRIPTION	SEAM	COATING
4A	1	0	140-3062	CAP, 4" PE PRFP	N/A	N/A

2" DISTRIBUTION MATERIALS LIST

CODE	DESIGN QTY.	AS-BUILT QTY.	STOCK ID	DESCRIPTION	SEAM	COATING
2A	1,252'	0'	100-5101	2" PE 8100 PIPE	N/A	N/A
2B	1	1 0	140-3060	CAP 2" PE FUSION	N/A	N/A
2C	2	0	140-3074	TEE 2" PE	N/A	N/A
2D	1	0	160-8171	TEE TAPPING HIGH VOLUME 2" X 2" PA12 CNTI	N/A	N/A

ABANDON FACILITIES WR# 3795988

CODE	DESIGN QTY.	AS-BUILT QTY.	DESCRIPTION	YEAR
1	31'	0'	4" PE8100, WR# 3555457, MOP: 55 PSIG	2018
2	11'	0'	2" PE8100, WR# 3793277, MOP: 55 PSIG	2019

CONSTRUCTION NOTES

1	TIE NEW 2" PE8100 TO EXISTING 6" PE8100
2	RTC 503
3	RTC 500.2
4	TIE NEW 2" PE8100 TO EXISTING 2" PE8100

Know what's **below.** **Call** before you dig.

SOUTHWEST GAS CORPORATION

Southwest Gas Corporation Confidential and Proprietary Information

For Reference Only - Not Valid for Line Locating Purposes. No representation or warranty is made for the adequacy, accuracy or completeness of the information or depictions shown. **This information is protected from further disclosure under the federal Freedom of Information Act and the Protected Critical Infrastructure Information Act of 2002, and Nevada Revised Statutes § 239C.**

This document may not be copied, distributed, or shared to any other person or entity in any manner or form without prior written consent of Southwest Gas Corporation.

REVISIONS

NO.	DESCRIPTION	BY	DATE	APPVD.
1	DEVELOPER'S WET UTILITY ALIGNMENT CHANGED	JW	8/20/2019	

PERMIT INFORMATION	ISOLATION AREA	LOCATION	ATLAS OR TILE
CITY OF LAS VEGAS TAX CODE 02-0200	ISO_21_DIST_323	T205 R59E S33 M.D.M.	X561Y516

D_W_VALLEY

SYSTEM MAOP: 60

SYSTEM MOP: 55

SYSTEM MAOP:

SYSTEM MOP:

JOB TYPE

HP SERVICE ☐

DISTRIBUTION ☒

FEEDER ☐

TRANS. BY DEF ☐

TRANS > 20% ☐

WR NO.

3811882 (INST)

RELATED WR NO.S

3814077 (ABND)

ENGINEER/TECHNICIAN	JALANIA WRIGHT	PHONE:	(702)365-2188
ACCOUNT REP.	TONY VANCHIERI	PHONE:	(702)365-2038
PROJECT CONTACT	ARIC BONNER	PHONE:	(702)236-4671
SHEET NO. 6 OF 7	SCALE 1" = 40'	DATE	08/20/2019
DWN. BY BC&F	CHKD. BY JW	APPVD. BY	BWJ

S BRISTLE VALE UNIT 2

N

0 40
1" = 40'

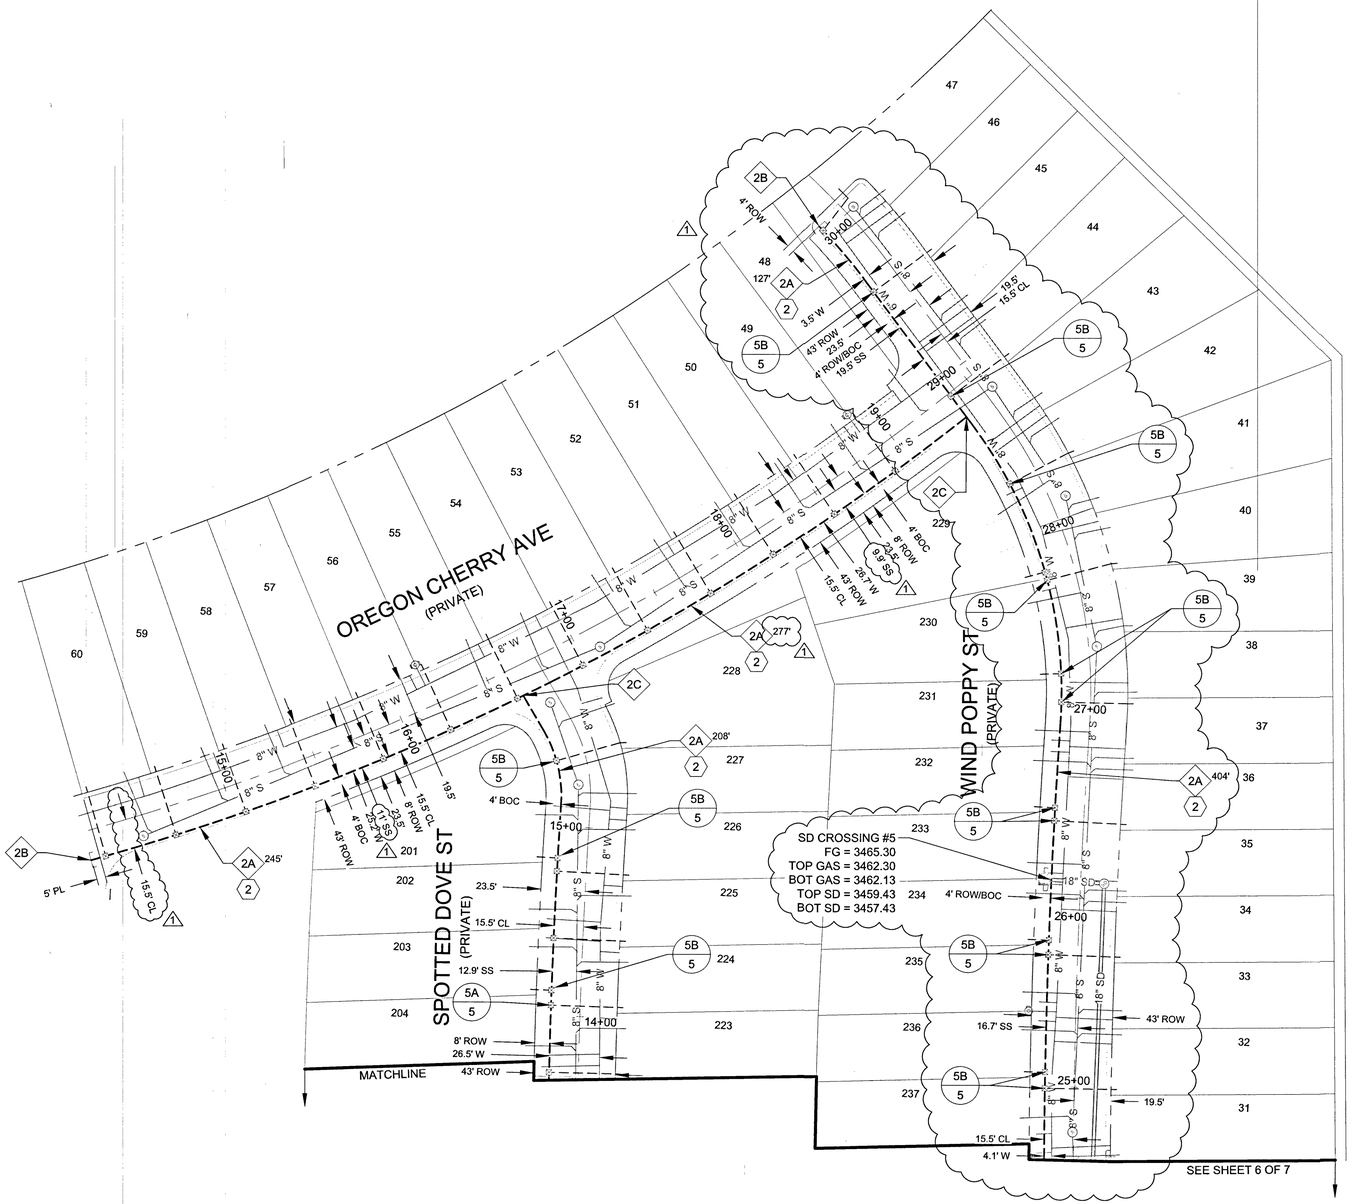

2" DISTRIBUTION MATERIALS LIST

CODE	DESIGN QTY.	AS-BUILT QTY.	STOCK ID	DESCRIPTION	SEAM	COATING
2A	1,261'	0'	100-5101	2" PE 8100 PIPE	N/A	N/A
2B	2	0	140-3060	CAP 2" PE FUSION	N/A	N/A
2C	2	0	140-3074	TEE 2" PE	N/A	N/A

CONSTRUCTION NOTES

2	RTC 503

Know what's **below.** **Call** before you dig.

SOUTHWEST GAS CORPORATION

Southwest Gas Corporation Confidential and Proprietary Information

For Reference Only - Not Valid for Line Locating Purposes. No representation or warranty is made for the adequacy, accuracy or completeness of the information or depictions shown. **This information is protected from further disclosure under the federal Freedom of Information Act and the Protected Critical Infrastructure Information Act of 2002, and Nevada Revised Statutes § 239C.**

This document may not be copied, distributed, or shared to any other person or entity in any manner or form without prior written consent of Southwest Gas Corporation.

REVISIONS

NO.	DESCRIPTION	BY	DATE	APPVD.
1	DEVELOPER'S WET UTILITY ALIGNMENT CHANGED	JW	8/20/2019	

PERMIT INFORMATION	ISOLATION AREA	LOCATION	ATLAS OR TILE
CITY OF LAS VEGAS TAX CODE 02-0200	ISO_21_DIST_323	T205 R59E S33 M.D.M.	X561Y516

D_W_VALLEY	
SYSTEM MAOP:	60
SYSTEM MOP:	55
SYSTEM MAOP:	
SYSTEM MOP:	

JOB TYPE

HP SERVICE	☐
DISTRIBUTION	☒
FEEDER	☐
TRANS. BY DEF	☐
TRANS > 20%	☐

WR NO. 3811882 (INST)

RELATED WR NO.S 3814077 (ABND)

ENGINEER/TECHNICIAN	JALANIA WRIGHT	PHONE:	(702)365-2188
ACCOUNT REP.	TONY VANCHIERI	PHONE:	(702)365-2038
PROJECT CONTACT	ARIC BONNER	PHONE:	(702)236-4671
SHEET NO. 7 OF 7	SCALE 1" = 40'	DATE	08/20/2019
DWN. BY BC&F	CHKD. BY JW	APPVD. BY	BWJ

S BRISTLE VALE UNIT 2

L19-00527
107Y5102-2

CONDUIT SEALING REQUIREMENT:

CONDUIT SEALING PER NESC AND OR NEC LATEST VERSION:
ALL ELECTRIC CONDUITS ENTERING BUILDING THROUGH OR PENETRATING CONCRETE SLAB SHALL BE SEALED AT BOTH ENDS WITH EXPANDING PLUG(S) AFTER CONDUIT IS MANDRILLED.
NVE WILL INSTALL A PERMANENT SEAL, AFTER CONDUCTORS ARE INSTALLED.

CONSTRUCTION OF THIS JOB IS CONTINGENT UPON THE COMPLETION OF WR#3003472877

SOURCE	PROJECT CONNECTED LOAD (3ø)				LOOP
FC OR RISER	PH.	EX: KVA	ADDED KVA	TOTAL KVA	FC OR RISER
DFC5517	A	725	300	1025	DFC8424
UGM91757	B	550	350	900	UGM95488
BLT1218	C	700	175	875	BLT1218

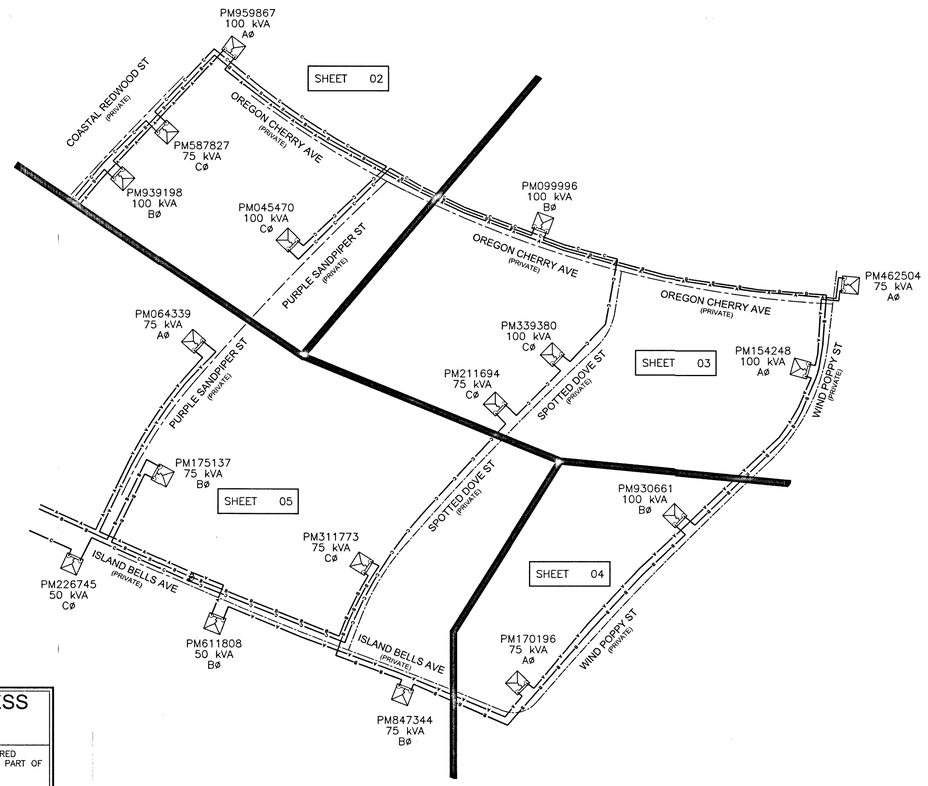

SINGLE LINE DIAGRAM

–NVE USE ONLY–

METER LOCATION & ACCESS REQUIREMENTS

(NV ENERGY STANDARDS RPI–2 & RPI–G)

MIN. 3'X3' CLEAR, LEVEL SPACE (SAFE WORK SPACE) REQUIRED DIRECTLY IN FRONT OF METER. THIS SPACE SHALL NOT BE PART OF A DRIVEWAY OR SUBJECT TO VEHICULAR TRAFFIC.

SERVICE POINT TO BE NO GREATER THAN 100' FROM BACK OF CURB OR PUBLIC EASEMENT (NO GREATER THAN 25' FROM SIDE STREET OR ALLEY).

A SERVICE PEDESTAL MUST BE 5' MIN. FROM BACK OF CURB, 6' MIN FROM DRIVEWAY OR OTHER TRAFFIC AREA.

BOTH SERVICE POINT AND SAFE WORK SPACE TO BE DIRECTLY VISIBLE FROM BACK OF CURB OR PUBLIC EASEMENT, AND MUST BE READILY ACCESSIBLE TO NV ENERGY AT ALL TIMES WITHOUT REQUIRING PASSAGE THROUGH RESTRICTED AREAS OR REQUIRING CUSTOMER CONTACT. FENCES, GATES, WALLS, OR OTHER OBSTRUCTIONS IN FRONT OF THE SERVICE POINT ARE PROHIBITED.

VISIBILITY, ACCESSIBILITY, AND SAFE WORK SPACE MUST BE MAINTAINED FOR THE ENTIRE LIFE OF THE SERVICE.

RTC NOTES:

BACKFILL AND RIGHT OF WAY RESTORATION SHALL CONFORM TO CLARK COUNTY UNIFORM STANDARD DRAWINGS

(1)	500.1	0 TO 5 YEARS PAVEMENT RESTORATION LONGITUDINAL CUT
(2)	500.2	0 TO 5 YEARS PAVEMENT RESTORATION TRANSVERSE CUT
(3)	500.3	OVER 5 YEARS PAVEMENT RESTORATION LONGITUDINAL CUT. GREATER THAN 60' R.O.W
(4)	500.4	OVER 5 YRS PAVEMENT RESTORATION LONGITUDINAL CUT. 60' R.O.W OR LESS
(5)	500.5	OVER 5 YRS PAVEMENT RESTORATION TRANSVERSE ALL R.O.W WIDTHS
(6)	501	TYPICAL UNDERGROUND UTILITY LOCATIONS IN RESIDENTIAL STREETS 60' OR LESS R.O.W.
(7)	501.1	TYPICAL UTILITY UNDERGROUND LOCATIONS IN STREETS WITH GREATER THAN 60' R.O.W.
(8)	503	METHOD B FOR RIGID AND FLEXIBLE PIPE TRENCH BACKFILL – PAVED AREAS
(9)	503.1	METHOD A FOR FLEXIBLE PIPE TRENCH BACKFILL – PAVED AREAS
(1)	BACKFILL	IN UNPAVED AREA AS REQUIRED BY LOCAL CODE OR AS APPROVED BY AGENCY.
(12)	234	SIDEWALK
(13)	506	UTILITY POTHOLE REPAIR
(14)	216	"L" TYPE CURB AND GUTTER

NV ENERGY SCHEDULING NOTE: DAY (NO LANE BLOCKS)

THIS PROJECT WAS ESTIMATED WITH THE ASSUMPTION THAT ALL THE WORK BEING PERFORMED ON THIS PROJECT BY NV ENERGY CREWS CAN BE DONE DURING THE DAYTIME WITH NO TRAFFIC CONTROL REQUIRED.

GOVERNMENT APPROVAL OF THESE DRAWINGS DOES NOT INDICATE APPROVAL OF TRAFFIC CONTROL. PLEASE REFER TO THE BARRICADE PLAN FOR APPROVED TRAFFIC CONTROL REQUIREMENTS.

CONSTRUCTION / INSPECTION REQUIREMENTS

WORK MUST CONFORM TO NVE ELECTRIC SERVICE STANDARDS, AVAILABLE AT: www.nvenergy.com/business/newconstruction/newconstructionS/servicestandards.cfm

NVE INSPECTOR MUST BE PRESENT TO INSPECT TRENCHING (SCHEDULE AT LEAST 72 HOURS IN ADVANCE) AT EACH OF THE FOLLOWING STAGES:
1. BOTTOM SAND AND CONDUIT INSTALLED
2. TOP SAND INSTALLED
3. BACKFILL INSTALLED

CONDUIT MUST BE MANDRILLED PRIOR TO RELEASE (COORDINATE WITH INSPECTOR).

NVE STAND BY CREW IS REQUIRED WHEN WORKING AT AN ENERGIZED VAULT OR TRANSFORMER. CALL STAND BY NUMBER (SEE TITLE BLOCK) TO SCHEDULE.

NVE ELECTRICAL INSTALLATION WILL NOT BE SCHEDULED UNTIL AFTER THE NVE INSPECTOR HAS COMPLETED THE OFFICIAL RELEASE.

METER(S) WILL NOT BE SET UNTIL ALL OF THE FOLLOWING ARE COMPLETE:
- [INSTRUMENT–RATED ONLY] METERING EQUIPMENT HAS BEEN SUBMITTED TO NVE METERING ENGINEER AND APPROVED. (submittals_southern@nvenergy.com)
- APPLICATION FOR METER SET HAS BEEN SUBMITTED TO NVE'S NEW DEVELOPMENT CENTER. FORM AVAILABLE AT: www.nvenergy.com/brochures_arch/new_construction/meter_set.pdf
- THE LOCAL BUILDING AUTHORITY HAS INSPECTED AND APPROVED THE METERING EQUIPMENT.
- METERING EQUIPMENT IS ACCESSIBLE AND CLEARLY IDENTIFIED WITH PERMANENT MARKINGS. ADDRESSES, SUITE NUMBERS, AND STREET SIGNS ARE POSTED IN PERMANENT LOCATIONS (SEE RPI–G).

TRACK PROJECT STATUS ONLINE WITH NVE'S DEVELOPER DASHBOARD: www.nvenergy.com/business/newconstruction/newconstructionS/developerdashboard.cfm

UNLESS OTHERWISE NOTED:

ALL SERVICE CONDUCTOR: 2/0 AL. TRI.
ALL TRANSFORMERS: 7200V–120/240V–1ø PM
LARGEST A/C UNIT SIZE: 5 TONS
NUMBER OF UNITS: 94
MAIN SIZE: 200 AMPS
ESTIMATED KVA PER UNIT: 8 KVA
SQ. FT. OF LARGEST UNIT: 2,466 FT²

CIVIL LINETYPE LEGEND

CENTERLINE
PROPERTY LINE/ROW
CURB
EDGE OF PAVEMENT
EDGE OF SIDEWALK
SEWER LINE (S)
WATER LINE (W)
COHW WATER LINE (COHW)
LVJWD WATER LINE (LVJWD)
SNWA WATER LINE (SNWA)
GAS LINE (GAS)
TELEPHONE LINE (TEL)
CABLE TV LINE (CATV)
CABLE TV LINE (FIBER)
STORM DRAIN LINE (SD)
FIRE HYDRANT
SERVICE INDICATOR (SI)
SIGNAL LIGHT
STREET LIGHT

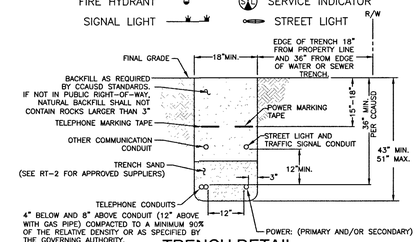

TRENCH DETAIL

NVE U.G. STD. RT–12 (REV. 10/27/2014)
(RESIDENTIAL AND COMMERCIAL)

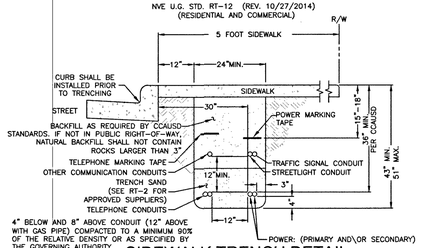

SIDEWALK TRENCH DETAIL

NVE U.G. STD. RT–7 (REV. 10/27/2014)
(RESIDENTIAL OR COMMERCIAL)

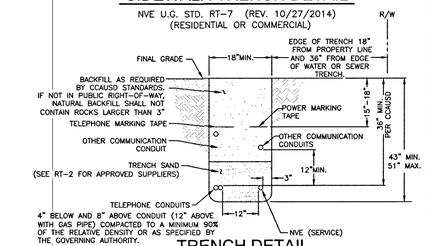

TRENCH DETAIL

NVE U.G. STD. RT–8 (REV. 10/27/2014)
(RESIDENTIAL SERVICE)

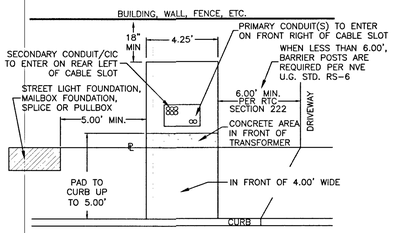

SINGLE-PHASE TRANSFORMER LOCATION DETAIL

NVE U.G. STD. RS–5 & RS–13 (RESIDENTIAL) & RS–19 (COMMERCIAL)

NVE STANDARDS

N

T,R,S: 20–59–33

APN: 137–33–610–002
137–33–610–003

GENERAL NOTES:

ANY NOTES LOCATED IN DRAWING AREA TAKE PRECEDENCE OVER STANDARD NOTES.

REFER TO A CURRENT NVEnergy ELECTRIC SERVICE REQUIREMENTS HANDBOOK FOR FURTHER CLARIFICATION OF NVEnergy STANDARDS.

THE APPLICANT SHALL INFORM THE INSPECTOR AT LEAST 48 HOURS BEFORE COMMENCING ANY ITEM OF CONSTRUCTION OR INSTALLATION OF MATERIAL TO ENABLE PROPER INSPECTION OF MATERIALS AND WORKMANSHIP. MAIN TRENCH WIRE PULLS TO BE SCHEDULED 72 HOURS IN ADVANCE OF INSTALLATION. APPLICANT'S PROJECT WILL NOT BE SCHEDULED UNTIL FINAL APPROVAL FROM NVEnergy UNDERGROUND & ELECTRICAL INSPECTORS.

ALL WORK SHALL BE ACCOMPLISHED IN STRICT ACCORDANCE WITH THE SPECIFICATIONS SET FORTH IN THE ELECTRIC SERVICE REQUIREMENTS HANDBOOK, AS CURRENTLY ADOPTED BY NVEnergy. THE CONTRACTOR SHALL SECURE COPIES OF THE AFOREMENTIONED CONSTRUCTION SPECIFICATIONS ON HIS OR HER OWN BEHALF.

SYMBOLS ARE NOT TO SCALE AND DO NOT NECESSARILY REPRESENT ACTUAL LOCATIONS OF FACILITIES.

THIS DRAWING ILLUSTRATES DATA COLLECTED FROM VARIOUS SOURCES AND MAY NOT REPRESENT A SURVEY OF THE PREMISES.

APPLICANT SHALL FIELD DETERMINE POSITION AND DEPTH OF EXISTING UTILITY EQUIPMENT PRIOR TO COMMENCING CONSTRUCTION.

USE CAUTION PRIOR TO EXCAVATION. CHECK TO ENSURE ADDITIONAL DEPTH IS NOT REQUIRED TO ACCOMMODATE GAS AND/OR WATER FACILITIES AND DRAINAGE CHANNELS.

CALL NVEnergy UNDERGROUND INSPECTORS 48 HOURS PRIOR TO START OF CONSTRUCTION FOR TRENCH INSPECTION BEFORE COVERING TRENCH.

ALL NVEnergy CABLE TO BE INSTALLED BEHIND CURB, UNLESS OTHERWISE STATED.

APPLICANT IS RESPONSIBLE FOR STAKING OF PROPERTY CORNERS & ELEVATIONS.

ALL HANDHOLES AND PULLBOXES SHALL BE INSTALLED TO FINISHED GRADE OR 6" ABOVE IF GRADE IS NOT ESTABLISHED.

ANY SUBSTRUCTURE VAULT INSTALLED IN GRAVEL, GRASS, OR BARE GROUND WILL REQUIRE A CONCRETED 8" WIDE AND 6" DEEP COLLAR AROUND BOX IN ACCORDANCE TO RS–G6.

2" PLASTIC CONDUIT BENDS (90', 45') WITH 36" MIN. RADIUS. (USE FIBERGLASS IF CONDUIT LENGTH IS OVER 500')

3" & 4" PLASTIC CONDUIT BENDS (90', 45') WITH 36" MIN. RADIUS.
(USE RGS IF CONDUIT LENGTH IS OVER 100')

6" PLASTIC CONDUIT BENDS (90', 45') WITH 48" MIN. RADIUS.
(USE RGS IF CONDUIT LENGTH IS OVER 100')

WHEN INSTALLING CONDUIT IN FIELD, USE APPROPRIATE BENDS TO COMPLETE THE INSTALLATION.

DEFLECTION OF CONDUIT BENDS AND CONDUIT NOT TO EXCEED NVEnergy STANDARDS.

EXISTING STUB–OUT/CONDUIT INSTALLED BY PREVIOUS CONTRACTOR / DEVELOPER. NVEnergy DOES NOT GUARANTEE LOCATION, LENGTH, OR ACCESSIBILITY OF EXISTING STUB–OUT/CONDUIT. IF UTILIZING ANY PORTION OF EXISTING CONDUIT, IT MUST BE MANDRELED PRIOR TO FINAL RELEASE.

PREVIOUSLY MANDRELED CONDUIT WHICH HAS BEEN IN THE GROUND FOR OVER 6 MONTHS MUST BE RE–MANDRILLED PRIOR TO FINAL RELEASE.

WHEN NVEnergy FACILITIES ARE TO BE REMOVED, NVEnergy WILL REMOVE ALL WIRES AND EQUIPMENT. NVEnergy IS NOT RESPONSIBLE FOR THE REMOVAL OF CONDUIT RUNS OR SUBSTRUCTURES FROM THE PROPERTY.

NO COVERED PARKING IN FRONT OF EQUIPMENT.

ALL CONSTRUCTION AND MATERIALS SHALL BE IN ACCORDANCE WITH THE "UNIFORM STANDARD SPECIFICATIONS FOR PUBLIC WORKS CONSTRUCTION OFF–SITE IMPROVEMENTS, CLARK COUNTY AREA NEVADA", LATEST ISSUE; THE "UNIFORM STANDARD DRAWINGS FOR PUBLIC WORKS CONSTRUCTION, CLARK COUNTY AREA NEVADA", LATEST ISSUE; AND OTHER APPLICABLE APPROVED STANDARDS ISSUED BY THE CONTROLLING AGENCY; ALL LOCAL CITY CODES AND ORDINANCES APPLICABLE.

NVE WILL NOT VERIFY THE EXISTING CONDUIT. CUSTOMER TO ENSURE ITS INTEGRITY AND REPAIR IF NECESSARY.

CUSTOMER NOTE:

UNLESS OTHERWISE NOTED, ALL CONDUIT, BENDS AND SUBSTRUCTURES ARE THE RESPONSIBILITY OF THE CUSTOMERS CONTRACTOR, OR ASSIGNED DCA CONTRACTOR (RESIDENTIAL ONLY)

FIRE HYDRANT CLEARANCE:

6' RADIUS FROM CENTER OF HYDRANT TO ALL ABOVE GROUND PADS AND/OR EQUIPMENT AND ALL MANHOLES AND SWITCHBOXES.
6' RADIUS FROM CENTER OF HYDRANT TO ALL UNDERGROUND HANDHOLES, PULLBOXES AND SPLICEBOXES. ALL PER NVEnergy STD. RS–5

NOTE: ALL THE ABOVE GROUND UTILITY APPURTENANCES SHALL CONFORM TO THE REQUIREMENTS OF CLV UNIFIED DEVELOPMENT CODE TITLE 19.06 AND 19.08

APPROVED FOR CONSTRUCTION

THIS APPROVAL IS FOR WORK IN CLV R/W & EASEMENT ONLY. OBTAINING PERMISSIONS OR EASEMENTS FOR WORK SHOWN ON PRIVATE PROPERTY IS THE RESPONSIBILITY OF THE UTILITY.

SEE Cover of Civil Plan

APPROVAL BY: DATE

NVEnergy REQUIRES 24 HOUR ACCESS TO EQUIPMENT

CITY OF LAS VEGAS PERMIT REQUIRED*

CONTACT CLV LAND DEVELOPMENT (229–6371) CLV CONSTRUCTION SERVICES MUST BE NOTIFIED 24 HOURS PRIOR TO COMMENCING CONSTRUCTION (229–6337)

HANSEN_____

DATE_____

*NVE INSPECTOR MUST BE NOTIFIED BY FAX 48 HOURS PRIOR TO COMMENCING CONSTRUCTION & WILL VERIFY CITY PERMIT FOR WORK DONE IN STREETS OR SIDEWALK.
FAX PERMIT TO:
LAS VEGAS NORTH (RYAN CENTER): 402–4354
LAS VEGAS SOUTH (BELTWAY CENTER): 402–6864

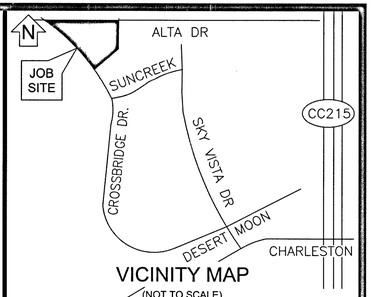

VICINITY MAP

(NOT TO SCALE)

EVERY EFFORT HAS BEEN MADE TO IDENTIFY ALL NVE FACILITIES. THE CUSTOMER SHALL CONFIRM THE EXISTENCE AND LOCATION OF THESE FACILITIES.

AVOID HITTING OVERHEAD POWER LINES. IT'S COSTLY.

CALL 1-702-402-2929

Call before you Dig
Avoid cutting underground utility lines. It's costly.
CALL 811
OR
1-800-227-2600
AND CLARK COUNTY TRAFFIC OPERATIONS
1-702-455-6000

REVISIONS

NO.	DESCRIPTION	DATE	REV BY
1	SERVICE FLOP LOT 25 PER CUSTOMER REQUEST PAGE 4 OF 5.	9/11/2019	

STANDARD DCA

PROJECT PURPOSE:

SERVE RESIDENTIAL SUBDIVISION WITHIN THE MASTER PLAN COMMUNITY OF 3000725849–SUMMERLIN V24
(94) HOMES, 200A 120/240V PANELS
(1) IRRIGATION SVC, 125A 120/240V PEDESTAL
(2) STREETLIGHT SVC 200A 120/240V PEDESTAL

EXHIBIT 'A'

NVEnergy INFORMATION:
COORDINATOR: MONTOYA, LUIS
PHONE: (702)217–8222 D.F. LOWELL, KEN
DESIGNER: MOHAMED, CHRISTOPHER
DCA: 285–8182, 219–5761
INSPECTOR: 702–402–3008 OR UGI@NVENERGY.COM
STAND BY: (702) 402–4450, 4150, 4114, 4117, 4118
DISTRICT: LAS VEGAS NORTH DISTRICT

JPA INFORMATION:
JPA ADMIN PHONE: N/A JPA#: N/A

CUSTOMER INFORMATION:
APPLICANT: KB HOME LAS VEGAS INC.
ENGINEER: SHG
CONTACT: BONNER, ARIC ** 702–266–8556
APPROVAL DATE: 7/25/2019

GOVERNMENT INFORMATION:
AGENCY: CLV
APPROVAL DATE: ---- /

FOR EACH SERVICE POINT (POINT OF DELIVERY), ENERGY FOR EACH TENANT SPACE WILL BE MEASURED THROUGH ONE WATTHOUR METER. ENERGY FOR ALL NON-TENANT SPACE WILL BE MEASURED THROUGH ONE WATTHOUR METER. CONTACT NVE METER OPERATIONS FOR MULTIPLE RATE CLASS INSTALLATIONS.

NVEnergy

BRISTLE VALE UNIT 2 - SUBDIVISION

CROSSBRIDGE AND SUNCREEK

PROJ #3003712795	SCALE: 1"=30'
SHEET # 1 OF 5	DATE: 5/28/2019

im21910

9/11/2019 5:22 PM

Sharing of this drawing and the information contained herein shall be only to individuals/parties who have entered into an agreement with Applicant for the completion of work associated with this specific project. Use for purposes other than this specific project requires the written consent of NV Energy.

1 REVISION(S)

LI9-00527
107S102-2

36

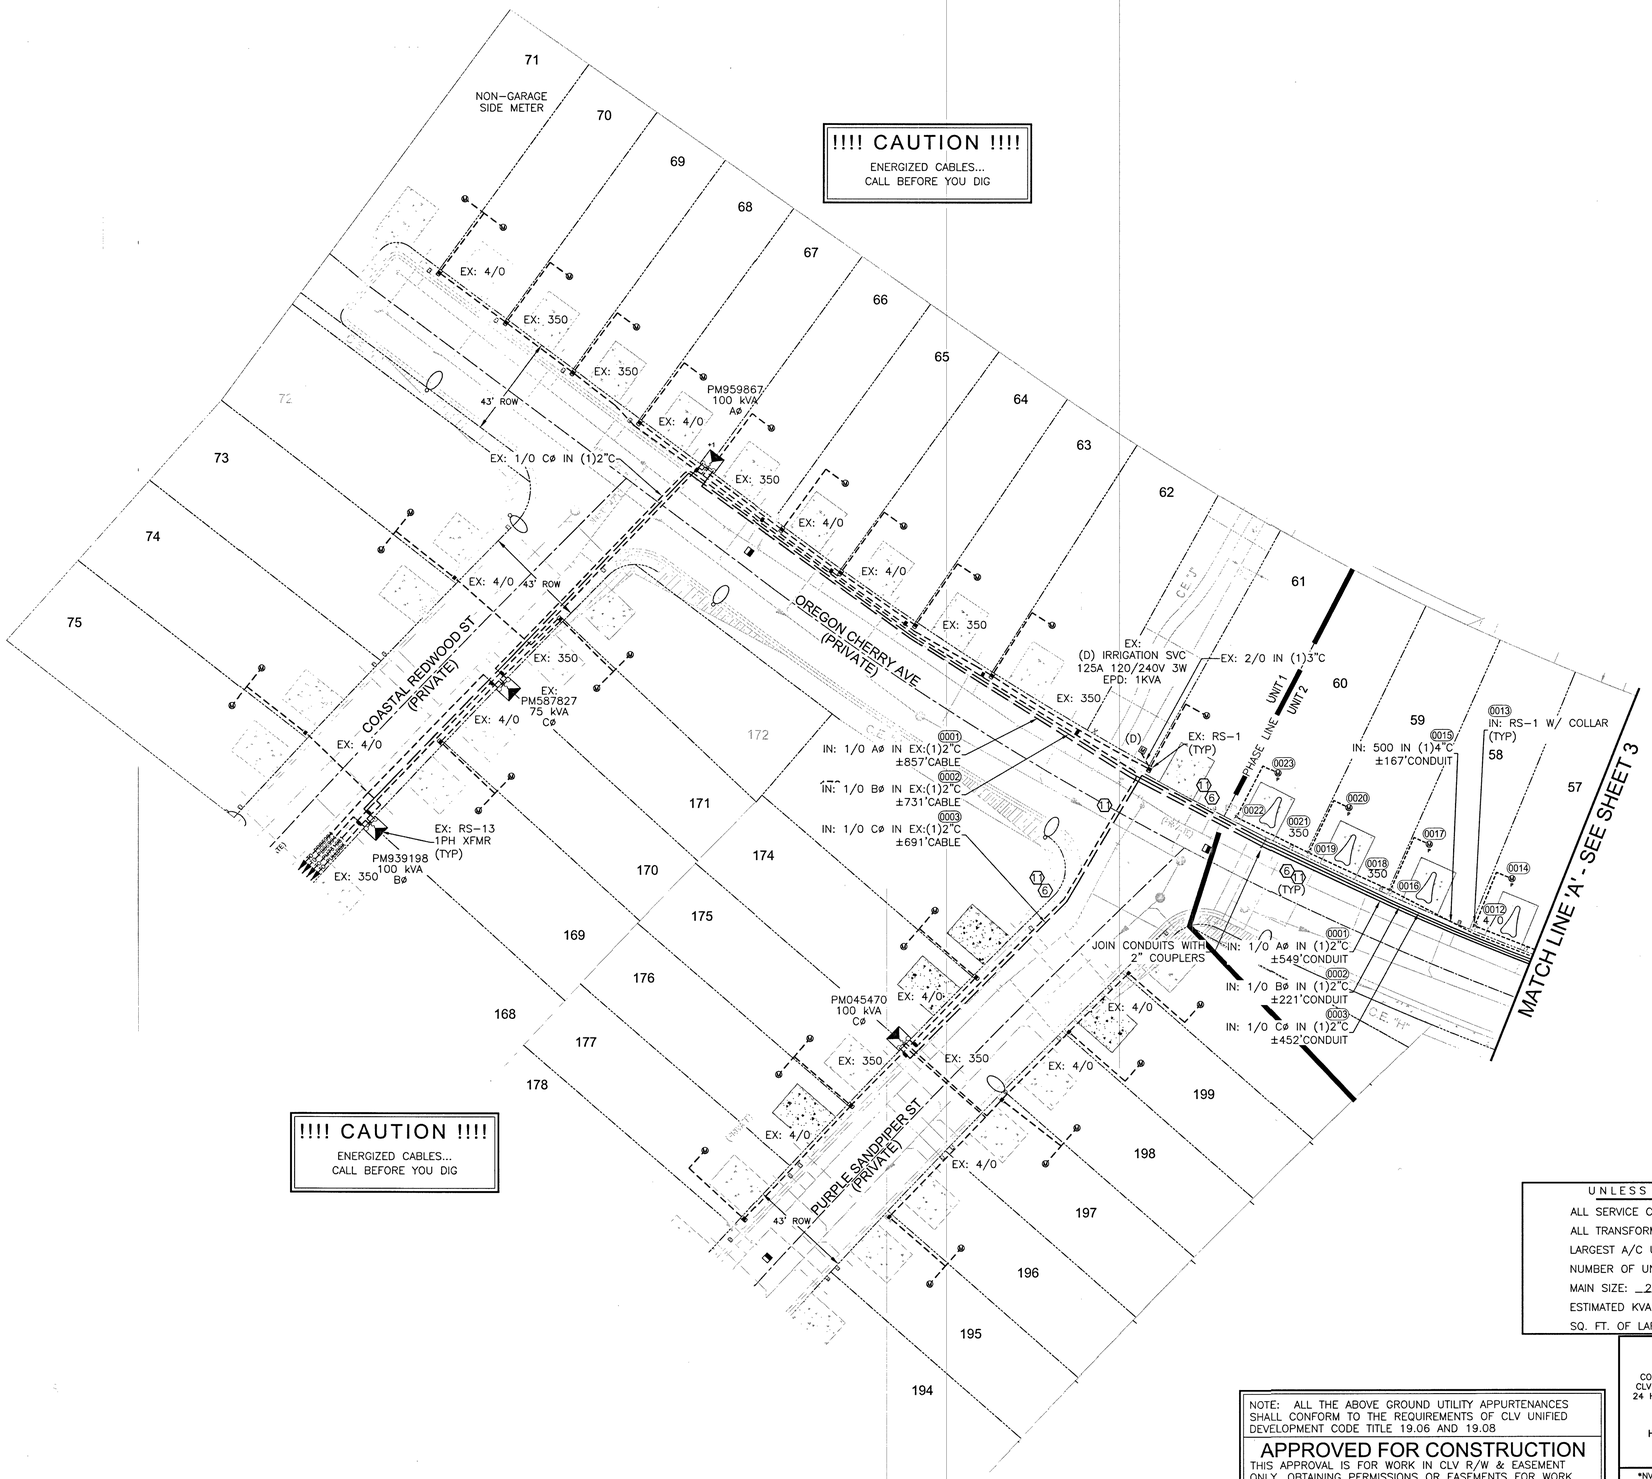

UNLESS OTHERWISE NOTED:

ALL SERVICE CONDUCTOR: 2/0 AL. TRI.
ALL TRANSFORMERS: 7200V-120/240V-1Ø PM
LARGEST A/C UNIT SIZE: 5 TONS
NUMBER OF UNITS: 94
MAIN SIZE: 200 AMPS
ESTIMATED KVA PER UNIT: 8 KVA
SQ. FT. OF LARGEST UNIT: 2,466 FT²

NOTE: ALL THE ABOVE GROUND UTILITY APPURTENANCES SHALL CONFORM TO THE REQUIREMENTS OF CLV UNIFIED DEVELOPMENT CODE TITLE 19.06 AND 19.08

APPROVED FOR CONSTRUCTION

THIS APPROVAL IS FOR WORK IN CLV R/W & EASEMENT ONLY. OBTAINING PERMISSIONS OR EASEMENTS FOR WORK SHOWN ON PRIVATE PROPERTY IS THE RESPONSIBILITY OF THE UTILITY.

SEE COVER OF CIVIL PLAN

APPROVAL BY: DATE

CITY OF LAS VEGAS
PERMIT REQUIRED*

CONTACT CLV LAND DEVELOPMENT (229-6371)
CLV CONSTRUCTION SERVICES MUST BE NOTIFIED 24 HOURS PRIOR TO COMMENCING CONSTRUCTION (229-6337)

HANSEN

DATE

*NVE INSPECTOR MUST BE NOTIFIED BY FAX 48 HOURS PRIOR TO COMMENCING CONSTRUCTION & WILL VERIFY CITY PERMIT FOR WORK DONE IN STREETS OR SIDEWALK.
FAX PERMIT TO:
LAS VEGAS NORTH (RYAN CENTER): 402-4354
LAS VEGAS SOUTH (BELTWAY CENTER): 402-6864

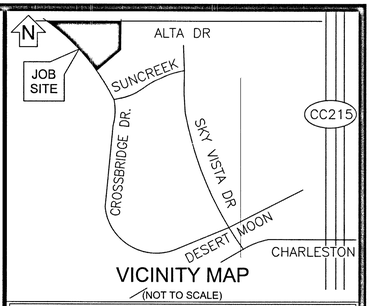

VICINITY MAP
(NOT TO SCALE)

EVERY EFFORT HAS BEEN MADE TO IDENTIFY ALL NVE FACILITIES. THE CUSTOMER SHALL CONFIRM THE EXISTENCE AND LOCATION OF THESE FACILITIES.

AVOID HITTING OVERHEAD POWER LINES. IT'S COSTLY.
CALL BEFORE YOU DO OVERHEAD
CALL 1-702-402-2929

Call before you Dig
Avoid cutting underground utility lines. It's costly.
CALL 811
OR
1-800-227-2600
AND CLARK COUNTY TRAFFIC OPERATIONS
1-702-455-6000

REVISIONS

NO.	DESCRIPTION	DATE	REV BY
1	SERVICE FLOP LOT 25 PER CUSTOMER REQUEST PAGE 4 OF 5.	9/11/2019	---

STANDARD DCA

PROJECT PURPOSE:

SERVE RESIDENTIAL SUBDIVISION WITHIN THE MASTER PLAN COMMUNITY OF 3000725849-SUMMERLIN V24
(94) HOMES, 200A 120/240V PANELS
(1) IRRIGATION SVC, 125A 120/240V PEDESTAL
(2) STREETLIGHT SVC 200A 120/240V PEDESTAL

EXHIBIT 'A'

NVEnergy INFORMATION:
COORDINATOR: MONTOYA, LUIS
PHONE: (702)217-8222 D.F. LOWELL, KEN
DESIGNER: MOHAMED, CHRISTOPHER
DCA: 285-8182, 219-5761
INSPECTOR: 702-402-3008 OR UGI@NVENERGY.COM
STAND BY: (702) 402-4450, 4150, 4114, 4117, 4118
DISTRICT: LAS VEGAS NORTH DISTRICT
JPA INFORMATION:
JPA ADMIN PHONE: N/A JPA#: N/A
CUSTOMER INFORMATION:
APPLICANT: KB HOME LAS VEGAS INC.
ENGINEER: SHG
CONTACT: BONNER, ARIC ** 702-266-8556
APPROVAL DATE: 7/25/2019
GOVERNMENT INFORMATION:
AGENCY: CLV !
APPROVAL DATE: ----- !

FOR EACH SERVICE POINT (POINT OF DELIVERY), ENERGY FOR EACH TENANT SPACE WILL BE MEASURED THROUGH ONE WATTHOUR METER. ENERGY FOR ALL NON-TENANT SPACE WILL BE MEASURED THROUGH ONE WATTHOUR METER. CONTACT NVE METER OPERATIONS FOR MULTIPLE RATE CLASS INSTALLATIONS.

NVEnergy

BRISTLE VALE UNIT 2 - SUBDIVISION

CROSSBRIDGE AND SUNCREEK

PROJ #3003712795	SCALE: 1"=30'
SHEET # 2 OF 5	DATE: 5/28/2019

lm21910
9/11/2019 5:22 PM

Sharing of this drawing and the information contained herein shall be only to individuals/parties who have entered into an agreement with Applicant for the completion of work associated with this specific project. Use for purposes other than this specific project requires the written consent of NV Energy.

1 REVISION(S)

L19-00527
107Y61D2-2
37

UNLESS OTHERWISE NOTED:

ALL SERVICE CONDUCTOR: 2/0 AL. TRI.
ALL TRANSFORMERS: 7200V-120/240V-1ø PM
LARGEST A/C UNIT SIZE: 5 TONS
NUMBER OF UNITS: 94
MAIN SIZE: 200 AMPS
ESTIMATED KVA PER UNIT: 8 KVA
SQ. FT. OF LARGEST UNIT: 2,466 FT²

NOTE: ALL THE ABOVE GROUND UTILITY APPURTENANCES SHALL CONFORM TO THE REQUIREMENTS OF CLV UNIFIED DEVELOPMENT CODE TITLE 19.06 AND 19.08

APPROVED FOR CONSTRUCTION
THIS APPROVAL IS FOR WORK IN CLV R/W & EASEMENT ONLY. OBTAINING PERMISSIONS OR EASEMENTS FOR WORK SHOWN ON PRIVATE PROPERTY IS THE RESPONSIBILITY OF THE UTILITY.
SEE COVER OF CIVIL PLAN
APPROVAL BY: DATE

CITY OF LAS VEGAS PERMIT REQUIRED*
CONTACT CLV LAND DEVELOPMENT (229-6371)
CLV CONSTRUCTION SERVICES MUST BE NOTIFIED 24 HOURS PRIOR TO COMMENCING CONSTRUCTION (229-6337)
HANSEN
DATE
*NVE INSPECTOR MUST BE NOTIFIED BY FAX 48 HOURS PRIOR TO COMMENCING CONSTRUCTION & WILL VERIFY CITY PERMIT FOR WORK DONE IN STREETS OR SIDEWALK.
FAX PERMIT TO:
LAS VEGAS NORTH (RYAN CENTER): 402-4354
LAS VEGAS SOUTH (BELTWAY CENTER): 402-6864

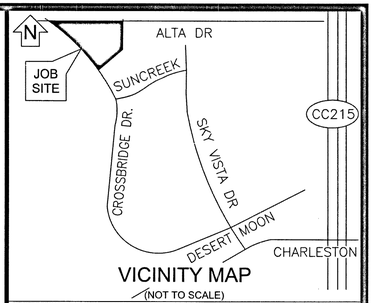

VICINITY MAP
(NOT TO SCALE)

EVERY EFFORT HAS BEEN MADE TO IDENTIFY ALL NVE FACILITIES. THE CUSTOMER SHALL CONFIRM THE EXISTENCE AND LOCATION OF THESE FACILITIES.

AVOID HITTING OVERHEAD POWER LINES. IT'S COSTLY.
CALL BEFORE YOU DO OVERHEAD
CALL 1-702-402-2929

Call before you Dig
Avoid cutting underground utility lines. It's costly.
CALL 811
OR 1-800-227-2600
AND CLARK COUNTY TRAFFIC OPERATIONS 1-702-455-6000

REVISIONS

NO.	DESCRIPTION	DATE	REV BY
1	SERVICE FLOP LOT 25 PER CUSTOMER REQUEST PAGE 4 OF 5.	9/11/2019	

STANDARD DCA

PROJECT PURPOSE:

SERVE RESIDENTIAL SUBDIVISION WITHIN THE MASTER PLAN COMMUNITY OF 3000725849-SUMMERLIN V24
(94) HOMES, 200A 120/240V PANELS
(1) IRRIGATION SVC, 125A 120/240V PEDESTAL
(2) STREETLIGHT SVC 200A 120/240V PEDESTAL

EXHIBIT 'A'

NVEnergy INFORMATION:
COORDINATOR: MONTOYA, LUIS
PHONE: (702)217-8222 D.F. LOWELL, KEN
DESIGNER: MOHAMED, CHRISTOPHER
DCA: 285-8182, 219-5761
INSPECTOR: 702-402-3008 OR UGI@NVENERGY.COM
STAND BY: (702) 402-4450, 4150, 4114, 4117, 4118
DISTRICT: LAS VEGAS NORTH DISTRICT
JPA INFORMATION:
JPA ADMIN PHONE: N/A JPA#: N/A
CUSTOMER INFORMATION:
APPLICANT: KB HOME LAS VEGAS INC.
ENGINEER: SHG
CONTACT: BONNER, ARIC ** 702-266-8556
APPROVAL DATE: 7/25/2019
GOVERNMENT INFORMATION:
AGENCY: CLV
APPROVAL DATE: ----

FOR EACH SERVICE POINT (POINT OF DELIVERY), ENERGY FOR EACH TENANT SPACE WILL BE MEASURED THROUGH ONE WATTHOUR METER. ENERGY FOR ALL NON-TENANT SPACE WILL BE MEASURED THROUGH ONE WATTHOUR METER. CONTACT NVE METER OPERATIONS FOR MULTIPLE RATE CLASS INSTALLATIONS.

NVEnergy

BRISTLE VALE UNIT 2 - SUBDIVISION

CROSSBRIDGE AND SUNCREEK

PROJ #3003712795	SCALE: 1"=30'
SHEET # 3 OF 5	DATE: 5/28/2019

lm21910
9/11/2019 5:22 PM

Sharing of this drawing and the information contained herein shall be only to individuals/parties who have entered into an agreement with Applicant for the completion of work associated with this specific project. Use for purposes other than this specific project requires the written consent of NV Energy.

L19-00524
107Y5102-2

1 REVISION(S)
30

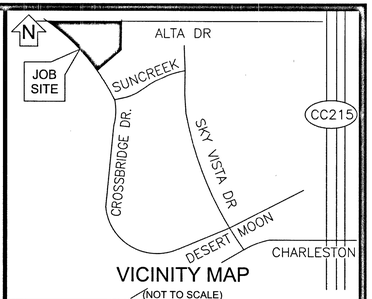

VICINITY MAP

(NOT TO SCALE)

EVERY EFFORT HAS BEEN MADE TO IDENTIFY ALL NVE FACILITIES. THE CUSTOMER SHALL CONFIRM THE EXISTENCE AND LOCATION OF THESE FACILITIES.

AVOID HITTING OVERHEAD POWER LINES. IT'S COSTLY.

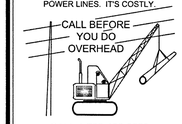

CALL 1-702-402-2929

Call before you Dig
Avoid cutting underground utility lines. It's costly.

CALL 811

OR
1-800-227-2600
AND CLARK COUNTY TRAFFIC OPERATIONS
1-702-455-6000

REVISIONS

NO.	DESCRIPTION	DATE	REV BY
1	SERVICE FLOP LOT 25 PER CUSTOMER REQUEST PAGE 4 OF 5.	9/11/2019	

STANDARD DCA

PROJECT PURPOSE:

SERVE RESIDENTIAL SUBDIVISION WITHIN THE MASTER PLAN COMMUNITY OF 3000725849-SUMMERLIN V24
(94) HOMES, 200A 120/240V PANELS
(1) IRRIGATION SVC, 125A 120/240V PEDESTAL
(2) STREETLIGHT SVC 200A 120/240V PEDESTAL

EXHIBIT 'A'

NVEnergy INFORMATION:
COORDINATOR: MONTOYA, LUIS
PHONE: (702)217-8222 D.F. LOWELL, KEN
DESIGNER: MOHAMED, CHRISTOPHER
DCA: 285-8182, 219-5761
INSPECTOR: 702-402-3008 OR UGI@NVENERGY.COM
STAND BY: (702) 402-4450, 4150, 4114, 4117, 4118
DISTRICT: LAS VEGAS NORTH DISTRICT
JPA INFORMATION:
JPA ADMIN PHONE: N/A JPA#: N/A
CUSTOMER INFORMATION:
APPLICANT: KB HOME LAS VEGAS INC.
ENGINEER: SHG
CONTACT: BONNER, ARIC ** 702-266-8556
APPROVAL DATE: 7/25/2019
GOVERNMENT INFORMATION:
AGENCY: CLV I
APPROVAL DATE: ---- I

FOR EACH SERVICE POINT (POINT OF DELIVERY), ENERGY FOR EACH TENANT SPACE WILL BE MEASURED THROUGH ONE WATTHOUR METER. ENERGY FOR ALL NON-TENANT SPACE WILL BE MEASURED THROUGH ONE WATTHOUR METER. CONTACT NVE METER OPERATIONS FOR MULTIPLE RATE CLASS INSTALLATIONS.

UNLESS OTHERWISE NOTED:

ALL SERVICE CONDUCTOR: 2/0 AL. TRI.
ALL TRANSFORMERS: 7200V-120/240V-1ø PM
LARGEST A/C UNIT SIZE: 5 TONS
NUMBER OF UNITS: 94
MAIN SIZE: 200 AMPS
ESTIMATED KVA PER UNIT: 8 KVA
SQ. FT. OF LARGEST UNIT: 2,466 FT²

NOTE: ALL THE ABOVE GROUND UTILITY APPURTENANCES SHALL CONFORM TO THE REQUIREMENTS OF CLV UNIFIED DEVELOPMENT CODE TITLE 19.06 AND 19.08

APPROVED FOR CONSTRUCTION
THIS APPROVAL IS FOR WORK IN CLV R/W & EASEMENT ONLY. OBTAINING PERMISSIONS OR EASEMENTS FOR WORK SHOWN ON PRIVATE PROPERTY IS THE RESPONSIBILITY OF THE UTILITY.

SEE COVER OF CIVIL PLAN

APPROVAL BY: DATE

CITY OF LAS VEGAS
PERMIT REQUIRED*

CONTACT CLV LAND DEVELOPMENT (229-6371) CLV CONSTRUCTION SERVICES MUST BE NOTIFIED 24 HOURS PRIOR TO COMMENCING CONSTRUCTION (229-6337)

HANSEN

DATE

*NVE INSPECTOR MUST BE NOTIFIED BY FAX 48 HOURS PRIOR TO COMMENCING CONSTRUCTION & WILL VERIFY CITY PERMIT FOR WORK DONE IN STREETS OR SIDEWALK.
FAX PERMIT TO:
LAS VEGAS NORTH (RYAN CENTER): 402-4354
LAS VEGAS SOUTH (BELTWAY CENTER): 402-6864

NVEnergy

BRISTLE VALE UNIT 2 - SUBDIVISION

CROSSBRIDGE AND SUNCREEK

PROJ #3003712795	SCALE: 1"=30'
SHEET # 4 OF 5	DATE: 5/28/2019

Sharing of this drawing and the information contained herein shall be only to individuals/parties who have entered into an agreement with Applicant for the completion of work associated with this specific project. Use for purposes other than this specific project requires the written consent of NV Energy.

1 REVISION(S)

L-19-00624
1074S102-2

39

im21910
9/11/2019 5:22 PM

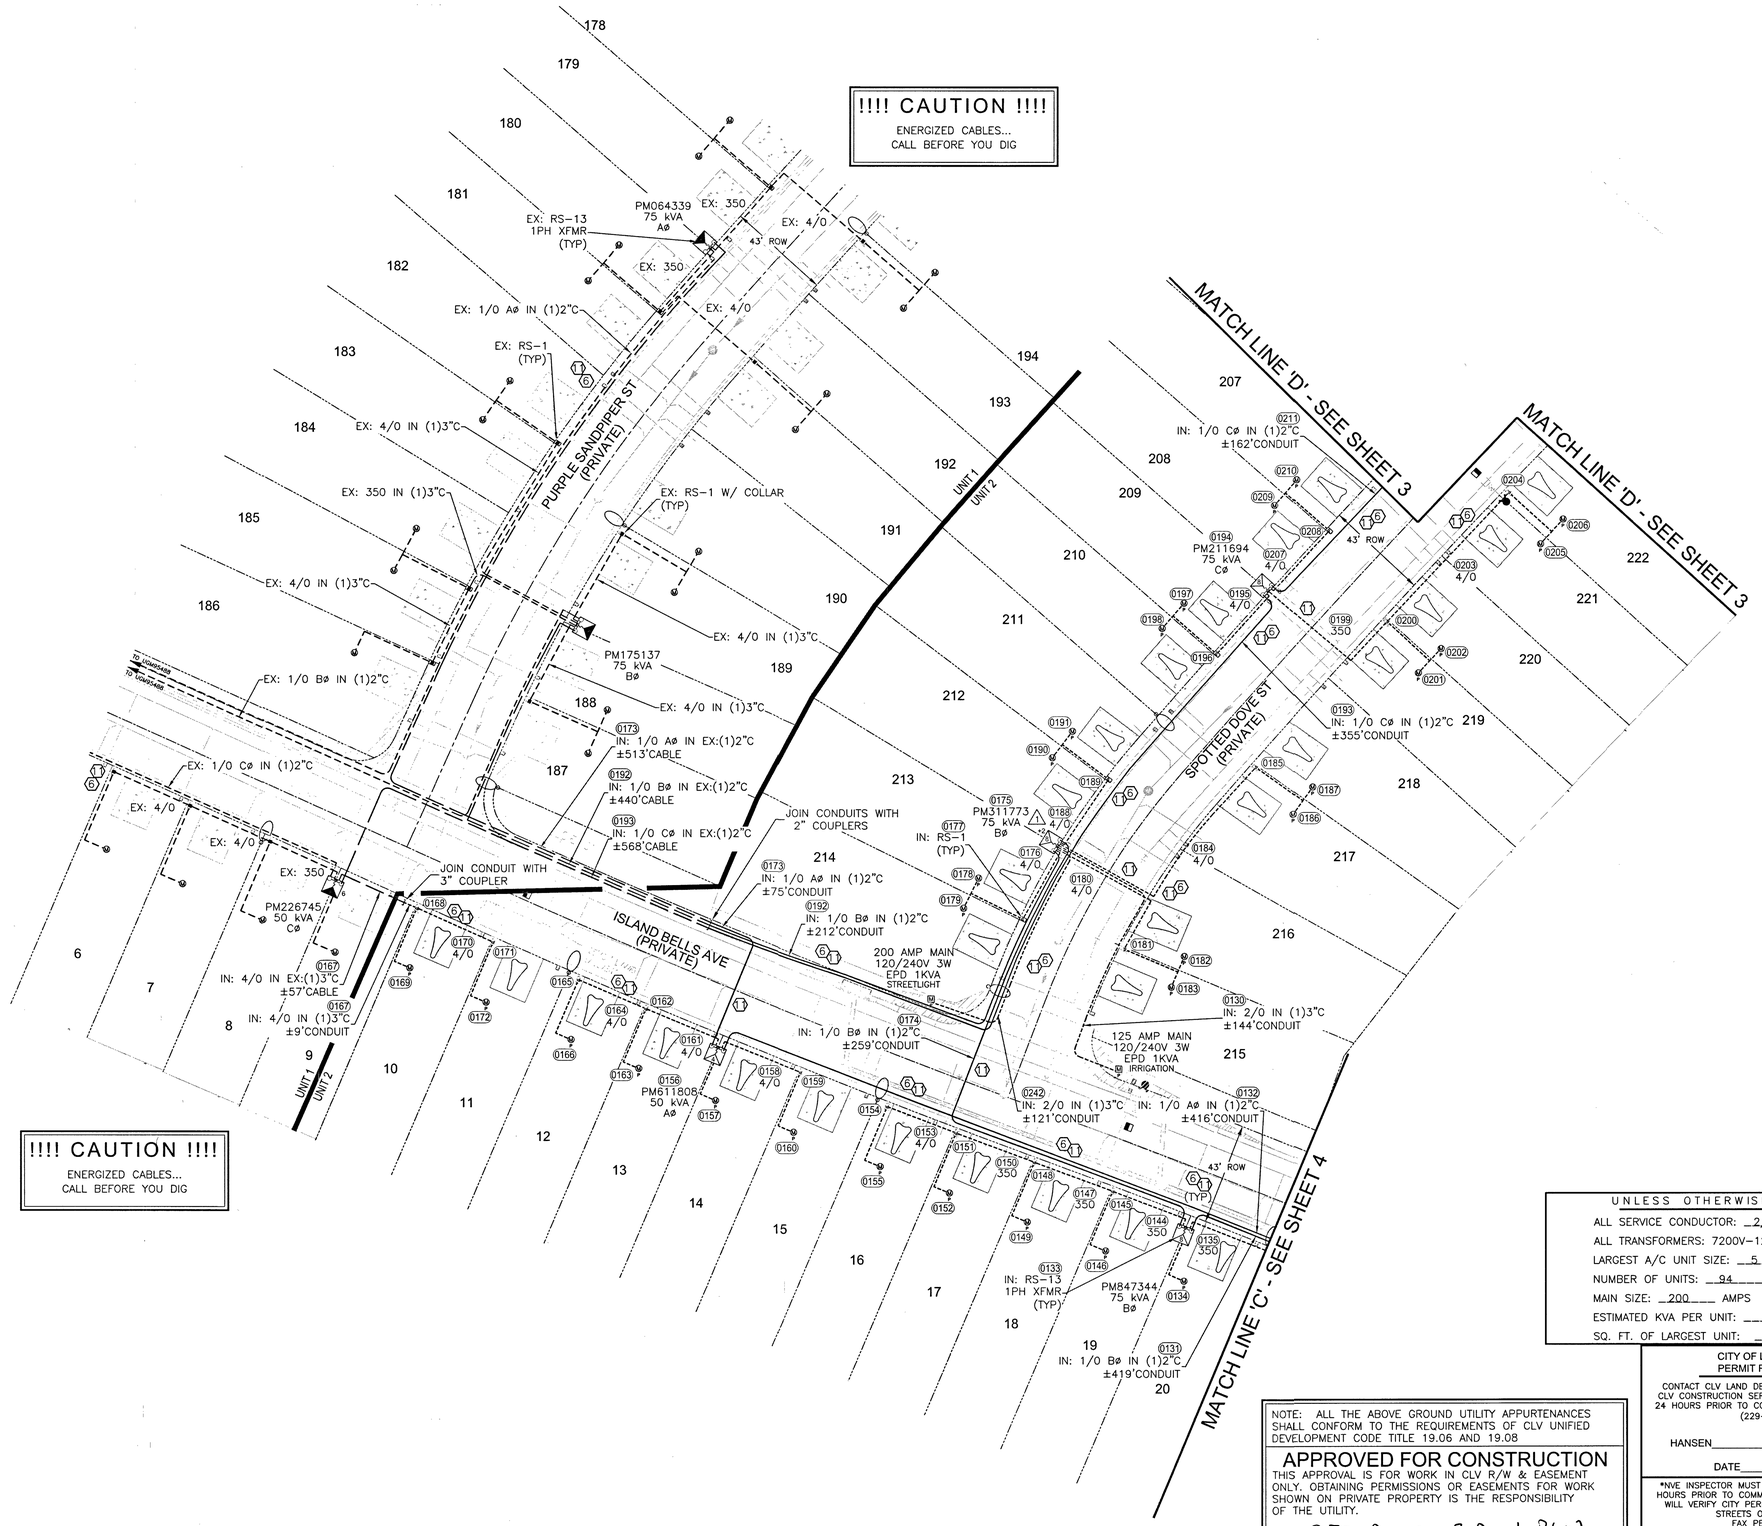

UNLESS OTHERWISE NOTED:

ALL SERVICE CONDUCTOR: 2/0 AL. TRI.
ALL TRANSFORMERS: 7200V-120/240V-1Ø PM
LARGEST A/C UNIT SIZE: 5 TONS
NUMBER OF UNITS: 94
MAIN SIZE: 200 AMPS
ESTIMATED KVA PER UNIT: 8 KVA
SQ. FT. OF LARGEST UNIT: 2,466 FT²

NOTE: ALL THE ABOVE GROUND UTILITY APPURTENANCES SHALL CONFORM TO THE REQUIREMENTS OF CLV UNIFIED DEVELOPMENT CODE TITLE 19.06 AND 19.08

APPROVED FOR CONSTRUCTION

THIS APPROVAL IS FOR WORK IN CLV R/W & EASEMENT ONLY. OBTAINING PERMISSIONS OR EASEMENTS FOR WORK SHOWN ON PRIVATE PROPERTY IS THE RESPONSIBILITY OF THE UTILITY.

SEE Cover of Civil PLAN

APPROVAL BY: DATE

CITY OF LAS VEGAS
PERMIT REQUIRED*

CONTACT CLV LAND DEVELOPMENT (229-6371)
CLV CONSTRUCTION SERVICES MUST BE NOTIFIED 24 HOURS PRIOR TO COMMENCING CONSTRUCTION (229-6337)

HANSEN

DATE

*NVE INSPECTOR MUST BE NOTIFIED BY FAX 48 HOURS PRIOR TO COMMENCING CONSTRUCTION & WILL VERIFY CITY PERMIT FOR WORK DONE IN STREETS OR SIDEWALK.
FAX PERMIT TO:
LAS VEGAS NORTH (RYAN CENTER): 402-4354
LAS VEGAS SOUTH (BELTWAY CENTER): 402-6864

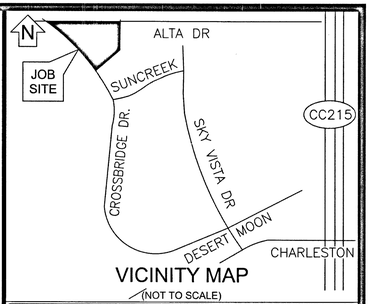

VICINITY MAP
(NOT TO SCALE)

EVERY EFFORT HAS BEEN MADE TO IDENTIFY ALL NVE FACILITIES. THE CUSTOMER SHALL CONFIRM THE EXISTENCE AND LOCATION OF THESE FACILITIES.

AVOID HITTING OVERHEAD POWER LINES. IT'S COSTLY.
CALL BEFORE YOU DO OVERHEAD
CALL 1-702-402-2929

Call before you Dig
Avoid cutting underground utility lines. It's costly.
CALL 811
OR
1-800-227-2600
AND CLARK COUNTY TRAFFIC OPERATIONS
1-702-455-6000

REVISIONS

NO.	DESCRIPTION	DATE	REV BY
1	SERVICE FLOP LOT 25 PER CUSTOMER REQUEST PAGE 4 OF 5.	9/11/2019	

STANDARD DCA

PROJECT PURPOSE:

SERVE RESIDENTIAL SUBDIVISION WITHIN THE MASTER PLAN COMMUNITY OF 3000725849-SUMMERLIN V24
(94) HOMES, 200A 120/240V PANELS
(1) IRRIGATION SVC, 125A 120/240V PEDESTAL
(2) STREETLIGHT SVC 200A 120/240V PEDESTAL

EXHIBIT 'A'

NVEnergy INFORMATION:
COORDINATOR: MONTOYA, LUIS
PHONE: (702)217-8222 D.F. LOWELL, KEN
DESIGNER: MOHAMED, CHRISTOPHER
DCA: 285-8182, 219-5761
INSPECTOR: 702-402-3008 OR UGI@NVENERGY.COM
STAND BY: (702) 402-4450, 4150, 4114, 4117, 4118
DISTRICT: LAS VEGAS NORTH DISTRICT

JPA INFORMATION:
JPA ADMIN PHONE: N/A JPA#: N/A

CUSTOMER INFORMATION:
APPLICANT: KB HOME LAS VEGAS INC.
ENGINEER: SHG
CONTACT: BONNER, ARIC ** 702-266-8556
APPROVAL DATE: 7/25/2019

GOVERNMENT INFORMATION:
AGENCY: CLV 1
APPROVAL DATE: ----- 1

FOR EACH SERVICE POINT (POINT OF DELIVERY), ENERGY FOR EACH TENANT SPACE WILL BE MEASURED THROUGH ONE WATTHOUR METER. ENERGY FOR ALL NON-TENANT SPACE WILL BE MEASURED THROUGH ONE WATTHOUR METER. CONTACT NVE METER OPERATIONS FOR MULTIPLE RATE CLASS INSTALLATIONS.

NVEnergy

BRISTLE VALE UNIT 2 - SUBDIVISION

CROSSBRIDGE AND SUNCREEK

PROJ #3003712795	SCALE: 1"=30'
SHEET # 5 OF 5	DATE: 5/28/2019

lm21910
9/17/2019 5:22 PM

Sharing of this drawing and the information contained herein shall be only to individuals/parties who have entered into an agreement with Applicant for the completion of work associated with this specific project. Use for purposes other than this specific project requires the written consent of NV Energy.

L19-00527
107Y-5102-2

1 REVISION(S)

40

MATCHLINE "A" SEE SHEET 2

OREGON CHERRY AVE (PRIVATE)

SPOTTED DOVE ST (PRIVATE)

WIND POPPY ST (PRIVATE)

ISLAND BELLS AVE (PRIVATE)

LEGEND

1		INSTALL B-36 PULL BOX (24"X36"X24")
2		EXISTING B-36 PULL BOX (24"X36"X24")
3		INSTALL B-50 PULL BOX (13"X24"X24")
4		EXISTING B-50 PULL BOX (13"X24"X24")
5		INSTALL B-100 PULL BOX (24"X36"X24")
6		EXISTING B-100 PULL BOX (24"X36"X24")
7		INSTALL T-200 CATV VAULT (30"X48"X36")
8		EXISTING T-200 CATV VAULT (30"X48"X36")
9		INSTALL T-400 CATV VAULT (36"X60"X36")
10		EXISTING T-400 CATV VAULT (36"X60"X36")
11		INSTALL T-600 CATV VAULT (48"X72"X36")
12		EXISTING T-600 CATV VAULT (48"X72"X36")
13		INSTALL NEW CATV PEDESTAL
14		EXISTING CATV PEDESTAL
15		R&R S/W SLAB(S)
16		POTHOLE
17	—C—	SIDEWALK/DIRT TRENCH INSTALL WITH FIBER/COAX PULL
18	—C—	ASPHALT MITIGATION/STREET TRENCH WITH FIBER/COAX PULL
19	—B—	PROPOSED BORE WITH FIBER/COAX PULL
20	—X—	EXISTING CATV CONDUIT(S)
21	—OHC—	PROPOSED OVERHEAD FIBER OPTIC CABLE OR COAX INSTALL
22	—XOHC—	EXISTING OVERHEAD FIBER OPTIC CABLE OR COAX
23		U.G. FIBER/COAX PULL THROUGH EXISTING CONDUIT
24		RIGHT OF WAY LINE
25		LOT/PROPERTY LINE
26		EDGE OF PAVEMENT/ SIDEWALK/CONCRETE
27	P	EXISTING NVE PULL BOX
28	T	EXISTING TELCO PULL BOX
29	TM	EXISTING COMMUNICATION MANHOLE
30	T	EXISTING TELCO POLE
31		EXISTING NVE POLE
32	NVE	EXISTING NVE TRANSMISSION POLE
33		EXISTING JOINT POLE
34		EXISTING JOINT POLE WITH TRANSFORMER
35		POLE ANCHOR
36		EXISTING NVE TRANSFORMER TRANSFORMER PAD
37	TS	SNWA TEST STATION
38		COX POWER SUPPLY (49"X24"X52")
39	CB	CABINET (RHINO,ODN,OLM)
40		RISER POLE/QUADRANT DETAIL RISER OWNERSHIP NOTED
41		RAILROAD
42	MH	EXISTING MANHOLE (SS),(SD)...ECT
43		1in CONDUIT LATERAL
44		STORMWATER ASSETS
45		

DISCLAIMER NOTE

UTILITY LOCATIONS SHOWN HEREON ARE APPROXIMATE ONLY. IT SHALL BE THE CONTRACTOR'S RESPONSIBILITY TO DETERMINE THE EXACT HORIZONTAL AND VERTICAL LOCATION OF ALL EXISTING UNDERGROUND AND OVERHEAD UTILITIES PRIOR TO COMMENCING CONSTRUCTION. NO REPRESENTATION IS MADE THAT ALL EXISTING UTILITIES ARE SHOWN HEREON. THE ENGINEER ASSUMES NO RESPONSIBILITY FOR UTILITIES NOT SHOWN OR UTILITIES NOT SHOWN IN THEIR PROPER LOCATIONS.

AVOID HITTING UNDERGROUND TRAFFIC SIGNAL SYSTEMS AND STREET LIGHT SYSTEMS CONDUITS IT'S COSTLY.
CALL BEFORE YOU DO UNDERGROUND
CALL BEFORE YOU UNDERGROUND
1-702-455-7811
CLARK COUNTY TRAFFIC OPERATIONS
AND
1-702-432-5300
LAS VEGAS AREA COMPUTERIZED SYSTEM

AVOID CUTTING UNDERGROUND UTILITY LINES. IT'S COSTLY.
CALL
BEFORE YOU DIG
OR 1-800-227-2600
UNDERGROUND SERVICE (USA)

AVOID OVERHEAD POWER LINE CONTACT
CALL BEFORE YOU OVERHEAD
1-702-227-2929
NEVADA POWER ENVIROMENT AND SAFETY SERVICE DEPARTMENT

TOTAL BORE	0'
TOTAL DIRT TRENCH	0'
TOTAL ASPHALT TRENCH	0'
TOTAL TRENCH	0'
SIDEWALK REMOVAL/REPAIR	
TOTAL S/W PANELS	0
TOTAL LINEAR FOOTAGE	0'

T20S R59E SEC33

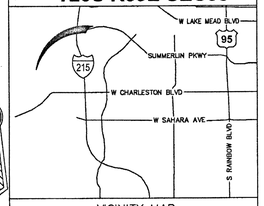

VICINITY MAP

REVISIONS

REV	DESCRIPTION	DATE	BY

ALL CONSTRUCTION AND MATERIALS SHALL BE IN ACCORDANCE WITH THE "UNIFORM STANDARD SPECIFICATIONS FOR PUBLIC WORKS CONSTRUCTION OFF-SITE IMPROVEMENTS, CLARK COUNTY AREA NEVADA" LATEST ISSUE; THE "UNIFORM STANDARD DRAWINGS FOR PUBLIC WORKS CONSTRUCTION, CLARK COUNTY AREA NEVADA",LATEST ISSUE; AND OTHER APPLICABLE APPROVED STANDARDS ISSUED BY THE CONTROLLING AGENCY; ALL LOCAL CITY CODES AND ORDINANCES APPLICABLE.

APPROVED FOR CONSTRUCTION

THIS APPROVAL IS FOR WORK IN CLV R/W OR CLV EASEMENT ONLY. OBTAINING PERMISSION OR EASEMENT FOR WORK SHOWN IN PRIVATE PROPERTY IS THE RESPONSIBILITY OF THE UTILITY.

SEE COVER SH OF CIVIL PLAN
APPROVAL DATE

PERMIT # RB-2290
DRAWN BY: WTB
DATE: 8/23/2019
SCALE: 1:30
NODE: N/A
PROJECT #: 40505190000RB29900
TECH # N/A
APPROVED BY: JASON COLLINS

COX
BRINGING US CLOSER
1700 VEGAS DRIVE
LAS VEGAS, NEVADA 89106
PHONE: (702) 545-1606
FAX: (702) 545-2606

CITY OF LAS VEGAS
333 N. RANCHO DRIVE
LAS VEGAS, NEVADA 89106
(702) 229-6885

PROJECT LOCATION: SV24 BRISTLE VALE UNIT 2
ISLAND BELLS AVE & WIND POPPY ST

SUB-CONTRACTOR: DBA: COX COMMUNICATIONS

ENTITY NOTES: 19-00527 ~~NONE~~ 107Y5102-2

SHEET No: 1
Sheet 1 of 2

TrueNet# 14520

19-00527
107Y5102-2
42

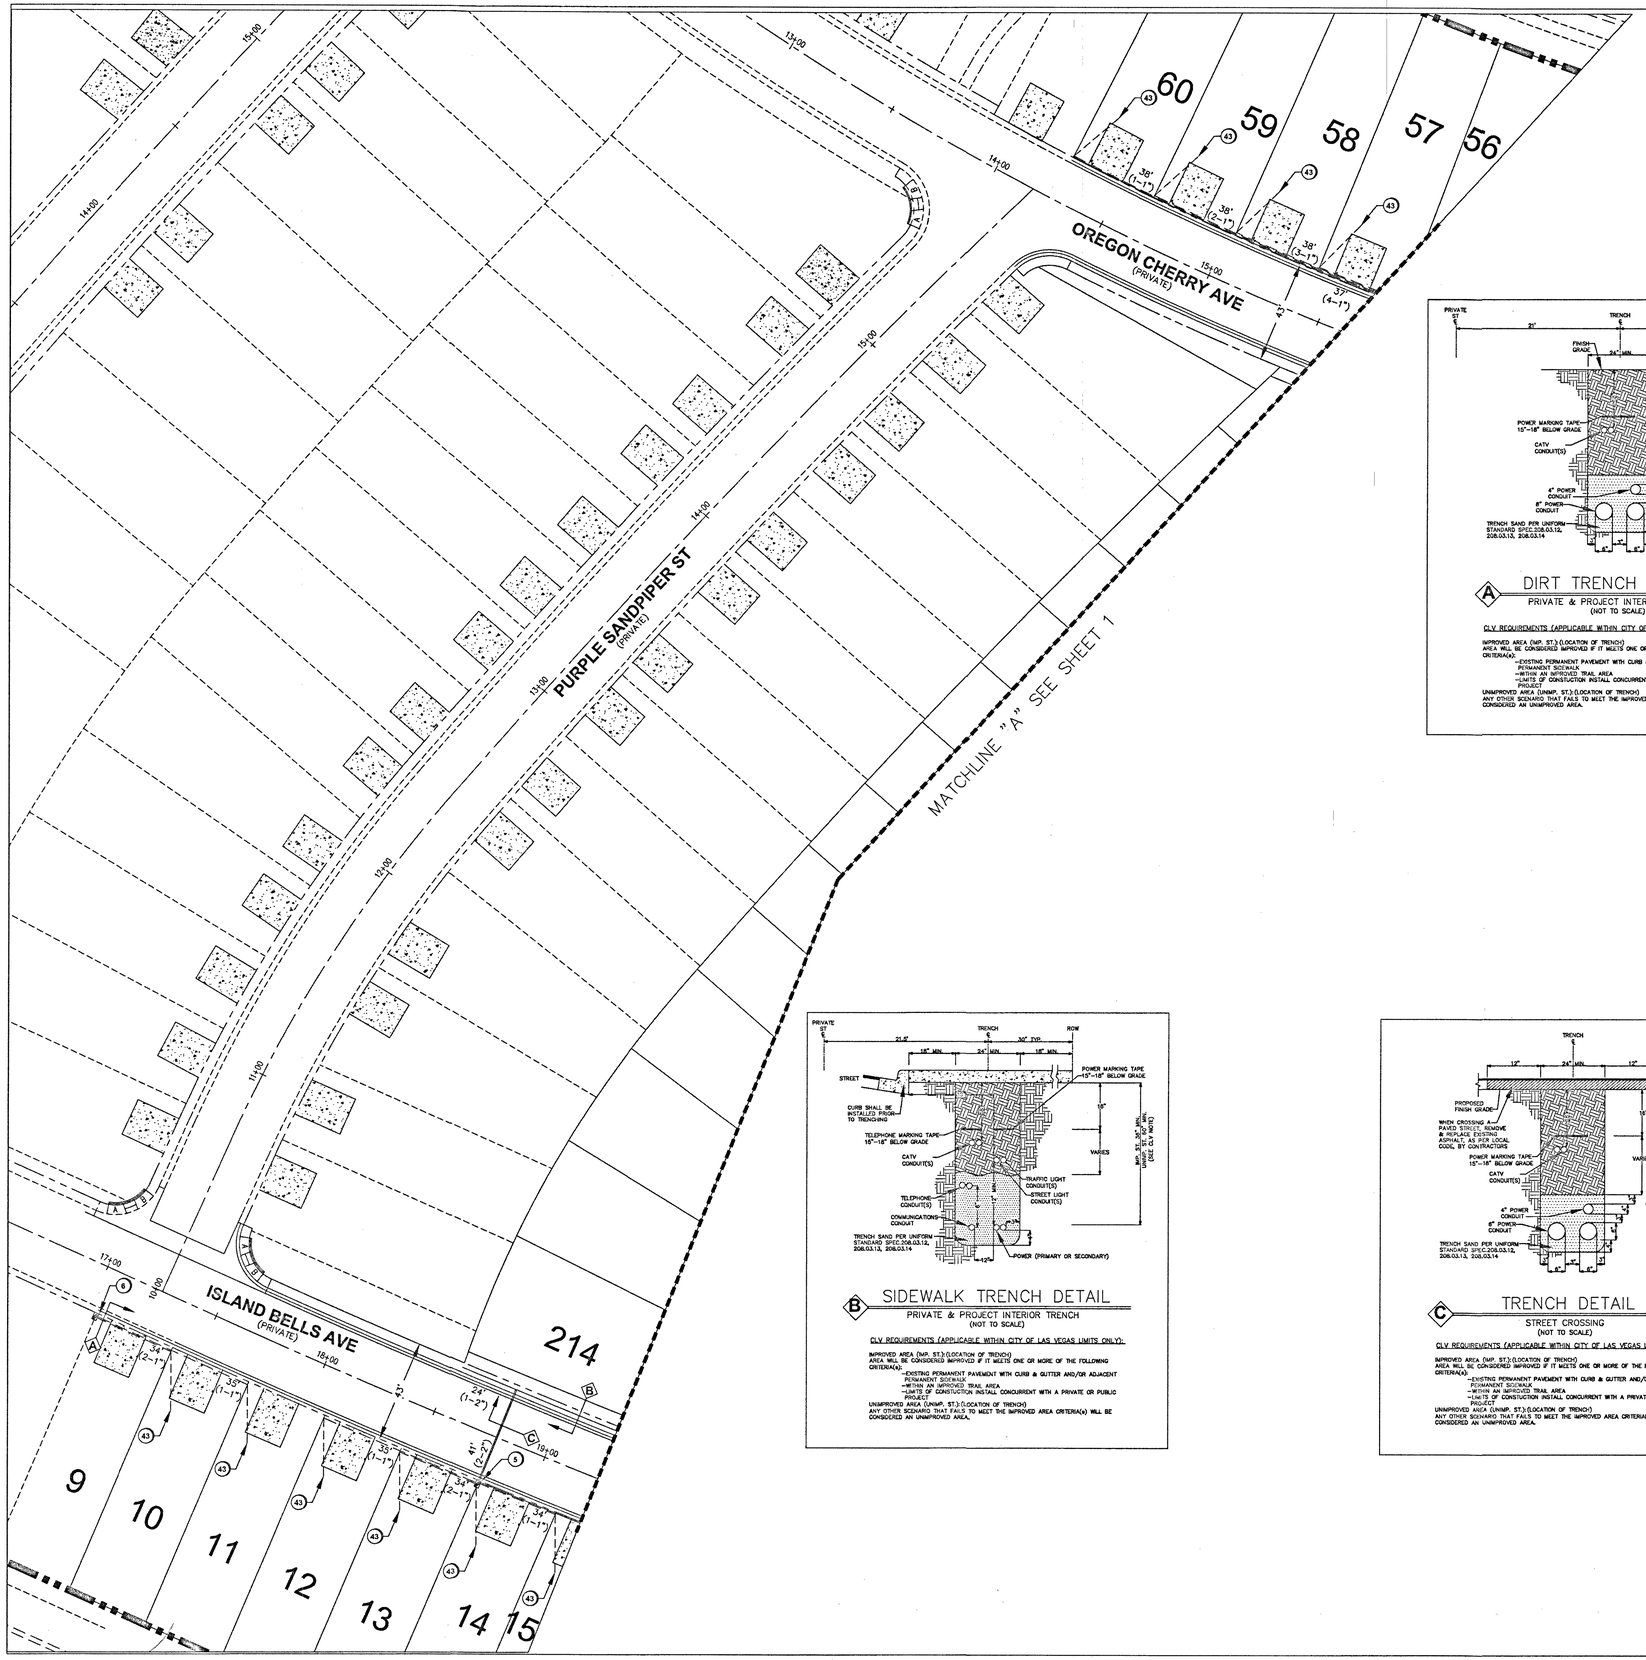

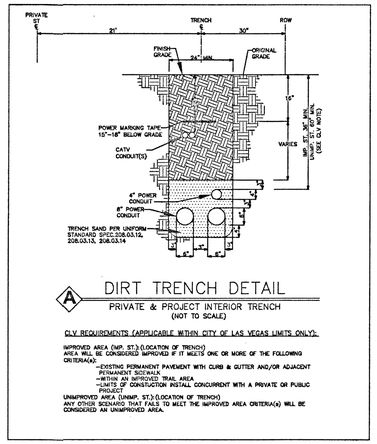

A DIRT TRENCH DETAIL

PRIVATE & PROJECT INTERIOR TRENCH
(NOT TO SCALE)

CLV REQUIREMENTS (APPLICABLE WITHIN CITY OF LAS VEGAS LIMITS ONLY):

IMPROVED AREA (IMP. ST.):(LOCATION OF TRENCH)
AREA WILL BE CONSIDERED IMPROVED IF IT MEETS ONE OR MORE OF THE FOLLOWING CRITERIA(A):
- –EXISTING PERMANENT PAVEMENT WITH CURB & GUTTER AND/OR ADJACENT PERMANENT SIDEWALK
- –WITHIN AN IMPROVED TRAIL AREA
- –LIMITS OF CONSTUCTION INSTALL CONCURRENT WITH A PRIVATE OR PUBLIC PROJECT

UNIMPROVED AREA (UNIMP. ST.):(LOCATION OF TRENCH)
ANY OTHER SIGNARIO THAT FAILS TO MEET THE IMPROVED AREA CRITERIA(A) WILL BE CONSIDERED AN UNIMPROVED AREA.

B SIDEWALK TRENCH DETAIL

PRIVATE & PROJECT INTERIOR TRENCH
(NOT TO SCALE)

CLV REQUIREMENTS (APPLICABLE WITHIN CITY OF LAS VEGAS LIMITS ONLY):

IMPROVED AREA (IMP. ST.):(LOCATION OF TRENCH)
AREA WILL BE CONSIDERED IMPROVED IF IT MEETS ONE OR MORE OF THE FOLLOWING CRITERIA(A):
- –EXISTING PERMANENT PAVEMENT WITH CURB & GUTTER AND/OR ADJACENT PERMANENT SIDEWALK
- –WITHIN AN IMPROVED TRAIL AREA
- –LIMITS OF CONSTUCTION INSTALL CONCURRENT WITH A PRIVATE OR PUBLIC PROJECT

UNIMPROVED AREA (UNIMP. ST.):(LOCATION OF TRENCH)
ANY OTHER SIGNARIO THAT FAILS TO MEET THE IMPROVED AREA CRITERIA(A) WILL BE CONSIDERED AN UNIMPROVED AREA.

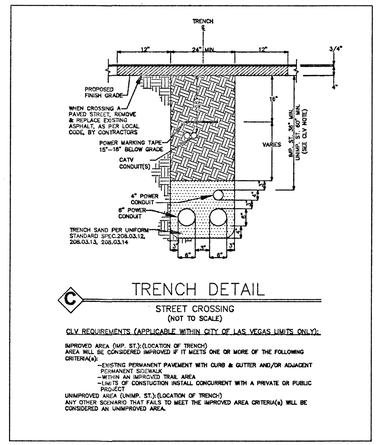

C TRENCH DETAIL

STREET CROSSING
(NOT TO SCALE)

CLV REQUIREMENTS (APPLICABLE WITHIN CITY OF LAS VEGAS LIMITS ONLY):

IMPROVED AREA (IMP. ST.):(LOCATION OF TRENCH)
AREA WILL BE CONSIDERED IMPROVED IF IT MEETS ONE OR MORE OF THE FOLLOWING CRITERIA(A):
- –EXISTING PERMANENT PAVEMENT WITH CURB & GUTTER AND/OR ADJACENT PERMANENT SIDEWALK
- –WITHIN AN IMPROVED TRAIL AREA
- –LIMITS OF CONSTUCTION INSTALL CONCURRENT WITH A PRIVATE OR PUBLIC PROJECT

UNIMPROVED AREA (UNIMP. ST.):(LOCATION OF TRENCH)
ANY OTHER SIGNARIO THAT FAILS TO MEET THE IMPROVED AREA CRITERIA(A) WILL BE CONSIDERED AN UNIMPROVED AREA.

LEGEND

1		INSTALL B-36 PULL BOX (24"X36"X24")
2		EXISTING B-36 PULL BOX (24"X36"X24")
3		INSTALL B-50 PULL BOX (13"X24"X24")
4		EXISTING B-50 PULL BOX (13"X24"X24")
5		INSTALL B-100 PULL BOX (24"X36"X24")
6		EXISTING B-100 PULL BOX (24"X36"X24")
7		INSTALL T-200 CATV VAULT (30"X48"X36")
8		EXISTING T-200 CATV VAULT (30"X48"X36")
9		INSTALL T-400 CATV VAULT (36"X60"X36")
10		EXISTING T-400 CATV VAULT (36"X60"X36")
11		INSTALL T-600 CATV VAULT (48"X72"X36")
12		EXISTING T-600 CATV VAULT (48"X72"X36")
13	△	INSTALL NEW CATV PEDESTAL
14	△	EXISTING CATV PEDESTAL
15	□	R&R S/W SLAB(S)
16	○	POTHOLE
17	—C—	SIDEWALK/DIRT TRENCH INSTALL WITH FIBER/COAX PULL
18	—C—	ASPHALT MITIGATION/STREET TRENCH WITH FIBER/COAX PULL
19	—B—	PROPOSED BORE WITH FIBER/COAX PULL
20	—X—	EXISTING CATV CONDUIT(S)
21	—OHC—	PROPOSED OVERHEAD FIBER OPTIC CABLE OR COAX INSTALL
22	—XOHC—	EXISTING OVERHEAD FIBER OPTIC CABLE OR COAX
23		U.G. FIBER/COAX PULL THROUGH EXISTING CONDUIT
24		RIGHT OF WAY LINE
25		LOT/PROPERTY LINE
26		EDGE OF PAVEMENT/ SIDEWALK/CONCRETE
27	P	EXISTING NVE PULL BOX
28	T	EXISTING TELCO PULL BOX
29	TM	EXISTING COMMUNICATION MANHOLE
30	T	EXISTING TELCO POLE
31		EXISTING NVE POLE
32	NVE	EXISTING NVE TRANSMISSION POLE
33		EXISTING JOINT POLE
34		EXISTING JOINT POLE WITH TRANSFORMER
35		POLE ANCHOR
36		EXISTING NVE TRANSFORMER TRANSFORMER PAD
37	TS	SNWA TEST STATION
38		COX POWER SUPPLY (49"X24"X52")
39	CB	CABINET (RHINO,ODN,OLM)
40		RISER POLE/QUADRANT DETAIL RISER OWNERSHIP NOTED
41		RAILROAD
42	MH	EXISTING MANHOLE (SS),(SD)...ECT
43		1in CONDUIT LATERAL
44		STORMWATER ASSETS
45		

DISCLAIMER NOTE

UTILITY LOCATIONS SHOWN HEREON ARE APPROXIMATE ONLY. IT SHALL BE THE CONTRACTOR'S RESPONSIBILITY TO DETERMINE THE EXACT HORIZONTAL AND VERTICAL LOCATION OF ALL EXISTING UNDERGROUND AND OVERHEAD UTILITIES PRIOR TO COMMENCING CONSTRUCTION. NO REPRESENTATION IS MADE THAT ALL EXISTING UTILITIES ARE SHOWN HEREON.THE ENGINEER ASSUMES NO RESPONSIBILITY FOR UTILITIES NOT SHOWN OR UTILITIES NOT SHOWN IN THEIR PROPER LOCATIONS.

AVOID HITTING UNDERGROUND TRAFFIC SIGNAL SYSTEMS AND STREET LIGHT SYSTEMS CONDUITS IT'S COSTLY

CALL BEFORE YOU DO UNDERGROUND

CALL BEFORE YOU UNDERGROUND
1-702-455-7511
CLARK COUNTY TRAFFIC OPERATIONS
AND
1-702-432-5300
LAS VEGAS AREA COMPUTERIZED SYSTEM

AVOID CUTTING UNDERGROUND UTILITY LINES. IT'S COSTLY.
CALL 811
BEFORE YOU DIG
OR 1-800-227-2600
UNDERGROUND SERVICE (USA)

AVOID OVERHEAD POWER LINE CONTACT
CALL BEFORE YOU OVERHEAD
1-702-227-2929
NEVADA POWER ENVIRONMENT AND SAFETY SERVICE DEPARTMENT

TOTAL BORE	0'
TOTAL DIRT TRENCH	0'
TOTAL ASPHALT TRENCH	0'
TOTAL TRENCH	0'
SIDEWALK REMOVAL/REPAIR	
TOTAL S/W PANELS	0
TOTAL LINEAR FOOTAGE	0'

T20S R59E SEC33

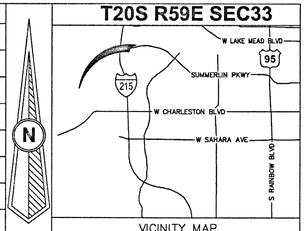

VICINITY MAP

REVISIONS

REV	DESCRIPTION	DATE	BY
△			
△			
△			
△			

ALL CONSTRUCTION AND MATERIALS SHALL BE IN ACCORDANCE WITH THE "UNIFORM STANDARD SPECIFICATIONS FOR PUBLIC WORKS CONSTRUCTION OFF-SITE IMPROVEMENTS, CLARK COUNTY AREA NEVADA" LATEST ISSUE; THE "UNIFORM STANDARD DRAWINGS FOR PUBLIC WORKS CONSTRUCTION, CLARK COUNTY AREA NEVADA",LATEST ISSUE; AND OTHER APPLICABLE APPROVED STANDARDS ISSUED BY THE CONTROLLING AGENCY; ALL LOCAL CITY CODES AND ORDINANCES APPLICABLE.

APPROVED FOR CONSTRUCTION

THIS APPROVAL IS FOR WORK IN CLV R/W OR CLV EASEMENT ONLY. OBTAINING PERMISSION OR EASEMENT FOR WORK SHOWN IN PRIVATE PROPERTY IS THE RESPONSIBILITY OF THE UTILITY.

SEE COVER SHEET FOR CIVIL PLAN APPROVAL — DATE

PERMIT #	RB-2290
DRAWN BY:	WTB
DATE:	8/23/2019
SCALE:	1:30
NODE:	N/A
PROJECT #:	40505190000RB29900
TECH #	N/A
APPROVED BY:	JASON COLLINS

COX
BRINGING US CLOSER
1700 VEGAS DRIVE
LAS VEGAS, NEVADA 89106
PHONE: (702) 545-1606
FAX: (702) 545-2606

CITY OF LAS VEGAS
333 N. RANCHO DRIVE
LAS VEGAS, NEVADA 89106
(702) 229-6885

PROJECT LOCATION: SV24 BRISTLE VALE UNIT 2
ISLAND BELLS AVE & WIND POPPY ST

SUB-CONTRACTOR: DBA: COX COMMUNICATIONS

ENTITY NOTES: L19-00527

SHEET No: 2
Sheet 2 of 2

NONE 1075102-2

TrueNet# 14520

L19-00527
1075102-2
43