
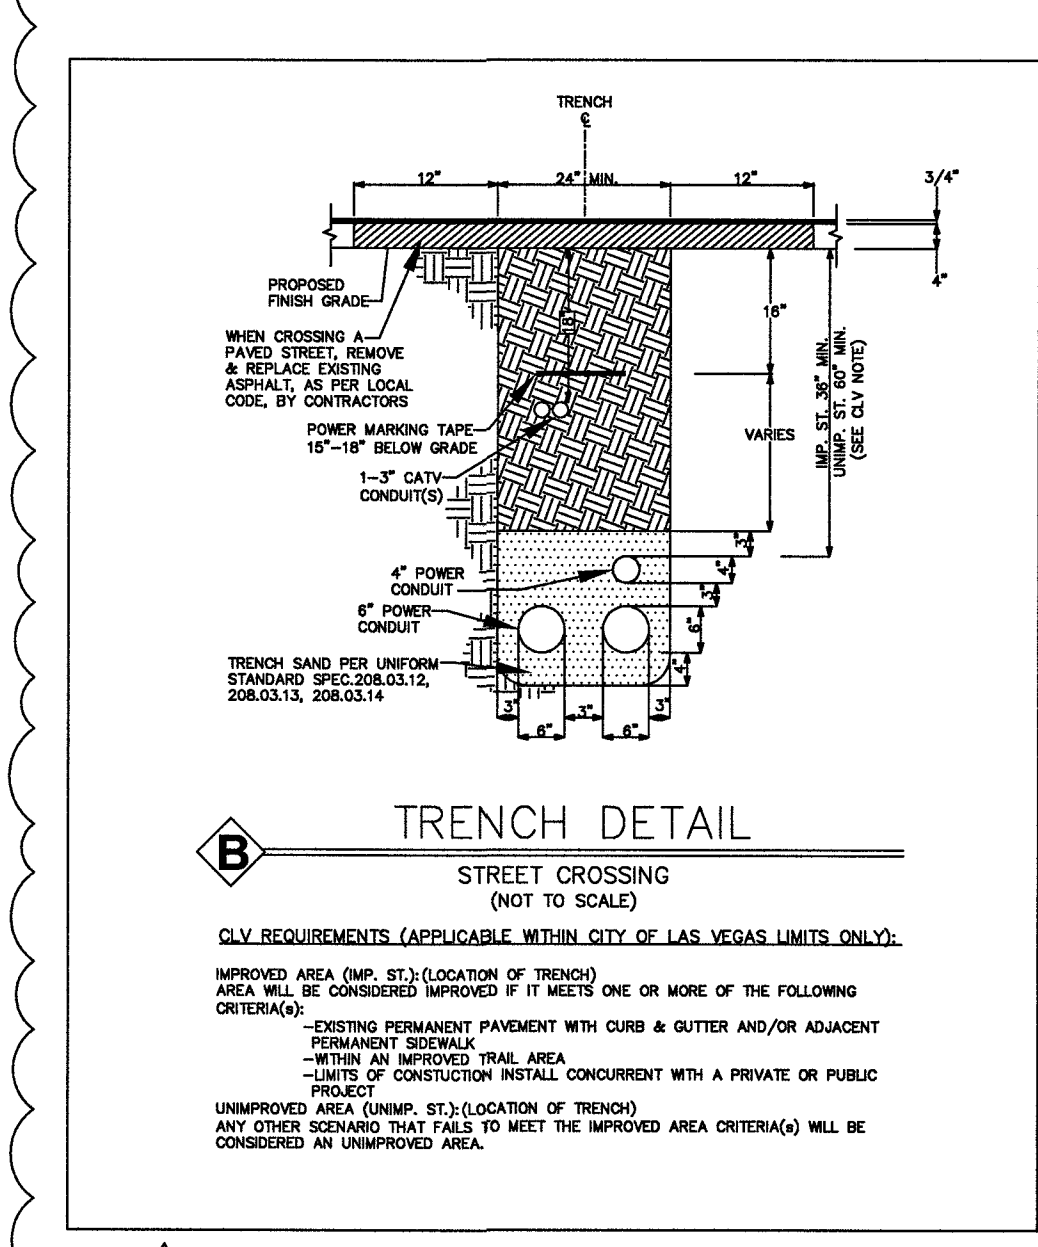
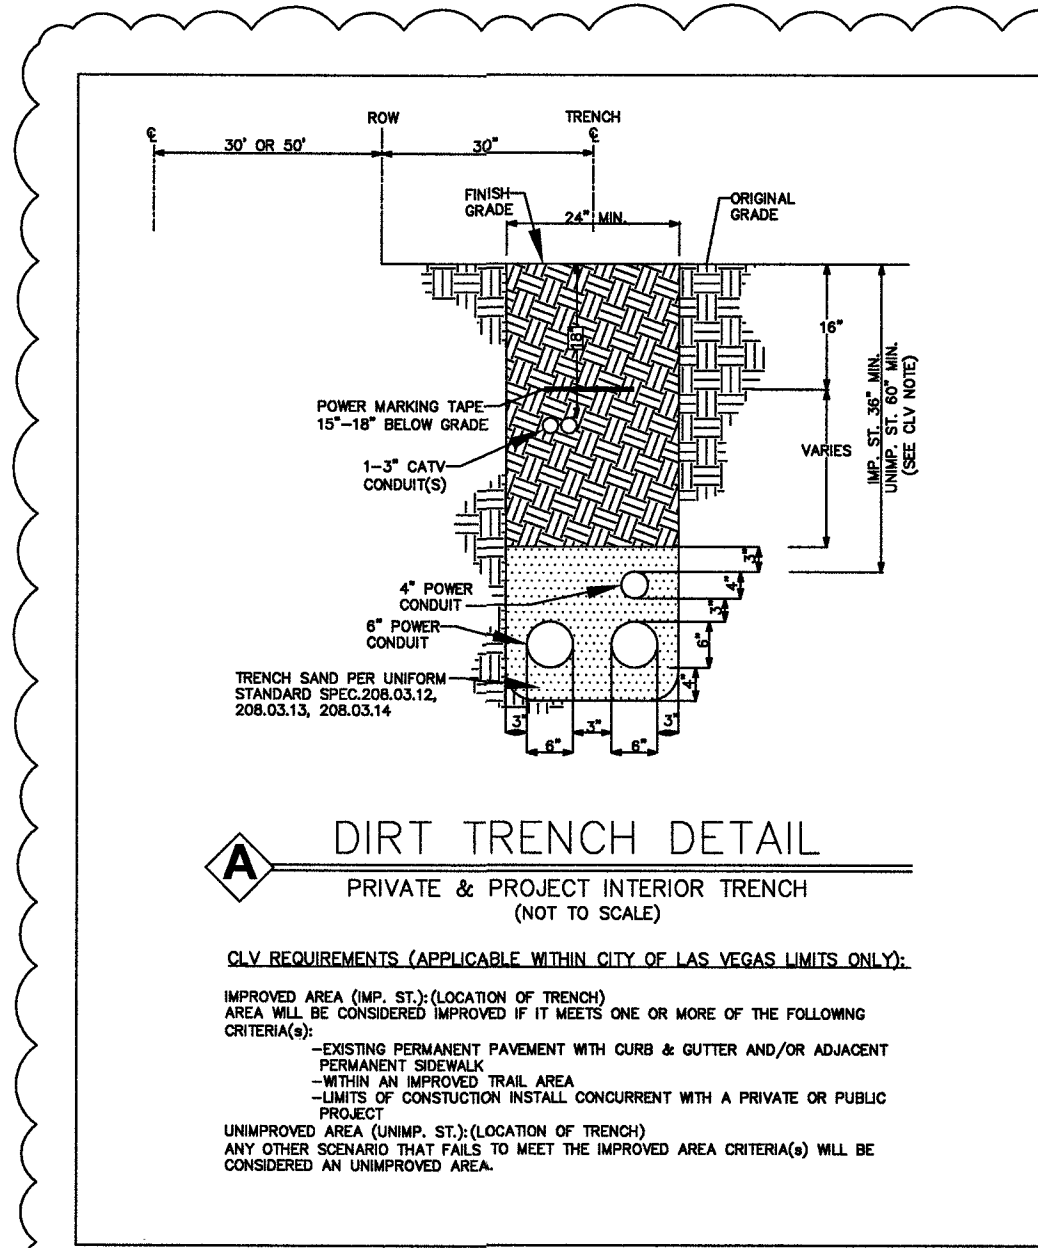
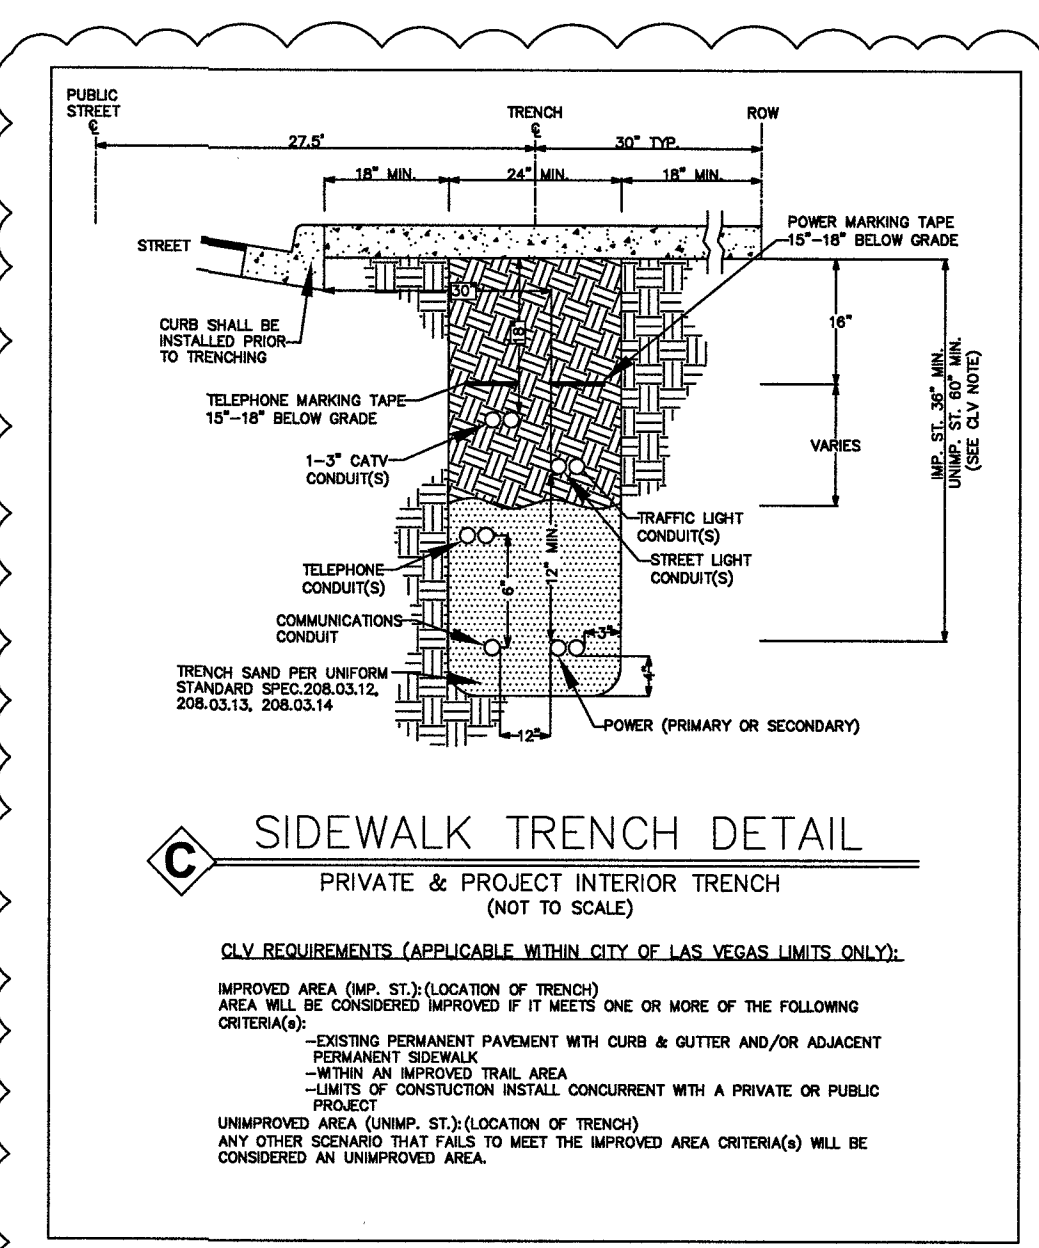


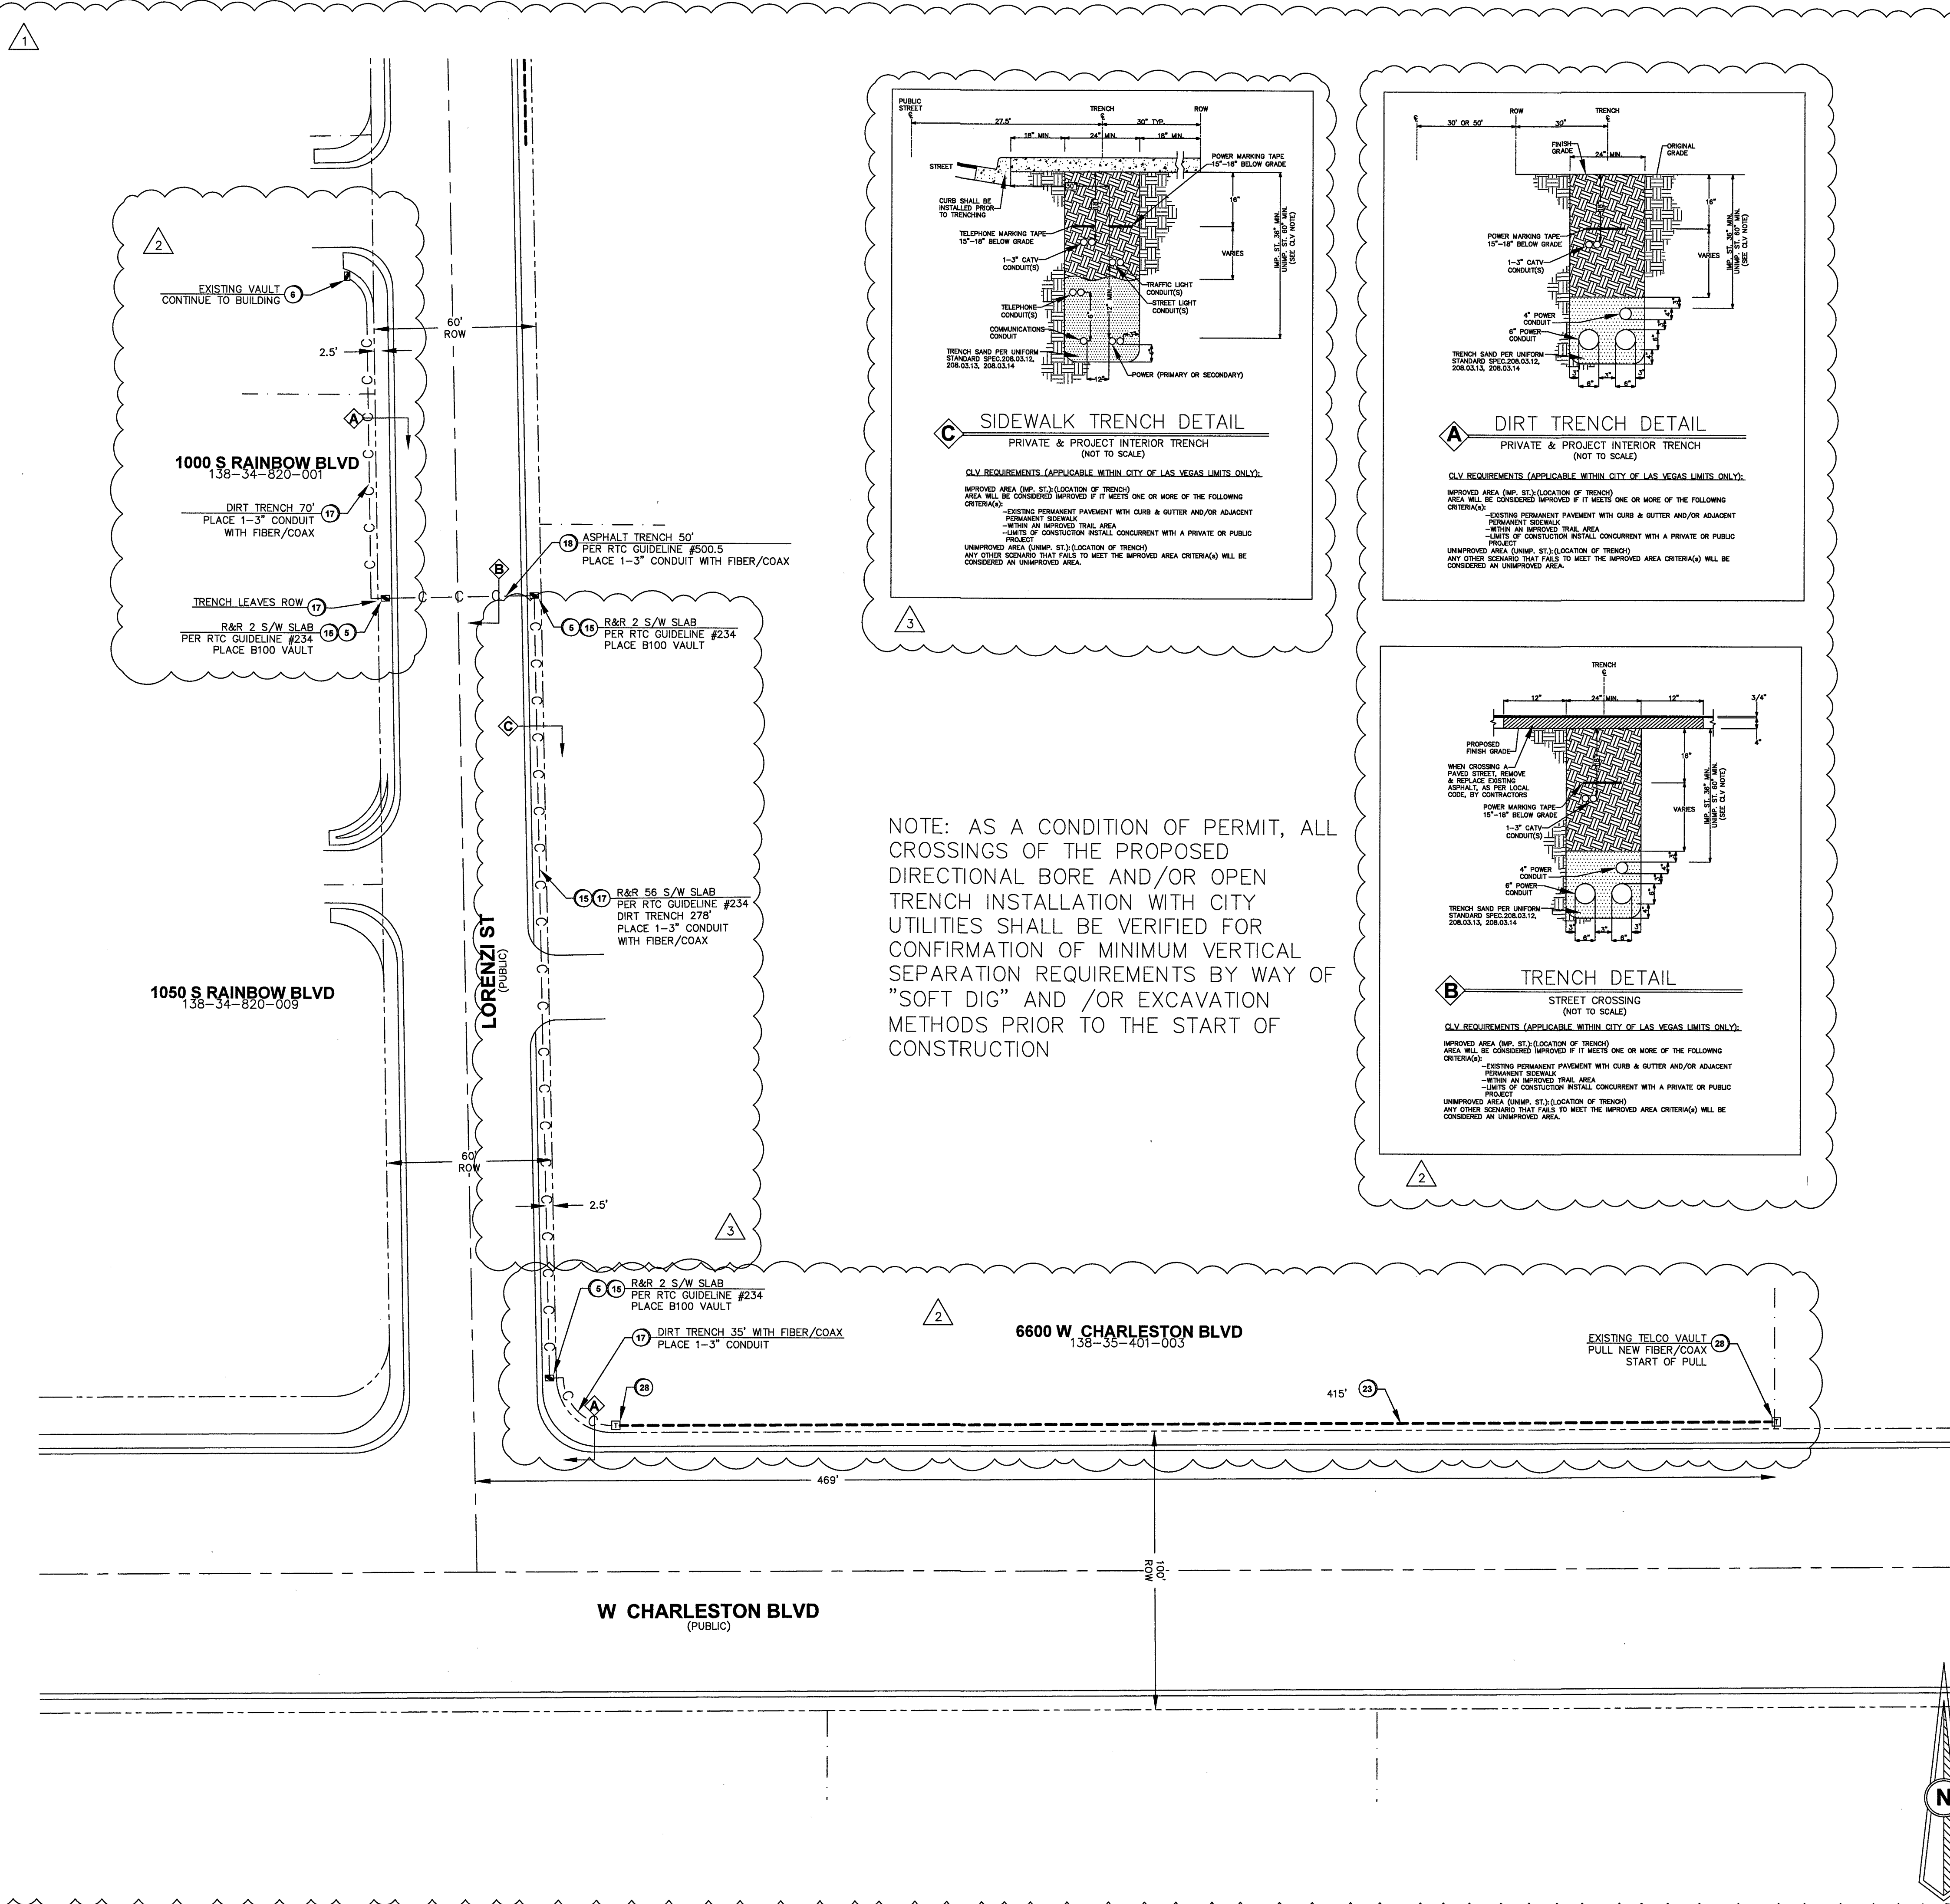

NOTE: AS A CONDITION OF PERMIT, ALL CROSSINGS OF THE PROPOSED DIRECTIONAL BORE AND/OR OPEN TRENCH INSTALLATION WITH CITY UTILITIES SHALL BE VERIFIED FOR CONFIRMATION OF MINIMUM VERTICAL SEPARATION REQUIREMENTS BY WAY OF "SOFT DIG" AND /OR EXCAVATION METHODS PRIOR TO THE START OF CONSTRUCTION

LEGEND

1	INSTALL B-36 PULL BOX (24"x36"x24")
2	EXISTING B-36 PULL BOX (24"x36"x24")
3	INSTALL B-50 PULL BOX (13"x24"x24")
4	EXISTING B-50 PULL BOX (13"x24"x24")
5	INSTALL B-100 PULL BOX (24"x36"x24")
6	EXISTING B-100 PULL BOX (24"x36"x24")
7	INSTALL T-200 CATV VAULT (30"x48"x36")
8	EXISTING T-200 CATV VAULT (30"x48"x36")
9	INSTALL T-400 CATV VAULT (36"x60"x36")
10	EXISTING T-400 CATV VAULT (36"x60"x36")
11	INSTALL T-600 CATV VAULT (48"x72"x36")
12	EXISTING T-600 CATV VAULT (48"x72"x36")
13	INSTALL NEW CATV PEDESTAL/CABINET
14	EXISTING NEW CATV PEDESTAL/CABINET
15	R&R S/W SLAB(S)
16	POTHOLE
17	SIDEWALK/DIRT TRENCH INSTALL WITH FIBER/COAX PULL
18	ASPHALT MITIGATION/STREET TRENCH WITH FIBER/COAX PULL
19	PROPOSED BORE WITH FIBER/COAX PULL
20	EXISTING CATV CONDUIT(S)
21	PROPOSED OVERHEAD FIBER OPTIC CABLE OR COAX INSTALL
22	EXISTING OVERHEAD FIBER OPTIC CABLE OR COAX
23	U.G. FIBER/COAX PULL THROUGH EXISTING CONDUIT
24	RIGHT OF WAY LINE
25	LOT/PROPERTY LINE
26	EDGE OF PAVEMENT
27	P EXISTING NVE PULL BOX
28	T EXISTING TELCO PULL BOX
29	TM EXISTING TELCO MANHOLE
30	T EXISTING TELCO POLE
31	NVE EXISTING NVE POLE
32	NVE EXISTING NVE TRANSMISSION POLE
33	EXISTING JOINT POLE
34	EXISTING JOINT POLE WITH TRANSFORMER
35	POLE ANCHOR
36	EXISTING NVE TRANSFORMER TRANSFORMER PAD
37	TS SNWA TEST STATION
38	COX POWER SUPPLY (49"x24"x52")
39	RC INSTALL RHINO CABINET
40	RISER POLE/QUADRANT DETAIL RISER OWNERSHIP NOTED
41	RAILROAD
42	EXISTING MANHOLE (SS)(SD)...ECT
43	1in CONDUIT LATERAL
44	STORMWATER ASSETS
45	

REVISIONS

REV	DESCRIPTION	DATE	BY
1	CHANGED ROUTE	8-28-19	MM
2	MOVED AREAS BEHIND SIDEWALK	10-31-19	MM
3	CHANGED BORE TO TRENCH DUE TO CALICHE	1-30-20	MM

ALL CONSTRUCTION AND MATERIALS SHALL BE IN ACCORDANCE WITH THE "UNIFORM STANDARD SPECIFICATIONS FOR PUBLIC WORKS CONSTRUCTION OFF-SITE IMPROVEMENTS, CLARK COUNTY AREA NEVADA" LATEST ISSUE; THE "UNIFORM STANDARD DRAWINGS FOR PUBLIC WORKS CONSTRUCTION, CLARK COUNTY AREA NEVADA", LATEST ISSUE; AND OTHER APPLICABLE APPROVED STANDARDS ISSUED BY THE CONTROLLING AGENCY; ALL LOCAL CITY CODES AND ORDINANCES APPLICABLE.

APPROVED FOR CONSTRUCTION

THIS APPROVAL IS FOR WORK IN CLV RW OR CLV EASEMENT ONLY. OBTAINING PERMISSION OR EASEMENT FOR WORK SHOWN IN PRIVATE PROPERTY IS THE RESPONSIBILITY OF THE UTILITY.

APPROVAL: *[Signature]* DATE: 3-25-20

PERMIT # 151121 DBT REV3 / 1001813

DRAWN BY: MM

DATE: 1/30/2020

SCALE: 1"=30'

NOTE: 151121 - 1001813

PROJECT #: 405201900000151121

TECH # N/A

APPROVED BY: Charles Testut

CITY OF LAS VEGAS

333 N. RANCHO DRIVE

LAS VEGAS, NEVADA 89106

PHONE: (702) 545-1606

FAX: (702) 545-2606

PROJECT LOCATION: LORENZI ST & CHARLESTON BLVD

SUB-CONTRACTOR: IES

ENTITY NOTES: 24 HOUR EMERGENCY # FOR IES: 702-217-5643

SHEET No: 1

Sheet 1 of 1

DISCLAIMER NOTE

UTILITY LOCATIONS SHOWN HEREON ARE APPROXIMATE ONLY. IT SHALL BE THE CONTRACTOR'S RESPONSIBILITY TO DETERMINE THE EXACT HORIZONTAL AND VERTICAL LOCATION OF ALL EXISTING UNDERGROUND AND OVERHEAD UTILITIES PRIOR TO COMMENCING CONSTRUCTION. NO REPRESENTATION IS MADE THAT ALL EXISTING UTILITIES ARE SHOWN HEREON. THE ENGINEER ASSUMES NO RESPONSIBILITY FOR UTILITIES NOT SHOWN OR UTILITIES NOT SHOWN IN THEIR PROPER LOCATIONS.

CALL BEFORE YOU DIG

811

BEFORE YOU DIG

OR 1-800-227-2600

UNDERGROUND SERVICE (USA)

AVOID CUTTING UNDERGROUND UTILITY LINES. IT'S COSTLY.

CALL BEFORE YOU OVERHEAD

1-702-227-2929

NEVADA POWER ENVIRONMENT AND SAFETY SERVICE DEPARTMENT

AVOID OVERHEAD POWER LINE CONTACT

TOTAL BORE 0'

TOTAL DIRT TRENCH 383'

TOTAL ASPHALT TRENCH 50'

TOTAL TRENCH 155'

SIDEWALK REMOVAL/REPAIR

TOTAL S/W PANELS 62

TOTAL LINEAR FOOTAGE 310'

L19-00639-R002 02/10/2020

TrueNet# 13857