

2920 BRADY AVE.

LOT 18 BLK 16 COLLEGE PARK 35 ZONE R-1

D. Gatewood 1-29-79

CITY OF LAS VEGAS, NEVADA

LOG NO. & AREA

DEPARTMENT OF BUILDING & SAFETY

APPLICATION & BUILDING PERMIT - for:

Dwellings, Duplexes, Misc. Residential Const.

CONST. VAL. \$1646000

ADDRESS OF CONSTRUCTION:

2920 Brady Avenue

OWNER:

College Park Development Co.

LOT(s)

9

BLOCK

15

SUBDIVISION

College Park 35

ZONE: R-1

Existing structure on lot:

Dwelling ☐

Accessory bldgs. ☐

Vacant lot ☒

Other ☐

PROPOSED CONSTRUCTION:

S.F.D.

USE: Dwelling

MATERIALS OF CONSTRUCTION:

Wood Frame ☒

Concrete Block ☐

Reinforced Concrete ☐

Steel Frame ☐

SQUARE FEET OF FLOOR AREAS:

1st 1150

2nd

3rd

Other

TOTAL SQ. FT.

FIRE ZONE:

1 263

Occupancy Group

A B C D E F G H I J

1-2-3-4-5

CONST. TYPE:

I II III IV V

ARCHITECT:

Eugene V. Conroy

ENGINEER:

VTN

NO. of UNITS

NO. of STORIES

1

Plans Submitted:

Yes ☐

No ☐

Calculations Submitted

Yes ☐

No ☐

Sewer Fee Req'd

Yes ☒

No ☐

CONTRACTOR:

Pardee Const. Co. of Nev.

STATE

LICENSE # 3633-A

CITY

LICENSE # 01155

ADD'L. PERMITS REQ'D:

Air Cond. ☒

Elec. ☒

Plumbing ☒

Signs ☐

Paving ☐

Fence ☐

Public Walks ☐

Curb-gutters ☐

Incinerators ☐

Fire Sprinkling System ☐

CONDITIONS OF THE PERMIT:

1. I agree to call the City Building Department for inspections before concrete is poured, before rough wiring, electrical, plumbing, framing is covered. Also for Air conditioning, sheet-rock and sheathing inspection.
2. I agree that when the job is completed that I will call for final inspection before occupancy.
3. I agree to perform all construction in accordance with City Ordinances and Building Codes.
4. The Contractor's signature below denotes authority from the owner to sign in his behalf and that the owner is aware of all requirements of this application and permit. Separate permits must be taken out for work outlined above this agreement.
5. I have read and understand the contents of this application and permit; I hereby state that the information I have supplied on this application is true and correct.

SIGNED: PARDEE CONSTRUCTION CO. OF NEV. Contractor

BY: Agent or Owner

CLARK COUNTY HEALTH DEPT.

LAS VEGAS FIRE DEPARTMENT

PLANNING DEPT:

Date:

PUBLIC WORKS DEPT:

Date:

BUILDING DEPT:

Date:

#12850

PERMIT NO:

54001

PERMIT FEE \$ 70.00

RECEIPT \$070.00 - 8

CITY OF LAS VEGAS
DEPT. OF
BUILDING & SAFETY

MUST BE MACHINE VALIDATED

W. Gatewood 1-29-79

CITY OF LAS VEGAS, NEVADA
DEPARTMENT OF BUILDING & SAFETY

**RECEIPT
FOR
SEWER CONNECTION FEE**

JOB ADDRESS: 2920 Brady Avenue OWNER'S NAME: College Park Development Co.

LOT 9 BLOCK 15 SUBDIVISION College Park 35

QUANTITY	OCCUPANCY	UNIT FEE	AMOUNT
1	S.F. Dwelling	150.00	150.00
TOTAL		150.00	
PAID BY: _____		Less Credit *	
		TOTAL FEE \$	150.00

* Credit for existing sewer is applied to the new sewer connection fee based on previous type of occupancy and only when the new occupancy requires an additional fee.
This receipt does not authorize the owner or his representative to start any work without obtaining a plumbing permit.

J. Wenz
DEPARTMENT OF BUILDING & SAFETY

7-6-70
DATE

73102

RECEIPT NO. 30812 SEWER FEE \$ 150.00

RECEIPT

6631 \$150.00 ÷ 3

CITY OF LAS VEGAS
DEPT. OF
BUILDING & SAFETY
MUST BE MACHINE VALIDATED

7 JUL 70

G. Gatewood 1-29-79

CITY OF LAS VEGAS, NEVADA
DEPARTMENT OF BUILDING & SAFETY - AIR CONDITIONING APPLICATION & PERMIT

ADDRESS OF CONSTRUCTION: 2920 Brady Ave.

OWNER'S NAME: Pardee Construction

CIRCLE: Addition: Remodel: New

TYPE OF BLDG: SFD APT. COMM. PUBLIC

CONTRACTOR'S NAME: Oasis Air Conditioning

STATE LICENSE 8454A

CITY LICENSE 10371

UNITS	DESCRIPTION	FEE	TOTAL	UNITS	DESCRIPTION	FEE	TOTAL
	Unit heater-floor, wall or suspended	4.00			EVAPORATIVE COOLERS:		
	FOR EACH FORCED-AIR OR GRAVITY-TYPE FURNACE OR BURNER INCLUDING DUCTS AND VENT ATTACHED TO SUCH APPLIANCES:				5 outlets or under	3.00	
	Up to and including 100,000 B.t.u.'s	4.00			Over 5 and up to and including 10	8.00	
	Over 100,000 B.t.u.'s	6.00			Each additional outlet over 10	.25	
	FOR EACH HEATING APPLICATION, REFRIGERATION UNIT, COMFORT COOLING AND HEATING UNIT, ABSORPTION UNIT, COMPRESSOR OR BOILER:				VENTILATION:		
	Up to and including 3 ton or horsepower, or absorption system up to and including 100,000 B.t.u.'s	4.00			For each fan connected to a single duct	1.00	
4T	Over 3 ton or 3 horsepower up to and including 10, or absorption system over 100,000 B.t.u.'s up to and including 250,000 B.t.u.'s	7.00	7.00		For each commercial or industrial ventilation system	5.00	
	Over 10 ton or 10 horsepower up to and including 30, or absorption system over 250,000 B.t.u.'s up to and including 1,000,000 B.t.u.'s	12.00			For each commercial kitchen hood	5.00	
	Over 30 ton or 30 horsepower up to and including 50, or absorption system over 1,000,000 B.t.u.'s up to and including 1,700,000 B.t.u.'s	20.00			MISCELLANEOUS:		
	Over 50 ton or 50 horsepower, or absorption system over 1,700,000 B.t.u.'s	30.00		10	For each water cooling tower	8.00	
	FOR EACH AIR HANDLING UNIT INCLUDING DUCTS ATTACHED THERETO:				Duct work only - each opening	.25	2.50
	Up to and including 10,000 CFM	2.00			For installation or relocation of each commercial or industrial incinerator	15.00	
	Over 10,000 CFM	4.00			Gas piping related to the air cond. work in single-family dwelling only	3.00	
					For each appliance, piece of equipment, any mechanical work or alteration, or replacement not included in this schedule, the permit fee shall be computed the same as building permit fees by using the cost of installation for the valuation amount.		
					FOR THE ISSUANCE OF EACH PERMIT	3.00	
					TOTAL PERMIT FEE \$	12.50	

I hereby certify that I have carefully examined and read the above application; that the same is true and correct; and that the work herein described is to be done in accordance with all the provisions of the applicable Ordinances of the City of Las Vegas, Nevada and the State Laws, whether herein specified or not.

SIGNED: Ruby Dutton
Air Conditioning Contractor - Owner

Date

7/20/70

BUILDING DEPARTMENT

Date

7-22-70

PERMIT NO.

29357

PERMIT FEE \$

12.50

RECEIPT

7516 \$012.50 - 4

CITY OF LAS VEGAS
DEPT. OF
BUILDING & SAFETY

MUST BE MACHINE VALIDATED

22 JUL 70

12890

D. Gatewood 1-29-79

CITY OF LAS VEGAS, NEVADA

B15 L9

DEPARTMENT OF BUILDING & SAFETY - APPLICATION AND PERMIT FOR PLUMBING

ADDRESS OF CONSTRUCTION: 2920 Brady Ave

OWNER'S NAME: Fardes Const. Co.

CIRCLE: (New Bldg); Add'n; Remodel; TYPE OF BLDG.: (SFD.) ART. PUBLIC COMM.

STATE LICENSE # 10472

CITY LICENSE # 6645

CONTRACTOR'S NAME: Kitzman's Plumbing

UNITS	DESCRIPTION	FEE	TOTAL
1	Bathtub	1.00	1.00
1	Shower	1.00	1.00
2	Lavatory	1.00	2.00
2	Toilet	1.00	2.00
	Uginal	1.00	
	Floor Drain	1.00	
	Floor Sink	1.00	
	Wash Tray	1.00	
1	Sink	1.00	1.00
1	Garbage Disposal	1.00	1.00
	Garbage Disposal (comm.)	3.00	
1	Clothes Dryer (gas)	1.00	1.00
1	Clothes Washer	1.00	1.00
	Clothes Washer (comm.)	5.00	
	Dishwasher	1.00	
	Dishwasher (commercial)	5.00	
	Dental Unit	10.00	
	Drinking Fountain	1.00	
1	Any Water using Equipment	1.00	1.00
1	Water Heater (gas) (elect.)	1.00	1.00
1	Sewer System - New, Replacement, or any Drainage System	4.00	4.00
	Grease or Sand Trap	2.00	
	Trailer Trap	2.00	
	Septic Disposal System	4.00	
WATER SOFTENERS			
	Nonpermanent Type	4.00	
	Permanent Type (connected to Drainage)	5.00	
SWIMMING POOLS			
	Private or Wading Pool	10.00	
	Public or Semi-public	20.00	

UNITS	DESCRIPTION	FEE	TOTAL
WATER DISTRIBUTION SYSTEM			
1	Single Family Dwelling	4.00	4.00
	Multiple Family Dwelling plus each unit	4.00	
		2.00	
	Bldg. Group "A" thru "G" per each floor	6.00	
	Hotel or Motel	4.00	
	plus each bath	1.50	
	Trailer Park	20.00	
	plus each space	1.00	
	Irrigation	4.00	
GAS PIPING SYSTEM			
1	Single Family Dwelling	3.00	3.00
	Multiple Family Dwelling plus each unit	6.00	
		1.00	
	Commercial Bldg. per floor plus each unit	3.00	
		3.00	
	Gas Appliance (any type)	1.00	
AUTOMATIC FIRE EXTINGUISHING SYSTEM			
	Underground Piping	10.00	
	Distribution Piping ea. ft.	.01	
	Sprinkler Head each	.10	
	In Range Hood and Vent	5.00	
DRY STANDPIPE SYSTEM			
	Piping	50.00	
	Each Outlet	1.00	
WET STANDPIPE SYSTEM			
	Piping	5.00	
	Fire Hose Cabinet	1.00	
	MINIMUM PERMIT FEE	4.00	
TOTAL PERMIT FEE \$			23.00

I hereby certify that I have carefully examined and read the above application; that the same is true and correct; and that the work herein described is to be done in accordance with all the provisions of the applicable Ordinances of the City of Las Vegas, Nevada and the State Laws, whether herein specified or not.

Signed Stanford E. Nestor Date: 7-15-70
REGISTERED MASTER PLUMBER, SPEC. CONT'R. OR OWNER

Building Department J. W. Wenzel Date: 7-28-70
#12870 Permit No. 31130 Permit Fee \$ 23.00

RECEIPT

7635 \$023.00 - 7

CITY OF LAS VEGAS
DEPT. OF
BUILDING & SAFETY

MUST BE MACHINE VALIDATED

29 JUL 70

G. Gatewood 1-29-79

CITY OF LAS VEGAS, NEVADA

LOG NO. & AREA

DEPARTMENT OF BUILDING & SAFETY

CONST. VAL. \$ 366.00

APPLICATION & BUILDING PERMIT - for
Fence, Wall, Retaining Wall.

ADDRESS OF
CONSTRUCTION:

2920 BRADY AVE

OWNER:

Pardue

LOT(s)

7

BLOCK

15

SUBDIVISION

College Park 35

ZONE

CL

Materials of Construction:

Block ☒

Concrete ☐

Wire ☐

Wood ☐

Other ☐

Yes

No

PLANS:

☐

☐

ARCHITECT:

ENGINEER:

CALCS:

☐

☐

CONTRACTOR:

McDonald Inc

STATE

LICENSE #

2045

CITY

LICENSE #


1161

TOTAL SQUARE FEET:

TOTAL LINEAL FEET:

61

Remarks:

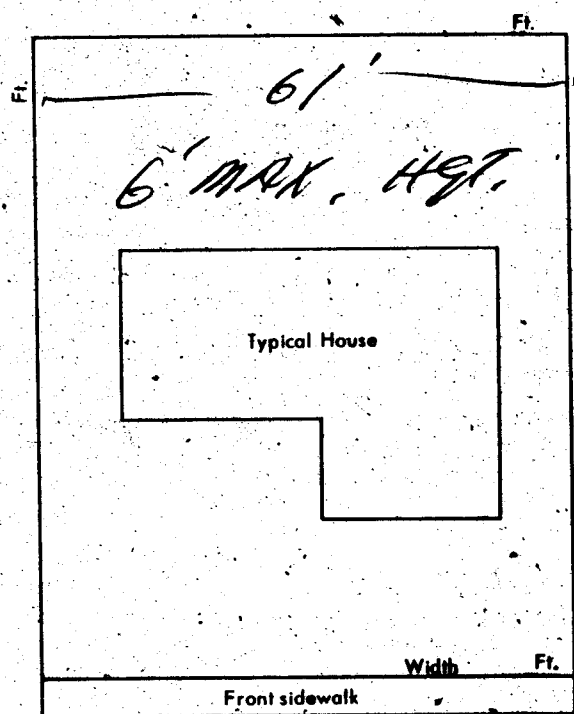

CONDITIONS OF THE PERMIT:

1. Any type of retaining wall must be engineered by a Civil or Structural Engineer.
2. If a home owner takes out the Building Permit and if the owner sublets the work to a Contractor, then the Contractor must take out the permit and pay for it.
3. No fence or wall can be built on City property or rights-of-way, but this is not intended to preclude construction within utility easements if utilities will not be damaged or made inaccessible.
4. The fence or wall shall not enclose any water meter, light standard, or fire alarm box and shall not come closer than 24" from the nearest fire hydrant outlet.
5. Department Inspectors must approve footings before concrete is poured and block wall reinforcing before grouting is done.
6. Maximum height of any wall or fence is 6', side and rear yards; 4' maximum in front yard with the vertical surface above the height of 2' --- 50% open.
7. I must not obstruct required onsite parking space (1 space for each dwelling unit) by the erection of this fence or wall.
8. By the signing of this application I herewith agree to the requirements outlined above.

SIGNED:

John McDonald

DATE:

CONTRACTOR ☐

AGENT ☐

OWNER ☐

PLANNING DEPT.:

R. H. W.

Date:

9/24/70

PUBLIC WORKS DEPT.:

Date:

BUILDING DEPT.:

J. W. H.

Date:

9-30-70

#12850

PERMIT NO.:

55061

PERMIT FEE \$

6.00

RECEIPT

299 \$006.00 - 8

CITY OF LAS VEGAS
DEPT. OF
BUILDING & SAFETY

MUST BE MACHINE VALIDATED

30 SEP 70

D. Gatewood 1-29-79

CITY OF LAS VEGAS, NEVADA

DEPARTMENT OF BUILDING & SAFETY - ELECTRICAL APPLICATION & PERMIT

ADDRESS OF CONSTRUCTION: 2920 Brady Ave., L. V. Nev.

OWNER'S NAME: Fardee Construction Co., of Nevada
College Park No. 35

CIRCLE: New Bldg.; Add.; Remodel; TYPE OF BLDG.: SFD. APT. PUBLC - COMM.

CONTRACTOR'S NAME: Sparks Electric Co., Inc.

STATE LICENSE # 5191A

CITY LICENSE # 04851

NUMBER	FIXTURE OR INSTALLATION	UNIT PRICE	
10	Fixture or sockets	.15	1.50
45	Light, receptacle or switch outlet	.20	9.00
	Wall or ceiling space heater	.36	
	Blast coil heater per kilowatt	.85	
1	Garbage grinder outlet	.35	.35
	Dishwasher outlet	.35	
	Clothes dryer outlet	.35	
1	Automatic clothes washer	.35	.35
	Electric range outlet	.35	
	Electric water heater outlet	.35	
	Mercury arc lamp and equipment	.35	
	Special purpose outlet	.35	
	X-ray unit and its appurtenances	5.00	
	Watts of festoon lighting (Watts) First 3,000 watts	4.00	
	for each additional thousand watts	1.50	
1	Horsepower - all motors first horsepower or less	1.75	1.75
2	for each additional horsepower	.35	.70
	Temporary power and lights (temporary pole)	4.00	
1	Electric service (including any single meter socket)	3.00	3.00
	for each additional socket	.35	
	Air conditioning service amps	1.50	
	Each KW (KVA) Generator (Transformer) (Welder) KW (KVA)	2.00	
	First 100 KVA - For each additional KW (KVA)	.01	
	Special inspection per hour	4.00	
	Speaker outlets	.15	
	Signal or Alarm outlets	.15	
	Amplifiers	.50	
	Control panels	.25	
	T. V. outlets - master system only	.15	
	Radio outlets	.15	
	Main control racks	1.00	
	T. V. and Radio antennas - master system only	.75	
	Minimum fee for any permit	4.00	
	Total fee		16.65

I hereby certify that I have carefully examined and read the above application; that the same is true and correct; and that the work herein described is to be done in accordance with all the provisions of the applicable Ordinances of the City of Las Vegas, Nevada and State laws whether herein specified or not.

SIGNED [Signature] DATE 10-7-70
MASTER (ELECTRICIAN) (TECHNICIAN) (OWNER)

BUILDING DEPARTMENT [Signature] DATE 10-7-70

*12860

PERMIT NO.

32109

PERMIT FEE: \$

16.65

RECEIPT

424 \$016.65 - 6

CITY OF LAS VEGAS

DEPT. OF
BUILDING & SAFETY

- 2 OCT 30

G. Gatewood 1-29-79

CITY OF LAS VEGAS, NEVADA

LOG NO. & AREA
DEPARTMENT OF BUILDING & SAFETY

CONST. VAL. \$ 600.

APPLICATION & BUILDING PERMIT — for:
Fence, Wall, Retaining Wall.

ADDRESS OF CONSTRUCTION: 2920 Brady Ave. N.W. OWNER: John C. Carson

LOT(s) 9 BLOCK 15 SUBDIVISION Collier Park No 30 ZONE: R-1

Materials of Construction: Block ☒ Concrete ☐ Wire ☐ Wood ☐ Other ☐ PLANS: ☐ Yes ☒ No

ARCHITECT: ENGINEER: CALCS: ☐ Yes ☐ No


CONTRACTOR: owner STATE LICENSE # CITY LICENSE #

TOTAL SQUARE FEET: TOTAL LINEAL FEET:

Remarks:

CONDITIONS OF THE PERMIT:

1. Any type of retaining wall must be engineered by a Civil or Structural Engineer.
2. If a home owner takes out the Building Permit and if the owner sublets the work to a Contractor, then the Contractor must take out the permit and pay for it.
3. No fence or wall can be built on City property or rights-of-way, but this is not intended to preclude construction within utility easements if utilities will not be damaged or made inaccessible.
4. The fence or wall shall not enclose any water meter, light standard, or fire alarm box and shall not come closer than 24" from the nearest fire hydrant outlet.
5. Department Inspectors must approve footings before concrete is poured and block wall reinforcing before grouting is done.
6. Maximum height of any wall or fence is 6', side and rear yards; 4' maximum in front yard with the vertical surface above the height of 2' — 50% open.
7. I must not obstruct required onsite parking space (2 spaces for each dwelling unit) by the erection of this fence or wall.
8. By the signing of this application I herewith agree to the requirements outlined above.

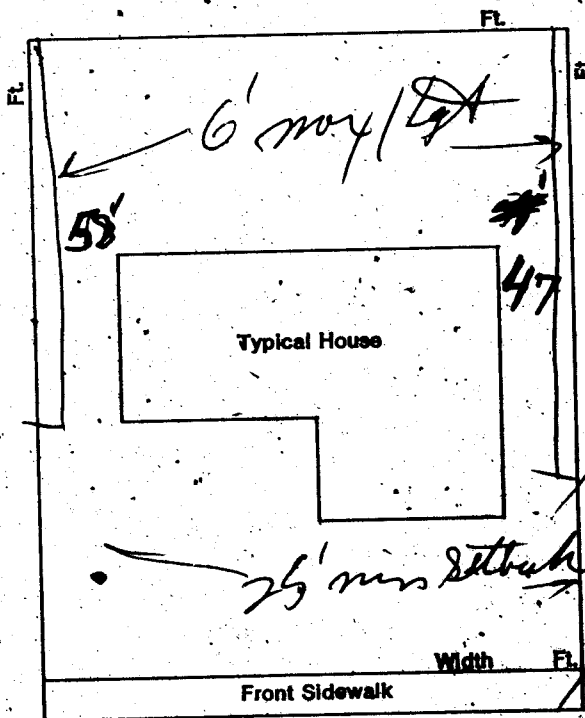

SIGNED: John C. Carson DATE: 4-12-73

CONTRACTOR ☒ AGENT ☐ OWNER ☒

PLANNING DEPT:

Date: 4-12-73

PUBLIC WORKS DEPT:

Date:

BUILDING DEPT:

Date: 4-12-73

#12850

PERMIT NO: 10617

PERMIT FEE \$ 800

RECEIPT

4382 \$008.00 - 8

CITY OF LAS VEGAS
DEPT. OF
BUILDING & SAFETY

MUST BE MACHINE VALIDATED

13 APR 73

9. Dated January 18, 1980

CITY OF LAS VEGAS, NEVADA

LOG NO. & AREA

CONST. VAL. \$

300.00

DEPARTMENT OF PUBLIC SERVICES
DIVISION OF BUILDING & SAFETY

APPLICATION & BUILDING PERMIT - for:
Fence, Wall, Retaining Wall.

ADDRESS OF
CONSTRUCTION:

2920 Brady Ave.

OWNER:

Dim Sha

LOT(s)

9

BLOCK

15

SUBDIVISION

College Park #35

ZONE

R-1

Materials of Construction:

Block

Concrete

Wire

Wood

Other

Yes

No

PLANS:

Yes

No

CALCS:

Yes

No

ARCHITECT:

ENGINEER:

CONTRACTOR:

Owner

STATE
LICENSE #

CITY

LICENSE #


TOTAL SQUARE FEET:

TOTAL LINEAL FEET:

Remarks:

CONDITIONS OF THE PERMIT:

1. Any type of retaining wall must be engineered by a Civil or Structural Engineer.
2. If a home owner takes out the Building Permit and if the owner sublets the work to a Contractor, then the Contractor must take out the permit and pay for it.
3. No fence or wall can be built on City property or rights-of-way, but this is not intended to preclude construction within utility easements if utilities will not be damaged or made inaccessible.
4. The fence or wall shall not enclose any water meter, light standard, or fire alarm box and shall not come closer than 24" from the nearest fire hydrant outlet.
5. Department Inspectors must approve footings before concrete is poured and block wall reinforcing before grouting is done.
6. Maximum height of any wall or fence is 6', side and rear yards; 4' maximum in front yard with the vertical surface above the height of 2' - 50% open.
7. I must not obstruct required onsite parking space (2 spaces for each dwelling unit) by the erection of this fence or wall.
8. By the signing of this application I herewith agree to the requirements outlined above.

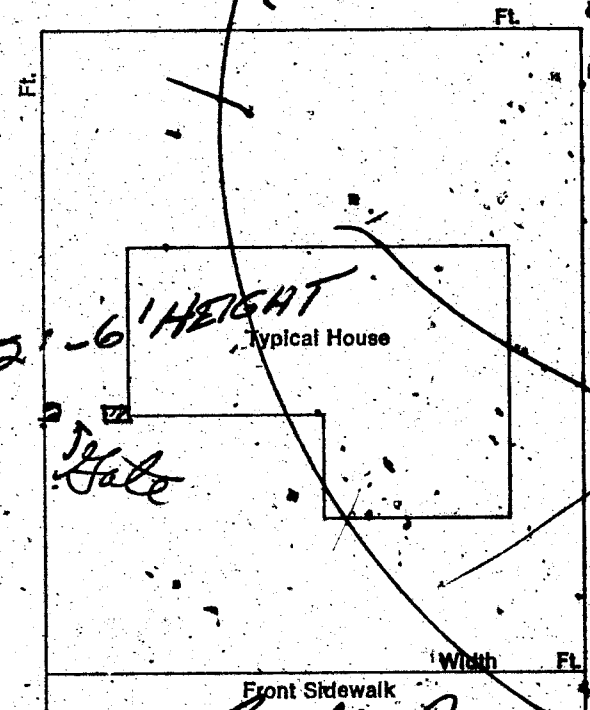

2920 Brady Ave

SIGNED:

CONTRACTOR

AGE

OWNER

DATE:

PLANNING DEPT:

J. R. Brown

Date:

1/15/80

PUBLIC WORKS DEPT:

TURK

Date:

1/15/80

BUILDING DIVISION:

Long

Date:

1/15/80

#12850

PERMIT NO:

9541

PERMIT FEE \$

500

RECEIPT

TOTAL \$ 500.00
CITY OF LAS VEGAS
DIVISION OF BUILDING & SAFETY

MUST BE MACHINE VALIDATED

Angela L. Jackson 2/20/80

FENCE & RETAINING WALLS			
OWNER <i>Disha</i>		DATE <i>1-15-80</i>	
ADDRESS <i>2920 Brady Ave.</i>			
CONTRACTOR <i>Other</i>		PERMIT NO. <i>9541</i>	FINAL INSPECTION
LOT <i>9</i>	BLOCK <i>15 College Park</i>	SUBDIVISION <i>#35</i>	
LOG		AREA	
FENCES (wire, wood, block, & retaining walls)			
1	Location <i>MU 323-80</i>		
2	Footing		
3	Wall Steel		
	1st	2nd	
4	Bond Beam		
	1st	2nd	
5	Final		
<i>M 7-4-21-80</i>			
Specify Type Of Fence			
75-11			

Angela L. Jackson 2/20/80

DEPARTMENT OF BUILDING & SAFETY
CITY OF LAS VEGAS, NEVADA

KARDEX CARD
FENCE & RETAINING WALLS

OWNER Pardee ADDRESS 2920 Brady Ave DATE 9-30-70

CONTRACTOR McDonald Inc. PERMIT NO. 55061

LOT 9 BLOCK k5 SUBDIVISION College Park 35 block fence

Fence (wire, wood, etc.)	Walls (masonry, rock, etc.)
Location _____	Location _____
Final Inspection _____	Footings _____
	Wall Steel 1st <u>10-17-70</u> 2d _____ 3d _____
	Final Inspection <u>10-17-70</u>

Retaining Wall (masonry)	Retaining Wall (concrete)
Location <u>10-18-70</u>	Location _____
Footings <u>10-18-70</u>	Footings _____
Wall Steel 1st _____ 2d _____ 3d _____	Wall Steel 1st _____ 2d _____ 3d _____
Bond Beam 1st _____ 2d _____ 3d _____	Final Inspection _____
Final Inspection _____	

23.14 B ADDRESS _____ LOG NO. _____ AREA _____

2920 Brady Ave

DEPARTMENT OF BUILDING & SAFETY
CITY OF LAS VEGAS, NEVADA

KARDEX CARD
FENCE & RETAINING WALLS

OWNER John C. Carson ADDRESS 2920 Brady Ave. DATE 4-12-73

CONTRACTOR Owner PERMIT NO. 10617

LOT 9 BLOCK 15 SUBDIVISION College Park # 30 block fence

Fence (wire, wood, etc.)	Walls (masonry, rock, etc.)
Location _____	Location <u>SCS-17-73</u>
Final Inspection _____	Footings <u>SCS-17-73</u>
	Wall Steel 1st <u>SCS-17-73</u> 2d _____ 3d _____
	Final Inspection <u>SCS-17-73</u>

Retaining Wall (masonry)	Retaining Wall (concrete)
Location _____	Location _____
Footings _____	Footings _____
Wall Steel 1st _____ 2d _____ 3d _____	Wall Steel 1st _____ 2d _____ 3d _____
Bond Beam 1st _____ 2d _____ 3d _____	Final Inspection _____
Final Inspection _____	

23.14 B ADDRESS _____ LOG NO. _____ AREA _____

2920 Brady Ave

Rigide L. Jackson 2/20/80

DEPT. of BLDG & SAFETY—CITY of LAS VEGAS, NEVADA		DATE 7/7/70
OWNER College Park Dev. Co.	ADDRESS 2920 Brady	
GEN CONT. 54001	Pardee Const.	TYPE OF STRUCTURE s.f.d.
PERMIT NO.	LEGAL DESCRIPTION Lot 9-BLK 15, College Park 35	
BUILDING		MECHANICAL
LOCATION 2920 Brady	PLUMBING CONT. 31135	TEMP. POLE CONT.
FIREPLACE FTO.	PERMIT NO. 31135	PERMIT NO.
FOOTINGS 10/14/70	HEAT & VENT. AC CONT. 29357	INSPECTION DATE
FOUNDATION WALL 10/8/70	PERMIT NO. 29357	ELECTRICAL CONT. 321091
FLOOR FRAMING 10/8/70	SEWER CONT. College Park Dev. Co.	PERMIT NO. 321091
SLAB 10/8/70	PERMIT NO. 30817	DATE 10-7-70
CHIMNEY STEEL (FIREPLACE)	ROUGH SOIL 10/23/70	FIXTURES CONT.
URBAN REDEVELOPMENT APPROVAL		
FINAL BLDG. DATE		

APPROVED FOR OCCUPANCY & METER *10/23/70* INSPECTOR DATE *10/23/70*
PLEASE NOTE REMARKS ON REVERSE SIDE 2920 Brady LOG # T-14 AREA # 2 23 04