

2528 Las Verdes St

L10 B6 Las Verdes Hts 6 Unit 1 Zone R-1

G. Gatewood 9-24-79

CITY OF LAS VEGAS, NEVADA  
DEPARTMENT OF BUILDING AND SAFETY  
APPLICATION FOR FENCE, WALL OR  
RETAINING WALL


LOG NO. 1986  
AREA: \_\_\_\_\_  
KARDEX CARD: \_\_\_\_\_  
TELEPHONE: \_\_\_\_\_  
CONSTRUCTION VALUATION: 30.00  
INSPECTION VALUATION: 24.00  
PERMIT FEE: 3.00  
PERMIT NUMBER: 33415  
DATE: 4/18 19 66

ADDRESS OF CONSTRUCTION: 2528 Las Vegas OWNER'S NAME: CLARENCE PARSDALE OWNER'S ADDRESS: 2528 LAS VEGAS  
Lot (s) 10 Block 6 Subdivision Las Vegas Hts 6 Unit 1 Zone: R1  
Materials of Concrete Construction: Block ( ) Concrete ( ) Wire ( ) Wood (  ) Other ( )

Total Square Feet: \_\_\_\_\_ Total Lineal Feet: 24 FT  
CONTRACTOR'S NAME: CLARENCE PARSDALE STATE LICENSE # \_\_\_\_\_ CITY LICENSE # \_\_\_\_\_

Architect's Name: \_\_\_\_\_ PLANS SUBMITTED: Yes  No \_\_\_\_\_  
Engineer's Name: \_\_\_\_\_ CALCULATIONS: Yes \_\_\_\_\_ No \_\_\_\_\_

Street Name: \_\_\_\_\_  
Front Yard: \_\_\_\_\_ Feet

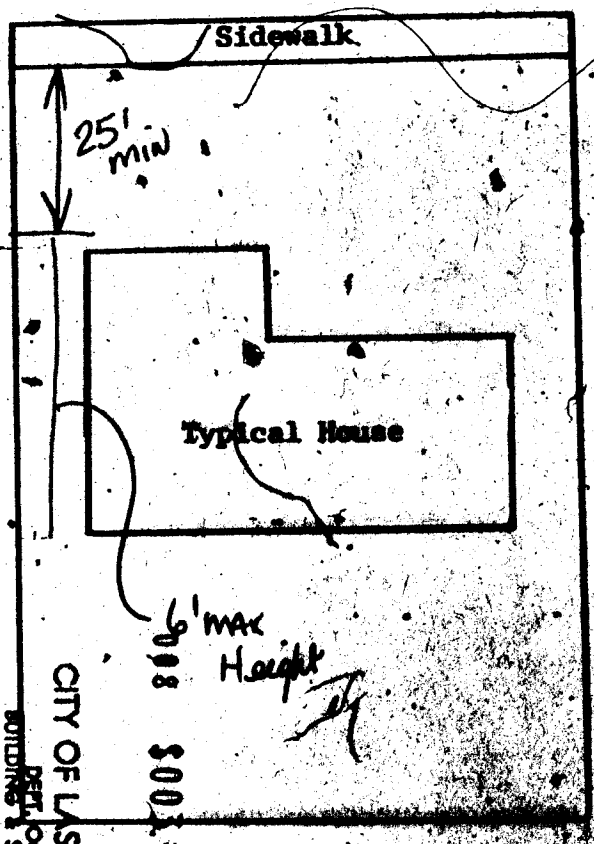

I understand that any portion of this (fence) (wall) constructed or erected on City property or right-of-way will be removed from said location at my expense upon request received from the City of Las Vegas, Nevada. I understand that the (fence) (wall) shall not enclose water meter, light standard, fire alarm box and shall not come closer than two (2') feet in any direction from any fire hydrant. I further state that I am familiar with effective Ordinances of the City of Las Vegas, Nev. and effective Statutes of the State of Nevada covering construction and use of above type; I agree to perform said construction in conformity therewith. I further agree that issuance of a permit on above application will not excuse me from conforming with said Ordinances and Statutes, despite any errors on the part of the Building Inspector or Engineer in checking plans and applications herewith submitted.

I have read and understand the contents of above application; I hereby state that same are true and correct.

SIGN HERE: Mr Clarence Parsdale  
By: \_\_\_\_\_

APPROVED BY: [Signature] DATE: 4-18-66  
PLANNING DEPT. & CODE ASSISTANCE  
FIRE DEPARTMENT DATE: \_\_\_\_\_  
ENGINEERING DEPT. DATE: \_\_\_\_\_  
BUILDING & SAFETY DEPT. DATE: \_\_\_\_\_

Read \_\_\_\_\_ Feet  
Note: \_\_\_\_\_ call for all inspections required.

Donat Dealy

2-20-82

DEPARTMENT OF BUILDINGS & SAFETY  
CITY OF LAS VEGAS, NEVADA

KARDEX CARD  
FENCE & RETAINING  
WALLS

OWNER Clarence Baggett

DATE 4/18/66

CONTRACTOR Owner

PERMIT NO. 33415

LOT 10 BLOCK 6 SUBDIVISION Las Verdes Hts. & Unit 1  
Wood fence

Fence (wire, wood, etc.)		Walls (masonry, rock, etc.)	
Location _____		Location _____	
Final Inspection <u>4-25-66</u>		Footings _____	
_____		Wall Steel 1st _____ 2d _____ 3d _____	
_____		Final Inspection _____	
Retaining Wall (masonry)		Retaining Wall (concrete)	
Location _____		Location _____	
Footings _____		Footings _____	
Wall Steel 1st _____ 2d _____ 3d _____		Wall Steel 1st _____ 2d _____ 3d _____	
Bond Beam 1st _____ 2d _____ 3d _____		Final Inspection _____	
Final Inspection _____		_____	

23714 B ADDRESS 2528 Las Verdes LOG NO. \_\_\_\_\_ AREA \_\_\_\_\_

777

DEPT. of BLDG & SAFETY—CITY of LAS VEGAS, NEVADA

OWNER MIRANTI INVESTMENT CO. ADDRESS 2528 Las Verdes St. DATE 6-21-62  
 GEN CON Miranti Const. Co. TYPE OF STRUCTURE S.F. Dwl.  
 PERMIT NO. 10834 LEGAL DESCRIPTION Lot 10, Block 6 Las Verdes #6 Unit #1

BUILDING	MECHANICAL	ELECTRICAL
LOCATION <u>2528 Las Verdes</u>	PLUMBING CONT. <u>General</u>	TEMP. POLE CONT. _____
FIREPLACE FTG. _____	PERMIT NO. <u>8109</u> DATE <u>12-13-61</u>	PERMIT NO. _____ DATE _____
FOOTINGS <u>7-16-62</u>	HEAT & VENT. AC CONT. <u>General</u>	INSPECTION _____ DATE _____
FOUNDATION WALL _____	PERMIT NO. <u>4330</u> DATE <u>2-6-62</u>	ELECTRICAL CONT. <u>General</u>
STEM WALL <u>1-11-62</u>	SEWER CONT. _____	PERMIT NO. <u>1403</u> DATE _____
FLOOR FRAMING _____	PERMIT NO. _____ DATE _____	FIXTURES CONT. <u>General</u>
SLAB <u>8-31-62</u>	ROUGH SOIL <u>General</u>	PERMIT NO. <u>1403</u> DATE <u>1-1-62</u>
CHIMNEY STEEL (FIREPLACE) _____	ROUGH WATER _____	SLAB _____
WALL STEEL <u>9-18-62</u>	TOP-OUT <u>10-29-61</u>	ROUGH <u>Miller 2-24-62</u>
COLUMN STEEL _____	ROUGH GAS <u>10-29-61</u>	FINAL ROUGH _____
BEAM STEEL _____	AC ROUGH DUCT <u>10-10-62</u>	FINAL FIXTURE _____
STEEL FABRICATION <u>10-20-62</u>	REF. ROUGH PIPING _____	TEMPORARY SERVICE _____
FRAMING <u>10-29-62</u>	FINAL PLUMBING <u>9-26-63</u>	MISCELLANEOUS
ROOF SHEATHING <u>11-22-62</u>	FINAL GAS _____	URBAN REDEVELOPMENT APPROVAL _____
INTERIOR _____	FINAL AIR COND. <u>9-26-63</u>	<input type="checkbox"/>
EXTERIOR _____	FINAL BEFRIG. <u>1-9-62</u>	GRADING & DRAINAGE _____
DRYWALL _____	FINAL SEWER <u>1-9-62</u>	ON-SITE PARKING SPACES _____ APP. _____
LATHING _____	FINAL SEPTIC TANK _____	ENG APPROVAL OF _____
BACKING (SHIMS) _____		OFF-SITE IMPROVEMENTS _____
PLASTER SCRATCH _____		DATE _____
FINAL BLDG <u>Subert</u> DATE <u>2-18-63</u>		

APPROVED FOR OCCUPANCY Subert 2-18-63 INSPECTOR \_\_\_\_\_  
 APPROVED FOR METER Miller 2-18-63 LOG # \_\_\_\_\_ AREA # \_\_\_\_\_ 2304

PLEASE NOTE REMARKS ON REVERSE SIDE

2528 Las Verdes St. T-32 4