

. 2400 LLEWELYN .

1 S. Collins 2-24-82

3-02 1-084
CITY OF LAS VEGAS, NEVADA

LOG NO. & AREA

DEPARTMENT OF BUILDING AND SAFETY

CONST. VAL. \$

500.00

APPLICATION & BUILDING PERMIT - for:
Fence, Wall, Retaining Wall.

ADDRESS OF
CONSTRUCTION:

2400 Lincoln

OWNER

E. Kaye

LOT(s)

3

BLOCK

SUBDIVISION

McNeil Park

ZONE

R-1

Materials of Construction

Block ☒

Concrete ☐

Wire ☐

Wood ☐

Other ☐

Yes ☐

No ☒

ARCHITECT:

ENGINEER:

PLANS:

☐

CALCS:

☐

CONTRACTOR:

Las Vegas Concrete

STATE

6887

CITY

LICENSE #

011-3939


Remarks:

TOTAL SQUARE FEET:

TOTAL LINEAL FEET:

CONDITIONS OF THE PERMIT:

1. Any type of retaining wall must be engineered by a Civil or Structural Engineer.
2. If a home owner takes out the Building Permit and the owner sublets the work to a Contractor, then the Contractor must take out the permit and pay for it.
3. No fence or wall can be built on City property or rights-of-way, but this is not intended to preclude construction within utility easements if utilities will not be damaged or made inaccessible.
4. The fence or wall shall not enclose any water meter, light standard, or fire alarm box and shall not come closer than 24" from the nearest fire hydrant outlet.
5. Department Inspectors must approve footings before concrete is poured and block wall reinforcing before grouting is done.
6. Maximum height of any wall or fence is 6' side and rear yards; 4' maximum in front yard with the vertical surface above the height of 2' 60% open.
7. I must not obstruct required onsite parking space (2 spaces for each dwelling unit) by the erection of this fence or wall.
8. By the signing of this application I herewith agree to the requirements outlined above.

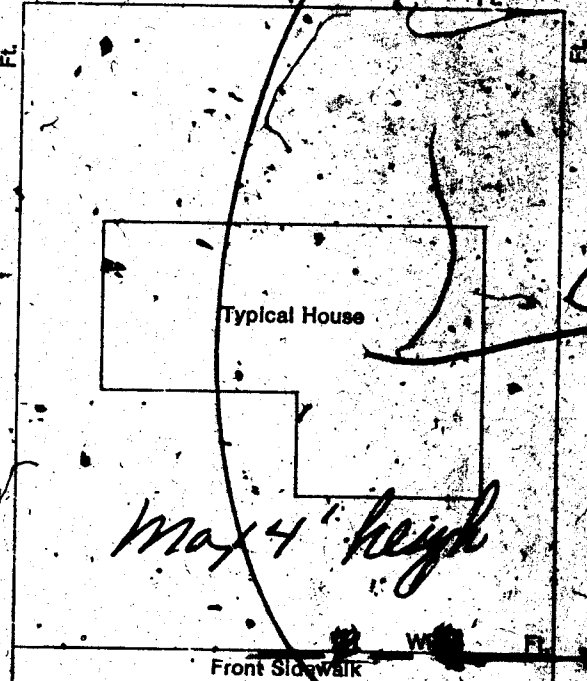

1 TON \$.00

WALL \$ 20.00

STL \$ 20.00

TOTL \$ 20.00

CHEK \$ 20.00

01118 SR#001/01

CITY - LAS VEGAS

DEPT. & SAFETY

02/22/82

SIGNED

CONTRACTOR ☐

AGENT ☐

OWNER ☒

PLANNING DEPT:

Date:

2/22/82

PUBLIC WORKS DEPT:

Date:

2/22/82

BUILDING DIVISION:

Date:

2/22/82

PERMIT NO:

8118

PERMIT FEE:

20.00

1721-2401

MUST BE MACHINE VALIDATED

1/ Collins 2-24-82

3-02 1-054
CITY OF LAS VEGAS, NEVADA

LOG NO. & AREA

DEPARTMENT OF BUILDING AND SAFETY

CONST. VAL. \$ 500.00

APPLICATION FOR BUILDING PERMIT - for:
Fence, Wall, Retaining Wall.

ADDRESS OF
CONSTRUCTION:

2400 Lincoln

OWNER

Kay

LOT(s)

3

BLOCK

SUBDIVISION

McNeil Park

ZONE

Materials of Construction

Block

Concrete

Wire

Wood

Other

PLANS

ARCHITECT

ENGINEER

CALCS

CONTRACTOR

Las Vegas Concrete

STATE

6887

CITY

LICENSE

011-3939


Remarks:

TOTAL SQUARE FEET

TOTAL LINEAL FEET

CONDITIONS OF THE PERMIT:

1. Any type of retaining wall must be engineered by a Civil or Structural Engineer.
2. If a home owner takes out the Building Permit and if the owner sublets the work to a Contractor, then the Contractor must take out the permit and pay for it.
3. No fence or wall can be built on City property or rights-of-way, but this is not intended to preclude construction within utility easements if utilities will not be damaged or made inaccessible.
4. The fence or wall shall not enclose any water meter, light standard, or fire alarm box and shall not come closer than 24" from the nearest fire hydrant outlet.
5. Department inspectors must approve footings before concrete is poured and block wall reinforcing before grouting is done.
6. Maximum height of any wall or fence is 6' side and rear yards; 4' maximum in front yard with the vertical surface above the height of 2' - 60% open.
7. I must not obstruct required on-site parking space (2 spaces for each dwelling unit) by the erection of this fence or wall.
8. By the signing of this application I herewith agree to the requirements outlined above.

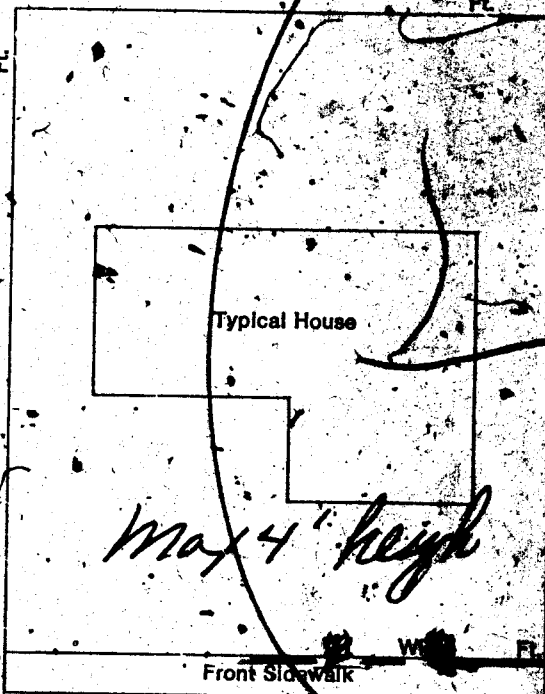

1 TON \$.00

WALL \$ 20.00

STL \$ 20.00

TOTL \$ 20.00

CHEK \$ 20.00

008118 SR#001/02

CITY - LAS VEGAS

DEPT. OF BUILDING & SAFETY

02/22/82

SIGNED

CONTRACTOR

AGENT

PLANNING DEPT:

PUBLIC WORKS DEPT:

BUILDING DIVISION:

PERMIT NO.

8118

PERMIT FEE

20.00

RECEIPT

Doug Hrealy

8-19-82

STOP WORK ORDER

PLACED ON JOB AT:

2400 Hurllyn

CONTRACTOR/OWNER:

DATE

2-16-82

TIME

11:35 AM

REASON

no permit - masonry pier in front - illegal height - 4' max

INSPECTOR

Rich Bailey

