

85.12 Log Cabin Way

$S\frac{1}{2}$ $SW\frac{1}{4}$ $SE\frac{1}{4}$ $NE\frac{1}{4}$ SEC 5 T19S R60E Zone R-E

MUST BE MACHINE REPRODUCED

Y. Watson 10-5-79

CITY OF LAS VEGAS, NEVADA

LOG NO. & AREA R-33-8
DEPARTMENT OF BUILDING & SAFETY

CONST. VAL. \$ 18169

APPLICATION & BUILDING PERMIT — for:
Dwellings, Duplexes, Misc. Residential Const.

ADDRESS OF CONSTRUCTION: 8512 LOG CABINWAY

OWNER: ANTHONY THOMPSON

LOT(s) 9 1/4, 9 1/4, 9 1/4, NE 1/4, NW 1/4, T19S, R26E

ZONE: R-1

Existing structure on lot: Dwelling ☐ Accessory bldg. ☐ Vacant lot ☒ Other ☐

PROPOSED CONSTRUCTION: S.F.D.

USE: U.F.D.

MATERIALS OF CONSTRUCTION: Wood Frame ☒ Concrete Block ☐ Reinforced Concrete ☐ Steel Frame ☐

SQ. FEET OF FLOOR AREAS: 1st 11 2nd Auto 200 3rd Covered Porch 81 TOTAL SQ. FT. 291

FIRE ZONE: 1 3 Occupancy Group 1 J 1 - 2

CONST. TYPE I II III IV V

ARCHITECT: _____ ENGINEER: _____ NO. of UNITS _____ NO. of STORIES _____

Plans Submitted: Yes ☐ No ☐ Calculations Submitted: Yes ☐ No ☐ Septic Fee Req'd. Yes ☐ No ☒

CONTRACTOR: Security Housing STATE LICENSE # 5863

CITY LICENSE # 9865

ADD'L. PERMITS REQ'D: Air Cond. ☒ Elec. ☒ Plumbing ☒ Signs ☐ Paving ☐ Fence ☐ Public Walks ☐ Curb-gutters ☐
Incinerators ☐ Fire Sprinkling System ☐

CONDITIONS OF THE PERMIT:

- I agree to call the City Building Department for inspections before concrete is poured, before rough wiring, electrical, plumbing, framing is covered. Also for air conditioning, sheet-rock and sheathing inspection.
- I agree that when the job is completed that I will call for final inspection before occupancy.
- I agree to perform all construction in accordance with City Ordinances and Building Codes.
- The Contractor's signature below denotes authority from the owner to sign in his behalf and that the owner is aware of all requirements of this application and permit. Separate permits must be taken out for work outlined above this agreement.
- I have read and understand the contents of this application and permit; I hereby state that the information I have supplied on this application is true and correct.

Approval for the work under this permit will be given only after relief and debris have been removed from job site and public right of way.

SIGNED: Anthony Thompson Contractor

BY: _____ Agent or Owner

CLARK COUNTY HEALTH DEPT. _____ Date _____

LAS VEGAS FIRE DEPARTMENT _____ Date _____

PLANNING DEPT.: [Signature] Date: 2/11/79

PUBLIC WORKS DEPT.: [Signature] Date: 3-12

BUILDING DEPT.: [Signature] Date: 3/19/79

12850

PERMIT NO.: 15308 PERMIT FEE \$ 117.00

RECEIPT

MUST BE MACHINE VALIDATED

U. Saturday 10-5-79

CITY OF LAS VEGAS, NEVADA

LOG NO. & AREA

DEPARTMENT OF BUILDING & SAFETY

CONST. VAL. \$

APPLICATION & BUILDING PERMIT — for:

Dwellings, Duplexes, Misc. Residential Const.

ADDRESS OF CONSTRUCTION:

8512 LOG CABINWAY

OWNER: ANTHONY THOMPSON

LOT (s)

4 1/4, 9 1/4, 9 1/4, NE 1/4, NW 1/4, 1199, 1260 E.

ZONE: R-2

Existing structure on lot: Dwelling

☐

Accessory bldgs.

☐

Vacant lot

☒

Other

☐

PROPOSED CONSTRUCTION:

S.F.D.

USE:

4.F.D.

MATERIALS OF CONSTRUCTION:

Wood Frame

☒

Concrete Block

☐

Reinforced Concrete

☐

Steel Frame

☐

SQ. FEET OF FLOOR AREAS:

1st

11

2nd

Ratio 2nd

3rd

Covered porch 81

Other

TOTAL SQ. FT.

FIRE ZONE: 1

3

Occupancy Group

1

J

1 - 2

CONST. TYPE

I

II

III

IV

V

ARCHITECT:

ENGINEER:

NO. of UNITS

NO. of STORIES

Plans Submitted:

Yes

☐

No

☐

Calculations Submitted

Yes

☐

No

☐

Septic Fee Req'd.

Yes

☐

No

☐

CONTRACTOR:

Security Housing

STATE LICENSE

5863

CITY LICENSE

9865

ADD'L. PERMITS REQ'D:

Air Cond.

☒

Incinerators

☐

Elec.

☒

Plumbing

☒

Signs

☐

Paving

☐

Fence

☐

Public Walks

☐

Curb-gutters

☐

☐

Fire Sprinkling System

☐

CONDITIONS OF THE PERMIT:

1. I agree to call the City Building Department, for inspections before concrete is poured, before rough wiring, electrical, plumbing, framing is covered. Also for air conditioning, sheet-rock and sheathing inspection.
2. I agree that when the job is completed that I will call for final inspection before occupancy.
3. I agree to perform all construction in accordance with City Ordinances and Building Codes.
4. The Contractor's signature below denotes authority from the owner to sign in his behalf and that the owner is aware of all requirements of this application and permit. Separate permits must be taken out for work outlined above this agreement.
5. I have read and understand the contents of this application and permit; I hereby state that the information I have supplied on this application is true and correct.

Approval for the work under this permit will be given only after rebar and debris have been removed from job site and public right of way.

SIGNED: Fred Anderson Contractor

BY: Agent or Owner

CLARK COUNTY HEALTH DEPT.

Date

LAS VEGAS FIRE DEPARTMENT

Date

PLANNING DEPT.:

Date:

2/11/74

PUBLIC WORKS DEPT.:

Date:

3-12

BUILDING DEPT.:

Date:

3/19/74

12850

PERMIT NO.:

15308

PERMIT FEE \$

117.00

RECEIPT

MUST BE MACHINE VALIDATED

Y. Gatewood 10-5-79

Sewer Is Available

52813 CITY OF LV - NO FEE

DISTRICT HEALTH DEPARTMENT
Las Vegas, Nevada
PLOT PLAN FOR INDIVIDUAL SEWAGE DISPOSAL SYSTEM

NAME THOMPSON, Anthony

Date 2/22/74

ADDRESS OF INSTALLATION

Log Cabin Way

Subdivision

Lot Number

Size of Lot

170' x 313'

Size of Septic Tank 1200 gals.

Size of Leaching Area 935 sq. ft.


Contractor Andrews

Indicate of Plan - Property lines, Water Wells, buildings, swimming pools, trees, ditches, water lines.

In the space below, please draw a layout of your proposed sewage disposal system, including items and exact distances in feet.

See Sample Drawing


TYPICAL PLOT PLAN

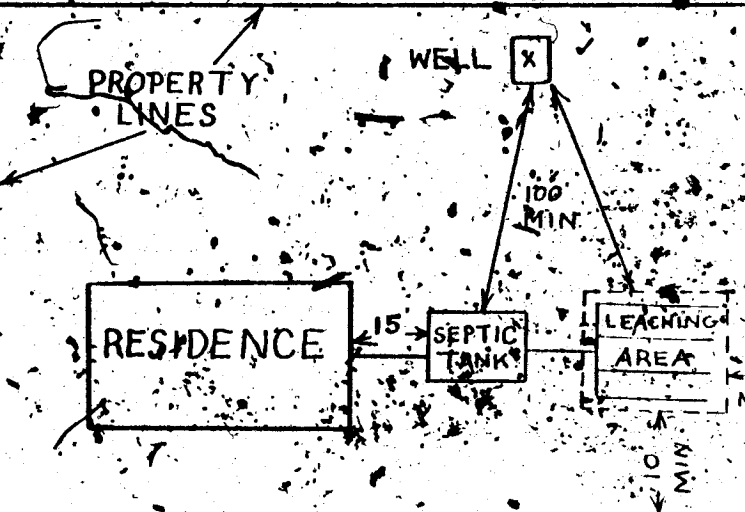

FIXTURE UNITS:

2 W. C.	12
1 Shower	2
1 Tub	2
2 S. Lavs	2
1 K. Sink	2
1 Wash M.	2

Total Units 22

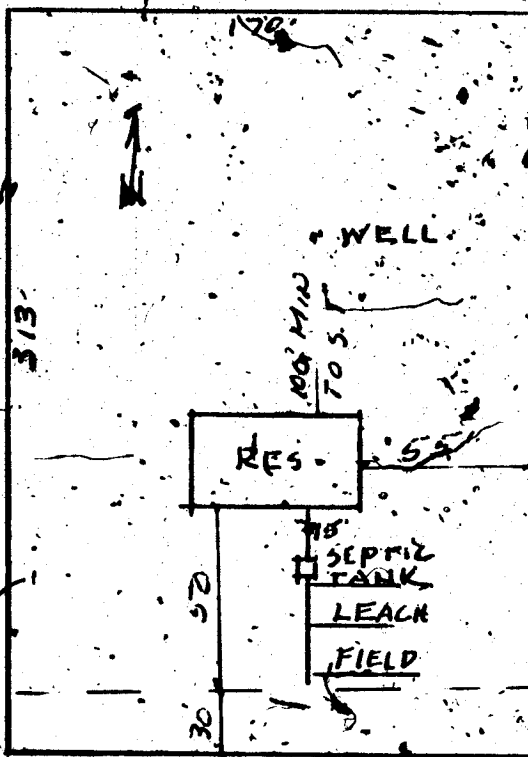

LOG CABIN WAY

SIGNATURE

Red Anderson

Y. Watered 10-3-79

CITY OF LAS VEGAS, NEVADA

LOG NO. & AREA

CONST. VAL. \$

DEPARTMENT OF BUILDING & SAFETY

APPLICATION & BUILDING PERMIT -- for:
Fence, Wall, Retaining Wall.

ADDRESS OF CONSTRUCTION:

8512 10th AVE NW

OWNER:

May G. Thompson

LOT (S)

BLOCK

SUBDIVISION

5, 195, 260E

ZONE:

Materials of Construction:

Block ☐

Concrete ☐

Wire ☒

Wood ☐

Other ☐

Yes

No

PLANS: ☐

☐

ARCHITECT:

ENGINEER:

CALOS: ☐

☐

CONTRACTOR:

OWNER

STATE LICENSE #

CITY LICENSE #

TOTAL SQUARE FEET:

TOTAL LINEAL FEET:


892

Remarks:

Remarks section with lines for notes.

CONDITIONS OF THE PERMIT:

1. Any type of retaining wall must be engineered by a Civil or Structural Engineer.
2. If a home owner takes out the Building Permit and if the owner sublets the work to a Contractor, then the Contractor must take out the permit and pay for it.
3. No fence or wall can be built on City property or rights-of-way, but this is not intended to preclude construction within utility easements if utilities will not be damaged or made inaccessible.
4. The fence or wall shall not enclose any water meter, light standard, or fire alarm box and shall not come closer than 24" from the nearest fire hydrant outlet.
5. Department inspectors must approve footings before concrete is poured and block wall reinforcing before grouting is done.
6. Maximum height of any wall or fence is 6', side and rear yards; 4' maximum in front yard with the vertical surface above the height of 2' - 50% open.
7. I must not obstruct required onsite parking space (2 spaces for each dwelling unit) by the erection of this fence or wall.
8. By the signing of this application I herewith agree to the requirements outlined above.

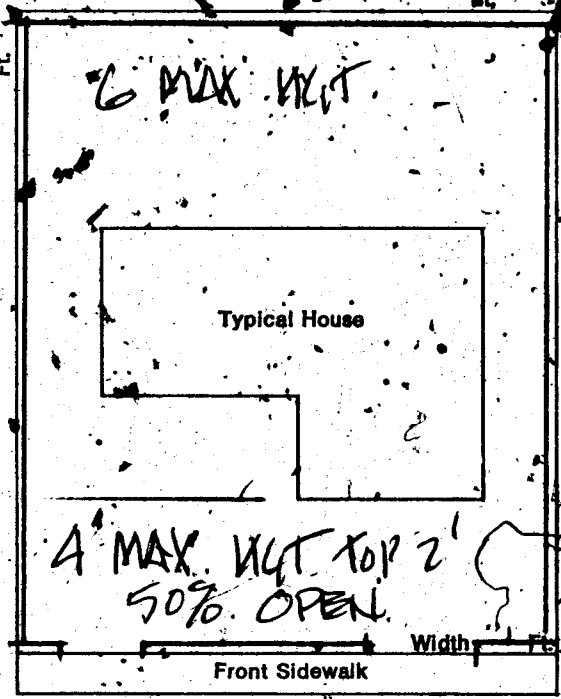

SIGNED:

May G. Thompson

DATE:

3/31/76

CONTRACTOR ☐

AGENT ☐

OWNER ☒

PLANNING DEPT:

Date:

3-31-76

PUBLIC WORKS DEPT:

Date:

3-31-76

BUILDING DEPT:

Date:

3-31-76

#12850

PERMIT NO:

1626

PERMIT FEE \$

1800

RECEIPT

9321 \$018.00 - 18

CITY OF LAS VEGAS

DEPT. OF BUILDING & SAFETY

MUST BE MACHINE VALIDATED

3-31-76

Y. Yataw 10-5-79

CITY OF LAS VEGAS, NEVADA

LOG NO. & AREA

DEPARTMENT OF BUILDING & SAFETY

CONST. VAL. \$32676.05

APPLICATION & BUILDING PERMIT -- for:
Fence, Wall, Retaining Wall.

ADDRESS OF
CONSTRUCTION:

8512 10th AVE. W. WAY

OWNER:

Mary E. Thompson

LOT(S)

BLOCK

SUBDIVISION

NE 1/4, SEC 5, T19S, R60E

ZONE

Materials of Construction:

Block ☐

Concrete ☐

Wire ☒

Wood ☐

Other ☐

Yes No

PLANS: ☐ ☐

ARCHITECT:

ENGINEER:

CALOS: ☐ ☐

CONTRACTOR:

OWNER

STATE
LICENSE #

CITY
LICENSE #

TOTAL SQUARE FEET:


TOTAL LINEAL FEET: 892

Remarks:

Remarks section with lines for notes.

CONDITIONS OF THE PERMIT:

1. Any type of retaining wall must be engineered by a Civil or Structural Engineer.
2. If a home owner takes out the Building Permit and if the owner sublets the work to a Contractor, then the Contractor must take out the permit and pay for it.
3. No fence or wall can be built on City property or rights-of-way, but this is not intended to preclude construction within utility easements if utilities will not be damaged or made inaccessible.
4. The fence or wall shall not enclose any water meter, light standard, or fire alarm box and shall not come closer than 24" from the nearest fire hydrant outlet.
5. Department Inspectors must approve footings before concrete is poured and block wall reinforcing before grouting is done.
6. Maximum height of any wall or fence is 6', side and rear yards; 4' maximum in front yard with the vertical surface above the height of 2' -- 50% open.
7. I must not obstruct required onsite parking space (2 spaces for each dwelling unit) by the erection of this fence or wall.
8. By the signing of this application I herewith agree to the requirements outlined above.

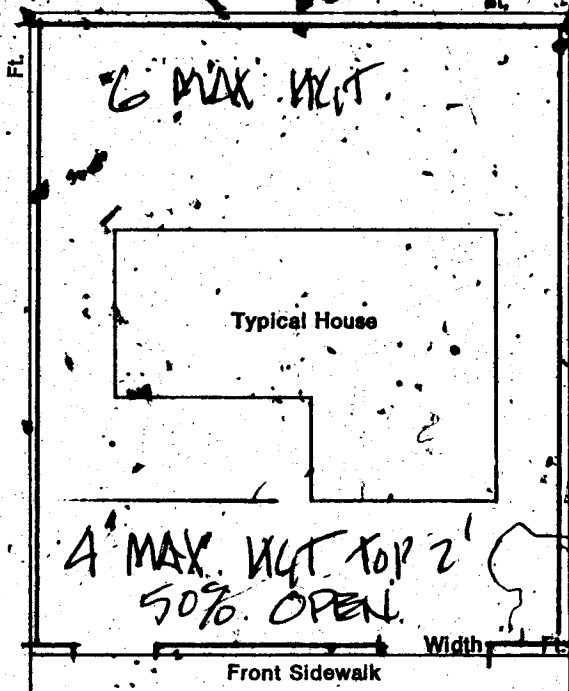

SIGNED:

Mary E. Thompson

DATE: 3/31/76

CONTRACTOR ☐ AGENT ☐ OWNER ☒

30-05

PLANNING DEPT:

Date: 3-31-76

PUBLIC WORKS DEPT:

Date:

BUILDING DEPT:

Date: 3-31-76

#12850

PERMIT NO:

1626

PERMIT FEE \$

1800

RECEIPT

9321 \$018.00 - 18

CITY OF LAS VEGAS
DEPT. OF
BUILDING & SAFETY

MUST BE MACHINE VALIDATED

3-31-76

4 Saturday 10-5-79

CITY OF LAS VEGAS, NEVADA
DEPARTMENT OF BUILDING & SAFETY - AIR CONDITIONING APPLICATION & PERMIT

ADDRESS OF CONSTRUCTION: 8512 Log Cabin Road OWNER'S NAME: Thompson

CIRCLE: Addition; Remodel; New Bldg; TYPE OF BLDG.: SFR APT. COMM. PUBLIC

CONTRACTOR'S NAME: Spratt Air Conditioning STATE LICENSE # 8214 CITY LICENSE # 9850

UNITS	DESCRIPTION	FEE	TOTAL	UNITS	DESCRIPTION	FEE	TOTAL
	Unit heater - floor, wall or suspended	4.00			EVAPORATIVE COOLERS:		
	FOR EACH FORCED-AIR OR GRAVITY-TYPE FURNACE OR BURNER INCLUDING DUCTS AND VENT ATTACHED TO SUCH APPLIANCES:				5 outlets or under	3.00	
	Up to and including 100,000 B.t.u.'s	4.00			Over 5 and up to and including 10	5.00	
	Over 100,000 B.t.u.'s	6.00			Each additional outlet over 10	.25	
	FOR EACH HEATING APPLICATION, REFRIGERATION UNIT, COMFORT COOLING AND HEATING UNIT, ABSORPTION UNIT, COMPRESSOR OR BOILER:				VENTILATION:		
	Up to and including 3 ton or horsepower, or absorption system up to and including 100,000 B.t.u.'s	4.00	4.00		For each fan connected to a single duct	1.00	
	Over 3 ton or 3 horsepower up to and including 10, or absorption system over 100,000 B.t.u.'s up to and including 250,000 B.t.u.'s	7.00			For each commercial or industrial ventilation system	5.00	
	Over 10 ton or 10 horsepower up to and including 30, or absorption system over 250,000 B.t.u.'s up to and including 1,000,000 B.t.u.'s	12.00			For each commercial kitchen hood	5.00	
	Over 30 ton or 30 horsepower up to and including 50, or absorption system over 1,000,000 B.t.u.'s up to and including 1,700,000 B.t.u.'s	20.00			MISCELLANEOUS:		
	Over 50 ton or 50 horsepower, or absorption system over 1,700,000 B.t.u.'s	30.00			For each water cooling tower	8.00	
	FOR EACH AIR HANDLING UNIT INCLUDING DUCTS ATTACHED THERETO:				Duct work only - each opening	.25	
	Up to and including 10,000 CFM	2.00			For installation or relocation of each commercial or industrial incinerator	15.00	
	Over 10,000 CFM	4.00			Gas piping related to the air cond. work in single family dwelling only	3.00	
					For each appliance, piece of equipment, any mechanical work or alteration or replacement not included in this schedule, the permit fee shall be computed the same as building permit fees by using the cost of installation for the valuation amount.		
					FOR THE ISSUANCE OF EACH PERMIT	3.00	
					TOTAL PERMIT FEE \$	7.00	

I hereby certify that I have carefully examined and read the above application; that the same is true and correct; and that the work herein described is to be done in accordance with all the provisions of the applicable Ordinances of the City of Las Vegas, Nevada and the State Laws, whether herein specified or not.

Approval for the work under this permit will be given only after refuse and debris have been removed from job site and public right of way.

SIGNED Ron W. Spratt Date 4-10-79
Air Conditioning Contractor

BUILDING DEPARTMENT WR3 Date: 4/10/79

PERMIT NO. 5189 PERMIT FEE \$ 7.00

#12890

RECEIPT

CITY OF LAS VEGAS

BUILDING DEPARTMENT

MACHINE VALIDATED

Y. Gatewood 10-5-79

CITY OF LAS VEGAS, NEVADA

DEPARTMENT OF BUILDING & SAFETY - ELECTRICAL APPLICATION & PERMIT

ADDRESS OF CONSTRUCTION: 8512 Lee Cabin OWNER'S NAME: THOMPSON
CIRCLE: New Bldg. Add'n.: Remodel: TYPE OF BLDG.: SFD APT. PUBLIC COMM.
CONTRACTOR'S NAME: Denton Electric Company STATE LICENSE # 9750 CITY LICENSE # 011-249

NUMBER	FIXTURE OR INSTALLATION	UNIT PRICE	TOTAL
	Rm addition, carport or garage enclosure	4.00	
	Temporary power	4.00	
44	Light, receptacle or switch outlet	.20	8.80
	Wall or ceiling space heater	.35	
	Garbage grinder, outlet	.35	
	Dishwasher outlet	.35	
1	Clothes dryer outlet	.35	.35
1	Automatic clothes washer	.35	.35
1	Electric range outlet	.35	.35
1	Electric water heater outlet	.35	.35
	Special purpose outlet	.35	
	X-ray unit and its appurtenances	5.00	
	Watts of festoon lighting (Watts) First 3,000 watts, for each additional thousand watts	4.00 1.50	
	Horsepower each motor first horsepower or less for each additional horsepower	1.75 .35	
	Electric service (including any single meter socket) for each additional socket	3.00 .35	3.00
1	Air conditioning service	1.50	1.50
	Each KW(KVA) Generator (Transformer, Winder) First 100 KVA for each additional KW(KVA)	2.00 .01	
	Speaker, signal or alarm outlet	.15	
	Amplifiers	.50	
	Control panels	.25	
	Main control racks	1.00	
	T.V. and radio antennas-master system only	.75	
	Minimum fee for any permit	4.00	
	TOTAL FEE		14.70

Approval for the work under this permit will be given only after refuse and debris have been removed from job site and public right of way.

I hereby certify that I have carefully examined and read the above application; that the same is true and correct; and that the work herein described is to be done in accordance with all the provisions of the applicable Ordinances of the City of Las Vegas, Nevada and State laws whether herein specified or not.

SIGNED E.H. Denton DATE 3-28-79
MASTER (ELECTRICIAN) (TECHNICIAN) (OWNER)

BUILDING DEPARTMENT [Signature] DATE

#12860 PERMIT NO. 9103 PERMIT FEE \$ 14.70

RECEIPT

CITY OF LAS VEGAS
BUILDING & SAFETY
MUST BE MACHINE VALIDATED

674 P. 121 P-20-82
DEPT. of BLDG. & SAFETY - CITY of LAS VEGAS, NEVADA
OWNER: Anthony Thompson ADDRESS: 8512 Log Cabin Way DATE: 3-13-74
GEN. CONT. Security Housing TYPE OF STRUCTURE SFD
PERMIT NO. 15388

BUILDING	MECHANICAL	ELECTRICAL
Investigation	Plumbing Cont. <i>Wepu</i>	Temp. pole cont. <i>Wepu</i>
Location & Footing <i>ag 4-4-74</i>	Permit No. <i>12857</i> Date <i>3-19-74</i>	Permit No. <i>9103</i> Date
Stem Wall	Heat & Vent. A/C Cont. <i>Wepu</i>	Inspection Date
Concrete Slab Floor <i>ag 4-4-74</i>	Permit No. <i>5189</i> Date <i>4-10-74</i>	Electrical Cont. <i>Wepu</i>
Floor Framing	Sewer Cont.	Permit No. <i>9103-9167</i> Date <i>4-11-74</i>
Fireplace Footing	Permit No. Date	Fixtures Cont.
Chimney Steel	Rough Soil <i>WEP 4-1-74</i>	Permit No. Date
Vert. Steel Reinf.	Rough Water <i>WEP 4-1-74</i>	Slab
Horiz. Steel Reinf.	Tap Out <i>WEP 4-22-74</i>	Rough <i>VP 4-30-74</i>
Roof Sheathing <i>ag 4-10-74</i>	Rough Gas	Final Rough
Framing <i>ag 4-10-74</i>	A/C Rough Duct <i>WEP 4-15-74</i>	Final Fixture
Backing & Siding	Ref. Rough Piping	Final Electrical
Ext. Lath	Final Plumbing	Temporary Service <i>ag 4-11-74</i>
Ext. Patch	Final Gas	MISCELLANEOUS
Ext. Brown	Final Air Cond.	Grading & Drainage
Int. Lath	Final Refrig.	On Site Parking Spaces App.
Int. Brown	Final Sewer	Eng. Approval of
Drywall	Final Septic Tank	Off Site Improvements
Permit No.		
Final Building		
Appr. for Occu.		

INSPECTOR: DATE:
APPROVED FOR OCCUPANCY & METER *ag*
PLEASE NOTE REMARKS ON REVERSE SIDE 8512 Log Cabin Way LOG # AREA # R 33-3