

73 MAYA ST

L1 B2 PALOMAR EST ZONE R-1

11-24-68 10-29-68

CITY OF LAS VEGAS, NEVADA

LOG NO. & AREA

CONST. VAL. \$ 600.00

DEPARTMENT OF BUILDING & SAFETY

APPLICATION & BUILDING PERMIT — for:
Dwellings, Duplexes, Misc. Residential Const.

ADDRESS OF
CONSTRUCTION: 73 Maya

OWNER: 1st Western S & L

LOT(s) BLOCK SUBDIVISION Paloma

ZONE:

Existing structure on lot: Dwelling ☒ Accessory bldgs. ☐ Vacant lot ☐ Other ☐

PROPOSED CONSTRUCTION: Rehab

USE:

MATERIALS OF CONSTRUCTION: Wood Frame ☐ Concrete Block ☐ Reinforced Concrete ☐ Steel Frame ☐

SQUARE FEET OF FLOOR AREAS: 1st 2nd 3rd Other TOTAL SQ. FT.

FIRE ZONE: 1 2 3 Occupancy Group A B C D E F G H I J-1-2-3-4-5 CONST. TYPE: I II III IV V

ARCHITECT: ENGINEER: NO. of UNITS NO. of STORIES

Plans Submitted: Yes ☐ No ☐ Calculations Submitted: Yes ☐ No ☐ Sewer Fee Req'd. Yes ☐ No ☐

CONTRACTOR: Herman Kaufmann STATE LICENSE # 9510 CITY LICENSE # C11030208550

ADD'L. PERMITS REQ'D: Air Cond. ☐ Elec. ☐ Plumbing ☐ Signs ☐ Paving ☐ Fence ☐ Public Walks ☐ Curb-gutters ☐
Incinerators ☐ Fire Sprinkling System ☐

Diagram showing the layout of the property with dimensions in feet (Ft.) and a label for the front sidewalk.

CONDITIONS OF THE PERMIT:

1. I agree to call the City Building Department for inspections before concrete is poured, before rough wiring, electrical, plumbing, framing is covered. Also for Air conditioning, sheet-rock and sheathing inspection.
2. I agree that when the job is completed that I will call for final inspection before occupancy.
3. I agree to perform all construction in accordance with City Ordinances and Building Codes.
4. The Contractor's signature below denotes authority from the owner to sign in his behalf and that the owner is aware of all requirements of this application and permit. Separate permits must be taken out for work outlined above this agreement.
5. I have read and understand the contents of this application and permit; I hereby state that the information I have supplied on this application is true and correct.

SIGNED: Contractor

BY: Agent or Owner

CLARK COUNTY HEALTH DEPT.

LAS VEGAS FIRE DEPARTMENT

PLANNING DEPT: Date:

ENGINEERING DEPT: Date:

BUILDING DEPT: Date: 8-22-68

#12850

PERMIT NO: 43979 PERMIT FEE \$ 6.00

RECEIPT

3989 \$006.00 - 8

CITY OF LAS VEGAS
DEPT. OF
BUILDING & SAFETY

MUST BE MACHINE VALIDATED

22 AUG 68

10-29574

CITY OF LAS VEGAS, NEVADA

LOG NO. & AREA

CONST. VAL. \$

DEPARTMENT OF BUILDING & SAFETY

APPLICATION & BUILDING PERMIT for:
Fence, Wall, Retaining Wall.

ADDRESS OF
CONSTRUCTION:

OWNER:

LOT(s)

BLOCK

SUBDIVISION

ZONE:

Materials of Construction:

Block ☐

Concrete ☐

Wire ☐

Wood ☒

Other ☐

Yes No

PLANS: ☐

☐

ARCHITECT:

ENGINEER:

CALCS: ☐

☐

CONTRACTOR:

STATE
LICENSE #

8581

CITY

LICENSE #

7594

TOTAL SQUARE FEET:


TOTAL LINEAL FEET:

150'

Remarks:

CONDITIONS OF THE PERMIT:

1. Any type of retaining wall must be engineered by a Civil or Structural Engineer.
2. If a home owner takes out the Building Permit and if the owner sublets the work to a Contractor then the Contractor must take out the permit and pay for it.
3. No fence or wall can be built on City property or rights-of-way, but this is not intended to preclude construction within utility easements if utilities will not be damaged or made inaccessible.
4. The fence or wall shall not enclose any water meter, light standard, or fire alarm box and shall not come closer than 24" from the nearest fire hydrant outlet.
5. Department Inspectors must approve footings before concrete is poured and block wall reinforcing before grouting is done.
6. Maximum height of any wall or fence is 6' side and rear yards; 4' maximum in front yard with the vertical surface above the height of 2' - 50% open and further that fencing within 25' of the intersection of curb faces on corner and through lots is limited to a maximum height of 30".
7. I must not obstruct required onsite parking space (1 space for each dwelling unit) by the erection of this fence or wall.
8. By the signing of this application I herewith agree to the requirements outlined above.

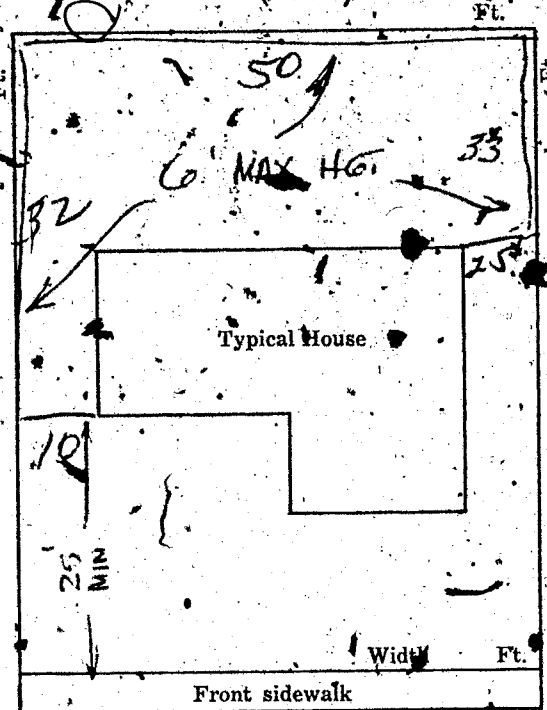

SIGNED:

J. K. Kessler

DATE:

9-19-68

CONTRACTOR ☐ AGENT ☐ OWNER ☐

PLANNING DEPT:

Date:

9-20-68

ENGINEERING DEPT:

Date:

BUILDING DEPT:

Date:

9-24-68

#12850

PERMIT NO:

44410

PERMIT FEE \$

4.00

RECEIPT

5419 \$004.00 - 8

CITY OF LAS VEGAS
DEPT. OF
BUILDING & SAFETY

MUST BE MACHINE VALIDATED

24 SEP 68

24. Hatedwood 10-29-70

1970
CITY OF LAS VEGAS, NEVADA

LOG NO. & AREA

DEPARTMENT OF BUILDING & SAFETY

CONST. VAL. \$ 342

APPLICATION & BUILDING PERMIT — for:
Fence, Wall, Retaining Wall.

ADDRESS OF CONSTRUCTION:

73 Maya

OWNER: P. Pacheco Reyes

LOT(s)

1

BLOCK

2

SUBDIVISION

PALOMAR ESTATES

ZONE

X

Materials of Construction:

Block ☐

Concrete ☐

Wire ☒

Wood ☐

Other ☐

Yes ☐

No ☐

ARCHITECT:

ENGINEER:

PLANS: ☐

CALCS: ☐

CONTRACTOR:

Deming Inc.

STATE LICENSE #

4012

CITY LICENSE #

100-8

TOTAL SQUARE FEET:


TOTAL LINEAL FEET:

121

Remarks:

CONDITIONS OF THE PERMIT.

- Any type of retaining wall must be engineered by a Civil or Structural Engineer.
- If a home owner takes out the Building Permit and if the owner sublets the work to a Contractor, then the Contractor must take out the permit and pay for it.
- No fence or wall can be built on City property or rights of way, but this is not intended to preclude construction within utility easements if utilities will not be damaged or made inaccessible.
- The fence or wall shall not enclose any water meter, light standard, or fire alarm box and shall not come closer than 24" from the nearest fire hydrant outlet.
- Department Inspectors must approve footings before concrete is poured and block wall reinforcing before grouting is done.
- Maximum height of any wall or fence is 6', side and rear yards; 4' maximum in front yard with the vertical surface above the height of 2' — 50% open.
- I must not obstruct required onsite parking space (1 space for each dwelling unit) by the erection of this fence or wall.
- By the signing of this application I hereby agree to the requirements outlined above.

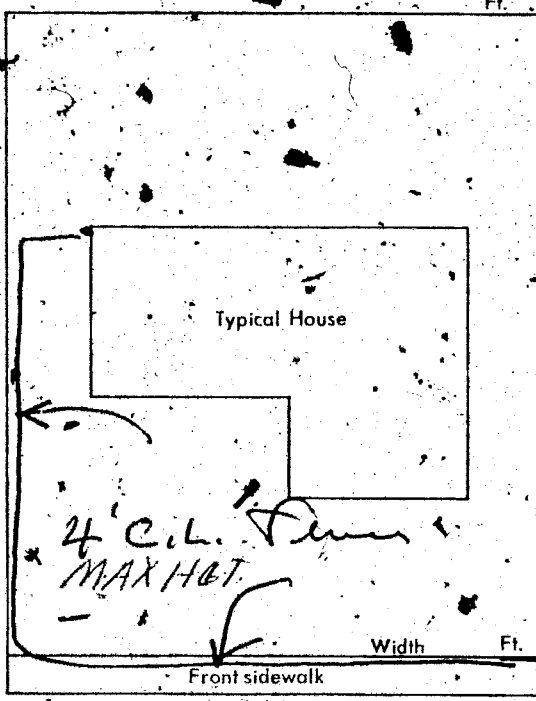

SIGNED:

Tang

DATE:

6-1-70

CONTRACTOR ☒

AGENT ☐

OWNER ☐

PLANNING DEPT.:

J.M.C.

Date:

6-9-70

PUBLIC WORKS DEPT.:

Date:

BUILDING DEPT.:

G. Wenzel

Date:

6-10-70

#12850

PERMIT NO.:

53765

PERMIT FEE \$

6.00

RECEIPT

5481 \$006.00 — 8

CITY OF LAS VEGAS

DEPT. OF BUILDING & SAFETY

MUST BE MACHINE VALIDATED

10 JUN 70

M. Matwood 10-29-72

CITY OF LAS VEGAS, NEVADA

LOG NO. & AREA

DEPARTMENT OF BUILDING & SAFETY

CONST. VAL. \$165.00

APPLICATION & BUILDING PERMIT for:

Dwellings, Duplexes, Misc. Residential Const.

ADDRESS OF CONSTRUCTION

73 MAYA ST

OWNER:

RODOLFO A. PACHECO REYES

LOT(s)

BLOCK 2

SUBDIVISION

Palomar Estate

ZONE R-1

Existing structure on lot: Dwelling

Accessory bldgs.

Vacant lot

Other

PROPOSED CONSTRUCTION:

Patio - 5600

USE: Patio

MATERIALS OF CONSTRUCTION: Wood Frame

Concrete Block

Reinforced Concrete

Steel Frame

SQ. FEET OF FLOOR AREAS: 1st

2nd

3rd

Other

TOTAL SQ. FT.

FIRE ZONE: 1 2 3

Occupancy Group

1 J 1-2

CONST. TYPE: I II III IV V

ARCHITECT

ENGINEER

NO. of UNITS

NO. of STORIES

Plans Submitted: Yes

No

Calculations Submitted: Yes

No

Sewer Fee Req'd: Yes

No

CONTRACTOR:

Home Owner

STATE LICENSE #

CITY LICENSE #

ADD'L. PERMITS REQ'D: Air Cond.

Elec.

Plumbing

Signs

Paving


Fence

Public Walks

Gurb-gutters

Incinerators

Fire Sprinkling System

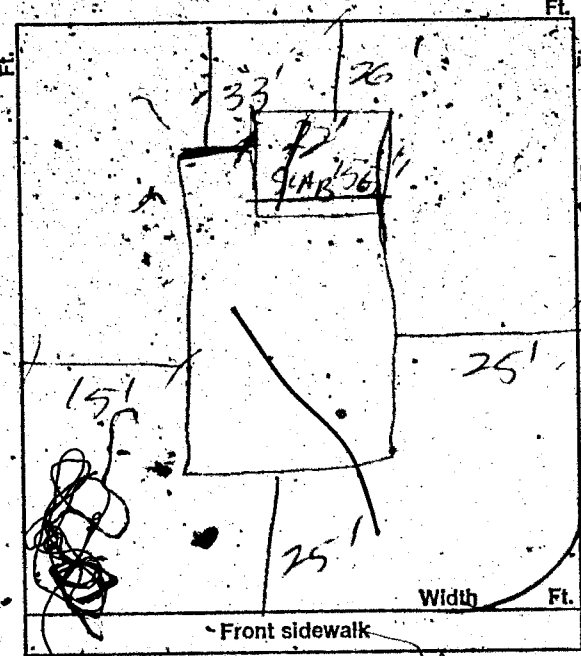

CONDITIONS OF THE PERMIT:

1. I agree to call the City Building Department for inspections before concrete is poured, before rough wiring, electrical, plumbing, framing is covered. Also for air conditioning, sheet rock and sheathing inspection.
2. I agree that when the job is completed that I will call for final inspection before occupancy.
3. I agree to perform all construction in accordance with City Ordinances and Building Codes.
4. The Contractor's signature below denotes authority from the owner to sign in his behalf and that the owner is aware of all requirements of this application and permit. Separate permits must be taken out for work outlined above this agreement.
5. I have read and understand the contents of this application and permit; I hereby state that the information I have supplied on this application is true and correct.

SIGNED:

Rodolfo A. Pacheco Reyes

Contractor

BY:

Agent or Owner

CLARK COUNTY HEALTH DEPT.

Date

LAS VEGAS FIRE DEPARTMENT

Date

PLANNING DEPT:

JBA

Date:

8-3-72

PUBLIC WORKS DEPT:

Date:

BUILDING DEPT:

[Signature]

Date:

8-3-72

#12850

PERMIT NO.:

66670

PERMIT FEE \$

5.00

RECEIPT

1526 \$005.00 - 8

CITY OF LAS VEGAS
DEPT. OF
BUILDING & SAFETY

MUST BE MACHINE VALIDATED

- 4 AUG 72

18. Gate road 10-29-72

CITY OF LAS VEGAS, NEVADA

Lot No. & Area

DEPARTMENT OF BUILDING & SAFETY

CONST. VAL. \$1848⁰⁰

APPLICATION & BUILDING PERMIT for:
Dwellings, Duplexes, Misc. Residential Const.

ADDRESS OF
CONSTRUCTION:

73 MAYA

OWNER: RODOLOFO A. PACHECO REYES

LOT(s)

1

BLOCK

2

SUBDIVISION

Palomar Estates

ZONE: R-1

Existing structure on lot: Dwelling

☒ Accessory bldgs.

☐ Vacant lot

☐ Other

PROPOSED CONSTRUCTION:

Room Addition

USE:

FMLY RM

MATERIALS OF CONSTRUCTION:

Wood Frame

☐ Concrete Block

☐ Reinforced Concrete

☐ Steel Frame

SQ. FEET OF FLOOR AREAS:

1st

2nd

3rd

Other

TOTAL SQ. FT.

FIRE ZONE:

1 2 3

Occupancy Group

1 J 1-2

CONST. TYPE:

I II III IV V

ARCHITECT:

ENGINEER:

NO. of UNITS

NO. of STORIES

Plans Submitted: Yes ☐ No ☐

Calculations Submitted

Yes ☐ No ☐

Sewer Fee Req'd

Yes ☐ No ☐

CONTRACTOR:

OWNER

STATE
LICENSE #

CITY
LICENSE #

ADD'L. PERMITS REQ'D: Air Cond. ☐

Incinerators ☐

Elec. ☒

Plumbing ☐

Signs ☐


Paving ☐

Fence ☐

Public Walks ☐

Curb-gutters ☐

65 Ft.

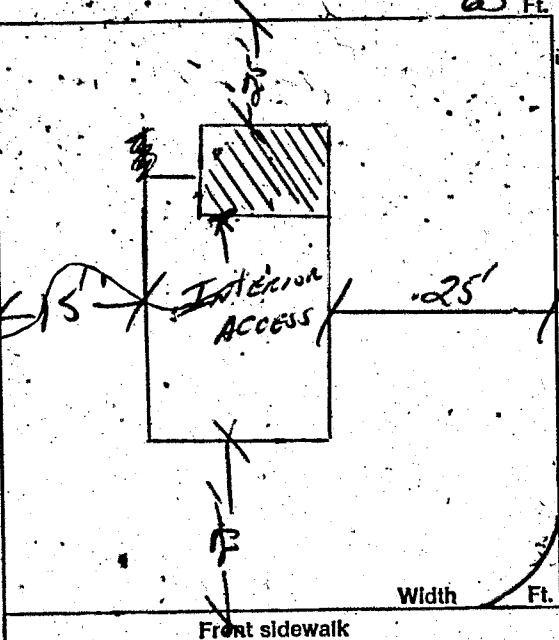

CONDITIONS OF THE PERMIT:

1. I agree to call the City Building Department for inspections before concrete is poured, before rough wiring, electrical, plumbing, framing is covered, also for air conditioning, sheet-rock and sheathing inspection.

2. I agree that when the job is completed that I will call for final inspection before occupancy.

3. I agree to perform all construction in accordance with City Ordinances and Building Codes.

The Contractor's signature below denotes authority from the owner to sign in his behalf and that the owner is aware of all requirements of this application and permit. Separate permits must be taken out for work outlined above this agreement.

4. I have read and understand the contents of this application and permit. I hereby state that the information I have supplied on this application is true and correct.

SIGNED: Rodolfo A. Pacheco Reyes Contractor

BY: Agent or Owner

CLARK COUNTY HEALTH DEPT.

Date

LAS VEGAS FIRE DEPARTMENT

Date

PLANNING DEPT.:

Quone D. May

Date:

9-20-72

PUBLIC WORKS DEPT.:

Date:

BUILDING DEPT.:

Date:

9-20-72

#12850

PERMIT NO.:

1766

PERMIT FEE:

1500

RECEIPT

3876 \$015.00 - 8

CITY OF LAS VEGAS
DEPT. OF
BUILDING & SAFETY

MUST BE MACHINE VALIDATED

20 SEP 72

W. Watson 10-29-71

CITY OF LAS VEGAS, NEVADA

DEPARTMENT OF BUILDING & SAFETY — ELECTRICAL APPLICATION & PERMIT

ADDRESS OF
CONSTRUCTION:

73 MAYA

OWNER'S
NAME:

R. PINOLO-REYES

CIRCLE: New Bldg.: ☒ Remodel: ☐ TYPE OF BLDG.: ☒ SFD ☐ APT. ☐ PUBLIC ☐ COMM.

CONTRACTOR'S NAME:

OWNER

STATE
LICENSE #

CITY
LICENSE #

NUMBER	FIXTURE OR INSTALLATION	UNIT PRICE	
2	Fixture or sockets	.15	
	Light, receptacle or switch outlet	.20	
	Wall or ceiling space heater	.39	
	Blast coil heater per kilowatt	.35	
	Garbage grinder outlet	.85	
	Dishwasher outlet	.35	
	Clothes dryer outlet	.35	
	Automatic clothes washer	.35	
	Electric range outlet	.35	
	Electric water heater outlet	.35	
	Mercury arc lamp and equipment	.35	
	Special purpose outlet	.35	
	X-ray unit and its appurtenances	5.00	
	Watts of festoon lighting (Watts) First 3,000 watts	4.00	
	for each additional thousand watts	1.50	
	Horsepower — all motors first horsepower or less	1.75	
	for each additional horsepower	.35	
	Temporary power and lights (temporary pole)	4.00	
	Electric service (including any single meter socket)	3.00	
	for each additional socket	.35	
	Air conditioning service amps	1.50	
	Each KW (KVA) Generator (Transformer) (Welder) KW (KVA)	2.00	
	First 100 KVA — For each additional KW (KVA)	.01	
	Special inspection per hour	4.00	
	Speaker outlets	.15	
	Signal or Alarm outlets	.15	
	Amplifiers	.50	
	Control panels	.25	
	T.V. outlets — master system only	.15	
	Radio outlets	.15	
	Main control racks	1.00	
	T.V. and Radio antennas — master system only	.75	
	Minimum fee for any permit	4.00	
	Total fee		4.00

I hereby certify that I have carefully examined and read the above application; that the same is true and correct; and that the work herein described is to be done in accordance with all the provisions of the applicable Ordinances of the City of Las Vegas, Nevada and State laws whether herein specified or not.

SIGNED

MASTER (ELECTRICIAN) (TECHNICIAN) (OWNER)

DATE

BUILDING DEPARTMENT

DATE

#12860

PERMIT NO.

PERMIT FEE: \$

RECEIPT

3875 \$004.00 — 6

CITY OF LAS VEGAS

DEPT. OF
BUILDING & SAFETY

MUST BE MACHINE VALIDATED

20 SEP 72

CITY OF LAS VEGAS, NEVADA

LOG NO. & AREA: _____

CONST. VAL: \$ 1440.00

DEPARTMENT OF PUBLIC SERVICES
DIVISION OF BUILDING AND SAFETY

APPLICATION & BUILDING PERMIT - for:
Dwellings, Duplexes, Misc. Residential Const.

ADDRESS OF
CONSTRUCTION: 23 Maya St

OWNER: Pacheco, R.

LQT(s): 1

BLOCK: 2

SUBDIVISION: Palomares Estates

ZONE: R-1

Existing structure on lot:

Dwelling ☐

Accessory Bldg. ☐

Vacant Lot ☐

Other ☐

PROPOSED CONSTRUCTION: Extend Room

USE: _____

MATERIALS OF CONSTRUCTION:

Wood Frame ☐

Concrete Block ☐

Reinforced Concrete ☐

Steel Frame ☐

SQUARE FEET OF FLOOR AREAS: 1st 120

2nd _____

3rd _____

Other _____

TOTAL SQ. FT. 120

FIRE ZONE: _____

Occupancy Group: R-3

CONST. TYPE: V-N

ARCHITECT: _____

ENGINEER: _____

NO. of UNITS: 1

NO. STORIES: 1

Plans Submitted: Yes ☐ No ☒

Calculations Submitted: Yes ☐ No ☒

Sewer Fee Req'd.: Yes ☐ No ☒

CONTRACTOR: Chun

STATE
LICENSE # _____

CITY
LICENSE # _____

ADD'L. PERMITS REQ'D.:

Air Cond. ☐

Elec. ☒

Plumbing ☐

Signs ☐

Paving ☐

Fence ☐

Public Walks ☐

Curb-gutters ☐

Incinerators ☐

Fire Sprinkling System ☐

CONDITIONS OF THE PERMIT:

1. I agree to call the City Building Department for inspections before concrete is poured, before rough wiring, electrical, plumbing, framing is covered. Also for Air conditioning, drywall and sheathing inspection.
2. I agree that when the job is completed that I will call for final inspection before occupancy.
3. I agree to perform all construction in accordance with City Ordinances and Building Codes.
4. The Contractor's signature below denotes authority from the owner to sign in his behalf and that the owner is aware of all requirements of this application and permit. Separate permits must be taken out for work outlined above this agreement.
5. I have read and understand the contents of this application and permit. I hereby state that the information I have supplied on this application is true and correct.

Approval for the work under this permit will be given only after refuse and debris have been removed from job site and public right of way.


SIGNED: Philip A. Pacheco

Contractor

BY: _____

Agent or Owner

EMERGENCY EGRESS
SHALL NOT BE
ELIMINATED.

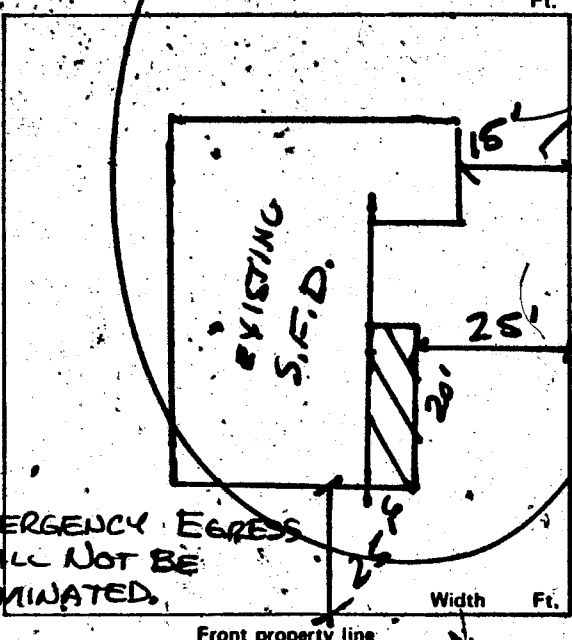

PLANNING DEPT. CBAR

Date: 22 June 81

PUBLIC WORKS DEPT. Nash

Date: 6-22-81

BUILDING DIVISION: M.J.

Date: 6-22-81

PERMIT NO. 2217

PERMIT FEE \$ 32.50

1721-2401

1 TON \$.00
SFD \$ 32.50
ELEC \$ 12.40

STL RECEIPT
TOTL \$ 44.90
CHK \$ 44.90
#2217 SR#00101
CITY - LAS VEGAS
BLDG. & SAFETY
06/22/81

MUST BE MACHINE VALIDATED

DEPARTMENT OF BUILDING AND SAFETY-ELECTRICAL APPLICATION & PERMIT

PHONE NO. _____
Pacheco P.

SFD APT COMM PUBLIC

CITY
LICENSE

[illegible]

Electrical permit fees may be computed the same as building permit fees by using the cost of installation for valuation amount when such work is not included in the above schedule.

FOR BUILDING DEPARTMENT USE ONLY

Square Footage

137

Total Fees

Other inspections and fees:

1. Inspections outside of normal business hours-\$15.00 per hour (minimum charge two hours).
2. Re-inspection fee assessed under provisions of TABLE 3-A of the Uniform Building Code-\$15.00 per hour.
3. Inspections for which no fee is specifically indicated-\$15.00 per hour (minimum charge one half hour).
4. Additional plan review required by changes, additions or revisions to approved plans-\$15.00 per hour (minimum charge one half hour).

Approval for the work under this permit will be given only after refuse and debris have been removed from job site and public right of way.

I hereby certify that I have carefully examined and read the above application; that the same is true and correct; and that the work herein described is to be done in accordance with all the provisions of the applicable Ordinances of the City of Las Vegas, Nevada and the State Laws, whether herein specified or not. City Master Card No. 2

Date _____

Date _____

#1721-2402

RECEIPT

Done Today

9-15-82

DEPT. of BLDG. & SAFETY—CITY of LAS VEGAS, NEVADA
OWNER Rodolfo Reyes ADDRESS 73 Maya St. DATE 8-3-72
GEN. CONT. Owner TYPE OF STRUCTURE patio slab
PERMIT NO. 6630 LEGAL DESCRIPTION L1 B 3 Palomar Estates

BUILDING		MECHANICAL		ELECTRICAL	
LOCATION <u>SP-4-72</u>		PLUMBING CONT.		TEMP. POLE CONT.	
FIREPLACE FTG.		PERMIT NO.	DATE	PERMIT NO.	DATE
FOOTINGS <u>SP-4-72</u>		HEAT & VENT. AC CONT.		INSPECTION	DATE
FOUNDATION WALL		PERMIT NO.	DATE	ELECTRICAL CONT.	DATE
FLOOR FRAMING		SEWER CONT.		PERMIT NO.	DATE
SLAB <u>SP-4-72</u>		PERMIT NO.	DATE	FIXTURES CONT.	DATE
CHIMNEY STEEL (FIREPLACE)		ROUGH SOIL		PERMIT NO.	DATE
WALL STEEL		ROUGH WATER		SLAB	
COLUMN STEEL		TOP-OUT		ROUGH	
BEAM STEEL		ROUGH GAS		FINAL ROUGH	
FRAMING		AC ROUGH DUCT		FINAL FIXTURE	
ROOF SHEATHING		REF. ROUGH PIPING		FINAL ELECTRICAL	
INTERIOR	EXTERIOR	FINAL PLUMBING		TEMPORARY SERVICE	
DRYWALL		FINAL GAS			
LATHING		FINAL AIR COND.			
BACKING (STOPS)		FINAL REFRIG.			
PLASTER <u>SCRATCH</u>		FINAL SEWER			
URBAN REDEVELOPMENT APPROVAL		FINAL SEPTIC TANK			
FINAL BLDG.	DATE				

APPROVED FOR OCCUPANCY METER

SP-25-72

INSPECTOR

DATE

PLEASE NOTE REMARKS ON REVERSE SIDE

LOG #

AREA #

23.0

73 Maya St.

DEPT. of BLDG. & SAFETY—CITY of LAS VEGAS, NEVADA
OWNER Rodolfo A. P. Reyes ADDRESS 73 Maya DATE 9-20-72
GEN. CONT. Owner TYPE OF STRUCTURE rm addn
PERMIT NO. 7266 LEGAL DESCRIPTION L 1 B 2 Palomar Estes

BUILDING		MECHANICAL		ELECTRICAL	
LOCATION		PLUMBING CONT.		TEMP. POLE CONT.	
FIREPLACE		PERMIT NO.	DATE	PERMIT NO.	DATE
FOOTINGS		HEAT & VENT. AC CONT.		INSPECTION	DATE
FOUNDATION WALL		PERMIT NO.	DATE	ELECTRICAL CONT. <u>Owner</u>	DATE
FLOOR FRAMING		SEWER CONT.		PERMIT NO. <u>4286</u>	DATE
SLAB		PERMIT NO.	DATE	FIXTURES CONT.	DATE
CHIMNEY STEEL (FIREPLACE)		ROUGH SOIL		PERMIT NO.	DATE
WALL STEEL		ROUGH WATER		SLAB	
COLUMN STEEL		TOP-OUT		ROUGH	
BEAM STEEL		ROUGH GAS		FINAL ROUGH	
FRAMING <u>SP-4-72</u>		AC ROUGH DUCT		FINAL FIXTURE	
ROOF SHEATHING <u>SP-4-72</u>		REF. ROUGH PIPING		FINAL ELECTRICAL <u>7-11-26-73</u>	
INTERIOR	EXTERIOR	FINAL PLUMBING		TEMPORARY SERVICE	
DRYWALL		FINAL GAS			
LATHING		FINAL AIR COND.			
BACKING (STOPS)		FINAL REFRIG.			
PLASTER <u>SCRATCH</u>		FINAL SEWER			
URBAN REDEVELOPMENT APPROVAL		FINAL SEPTIC TANK			
FINAL BLDG.	DATE				

Pulled 1-14-74

APPROVED FOR OCCUPANCY METER

INSPECTOR

DATE

PLEASE NOTE REMARKS ON REVERSE SIDE

LOG #

AREA #

23.0

73 Maya

John T. ... 9-15-68

DEPARTMENT OF BUILDING & SAFETY
CITY OF LAS VEGAS, NEVADA

KARDEX CARD
FENCE & RETAINING WALLS

OWNER 1st Western ADDRESS 73 Maya DATE 9/23/68

CONTRACTOR American PERMIT NO. 44410

LOT 1 BLOCK 2 SUBDIVISION Palomar Estates
Wood

Fence (wire, wood, etc.)	Walls (masonry, rock, etc.)
Location _____	Location _____
Final Inspection <u>9-2-68</u>	Footings _____
	Wall Steel 1st _____ 2d _____ 3d _____
	Final Inspection _____
Retaining Wall (masonry)	Retaining Wall (concrete)
Location _____	Location _____
Footings _____	Footings _____
Wall Steel 1st _____ 2d _____ 3d _____	Wall Steel 1st _____ 2d _____ 3d _____
Bond Beam 1st _____ 2d _____ 3d _____	Final Inspection _____
Final Inspection _____	

23.14 B ADDRESS 73 Maya LOG NO. _____ AREA _____

DEPARTMENT OF BUILDING & SAFETY
CITY OF LAS VEGAS, NEVADA

KARDEX CARD
FENCE & RETAINING WALLS

OWNER R. Pachecokeyes ADDRESS 73 Maya DATE 6/10/70

CONTRACTOR Fencing Inc PERMIT NO. 53765

LOT 1 BLOCK 2 SUBDIVISION Palomar Estates
Wire

Fence (wire, wood, etc.)	Walls (masonry, rock, etc.)
Location _____	Location _____
Final Inspection <u>10-6-70</u>	Footings _____
	Wall Steel 1st _____ 2d _____ 3d _____
	Final Inspection _____
Retaining Wall (masonry)	Retaining Wall (concrete)
Location _____	Location _____
Footings _____	Footings _____
Wall Steel 1st _____ 2d _____ 3d _____	Wall Steel 1st _____ 2d _____ 3d _____
Bond Beam 1st _____ 2d _____ 3d _____	Final Inspection _____
Final Inspection _____	

23.14 B ADDRESS 73 Maya LOG NO. _____ AREA _____

Dona Treacy 9-15-82

DEPT. of BLDG & SAFETY—CITY of LAS VEGAS, NEVADA

OWNER Mestler-Jacquot, Inc ADDRESS 73 Maya Street DATE 7-31-63

GEN CONT Same TYPE OF STRUCTURE SED

PERMIT NO. 18302 LEGAL DESCRIPTION Int 1 Block 2 Palomar Est

BUILDING		MECHANICAL		ELECTRICAL	
LOCATION	<u>W 5-6-64</u>	PLUMBING CONT.	<u>W 5-6-64</u>	TEMP. POLE CONT.	<u>W 5-6-64</u>
FIREPLACE FTS.		PERMIT NO.	<u>15667</u>	PERMIT NO.	<u>139063</u>
FOOTINGS	<u>W 5-6-64</u>	HEAT & VENT. AC CONT.	<u>W 5-6-64</u>	INSPECTION	<u>W 5-6-64</u>
FOUNDATION WALL	<u>W 5-6-64</u>	PERMIT NO.	<u>1436</u>	ELECTRICAL CONT.	<u>W 5-6-64</u>
FLOOR FRAMING		SEWER CONT.	<u>W 5-6-64</u>	PERMIT NO.	<u>139063</u>
SLAB	<u>W 5-6-64</u>	PERMIT NO.	<u>15667</u>	FIXTURES CONT.	<u>W 5-6-64</u>
CHIMNEY STEEL (FIREPLACE)		ROUGH SOL.	<u>W 5-6-64</u>	PERMIT NO.	<u>139063</u>
WALL STEEL		ROUGH WATER	<u>W 5-6-64</u>	SLAB	
COLUMN STEEL		TOP-OUT	<u>W 5-6-64</u>	ROUGH	<u>W 5-6-64</u>
BEAM STEEL		ROUGH GAS	<u>W 5-6-64</u>	FINAL ROUGH	
FRAMING	<u>W 5-6-64</u>	AC ROUGH DUCT	<u>W 5-6-64</u>	FINAL FIXTURE	
ROOF SHEATHING	<u>W 5-6-64</u>	REF. ROUGH PIPING		FINAL ELECTRICAL	<u>W 5-6-64</u>
DRYWALL	<u>W 5-6-64</u>	FINAL PLUMBING	<u>W 5-6-64</u>	TEMPORARY SERVICE	
LATHING	<u>W 5-6-64</u>	FINAL GAS			
BACKING (SIDING)	<u>W 5-6-64</u>	FINAL AIR COND.	<u>W 5-6-64</u>	MISCELLANEOUS	
PLASTER	<u>W 5-6-64</u>	FINAL REFRIG.		GRADING & DRAINAGE	
URBAN REDEVELOPMENT APPROVAL		FINAL SEWER		ON-SITE PARKING SPACES	
		FINAL SEPTIC TANK		ENG. APPROVAL OF	
FINAL BLDG	<u>W 5-6-64</u>			OFF-SITE IMPROVEMENTS	
DATE	<u>7-22-64</u>				

APPROVED FOR OCCUPANCY & METER 6053 INSPECTOR 7 DATE 7-22-64

PLEASE NOTE REMARKS ON REVERSE SIDE

73 Maya Street

LOG: # 71 AREA: # 2 23.04

DEPT. of BLDG & SAFETY—CITY of LAS VEGAS, NEVADA

OWNER 1st Western ADDRESS 73 Maya DATE 8/22/68

GEN CONT. HERMAN KAUFMAN TYPE OF STRUCTURE REHAB

PERMIT NO. 43979 LEGAL DESCRIPTION

BUILDING		MECHANICAL		ELECTRICAL	
LOCATION		PLUMBING CONT.		TEMP. POLE CONT.	
FIREPLACE FTS.		PERMIT NO.		PERMIT NO.	
FOOTINGS		HEAT & VENT. AC CONT.		INSPECTION	
FOUNDATION WALL		PERMIT NO.		ELECTRICAL CONT.	
FLOOR FRAMING		SEWER CONT.		PERMIT NO.	
SLAB		PERMIT NO.		FIXTURES CONT.	
CHIMNEY STEEL (FIREPLACE)		ROUGH SOL.		PERMIT NO.	
WALL STEEL		ROUGH WATER		SLAB	
COLUMN STEEL		TOP-OUT		ROUGH	
BEAM STEEL		ROUGH GAS		FINAL ROUGH	
FRAMING		AC ROUGH DUCT		FINAL FIXTURE	
ROOF SHEATHING		REF. ROUGH PIPING		FINAL ELECTRICAL	
DRYWALL		FINAL PLUMBING		TEMPORARY SERVICE	
LATHING		FINAL GAS			
BACKING (SIDING)		FINAL AIR COND.		MISCELLANEOUS	
PLASTER		FINAL REFRIG.		GRADING & DRAINAGE	
URBAN REDEVELOPMENT APPROVAL		FINAL SEWER		ON-SITE PARKING SPACES	
		FINAL SEPTIC TANK		ENG. APPROVAL OF	
FINAL BLDG				OFF-SITE IMPROVEMENTS	
DATE					

APPROVED FOR OCCUPANCY & METER Q 8 9-22-68 INSPECTOR 1 DATE 8/22/68

PLEASE NOTE REMARKS ON REVERSE SIDE

73 Maya

LOG: # 71 AREA: # 2 23.04

Dona Tread

9-15-52

Fitz Child rules

2nd permit 11099

5-29-57

JACKIE B.

2-27-86

OWNER <u>L. Pacheco</u>		ADDRESS <u>73 Maya Street</u>	
DATE <u>6-22-81</u>		GEN. CONT. <u>owner</u>	
TYPE OF STRUCTURE <u>extend Room</u>		PERMIT NO. <u>2217</u>	
LEGAL DESCRIPTION <u>Palomar Estates</u>		FINAL INSPECTION <u>LOG #</u>	
APPROVED FOR OCUPANCY & METER			
BUILDING		MECHANICAL	
Investigation		Plumbing Cont.	
Location & Footing		Permit No. Date	
Concrete Slab Floor <u>1510-1281</u>		Heat & Vent. A/C Cont.	
Fireplace Footing		Permit No. Date	
Chimney Steel		Sewer Cont.	
Vert. Steel Joint		Permit No. Date	
Horiz. Steel Joint		Rough Soil	
Framing <u>1511-281</u>		Rough Water	
Ext. Lath		Top-Out	
Ext. Brown		Rough Gas	
Drainage		A/C Rough Duct	
Final Building <u>1512-82</u>		Final Plumbing	
Appr. for Occu.		Final Gas	
ELECTRICAL		Final Air Cond.	
Temp. Pole Connection		Final Sewer	
Permit No. Date		REMARKS	
Inspection Date			
Electrical Cont. <u>owner</u>			
Permit No. <u>2217-1</u> Date <u>6/22/81</u>			
Rough		PLEASE NOTE ADDITIONAL REMARKS ON REVERSE SIDE.	
Final Rough		DIV. OF BLDG. & SAFETY CITY OF LAS VEGAS REV. 10-78	
Final Electrical <u>1512-81</u>		79-1-16	
Temporary Service		Final <u>1510-81</u>	