

1405 E MC WILLIAMS

L114 B11 G L V ADD TR #2 ZONE R-1

M. Matewood 11-7-79

CITY OF LAS VEGAS, NEVADA

LOG NO. & AREA

DEPARTMENT OF BUILDING & SAFETY

CONST. VAL. \$

320.00

APPLICATION & BUILDING PERMIT - for:
Fence, Wall, Retaining Wall.

ADDRESS OF
CONSTRUCTION:

1405 E. Mc WILLIAMS

OWNER: ROBERT H. WALL

LOT(s)

BLOCK

SUBDIVISION

GREATER L.V. ADD. TR 2

ZONE: R-1

Materials of Construction:

Block ☒

Concrete ☐

Wire ☐

Wood ☐

Other ☐

Yes No

PLANS: ☐ ☐

CALCS: ☐ ☐

ARCHITECT:

ENGINEER:

CONTRACTOR:

OWNER

STATE
LICENSE #

CITY
LICENSE #

TOTAL SQUARE FEET:

320


TOTAL LINEAL FEET:

80 ft?

Remarks:

CONDITIONS OF THE PERMIT:

1. Any type of retaining wall must be engineered by a Civil or Structural Engineer.
2. If a home owner takes out the Building Permit and if the owner sublets the work to a Contractor, then the Contractor must take out the permit and pay for it.
3. No fence or wall can be built on City property or rights-of-way, but this is not intended to preclude construction within utility easements if utilities will not be damaged or made inaccessible.
4. The fence or wall shall not enclose any water meter, light standard, or fire alarm box and shall not come closer than 24" from the nearest fire hydrant outlet.
5. Department inspectors must approve footings before concrete is poured and block wall reinforcing before grouting is done.
6. Maximum height of any wall or fence is 6', side and rear yards; 4' maximum in front yard with the vertical surface above the height of 2' - 50% open.
7. I must not obstruct required onsite parking space (1 space for each dwelling unit) by the erection of this fence or wall.
8. By the signing of this application I herewith agree to the requirements outlined above.

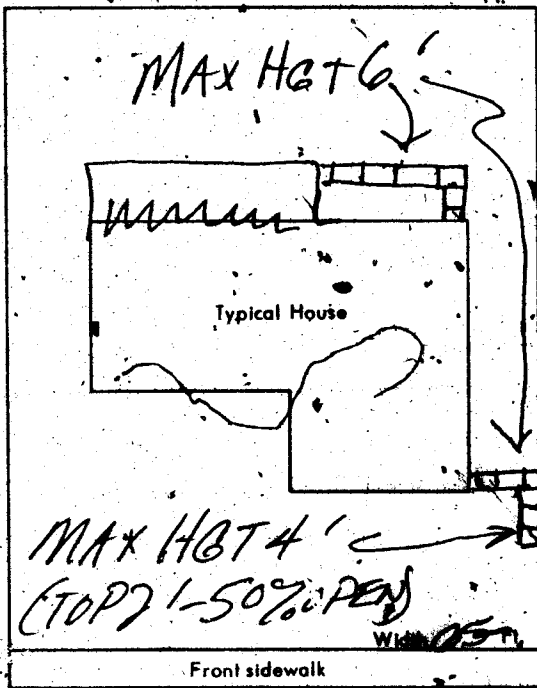

SIGNED:

Margaret A. Wall

DATE:

4-10-70

CONTRACTOR ☐

AGENT ☐

OWNER ☒

PLANNING DEPT.:

M.C.

DATE:

4-10-70

PUBLIC WORKS DEPT.:

DATE:

4-10-70

BUILDING DEPT.:

[Signature]

DATE:

4-10-70

#12850

PERMIT NO.:

51889

PERMIT FEE \$

6.00

RECEIPT

2019 \$006.00 - 8

CITY OF LAS VEGAS
DEPT. OF
BUILDING & SAFETY

MUST BE MACHINE VALIDATED

10 APR 70

F.Y. Matherwood 11-7-79

CITY OF LAS VEGAS, NEVADA

LOG NO. & AREA

DEPARTMENT OF BUILDING & SAFETY

APPLICATION & BUILDING PERMIT - for:

Dwellings, Duplexes, Misc. Residential Const.

ADDRESS OF CONSTRUCTION:

1405 E. McWilliams

OWNER:

Robert H. Hall

LOT:

114

BLOCK:

11

SUBDIVISION:

GREATER LAS VEGAS APP. #2

ZONE:

R1

Existing structure on lot:

Dwelling ☒

Accessory bldgs. ☐

Vacant lot ☐

Other ☐

PROPOSED CONSTRUCTION:

Patio Cover

USE:

Patio

MATERIALS OF CONSTRUCTION:

Wood Frame ☐

Concrete Block ☐

Reinforced Concrete ☐

Steel Frame ☐

SQUARE FEET OF FLOOR AREAS:

1st

2nd

3rd

Other

TOTAL SQ. FT.

FIRE ZONE:

1 2 3

Occupancy Group

A

B

C

D

E

F

G

H

I

J













CONST. TYPE:

I

II

III

IV

V

ARCHITECT:

ENGINEER:

NO. of UNITS

NO. of STORIES

Plans Submitted:

Yes ☐

No ☐

Calculations Submitted

Yes ☐

No ☐

Sewer Fee Req'd.

Yes ☐

No ☐

CONTRACTOR:

OWNER

STATE

LICENSE #

CITY

LICENSE #

ADD'L. PERMITS REQ'D:

Air Cond. ☐

Elec. ☐

Plumbing ☐

Signs ☐

Paving ☐


Fence ☐

Public Walks ☐

Curb-gutters ☐

Incinerators ☐

Fire Sprinkling System ☐

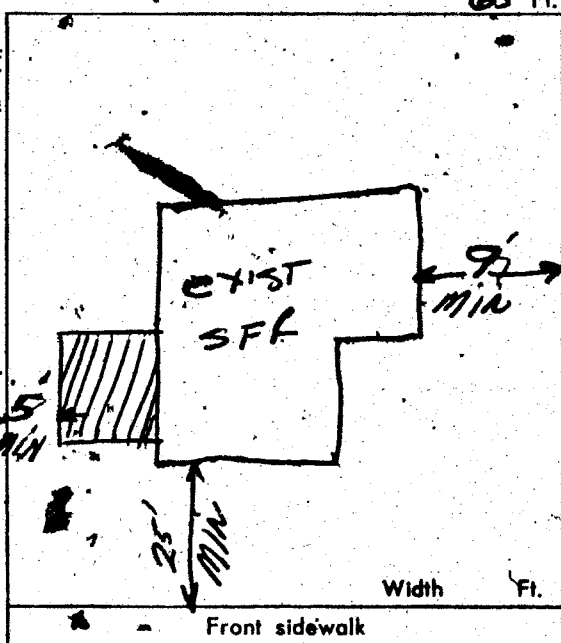

CONDITIONS OF THE PERMIT:

1. I agree to call the City Building Department for inspections before concrete is poured, before rough wiring, electrical, plumbing, framing is covered. Also for Air conditioning, sheet-rock and sheathing inspection.
2. I agree that when the job is completed that I will call for final inspection before occupancy.
3. I agree to perform all construction in accordance with City Ordinances and Building Codes.
4. The Contractor's signature below denotes authority from the owner to sign in his behalf and that the owner is aware of all requirements of this application and permit. Separate permits must be taken out for work outlined above this agreement.
5. I have read and understand the contents of this application and permit; I hereby state that the information I have supplied on this application is true and correct.

SIGNED:

Contractor

BY:

Margaret H. Hall

Agent or Owner

Date

CLARK COUNTY HEALTH DEPT.

Date

LAS VEGAS FIRE DEPARTMENT

PLANNING DEPT:

[Signature]

Date:

5-14-70

PUBLIC WORKS DEPT:

Date:

BUILDING DEPT:

[Signature]

Date:

5-14-70

*12850

PERMIT NO.:

53350

PERMIT FEE \$

700

RECEIPT

4107 \$1000.00 - 8

CITY OF LAS VEGAS

DEPT. OF BUILDING & SAFETY

MUST BE MACHINE VALIDATED

14 MAY 70

Y. Gatewood 11-7-79

CITY OF LAS VEGAS, NEVADA

LOG NO. & AREA

CONST. VAL. \$ 270

DEPARTMENT OF BUILDING & SAFETY

APPLICATION & BUILDING PERMIT - for:

Dwellings, Duplexes, Misc. Residential Const.

ADDRESS OF CONSTRUCTION: 1405 E. McWILLIAMS

OWNER: ROBERT H. WALL

LOT(s) 114 BLOCK 11 SUBDIVISION GREATER LV. ADD TR. 2 ZONE: R-1

Existing structure on lot: Dwelling ☒ Accessory bldgs. ☐ Vacant lot ☐ Other ☐

PROPOSED CONSTRUCTION: PATIO SLAB USE: SAME

MATERIALS OF CONSTRUCTION: Wood Frame ☐ Concrete Block ☐ Reinforced Concrete ☐ Steel Frame ☐

SQUARE FEET OF FLOOR AREAS: 1st 2nd 3rd Other TOTAL SQ. FT.


FIRE ZONE: 1 2 3 Occupancy Group A B C D E F G H I J-1-2-3-4-5 CONST. TYPE: I II III IV V

ARCHITECT: ENGINEER: NO. of UNITS NO. of STORIES

Plans Submitted: Yes ☐ No ☐ Calculations Submitted: Yes ☐ No ☐ Sewer Fee Req'd. Yes ☐ No ☐

CONTRACTOR: OWNER STATE LICENSE # CITY LICENSE #

ADD'L. PERMITS REQ'D: Air Cond. ☐ Elec. ☐ Plumbing ☐ Signs ☐ Paving ☐ Fence ☐ Public Walks ☐ Curb-gutters ☐ Incinerators ☐ Fire Sprinkling System ☐

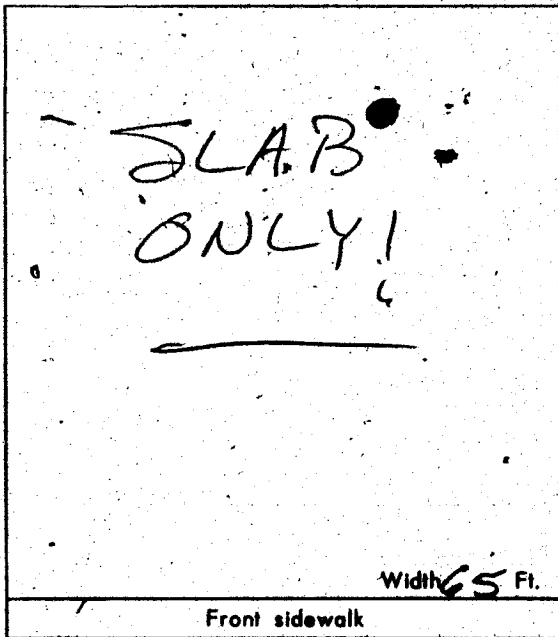

CONDITIONS OF THE PERMIT:

1. I agree to call the City Building Department for inspections before concrete is poured, before rough wiring, electrical, plumbing, framing is covered. Also for Air conditioning, sheet-rock and sheathing inspection.
2. I agree that when the job is completed that I will call for final inspection before occupancy.
3. I agree to perform all construction in accordance with City Ordinances and Building Codes.
4. The Contractor's signature below denotes authority from the owner to sign in his behalf and that the owner is aware of all requirements of this application and permit. Separate permits must be taken out for work outlined above this agreement.
5. I have read and understand the contents of this application and permit; I hereby state that the information I have supplied on this application is true and correct.

SIGNED: Contractor

BY: Margaret A. Wall Agent or Owner

CLARK COUNTY HEALTH DEPT.

LAS VEGAS FIRE DEPARTMENT

PLANNING DEPT:

PUBLIC WORKS DEPT:

BUILDING DEPT:

*12850

PERMIT NO:

53645

PERMIT FEE \$

5.00

RECEIPT
5246 \$005.00
CITY OF LAS VEGAS
DEPT. OF BUILDING & SAFETY
MUST BE MACHINE VALIDATED

M. Matherwood 11-7-79

CITY OF LAS VEGAS, NEVADA

LOG NO. & AREA

DEPARTMENT OF BUILDING & SAFETY

CONST. VAL. \$

300.00

APPLICATION & BUILDING PERMIT — for:
Dwellings, Duplexes, Misc. Residential Const.

ADDRESS OF
CONSTRUCTION:

1405 Mth WILLIAMS

OWNER:

Robert Wall

LOT(s)

BLOCK

SUBDIVISION

ZONE:

Existing structure on lot: Dwelling

☐

Accessory bldgs.

☐

Vacant lot

☐

Other

☐

PROPOSED CONSTRUCTION:

RE-ROOF

USE:

MATERIALS OF CONSTRUCTION:

Wood Frame

☐

Concrete Block

☐

Reinforced Concrete

☐

Steel Frame

☐

SQ. FEET OF FLOOR AREAS: 1st

2nd

3rd

Other

TOTAL SQ. FT.

FIRE ZONE: 1 2 3

Occupancy Group

1

J

1-2

CONST. TYPE: I II III IV V

ARCHITECT:

ENGINEER:

NO. of UNITS

NO. of STORIES

Plans Submitted: Yes

☐

No

☐

Calculations Submitted

Yes

☐

No

☐

Sewer Fee Req'd.

Yes

☐

No

☐

CONTRACTOR:

BURGESS ROOFING

STATE

LICENSE #

11311

CITY

LICENSE #

4872

ADD'L. PERMITS REQ'D: Air Cond.

☐

Elec.

☐

Plumbing

☐

Signs

☐

Paving

☐

Fence

☐

Public Walks

☐

Curb-gutters

☐

Incinerators

☐

Fire Sprinkling System

☐

CONDITIONS OF THE PERMIT:

1. I agree to call the City Building Department for inspections before concrete is poured, before rough wiring, electrical, plumbing, framing is covered. Also, for air conditioning, sheet-rock and sheathing inspection.
2. I agree that when the job is completed that I will call for final inspection before occupancy.
3. I agree to perform all construction in accordance with City Ordinances and Building Codes.
4. The Contractor's signature below denotes authority from the owner to sign in his behalf and that the owner is aware of all requirements of this application and permit. Separate permits must be taken out for work outlined above this agreement.
5. I have read and understand the contents of this application and permit; I hereby state that the information I have supplied on this application is true and correct.

SIGNED:

W. F. Burgess

Contractor

BY:

Agent or Owner

CLARK COUNTY HEALTH DEPT.

Date

LAS VEGAS FIRE DEPARTMENT

Date

PLANNING DEPT.:

Date:

PUBLIC WORKS DEPT.:

Date:

BUILDING DEPT.:

Date:

#12850

PERMIT NO.:

7257

PERMIT FEE \$

500

RECEIPT

3830 \$005.00 - 8

CITY OF LAS VEGAS
DEPT. OF
BUILDING & SAFETY

MUST BE MACHINE VALIDATED

20 SEP 72

Don't know

9-17-82

DEPT. of BLDG & SAFETY—CITY of LAS VEGAS, NEVADA
 OWNER Robert Wall ADDRESS 1405 McWilliams DATE 9-20-72
 GEN. CONT. Burgess Roofing TYPE OF STRUCTURE no roof
 PERMIT NO. 7257 LEGAL DESCRIPTION _____

BUILDING		MECHANICAL	ELECTRICAL
LOCATION _____		PLUMBING CONT. _____	TEMP. POLE CONT. _____
FIREPLACE FTS. _____		PERMIT NO. _____ DATE _____	PERMIT NO. _____ DATE _____
FOOTINGS _____		HEAT & VENT. AC CONT. _____	INSPECTION _____ DATE _____
FOUNDATION WALL _____		PERMIT NO. _____ DATE _____	ELECTRICAL CONT. _____
FLOOR FRAMING _____		SEWER CONT. _____	PERMIT NO. _____ DATE _____
SLAB _____		PERMIT NO. _____ DATE _____	FIXTURES CONT. _____
CHIMNEY STEEL (FIREPLACE) _____		ROUGH SOIL _____	PERMIT NO. _____ DATE _____
WALL STEEL _____		ROUGH WATER _____	SLAB _____
COLUMN STEEL _____		TOP-OUT _____	ROUGH _____
BEAM STEEL _____		ROUGH GAS _____	FINAL ROUGH _____
FRAMING _____		AC ROUGH DUCT _____	FINAL FIXTURE _____
ROOF SHEATHING _____		REF. ROUGH PIPING _____	FINAL ELECTRICAL _____
INTERIOR _____	EXTERIOR _____	FINAL PLUMBING _____	TEMPORARY SERVICE _____
DRYWALL _____	_____	FINAL GAS _____	MISCELLANEOUS _____
LATHING _____	_____	FINAL AIR COND. _____	GRADING & DRAINAGE _____
BACKING (SIDING) _____	_____	FINAL REFRIG. _____	ON-SITE PARKING SPACES _____ APP. _____
PLASTER SCRATCH _____	_____	FINAL SEWER _____	ENG. APPROVAL OF _____
PLASTER BROWN _____	_____	FINAL SEPTIC TANK _____	OFF-SITE IMPROVEMENTS _____
URBAN REDEVELOPMENT APPROVAL _____			
FINAL BLDG _____ DATE _____			

APPROVED FOR OCCUPANCY & METER SC 9-25-72 INSPECTOR _____ DATE _____
 PLEASE NOTE REMARKS ON REVERSE SIDE LOG: # _____ AREA: # _____ 23.04

1405 McWilliams

DEPT. of BLDG & SAFETY—CITY of LAS VEGAS, NEVADA
 OWNER Robert Wall ADDRESS 1405 E. McWilliams DATE 5/14/70
 GEN. CONT. Owner TYPE OF STRUCTURE Patio Cover
 PERMIT NO. 53350 LEGAL DESCRIPTION L 114 R 11 Greater L V #2

BUILDING		MECHANICAL	ELECTRICAL
LOCATION _____		PLUMBING CONT. _____	TEMP. POLE CONT. _____
FIREPLACE FTS. _____		PERMIT NO. _____ DATE _____	PERMIT NO. _____ DATE _____
FOOTINGS _____		HEAT & VENT. AC CONT. _____	INSPECTION _____ DATE _____
FOUNDATION WALL _____		PERMIT NO. _____ DATE _____	ELECTRICAL CONT. _____
FLOOR FRAMING _____		SEWER CONT. _____	PERMIT NO. _____ DATE _____
SLAB <u>5/16/70</u>		PERMIT NO. _____ DATE _____	FIXTURES CONT. _____
CHIMNEY STEEL (FIREPLACE) _____		ROUGH SOIL _____	PERMIT NO. _____ DATE _____
WALL STEEL _____		ROUGH WATER _____	SLAB _____
COLUMN STEEL _____		TOP-OUT _____	ROUGH _____
BEAM STEEL _____		ROUGH GAS _____	FINAL ROUGH _____
FRAMING _____		AC ROUGH DUCT _____	FINAL FIXTURE _____
ROOF SHEATHING _____		REF. ROUGH PIPING _____	FINAL ELECTRICAL _____
INTERIOR _____	EXTERIOR _____	FINAL PLUMBING _____	TEMPORARY SERVICE _____
DRYWALL _____	_____	FINAL GAS _____	MISCELLANEOUS _____
LATHING _____	_____	FINAL AIR COND. _____	GRADING & DRAINAGE _____
BACKING (SIDING) _____	_____	FINAL REFRIG. _____	ON-SITE PARKING SPACES _____ APP. _____
PLASTER SCRATCH _____	_____	FINAL SEWER _____	ENG. APPROVAL OF _____
PLASTER BROWN _____	_____	FINAL SEPTIC TANK _____	OFF-SITE IMPROVEMENTS _____
URBAN REDEVELOPMENT APPROVAL _____			
FINAL BLDG <u>DB</u> DATE <u>6/6/70</u>			

APPROVED FOR OCCUPANCY & METER _____ INSPECTOR _____ DATE _____
 PLEASE NOTE REMARKS ON REVERSE SIDE LOG: # _____ AREA: # _____ 23.04

1405 E. McWilliams

DEPARTMENT OF BUILDING & SAFETY
CITY OF LAS VEGAS, NEVADA

KARDEX CARD
FENCE & RETAINING
WALLS

OWNER Robert Wall ADDRESS 1405 E. McWilliams DATE 4/10/70

CONTRACTOR Owner PERMIT NO. 51984

LOT 114 BLOCK 11 SUBDIVISION Greater L. V. Add #2
Block

Fence (wire, wood, etc.)	Walls (masonry, rock, etc.)
Location _____	Location <u>Wall 4-24-70</u>
Final Inspection _____	Footing <u>0 A. 24-70</u>
	Wall Steel 1st _____ 2d _____ 3d _____
	Final Inspection <u>4-26-70</u>
Retaining Wall (masonry)	Retaining Wall (concrete)
Location _____	Location _____
Footing _____	Footing _____
Wall Steel 1st _____ 2d _____ 3d _____	Wall Steel 1st _____ 2d _____ 3d _____
Bond Beam 1st _____ 2d _____ 3d _____	Final Inspection _____
Final Inspection _____	

23.14 B

ADDRESS 1405 E. McWilliams LOG NO. _____ AREA _____

DEPT. of BLDG & SAFETY - CITY of LAS VEGAS, NEVADA

OWNER Robert Wall ADDRESS 1405 E. McWilliams DATE 6/4/70
GEN. CONT. Owner TYPE OF STRUCTURE Patio Slab
PERMIT NO. 53645 LEGAL DESCRIPTION L 114 B 11 Greater L. V. Add #2

BUILDING	MECHANICAL	ELECTRICAL
LOCATION _____	PLUMBING CONT. _____	TEMP. POLE CONT. _____
FIREPLACE FPG. _____	PERMIT NO. _____ DATE _____	PERMIT NO. _____ DATE _____
FOOTINGS _____	HEAT & VENT. AC CONT. _____	INSPECTION _____ DATE _____
FOUNDATION WALL _____	PERMIT NO. _____ DATE _____	ELECTRICAL CONT. _____
FLOOR FRAMING _____	SEWER CONT. _____	PERMIT NO. _____ DATE _____
SLAB <u>4-26-70</u>	PERMIT NO. _____ DATE _____	FIXTURES CONT. _____
CHIMNEY STEEL (FIREPLACE) _____	ROUGH SOIL _____	PERMIT NO. _____ DATE _____
WALL STEEL _____	ROUGH WATER _____	SLAB _____
COLUMN STEEL _____	TOP-OUT _____	ROUGH _____
BEAM STEEL _____	ROUGH GAS _____	FINAL ROUGH _____
FRAMING _____	AC ROUGH DUCT _____	FINAL FIXTURE _____
ROOF SHEATHING _____	REP. ROUGH PIPING _____	FINAL ELECTRICAL _____
INTERIOR _____ EXTERIOR _____	FINAL PLUMBING _____	TEMPORARY SERVICE _____
DRYWALL _____	FINAL GAS _____	
LATHING _____	FINAL AIR COND. _____	MISCELLANEOUS
BACKING (SIDING) _____	FINAL REFRIG. _____	GRADING & DRAINAGE _____
PLASTER SCRATCH _____	FINAL SEWER _____	ON-SITE PARKING SPACES _____ APP. _____
PLASTER BROWN _____	FINAL SEPTIC TANK _____	ENG. APPROVAL OF _____
URBAN REDEVELOPMENT APPROVAL _____		OFF-SITE IMPROVEMENTS _____
FINAL BLDG <u>6-9-70</u>		

APPROVED FOR OCCUPANCY & METER _____

INSPECTOR _____

DATE _____

PLEASE NOTE REMARKS ON REVERSE SIDE

1405 E. McWilliams

LOG: #

AREA: #

23.04