

3209 MERRITT

L15 33 RICHFIELD VILL #2A ZONE R-1

November 11, 1979 *M. Gatewood*

1966
PERMIT FEE *\$800*
400

CITY OF LAS VEGAS, NEVADA
DEPARTMENT OF BUILDING & SAFETY
APPLICATION & BUILDING PERMIT

RESIDENTIAL
(Single family dwelling, duplex,
miscellaneous residential)

LOG NO. & AREA

CONSTRUCTION
VALUATION: \$ *25200*
INSPECTION
VALUATION: \$ *2000*

SEWER CONN. FEE: \$
(Eng. Dept.)

ADDRESS OF
CONSTRUCTION: *3209 Merritt Ave* OWNER'S NAME: *Mrs. J. De Masi*
LOT(s) *15* BLOCK *6* SUBDIVISION *RICHFIELD VILLAGE # 28* ZONE *R1*
CIRCLE EXISTING STRUCTURE ON LOT: *Dwelling* Accessory Building(s) Vacant Lot
PROPOSED CONSTRUCTION: *Patio Cover* USE

MATERIALS OF CONSTRUCTION: Wood Concrete Reinforced Steel
Frame () Block () Concrete () Frame (X)

SQUARE FEET OF FLOOR AREAS: 1st 2nd TOTAL SQUARE FEET *200*

FIRE ZONE: 1 2 3 OCCUPANCY GROUPS: I (J) 1 2 BUILDING TYPE I II III IV (V)


ARCHITECT'S NAME: ENGINEER'S NAME:

PLANS SUBMITTED: YES NO CALCULATIONS SUBMITTED: YES NO

CONTRACTOR'S NAME: *Owner* State License # City License #

ADDITIONAL PERMITS REQUIRED: Air Conditioning () Electrical () Plumbing ()
If Tract House Insert Model Other ()
Number Here

Rear prop. line *67'7"*

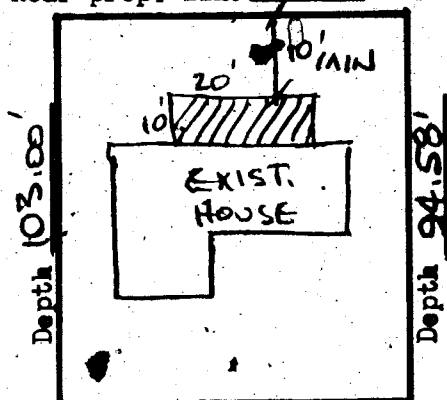

Front prop. line *67'*

STREET *MERRITT AVE.*

I state that I am familiar with effective Ordinances of the City of Las Vegas, Nevada and effective Statutes of the State of Nevada covering construction and use of the above type; I agree to perform said construction in conformity therewith. I further agree that issuance of a permit will not excuse me from conforming with said Ordinances and Statutes despite any errors on the part of the Building Inspector or Engineer in checking plans and applications herewith submitted.

I have read and understand the contents of above application and permit; I hereby state that same are true and correct:

SIGN HERE: *Richard De Masi* Contractor

BY: Agent or Owner

The Contractor's signature above denotes authority from the owner to sign in his behalf and that the owner is aware of all requirements of this application and permit. Separate permits must be obtained for all Electrical, Plumbing, Air Conditioning, Sign, Sidewalk, Paving, Curb & Gutters, Flammable Tank Storage, Incinerator & Fire Sprinkler Systems.

APPROVED BY:

Planning Department *[Signature]* Date: *8/1/66*

Engineering Department *[Signature]* Date:

Building Department *[Signature]* Date: *8-1-66*

#1285 PERMIT NO: *34631* PERMIT FEE \$ *800*

23.08

RECEIPT
842 \$008.00 -- 8

CITY OF LAS VEGAS
DEPT. OF
BUILDING & SAFETY

Must be machine validated

- 1 AUG 66

November 11, 1979 *Y Gatewood*

CITY OF LAS VEGAS, NEVADA

DEPARTMENT OF BUILDING & SAFETY - ELECTRICAL APPLICATION & PERMIT

ADDRESS OF
CONSTRUCTION:

3209 MERRITT

OWNER'S
NAME:

JOHN DEMASI

CIRCLE: New Bldg.: Add'n: Remodel: TYPE OF BLDG.: SFD. APT. PUBLIC COMM.

CONTRACTOR'S NAME:

John Ellet

STATE
LICENSE #

10445

CITY
LICENSE #

3364

NUMBER	FIXTURE OR INSTALLATION	UNIT PRICE	
	Fixture or sockets	.15	
<i>1</i>	Light, receptacle or switch outlet	.20	
	Wall or ceiling space heater	.35	
	Blast coil heater per kilowatt	.35	
	Garbage grinder outlet	.35	
	Dishwasher outlet	.35	
	Clothes dryer outlet	.35	
	Automatic clothes washer	.35	
	Electric range outlet	.35	
	Electric water heater outlet	.35	
	Mercury arc lamp and equipment	.35	
	Special purpose outlet	.85	
	X-ray unit and its appurtenances	5.00	
	Watts of festoon lighting (Watts) First 3,000 watts	4.00	
	for each additional thousand watts	1.50	
<i>2</i>	Horsepower - all motors first horsepower or less	1.75	
	for each additional horsepower	.35	
	Temporary power and lights (temporary pole)	4.00	
	Electric service (including any single meter socket)	3.00	
	for each additional socket	.35	
	Air conditioning service amps	1.50	
	Each KW (KVA) Generator (Transformer) (Welder) KW (KVA)	2.00	
	First 100 KVA - For each additional KW (KVA)	.01	
	Special inspection per hour	4.00	
	Speaker outlets	.15	
	Signal or Alarm outlets	.15	
	Amplifiers	.50	
	Control panels	.25	
	T. V. outlets - master system only	.15	
	Radio outlets	.15	
	Main control racks	1.00	
	T. V. and Radio antennas - master system only	.75	
	Minimum fee for any permit	4.00	
	Total fee		<i>4.60</i>

I hereby certify that I have carefully examined and read the above application; that the same is true and correct; and that the work herein described is to be done in accordance with all the provisions of the applicable Ordinances of the City of Las Vegas, Nevada and State laws whether herein specified or not.

SIGNED

John Ellet
MASTER (ELECTRICIAN) (TECHNICIAN) (OWNER)

DATE

BUILDING DEPARTMENT

DATE

3-2270

*12860

PERMIT NO.

30198

PERMIT FEE: \$

4.00

RECEIPT

1101 \$004.00 - 6

CITY OF LAS VEGAS

MUST BE MACHINE REPRODUCED
BUILDING & SAFETY

27 NOV 30

November 11, 1979 H. Gatewood

CITY OF LAS VEGAS, NEVADA
DEPARTMENT OF BUILDING & SAFETY

RECEIPT
FOR
SEWER CONNECTION FEE

JOB ADDRESS: 3209 MERMIT OWNER'S NAME: J. DEMASI

LOT _____ BLOCK _____ SUBDIVISION _____

QUANTITY	OCCUPANCY	UNIT FEE	AMOUNT
①	Pool 16,900 G2/		37.50
1			

PAID BY: _____

TOTAL	37.50
Less Credit *	— 0 —
TOTAL FEE \$	37.50

* Credit for existing sewer is applied to the new sewer connection fee based on previous type of occupancy and only when the new occupancy requires an additional fee.
This receipt does not authorize the owner or his representative to start any work without obtaining a plumbing permit.

N. Smet
DEPARTMENT OF BUILDING & SAFETY

3-27-79
DATE

73102

RECEIPT NO. 29706 SEWER FEE 37.50

RECEIPT

1099 \$037.50 - 3

CITY OF LAS VEGAS
DEPT. OF
BUILDING & SAFETY
MUST BE MACHINE VALIDATED

27 MAR 79

November 11, 1979 *Gatewood*

1970

PERMIT FEE \$ 18.00

CITY OF LAS VEGAS, NEVADA
DEPARTMENT OF BUILDING & SAFETY
APPLICATION & PERMIT FOR
SWIMMING POOL

CONSTRUCTION
VALUATION: \$ 2600.00
INSPECTION
VALUATION: \$

LOG NO. & AREA

ADDRESS OF CONSTRUCTION: 3209 MERRITT OWNER'S NAME: J. DeMASI

LOT (s) 15 BLOCK 6 SUBDIVISION RICHFIELD Village ZONE R-1

CIRCLE TYPE OF POOL THAT APPLIES: PRIVATE SEMI-PUBLIC PUBLIC

MATERIALS OF CONSTRUCTION: Reinforced Gunite ☒ Reinforced Concrete () Other ()

SQUARE FEET OF SURFACE AREA: 450

ARCHITECT'S NAME: M. Pool ENGINEER'S NAME:

PLANS SUBMITTED: Yes ☐ No ☒ CALCULATIONS SUBMITTED: Yes ☒ No ☐

CONTRACTOR'S NAME: New Pool State 6917 City 0559

ADDITIONAL PERMITS REQUIRED: Electrical () Plumbing () Other ()

I state that I am familiar with effective Ordinances of the City of Las Vegas Nevada and effective Statutes of the State of Nevada covering construction and use of above type; I agree to perform said construction in conformity therewith. I further agree that issuance of a permit on above application will not excuse me from conforming with said Ordinances and Statutes despite any errors on the part of the Building Inspector or Engineer in checking plans and application herewith submitted.

All swimming pools must be fenced before the pool is filled with water. No electric lines shall go over a pool.

I have read and understand the contents of above application; I hereby state that same are true and correct.

SIGN HERE: M. Pool

BY: Jay Gorman
(Contractor)
(Agent or Owner)

The Contractor's signature above denotes authority from the owner to sign on his behalf and that the owner is aware of all requirements of this application. Separate permits must be obtained for all electrical and plumbing work.

CITY SWIMMING POOL ORDINANCE:
Applicant must have separate plot plan showing location of power pole, proposed or existing pool fencing and location of swimming pool.

APPROVED BY:

PLAN. DEPT. M.C. DATE: 3-27-70

ENG. DEPT. DATE:

HEALTH DEPT. DATE:

Sewer Conn. Fee: \$
(Eng. Dept)

BUILDING DEPARTMENT: J. Phib DATE: 3-27-70

#12810 PERMIT NO. 51733 FEE: 18.00

CITY OF LAS VEGAS
DEPT. OF
BUILDING & SAFETY

Must be machine validated

November 11, 1979 G. Gatewood

CITY OF LAS VEGAS, NEVADA

DEPARTMENT OF BUILDING & SAFETY - APPLICATION AND PERMIT FOR PLUMBING

ADDRESS OF
CONSTRUCTION: 3209 MerrittOWNER'S
NAME: JOHN DE MASI

CIRCLE: New Bldg.; Add'n; Remodel; TYPE OF BLDG.: SFD. APT. PUBLIC COMM. POOL

CONTRACTOR'S NAME: COX PLUMBING

STATE
LICENSE # 7596CITY
LICENSE # 10100

UNITS	DESCRIPTION	FEE	TOTAL
	Bathtub	1.00	
	Shower	1.00	
	Lavatory	1.00	
	Toilet	1.00	
	Urinal	1.00	
	Floor Drain	1.00	
	Floor Sink	1.00	
	Wash Tray	1.00	
	Sink	1.00	
	Garbage Disposal	1.00	
	Garbage Disposal (comm.)	3.00	
	Clothes Dryer (gas)	1.00	
	Clothes Washer	1.00	
	Clothes Washer (comm.)	5.00	
	Dishwasher	1.00	
	Dishwasher (commercial)	5.00	
	Dental Unit	10.00	
	Drinking Fountain	1.00	
	Any Water using Equipment	1.00	
1	Water Heater (gas) (elect.)	1.00	1.00
	Sewer System - New, Replacement, or any Drainage System	4.00	
	Grease or Sand Trap	2.00	
	Trailer Trap	2.00	
	Septic Disposal System	4.00	
WATER SOFTENERS			
	Nonpermanent Type	4.00	
	Permanent Type (connected to Drainage)	5.00	
SWIMMING POOLS			
1	Private or Wading Pool	10.00	10.00
	Public or Semi-public	20.00	

UNITS	DESCRIPTION	FEE	TOTAL
WATER DISTRIBUTION SYSTEM			
	Single Family Dwelling	4.00	
	Multiple Family Dwelling plus each unit	4.00 2.00	
	Bldg. Group "A" thru "G" per each floor	6.00	
	Hotel or Motel plus each bath	4.00 1.50	
	Trailer Park plus each space	20.00 1.00	
	Irrigation	4.00	
GAS PIPING SYSTEM			
	Single Family Dwelling	3.00	
	Multiple Family Dwelling plus each unit	6.00 1.00	
	Commercial Bldg. per floor plus each unit	3.00 3.00	
1	Gas Appliance (any type)	1.00	1.00
AUTOMATIC FIRE EXTINGUISHING SYSTEM			
	Underground Piping	10.00	
	Distribution Piping ea. ft.	.01	
	Sprinkler Head each	.10	
	In Range Hood and Vent	5.00	
DRY STANDPIPE SYSTEM			
	Piping	50.00	
	Each Outlet	1.00	
WET STANDPIPE SYSTEM			
	Piping	5.00	
	Fire Hose Cabinet	1.00	
	MINIMUM PERMIT FEE	4.00	
TOTAL PERMIT FEE \$			12.00

I hereby certify that I have carefully examined and read the above application; that the same is true and correct; and that the work herein described is to be done in accordance with all the provisions of the applicable Ordinances of the City of Las Vegas, Nevada and the State Laws, whether herein specified or not.

Signed Wes E. Cox
REGISTERED MASTER PLUMBER, SPEC. CONT'R, OR OWNER

Date: 3-30-70

Building Department

#12870

Permit No. 29714

Permit Fee \$ 12.00

Date: 3-30-70

RECEIPT

\$012.00 - 7

CITY OF LAS VEGAS
DEPT. OF
BUILDING & SAFETY

MUST BE MACHINE STAMPED

30 MAR 70

November 11, 1979 M. Gatewood

CITY OF LAS VEGAS, NEVADA

LOG NO. & AREA

DEPARTMENT OF BUILDING & SAFETY

CONST. VAL. \$ 300

APPLICATION & BUILDING PERMIT — for:
Dwellings, Duplexes, Misc. Residential Const.

ADDRESS OF
CONSTRUCTION:

3209 Merritt

OWNER:

John DeMasi

LOT(s)

145

BLOCK

6

SUBDIVISION

Richfield Village 2A

ZONE:

R1

Existing structure on lot: Dwelling

☐

Accessory bldg.

☐

Vacant lot

☐

Other

☐

070-140-310

PROPOSED CONSTRUCTION:

Alum Patio Cover

USE:

MATERIALS OF CONSTRUCTION:

Wood Frame

☐

Concrete Block

☐

Reinforced Concrete

☐

Steel Frame

☐

SQ. FEET OF FLOOR AREAS:

1st

2nd

3rd

Other

TOTAL SQ. FT.

132

FIRE ZONE: 1 2 3

Occupancy Group 1 J 1 - 2

CONST. TYPE

I II III IV V

ARCHITECT:

ENGINEER:

NO. of UNITS

NO. of STORIES

Plans Submitted:

Yes

☐

No

☐

Calculations Submitted:

Yes

☐

No

☐

Sewer Fee Req'd.

Yes

☐

No

☐

CONTRACTOR:

Dura-Kool Alum

STATE

LICENSE #

11488-A

CITY

LICENSE #

10254

ADD'L. PERMITS REQ'D:

Air Cond.

☐

Elec.

☐

Plumbing

☐

Signs

☐

Paving

☐

Fence


☐

Public Walks

☐

Curb-gutters

☐

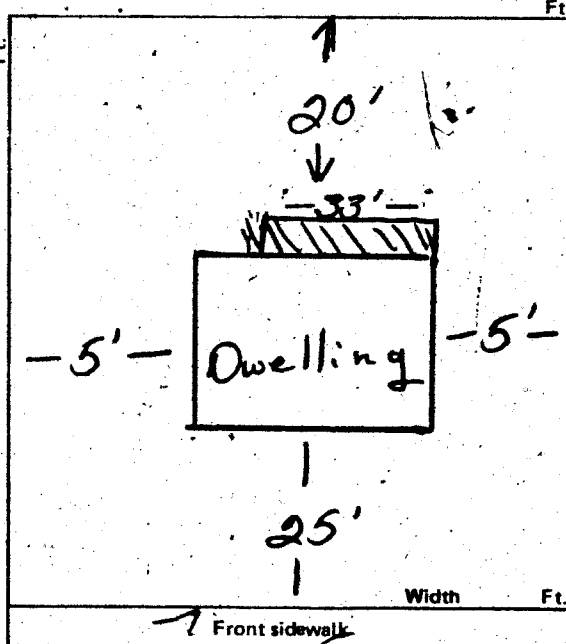

CONDITIONS OF THE PERMIT:

1. I agree to call the City Building Department for inspections before concrete is poured, before rough wiring, electrical, plumbing, framing is covered. Also for air conditioning, sheet-rock and sheathing inspection.
2. I agree that when the job is completed that I will call for final inspection before occupancy.
3. I agree to perform all construction in accordance with City Ordinances and Building Codes.
4. The Contractor's signature below denotes authority from the owner to sign in his behalf and that the owner is aware of all requirements of this application and permit. Separate permits must be taken out for work outlined above this agreement.
5. I have read and understand the contents of this application and permit; I hereby state that the information I have supplied on this application is true and correct.

Approval for the work under this permit will be given only after refuse and debris have been removed from job site and public right of way.

SIGNED: Dura-Kool Alum Prod Inc Contractor

BY: Betty Cohen Agent or Owner

CLARK COUNTY HEALTH DEPT.

LAS VEGAS FIRE DEPARTMENT

PLANNING DEPT.:

Date:

9/25/74

PUBLIC WORKS DEPT.:

Date:

BUILDING DEPT.:

H.T. Rider

Date:

9-25-74

12850

PERMIT NO.:

18634

PERMIT FEE \$

5.00

RECEIPT

7124 \$005.00 - 8

CITY OF LAS VEGAS
DEPT. OF
BUILDING & SAFETY


MUST BE MACHINE VALIDATED.

2-2-74

November 11, 1979 H. Gatewood

CITY OF LAS VEGAS, NEVADA
Department of Building and Safety

CERTIFICATE OF INSPECTION

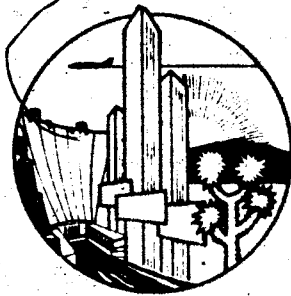

Address 3209 Merritt

Owner F. Jones

Legal LT 15 BL 6 Richfield village 2A Date 8/17/77

This certificate issued pursuant to the requirements of Section 306 of the
UNIFORM BUILDING CODE certifying that at the time of this issuance
the improvements on this property were in compliance with CITY OF LAS
VEGAS, HOUSING, BUILDING, ELECTRICAL, PLUMBING and MECH-
ANICAL CODES

Swimming pool, all patio covers, garage enclosure. existing storage shed
was removed.

DIRECTOR
Department of Building & Safety

This Certificate does not include conditions subject to normal maintenance.

No. 288169

Fee \$ 10.00

12850

RECEIPT

Must be machine validated

8/18/77
PD
WFK


November 11, 1977 *L. Gatewood*

MAYOR BILL BRIARE

COMMISSIONERS
PAUL J. CHRISTENSEN
RON LURIE
MYRON E. LEAVITT
ROY WOOFER

CITY ATTORNEY
CARL E. LOVELL, JR.

CITY MANAGER
WILLIAM E. ADAMS, P.E.

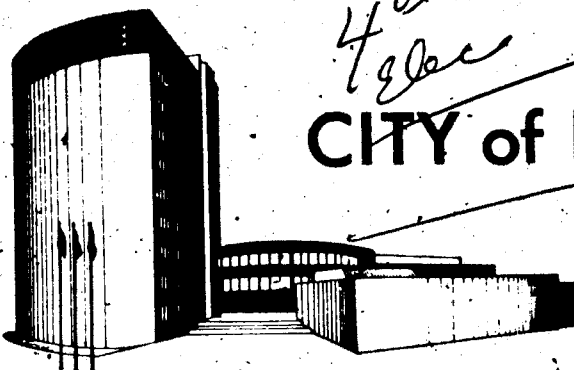

4⁰⁰ 4⁰⁰ 18⁰⁰ Beds
CITY of LAS VEGAS



DEPARTMENT BUILDING & SAFETY

BUILDING INSPECTION REPORT OF REQUIREMENTS FOR COMPLIANCE WITH CITY OF LAS VEGAS
BUILDING CODES AND ZONING ORDINANCE

ADDRESS *3209 Merritt*

OWNER *Frank W. Jones*

DATE *8-9-77*

BLDG. ☒

ELEC. ☒

PLBG. ☐

A.C. ☐

CORRECTIONS TO BE MADE


BLDG. *See notes for side patio cover to be moved back to 5' from P.L.*

ELEC. *Put self closer on panel gate P.L.*

PLBG.

A.C.

MISC.

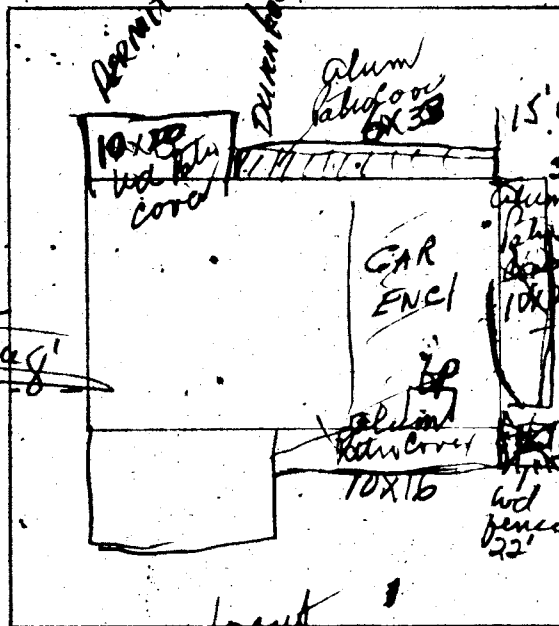

CERTIFICATE OF INSPECTION

APPROVED _____ DATE _____

☒ NOT APPROVED - CALL FOR REINSPECTION. 386 6251

REMARKS *pool patio cover, 74 patio cover, 66*

Dwelling at

BLDG. INSPECTOR _____

1260

400 E. STEWART AVENUE, LAS VEGAS, NEVADA 89101 • (702) 386-6011

November 11, 1979 H. Gatewood

CITY OF LAS VEGAS, NEVADA

9-19

LOG NO. & AREA

CONST. VAL. \$

1260⁰⁰

DEPARTMENT OF PUBLIC SERVICES
DIVISION OF BUILDING AND SAFETY

APPLICATION & BUILDING PERMIT - for:
Dwellings, Duplexes, Misc. Residential Const.

ADDRESS OF CONSTRUCTION: 3209 MERRITT

OWNER: FRANK W. JONES

LOT(s) 15 BLOCK 6 SUBDIVISION RICHFIELD VILLAGE # 2-A ZONE R-1

Existing structure on lot: Dwelling ☒ Accessory Bldgs. ☐ Vacant Lot ☐ Other ☐

PROPOSED CONSTRUCTION: PATIO COVERS ~~STORAGE SHED~~ ^{CERTIFICATION} USE: ^{10x16 & 10x20}

MATERIALS OF CONSTRUCTION: Wood Frame ☐ Concrete Block ☐ Reinforced Concrete ☐ Steel Frame ☐

SQUARE FEET OF FLOOR AREAS: 1st 2nd 3rd Other TOTAL SQ. FT. 360


FIRE ZONE: Occupancy Group CONST. TYPE:

ARCHITECT: ENGINEER: NO. of UNITS NO. of STORIES

Plans Submitted: Yes ☐ No ☐ Calculations Submitted: Yes ☐ No ☐ Sewer Fee Req'd. Yes ☐ No ☐

CONTRACTOR: OWNER STATE LICENSE # CITY LICENSE #

ADD'L. PERMITS REQ'D.: Air Cond. ☐ Elec. ☐ Plumbing ☐ Signs ☐ Paving ☐ Fence ☐ Public Walks ☐ Curb-gutters ☐
Incinerators ☐ Fire Sprinkling System ☐

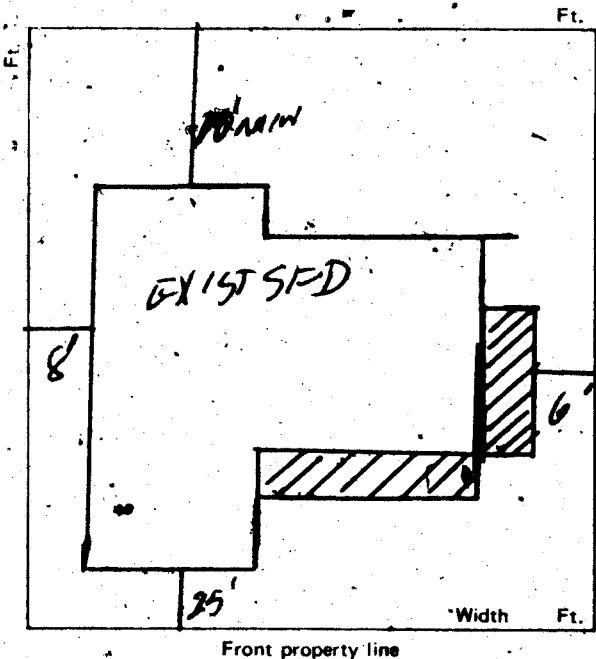

CONDITIONS OF THE PERMIT:

1. I agree to call the City Building Department for inspections before concrete is poured, before rough wiring, electrical, plumbing, framing is covered. Also for Air conditioning, drywall and sheathing inspection.
2. I agree that when the job is completed that I will call for final inspection before occupancy.
3. I agree to perform all construction in accordance with City Ordinances and Building Codes.
4. The Contractor's signature below denotes authority from the owner to sign in his behalf and that the owner is aware of all requirements of this application and permit. Separate permits must be taken out for work outlined above this agreement.
5. I have read and understand the contents of this application and permit. I hereby state that the information I have supplied on this application is true and correct.

Approval for the work under this permit will be given only after refuse and debris have been removed from job site and public right of way.

SIGNED: Contractor

By Frank W. Jones Agent or Owner

PLANNING DEPT.: Date: 8-15-77

PUBLIC WORKS DEPT.: Date: 8-15-77

BUILDING DIVISION: Date: 8-15-77

PERMIT NO.: 4980 PERMIT FEE \$ 1500

154-01-220

RECEIPT

6276 \$015.00 - 8

CITY OF LAS VEGAS

MUST BE MACHINE VALIDATED

15 AUG 77

November 11, 1979 H. Gatewood

MAYOR BILL BRIARE

COMMISSIONERS
PAUL J. CHRISTENSEN
RON LURIE
MYRON E. LEAVITT
ROY WOOFER

CITY ATTORNEY
CARL E. LOVELL, JR.

CITY MANAGER
WILLIAM E. ADAMS, P.E.



CITY of LAS VEGAS



DEPARTMENT BUILDING & SAFETY

BUILDING INSPECTION REPORT OF REQUIREMENTS FOR COMPLIANCE WITH CITY OF LAS VEGAS
BUILDING CODES AND ZONING ORDINANCE

ADDRESS 3209 Morrill

OWNER Frank W. Jones

DATE 8-16-77

PERMITS REQUIRED

BLDG. ☐

ELEC. ☐

PLBG. ☐

A.C. ☐

CORRECTIONS TO BE MADE

BLDG. _____

ELEC. _____

PLBG. _____

A.C. _____

MISC. _____

CERTIFICATE OF INSPECTION

APPROVED ☒ DATE 8-16-77

☐ NOT APPROVED - CALL FOR
REINSPECTION.
386 6251

REMARKS Corrections made permits taken

4970

BLDG. INSPECTOR R. Bailey

November 11, 1979 M. Matwood

CITY OF LAS VEGAS, NEVADA

LOG NO. & AREA

CONST. VAL. \$

DEPARTMENT OF PUBLIC SERVICES
DIVISION OF BUILDING AND SAFETY

APPLICATION & BUILDING PERMIT - for:
Dwellings, Duplexes, Misc: Residential Const.

ADDRESS OF
CONSTRUCTION:

3209 MERITT

OWNER:

FRANK W. JONES

LOT(s)

15

BLOCK

6

SUBDIVISION

RIGHTER VILLAGE 2-A

ZONE

R-1

Existing structure on lot:

Dwelling ☒

Accessory Bldgs. ☐

Vacant Lot ☐

Other ☐

PROPOSED CONSTRUCTION:

10' x 20' + 10' x 16' ALUMINUM PATIO COVERS

CERTIFICATION

MATERIALS OF CONSTRUCTION:

Wood Frame ☐

Concrete Block ☐

Reinforced Concrete ☐

Steel Frame ☐

SQUARE FEET OF FLOOR AREAS: 1st

2nd

3rd

Other

TOTAL SQ. FT.

3600

FIRE ZONE:

Occupancy Group

CONST. TYPE:

ARCHITECT:

ENGINEER:

NO. of UNITS

NO. of STORIES

Plans Submitted:

Yes ☐

No ☐

Calculations Submitted

Yes ☐

No ☐

Sewer Fee Req'd.

Yes ☐

No ☐

CONTRACTOR:

OWNER

STATE
LICENSE #

CITY
LICENSE #

ADD'L. PERMITS REQ'D:

Air Cond. ☐

Elec. ☐

Plumbing ☐

Signs ☐

Fencing ☐

Fence ☐

Public Walks ☐

Curb-gutters ☐

Incinerators ☐

Fire Sprinkling System ☐

CONDITIONS OF THE PERMIT:

- I agree to call the City Building Department for inspections before concrete is poured, before rough wiring, electrical, plumbing, framing is covered. Also for Air conditioning, drywall and sheathing inspection.
- I agree that when the job is completed that I will call for final inspection before occupancy.
- I agree to perform all construction in accordance with City Ordinances and Building Codes.
- The Contractor's signature below denotes authority from the owner, to sign in his behalf and that the owner is aware of all requirements of this application and permit. Separate permits must be taken out for work outlined above this agreement.
- I have read and understand the contents of this application and permit. I hereby state that the information I have supplied on this application is true and correct.

Approval for the work under this permit will be given only after refuse and debris have been removed from job site and public right of way.


SIGNED:

Contractor

BY

Signature of Owner

Agent or Owner

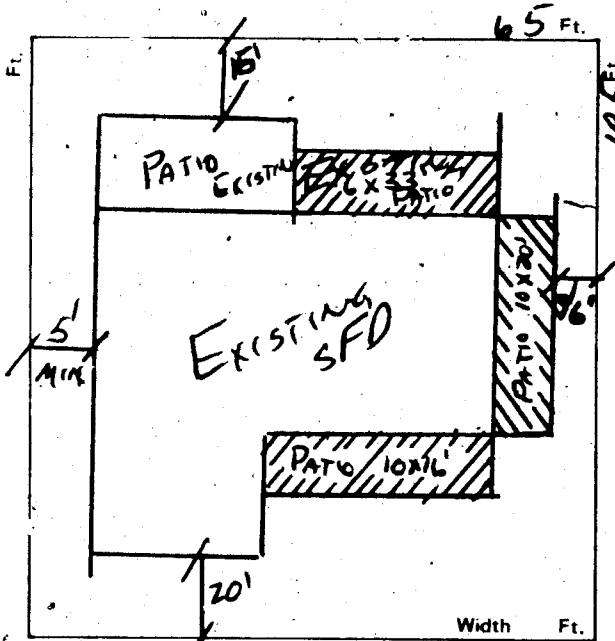

PLANNING DEPT.

Don Bunn

Date:

8-17-77

PUBLIC WORKS DEPT.

Date:

BUILDING DIVISION:

Date:

PERMIT NO.:

5013

PERMIT FEE \$

11.00

154-01-220

RECEIPT.

6522 \$011.00 - 8

CITY OF LAS VEGAS
MUST BE MAILED & VALIDATED
BUILDING & SAFETY

17 AUG 77

Dona Hoidal

9-30-82

DEPT. of BLDG & SAFETY—CITY of LAS VEGAS, NEVADA

OWNER J. DeMoss ADDRESS 3209 Merritt DATE 8/1/66
GEN. CONT. Owner TYPE OF STRUCTURE Patio Cover
PERMIT NO. 34631 LEGAL DESCRIPTION L 15-B 6 Richfield Village #20

BUILDING		MECHANICAL		ELECTRICAL	
LOCATION		PLUMBING CONT.		TEMP. POLE CONT.	
FIREPLACE FTS.		PERMIT NO.	DATE	PERMIT NO.	DATE
FOOTINGS		HEAT & VENT. AC CONT.		INSPECTION	DATE
FOUNDATION WALL		PERMIT NO.	DATE	ELECTRICAL CONT.	
FLOOR FRAMING		SEWER CONT.		PERMIT NO.	DATE
SLAB		PERMIT NO.	DATE	FIXTURES CONT.	
CHIMNEY STEEL (FIREPLACE)		ROUGH SOIL		PERMIT NO.	DATE
WALL STEEL		ROUGH WATER		SLAB	
COLUMN STEEL		TOP-OUT		ROUGH	
BEAM STEEL		ROUGH GAS		FINAL ROUGH	
FRAMING		AC ROUGH DUCT		FINAL FIXTURE	
ROOF SHEATHING		REF. ROUGH PIPING		FINAL ELECTRICAL	
INTERIOR		FINAL PLUMBING		TEMPORARY SERVICE	
EXTERIOR		FINAL GAS			
DRYWALL		FINAL AIR COND.		MISCELLANEOUS	
LATHING		FINAL REFRIG.			
BACKING (STONS)		FINAL SEWER		GRADING & DRAINAGE	
SCRATCH		FINAL SEPTIC TANK		ON-SITE PARKING SPACES	
PLASTER				ENG. APPROVAL OF	
BROWN				OFF-SITE IMPROVEMENTS	
URBAN REDEVELOPMENT APPROVAL					
FINAL BLDG	DATE				

APPROVED FOR OCCUPANCY & METER Inspector INSPECTOR 8-1-66 DATE
PLEASE NOTE REMARKS ON REVERSE SIDE 3209 Merritt LOG # 1 AREA # 23.04

DIVISION of BUILDING & SAFETY—CITY of LAS VEGAS, NEVADA

OWNER Frank W. Jones ADDRESS 3209 Merritt DATE 8-17-77
GEN. CONT. owner TYPE OF STRUCTURE alum patio (certifi)
PERMIT NO. 5013 LEGAL DESCRIPTION lot 15, block 6, Richfield Village

BUILDING		MECHANICAL		ELECTRICAL	
Investigation		Plumbing Cont.		Temp. pole cont.	
Location & Footing		Permit No.	DATE	Permit No.	DATE
Stem Wall		Heat & Vent. A/C Cont.		Inspection	DATE
Concrete Slab Floor		Permit No.	DATE	ELECTRICAL CONT.	
Floor Framing		Sewer Cont.		Permit No.	DATE
Fireplace Footing		Permit No.	DATE	Fixtures Cont.	
Chimney Steel		ROUGH SOIL		Permit No.	DATE
Vert. Steel Reinf.		ROUGH WATER		SLAB	
Horiz. Steel Reinf.		TOP-OUT		ROUGH	
Roof Sheathing		ROUGH GAS		FINAL ROUGH	
Framing		A/C ROUGH DUCT		FINAL FIXTURE	
Backing for siding		REF. ROUGH PIPING		FINAL ELECTRICAL	
Ext. Lath		FINAL PLUMBING		TEMPORARY SERVICE	
Ext. Scratch		FINAL GAS			
Ext. Brown		FINAL AIR COND.		MISCELLANEOUS	
Int. Lath		FINAL REFRIG.			
Int. Brown		FINAL SEWER		GRADING & DRAINAGE	
Drywall		FINAL SEPTIC TANK		ON-SITE PARKING SPACES	
Insulation				ENG. APPROVAL OF	
Final Building				OFF-SITE IMPROVEMENTS	
Appr. for Occu.					

INSPECTOR: _____ DATE _____
APPROVED FOR OCCUPANCY & METER _____
PLEASE NOTE REMARKS ON REVERSE SIDE 3209 Merritt LOG # _____ AREA # _____ 76-114

Dona Hovady 9-30-82

DIVISION of BUILDING & SAFETY - CITY of LAS VEGAS, NEVADA		
OWNER	Frank W. Jones	ADDRESS 3209 Merritt
GEN. CONT.	Owner	DATE 8-15-77
PERMIT NO.	4980	TYPE OF STRUCTURE Patio Cover (Certifica)
LEGAL DESCRIPTION E-15 B-6 Richfield Village #2-A		
BUILDING	MECHANICAL	ELECTRICAL
Investigation	Plumbing Cont.	Temp. pole cont.
Location & Footing	Permit No. _____ Date _____	Permit No. _____ Date _____
Stem Wall	Heat & Vent. A/C Cont.	Inspection _____ Date _____
Concrete Slab Floor	Permit No. _____ Date _____	Electrical Cont.
Floor Framing	Sewer Cont.	Permit No. _____ Date _____
Fireplace Footing	Permit No. _____ Date _____	Fixtures Cont.
Chimney Steel	Rough Soil	Permit No. _____ Date _____
Vert. Steel Reinf.	Rough Water	Slab
Horiz. Steel Reinf.	Top-Out	Rough
Roof Sheathing	Rough Gas	Final Rough
Framing	A/C Rough Duct	Final Fixture
Backing for siding	Ref. Rough Piping	Final Electrical
Ext. Lath	Final Plumbing	Temporary Service
Ext. Scratch	Final Gas	MISCELLANEOUS
Ext. Brown	Final Air Cond.	Grading & Drainage
Int. Lath	Final Refrig.	On-Site Parking Spaces App.
Int. Brown	Final Sewer	Eng. Approval of
Drywall	Final Septic Tank	Off-Site Improvements
Insulation		
Final Building		
Appr. for Occu.		

INSPECTOR: _____

DATE _____

APPROVED FOR OCCUPANCY & METER _____

PLEASE NOTE REMARKS ON REVERSE SIDE 3209 Merritt

LOG # _____

AREA # _____

76-114

DEPT. of BLDG. & SAFETY - CITY of LAS VEGAS, NEVADA		
OWNER, ALAMEDA HOMES CORP.	ADDRESS 3209 MERRITT AVENUE	DATE 8-28-61
GEN. CONT. SAME		TYPE OF STRUCTURE DWELLING
PERMIT NO. 5878	LEGAL DESCRIPTION Lot 15, Blk. 6, Richfield Village #2	
LOCATION	FIREPLACE FTS.	PLUMBING CONT.
FOOTINGS	PILES	PERMIT NO. _____ DATE _____
FOUND	PIERS	HEAT & VENT. CONT.
FLOOR	SLAB	PERMIT NO. _____ DATE _____
ANCHOR BOLTS	BASE PLATES	SEWER CONT.
WALL STEEL		PERMIT NO. _____ DATE _____
COLUMN STEEL		ROUGH SOIL
BEAM STEEL		ROUGH WATER
FRAMING	11-20-61	TOP-OUT
ROOF SHEATHING	11-20-61	ROUGH GAS
STEEL FABRICATION		AC ROUGH DUCT
STEEL CONNECTION		REF. ROUGH PIPING
LATHING	INTERIOR	SEWER
BACKING	EXTERIOR	SEPIC TANK
PLASTER	SCRATCH	FINAL PLUMBING
FINAL BLOS.	BROWN 2-14-62	FINAL GAS
GRADING & DRAINAGE	DATE 2-14-62	FINAL HEATING
ON-SITE PARKING	SPACES	FINAL AIR COND.
ENG. APPROVAL OF		FINAL REFRIG.
OFF-SITE IMPROVEMENTS		
APPROVED FOR OCCUPANCY _____		
APPROVED FOR METER _____		
PLEASE NOTE REMARKS ON REVERSE SIDE 3209 MERRITT AVE.		

LOG# T-12

AREA: # 4

23.04

Done Hvalby 9.30-82

DEPARTMENT OF BUILDING & SAFETY
CITY OF LAS VEGAS, NEVADA

KARDEX CARD
SWIMMING POOL

OWNER J. DEMASI ADDRESS 3209 Merritt DATE 3/27/70
CONTRACTOR NEVADA POOLS PERMIT NO. 51733
LOT 15 BLOCK HH 6 SUBDIVISION Richfield Village 2-A

LOCATION Q84970 FINAL PLUMBING _____
ROUGH SOIL Q84970 FINAL ELECTRIC PM43070
ROUGH WATER Q84970 FINAL GAS W542370
ROUGH GAS _____ FINAL SEWER _____
ROUGH ELECTRIC 1st Q84970 2d 3d FINAL SEPTIC TANK _____
STEEL INSPECTION Q84970

Sewer J. Demasi 29706 3/27/70

FINAL POOL INSPECTION Baily DATE 3-1-71

Potter Elec. 30198 3/27/70
64 Olby 29714 3-30-70 (Inspector)

23.24 B ADDRESS 3209 Merritt LOG NO. _____ AREA _____

DEPT. of BLDG. & SAFETY - CITY of LAS VEGAS, NEVADA

OWNER John DeMasi ADDRESS 3209 Merritt DATE 9-26-74
GEN. CONT. Dura Kool Alum TYPE OF STRUCTURE patio cover
PERMIT NO. 18634 LEGAL DESCRIPTION L 15 B 6 Richfield Village 2 A

BUILDING	MECHANICAL	ELECTRICAL
Investigation	Plumbing Cont.	Temp. pole cont.
Location & Footing	Permit No. _____ Date _____	Permit No. _____ Date _____
Stem Wall	Heat & Vent. A/C Cont.	Inspection _____ Date _____
Concrete Slab Floor	Permit No. _____ Date _____	Electrical Cont.
Floor Framing	Sewer Cont.	Permit No. _____ Date _____
Fireplace Footing	Permit No. _____ Date _____	Fixtures Cont.
Chimney Steel	Rough Soil	Permit No. _____ Date _____
Vert. Steel Reinf.	Rough Water	Slab _____
Horiz. Steel Reinf.	Top-Out	Rough _____
Roof Sheathing	Rough Gas	Final Rough
Framing	A/C Rough Duct	Final Fixture
Backing for siding	Ref. Rough Piping	Final Electrical
Ext. Lath	Final Plumbing	Temporary Service
Ext. Scratch	Final Gas	MISCELLANEOUS
Ext. Brown	Final Air Cond.	Grading & Drainage
Int. Lath	Final Refrig.	On-Site Parking Spaces
Int. Brown	Final Sewer	Eng. Approval of
Drywall	Final Septic Tank	Off-Site Improvements
Permit No. _____		
Final Building		
Approved Occu.		

INSPECTOR: _____ DATE _____

APPROVED FOR OCCUPANCY & METER _____

PLEASE NOTE REMARKS ON REVERSE SIDE 3209 Merritt LOG # _____ AREA # _____