

886 Miller

L 156 A, B, C

VEGAS HEIGHTS #4

ZONE R-2

G. Gatewood December 4, 1970

CITY OF LAS VEGAS, NEVADA

LOG NO. AREA

DEPARTMENT OF BUILDING & SAFETY

APPLICATION & BUILDING PERMIT - for:
Dwellings, Duplexes, Misc. Residential Const.

ADDRESS OF CONSTRUCTION: 886 MILLER

OWNER: J. T. THOMAS

LOT(s): 156 Bldg. Block

SUBDIVISION: VEGAS HTS. TR NO 4

ZONE: R-2

Existing structure on lot: Dwelling ☐ Accessory bldgs. ☐ Vacant lot ☐ Other ☐

PROPOSED CONSTRUCTION: Room addition

USE: bedroom

MATERIALS OF CONSTRUCTION: Wood Frame ☐ Concrete Block ☐ Reinforced Concrete ☐ Steel Frame ☐

SQUARE FEET OF FLOOR AREAS: 1st 2nd 3rd Other TOTAL SQ. FT. 144

FIRE ZONE: 1 2 3 Occupancy Group: A B C D E F G H J-1-2-3-4-5 CONST. TYPE: I II III IV V

ARCHITECT: ENGINEER: NO. of UNITS NO. of STORIES


Plans Submitted: Yes ☐ No ☐ Calculations Submitted: Yes ☐ No ☐ Sewer Fee Req'd. Yes ☐ No ☐

CONTRACTOR: OWNER

STATE LICENSE #

CITY LICENSE #

ADD'L PERMITS REQ'D: Air Cond. ☐ Elec. ☒ Plumbing ☐ Signs ☐ Paving ☐ Fence ☐ Public Walks ☐ Curb-gutters ☐ Incinerators ☐ Fire Sprinkling System ☐

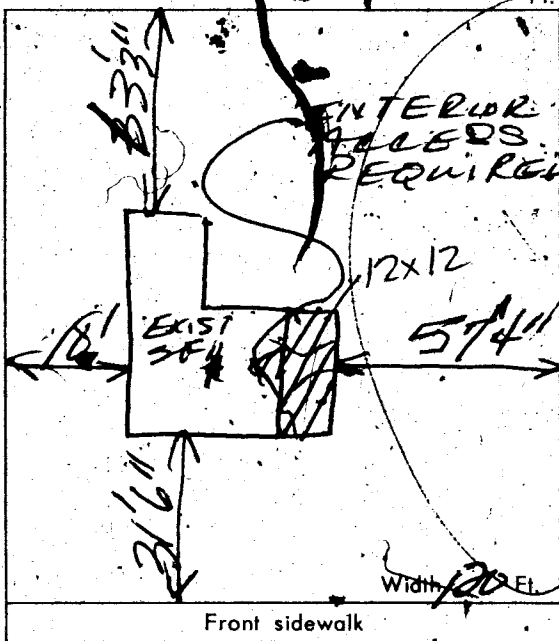

CONDITIONS OF THE PERMIT:

1. I agree to call the City Building Department for inspections before concrete is poured, before rough wiring, electrical, plumbing, framing is covered. Also for Air conditioning, sheet-rock and sheathing inspection.
2. I agree that when the job is completed that I will call for final inspection before occupancy.
3. I agree to perform all construction in accordance with City Ordinances and Building Codes.
4. The Contractor's signature below denotes authority from the owner to sign in his behalf and that the owner is aware of all requirements of this application and permit. Separate permits must be taken out for work outlined above this agreement.
5. I have read and understand the contents of this application and permit; I hereby state that the information I have supplied on this application is true and correct.

SIGNED: J. T. THOMAS Contractor

BY: Agent or Owner

CLARK COUNTY HEALTH DEPT.

LAS VEGAS FIRE DEPARTMENT

PLANNING DEPT. Date: 10-13-70

PUBLIC WORKS DEPT. Date: 10-13-70

BUILDING DEPT. Date: 10-13-70

PERMIT NO. 55198 PERMIT FEE \$ 10.00

RECEIPT

865 \$010.00 - 8

CITY OF LAS VEGAS
DEPT. OF
BUILDING & SAFETY

MUST BE MACHINE VALIDATED

14 OCT 1970

G. Gatewood December 4, 1979

CITY OF LAS VEGAS, NEVADA

DEPARTMENT OF BUILDING & SAFETY - ELECTRICAL APPLICATION & PERMIT

ADDRESS OF CONSTRUCTION: 886 Miller OWNER'S NAME: J. T. THOMAS

CIRCLE: New Bldg.; Add'n; Remodel; TYPE OF BLDG.: SFD. APT. PUBLIC COMM.

CONTRACTOR'S NAME: OWNER STATE LICENSE # CITY LICENSE #

NUMBER	FIXTURE OR INSTALLATION	UNIT PRICE	
	Fixture or sockets	.15	
4	Light, receptacle or switch outlet	.20	.80
	Wall or ceiling space heater	.35	
	Blast coil heater per kilowatt	.35	
	Garbage grinder outlet	.35	
	Dishwasher outlet	.35	
	Clothes dryer outlet	.35	
	Automatic clothes washer	.35	
	Electric range outlet	.35	
	Electric water heater outlet	.35	
	Mercury arc lamp and equipment	.35	
	Special purpose outlet	.35	
	X-ray unit and its appurtenances	5.00	
	Watts of festoon lighting (Watts) First 3,000 watts	4.00	
	for each additional thousand watts	1.50	
	Horsepower - all motors first horsepower or less	1.75	
	for each additional horsepower	.35	
	Temporary power and lights (temporary pole)	4.00	
	Electric service (including any single meter socket)	3.00	
	for each additional socket	.35	
	Air conditioning service amps	1.50	
	Each KW (KVA) Generator (Transformer) (Welder) KW (KVA)	2.00	
	First 100 KVA - For each additional KW (KVA)	.01	
	Special inspection per hour	4.00	
	Speaker outlets	.15	
	Signal or Alarm outlets	.15	
	Amplifiers	.50	
	Control panels	.25	
	T. V. outlets - master system only	.15	
	Radio outlets	.15	
	Main control racks	1.00	
	T. V. and Radio antennas - master system only	.75	
	Minimum fee for any permit	4.00	
	Total fee		4.00

I hereby certify that I have carefully examined and read the above application; that the same is true and correct; and that the work herein described is to be done in accordance with all the provisions of the applicable Ordinances of the City of Las Vegas, Nevada and State laws whether herein specified or not.

SIGNED J. T. Thomas DATE 10/14/70
MASTER (ELECTRICIAN) (TECHNICIAN) (OWNER)

BUILDING DEPARTMENT DATE 10/14/70

*12860 PERMIT NO. 32199 PERMIT FEE: \$ 4.00

RECEIPT

866 \$004.00 - 6

CITY OF LAS VEGAS
DEPT. OF
BUILDING & SAFETY

MUST BE MACHINE VALIDATED

14 OCT 70

G. Gatewood December 4, 1977

CITY OF LAS VEGAS, NEVADA

LOG NO. & AREA

DEPARTMENT OF BUILDING & SAFETY

APPLICATION & BUILDING PERMIT - for:

Dwellings, Duplexes, Misc. Residential Const.

ADDRESS OF CONSTRUCTION:

886 MILLER

OWNER:

J. T. THOMAS

LOT(s)

156 B

BLOCK

SUBDIVISION

VEGAS HTS TR No 4

ZONE:

R-2

Existing structure on lot:

Dwelling ☐

Accessory bldgs. ☐

Vacant lot ☐

Other ☐

PROPOSED CONSTRUCTION:

ADDITION 2nd FLOOR

USE:

BEDRMS

MATERIALS OF CONSTRUCTION:

Wood Frame ☐

Concrete Block ☐

Reinforced Concrete ☐

Steel Frame ☐

SQUARE FEET OF FLOOR AREAS:

1st

2nd

3rd

Other

TOTAL SQ. FT.

270

FIRE ZONE:

1 2 3

Occupancy Group

A B C D E F G H I

J-1-2-3-4-5

CONST. TYPE:

I II III IV V

ARCHITECT:

ENGINEER:

NO. of UNITS

NO. of STORIES

Plans Submitted:

Yes ☐

No ☐

Calculations Submitted

Yes ☐

No ☐

Sewer Fee Req'd.

Yes ☐

No ☐

CONTRACTOR:

OWNER

STATE

LICENSE #

CITY

LICENSE #

ADD'L. PERMITS REQ'D:

Air Cond. ☐

Elect. ☒

Plumbing ☐

Signs ☐

Paving ☐


Fence ☐

Public Walks ☐

Curb-gutters ☐

Incinerators ☐

Fire Sprinkling System ☐

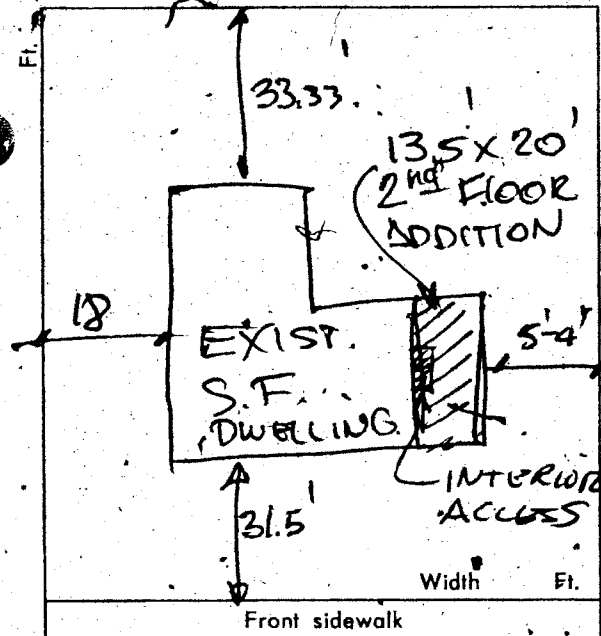

CONDITIONS OF THE PERMIT:

1. I agree to call the City Building Department for inspections before concrete is poured, before rough wiring, electrical, plumbing, framing is covered. Also for Air conditioning, sheet-rock and sheathing inspection.
2. I agree that when the job is completed that I will call for final inspection before occupancy.
3. I agree to perform all construction in accordance with City Ordinances and Building Codes.
4. The Contractor's signature below denotes authority from the owner to sign in his behalf and that the owner is aware of all requirements of this application and permit. Separate permits must be taken out for work outlined above this agreement.
5. I have read and understand the contents of this application and permit; I hereby state that the information I have supplied on this application is true and correct.

SIGNED:

[Signature]

Contractor

BY:

[Signature]

Agent or Owner

CLARK COUNTY HEALTH DEPT.

Date

LAS VEGAS FIRE DEPARTMENT

Date

PLANNING DEPT:

[Signature]

Date:

1-18-71

PUBLIC WORKS DEPT:

[Signature]

Date:

1-18-71

BUILDING DEPT:

[Signature]

Date:

1-18-71

*12850

PERMIT NO:

56816

PERMIT FEE \$

15.00

RECEIPT

8191 \$015.00 - 3

CITY OF LAS VEGAS

DEPT. OF BUILDING & SAFETY

MUST BE MACHINE VALIDATED

8 JAN 71

Gatewood December 4, 1970

CITY OF LAS VEGAS, NEVADA

DEPARTMENT OF BUILDING & SAFETY - ELECTRICAL APPLICATION & PERMIT

ADDRESS OF
CONSTRUCTION: 886 Miller

OWNER'S
NAME: J. T. THOMAS

CIRCLE: New Bldg. Add'n; Remodel; TYPE OF BLDG.: SFD. APT. PUBLIC COMM.

CONTRACTOR'S NAME: OWNER

STATE
LICENSE #

CITY
LICENSE #

NUMBER	FIXTURE OR INSTALLATION	UNIT PRICE	
	Fixture or sockets	.15	
10	Light, receptacle or switch outlet	.20	2.00
	Wall or ceiling space heater	.35	
	Blast coil heater per kilowatt	.35	
	Garbage grinder outlet	.35	
	Dishwasher outlet	.35	
	Clothes dryer outlet	.35	
	Automatic clothes washer	.95	
	Electric range outlet	.35	
	Electric water heater outlet	.35	
	Mercury arc lamp and equipment	.35	
	Special purpose outlet	.35	
	X-ray unit and its appurtenances	5.00	
	Watts of festoon lighting (Watts) First 3,000 watts	4.00	
	for each additional thousand watts	1.50	
	Horsepower - all motors first horsepower or less	1.75	
	for each additional horsepower	.35	
	Temporary power and lights (temporary pole)	4.00	
1	Electric service (including any single meter socket)	3.00	3.00
	for each additional socket	.35	
	Air conditioning service amps	1.50	
	Each KW (KVA) Generator (Transformer) (Welder) KW (KVA)	2.00	
	First 100 KVA - For each additional KW (KVA)	.01	
	Special inspection per hour	4.00	
	Speaker outlets	.15	
	Signal or Alarm outlets	.15	
	Amplifiers	.50	
	Control panels	.25	
	T. V. outlets - master system only	.15	
	Radio outlets	.15	
	Main control racks	1.00	
	T. V. and Radio antennas - master system only	.75	
	Minimum fee for any permit	4.00	
	Total fee		5.00

I hereby certify that I have carefully examined and read the above application; that the same is true and correct; and that the work herein described is to be done in accordance with all the provisions of the applicable Ordinances of the City of Las Vegas, Nevada and State laws whether herein specified or not.

SIGNED [Signature]
MASTER (ELECTRICIAN) (TECHNICIAN) (OWNER)

DATE 1/18/71

BUILDING DEPARTMENT

[Signature] DATE 1/18/71

#12860

PERMIT NO.

32741

PERMIT FEE: \$

5.00

RECEIPT

[Signature] \$005.00 - 6

CITY OF LAS VEGAS
DEPT. OF
BUILDING & SAFETY

MUST BE MACHINE VALIDATED


18 JAN 71

38-17 CITY OF LAS VEGAS, NEVADA
 LOG. NO. & AREA
 DEPARTMENT OF BUILDING & SAFETY
 CONST. # 555⁰⁰
 APPLICATION & BUILDING PERMIT — for:
 Fence, Wall, Retaining Wall
 ADDRESS OF CONSTRUCTION: 886 MILLER
 OWNER: J. T. THOMAS
 LOT(s) 156 BLOCK 39C SUBDIVISION NE 643 N 678 #4 ZONE: R-2
 Materials of Construction: Block ☐ Concrete ☐ Wire ☐ Wood ☒ Other ☐ Yes No
 ARCHITECT: ENGINEER: PLANS: ☐ ☐
 CONTRACTOR: OWNER STATE LICENSE # CITY LICENSE #
 TOTAL SQUARE FEET: TOTAL LINEAL FEET: 185

Remarks:

CONDITIONS OF THE PERMIT:

- Any type of retaining wall must be engineered by a Civil or Structural Engineer.
- If a home owner takes out the Building Permit and if the owner sublets the work to a Contractor, then the Contractor must take out the permit and pay for it.
- No fence or wall can be built on City property or rights-of-way, but this is not intended to preclude construction within utility easements if utilities will not be damaged or made inaccessible.
- The fence or wall shall not enclose any water meter, light standard, or fire alarm box and shall not come closer than 24" from the nearest fire hydrant outlet.
- Department Inspectors must approve footings before concrete is poured and block wall reinforcing before grouting is done.
- Maximum height of any wall or fence is 6', side and rear yards; 4' maximum in front yard with the vertical surface above the height of 2' 50% open.
- I must not obstruct required onsite parking space (2 spaces for each dwelling unit) by the erection of this fence or wall.
- By the signing of this application I herewith agree to the requirements outlined above.

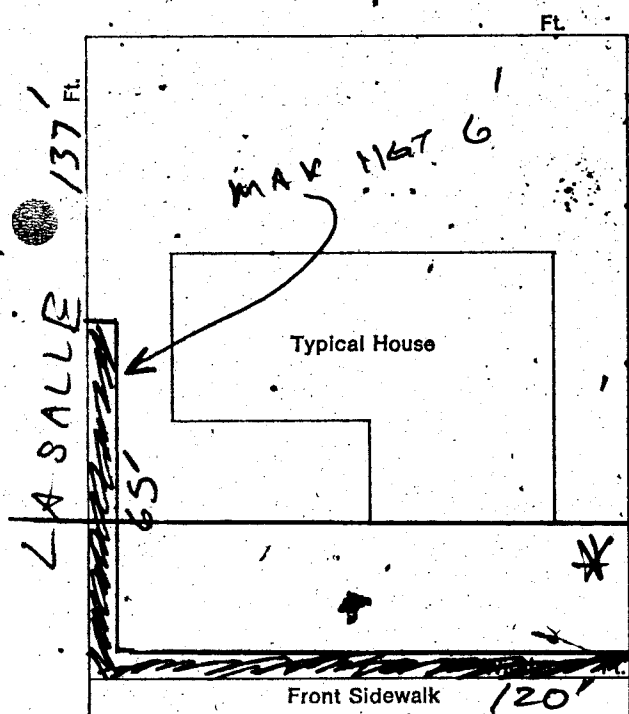

SIGNED: J. T. Thomas
 CONTRACTOR ☐ AGENT ☐ OWNER ☐

DATE: 7-27-76

PLANNING DEPT: [Signature]

Date: 7/27/76

PUBLIC WORKS DEPT: [Signature]

Date:

BUILDING DEPT: [Signature]

Date: 7-27-76

154-01-220

PERMIT NO: 3861

PERMIT FEE \$ 800

RECEIPT

5404 \$008.00 - 8

CITY OF LAS VEGAS
 DEPT. OF BUILDING & SAFETY

MUST BE MACHINE VALIDATED

28-11-76

Dona Healy 10-5-82

DEPARTMENT OF BUILDING & SAFETY
CITY OF LAS VEGAS, NEVADA

KARDEX CARD
FENCE & RETAINING WALLS

OWNER J. T. Thomas ADDRESS 886 Miller DATE 7-27-76

CONTRACTOR Owner PERMIT NO. 3861

LOT _____ BLOCK _____ SUBDIVISION wood fence

Fence (wire, wood, etc.)	Walls (masonry, rock, etc.)
Location _____	Location _____
Final Inspection _____	Footings _____
	Wall Steel 1st _____ 2d _____ 3d _____
	Final Inspection _____
Retaining Wall (masonry)	Retaining Wall (concrete)
Location _____	Location _____
Footings _____	Footings _____
Wall Steel 1st _____ 2d _____ 3d _____	Wall Steel 1st _____ 2d _____ 3d _____
Bond Beam 1st _____ 2d _____ 3d _____	Final Inspection _____
Final Inspection _____	

23.14 B ADDRESS 886 Miller AREA _____

DEPT. of BLDG & SAFETY - CITY of LAS VEGAS, NEVADA

OWNER J. T. THOMAS ADDRESS 886 Miller DATE 10/14/70

GEN. CONT. _____ OWNER _____ TYPE OF STRUCTURE room add.

PERMIT NO. 55199 LEGAL DESCRIPTION _____

BUILDING	MECHANICAL	ELECTRICAL
LOCATION <u>886 Miller</u>	PLUMBING CONT. _____	TEMP. POLE CONT. _____
FIREPLACE FTG. _____	PERMIT NO. _____ DATE _____	PERMIT NO. _____ DATE _____
PLASTER SCRATCH _____	FINAL SEPTIC TANK _____	ENG. APPROVAL OF _____
PLASTER BROWN _____		OFF-SITE IMPROVEMENTS _____
URBAN REDEVELOPMENT APPROVAL _____		
FINAL BLDG _____ DATE _____		

Pulled 7-5-72

APPROVED FOR OCCUPANCY & METER _____ INSPECTOR _____ DATE _____

PLEASE NOTE REMARKS ON REVERSE SIDE 886 Miller LOG: # _____ AREA: # _____ 23.04

Dora Healy

10-5-82

V.

OWNER J. T. THOMAS DEPT. of BLDG & SAFETY - CITY of LAS VEGAS, NEVADA
 GEN CONT. OWNER ADDRESS 886 Miller DATE 1/18/71
 PERMIT NO. 56810 LEGAL DESCRIPTION Lot 156B Vegas Hgts #4 TYPE OF STRUCTURE 2d story add.

BUILDING		MECHANICAL	ELECTRICAL
LOCATION		PLUMBING CONT.	TEMP. POLE CONT.
FIREPLACE FTS.		PERMIT NO. DATE	PERMIT NO. DATE
FOOTINGS		HEAT & VENT. AC CONT.	INSPECTION <u>J. T. THOMAS</u>
FOUNDATION WALL		PERMIT NO. DATE	ELECTRICAL CONT.
FLOOR FRAMING		SEWER CONT.	PERMIT NO. <u>32741</u> DATE <u>1/18/71</u>
SLAB		PERMIT NO. DATE	FIXTURES CONT.
CHIMNEY STEEL (FIREPLACE) <u>912865-12-71</u>		ROUGH SOL.	PERMIT NO. DATE
WALL STEEL		ROUGH WATER	SLAB
COLUMN STEEL		TOP-OUT	ROUGH
BEAM STEEL		ROUGH GAS	FINAL ROUGH
FRAMING <u>912865-12-71</u>		AC ROUGH DUCT	FINAL FIXTURE
ROOF SHEATHING <u>912865-12-71</u>		REF. ROUGH PIPING	FINAL ELECTRICAL
INTERIOR	EXTERIOR	FINAL PLUMBING	TEMPORARY SERVICE
DRYWALL		FINAL GAS	
LATHING		FINAL AIR COND.	MISCELLANEOUS
BACKING (SIDING) <u>912865-12-71</u>		FINAL REFRIG.	GRADING & DRAINAGE
PLASTER, "SCRATCH"		FINAL SEWER	ON-SITE PARKING SPACES APP.
URBAN REDEVELOPMENT APPROVAL		FINAL SEPTIC TANK	ENG. APPROVAL OF
FINAL BLDG. DATE			OFF-SITE IMPROVEMENTS

Reflected 7-5-71

APPROVED FOR OCCUPANCY & METER

INSPECTOR

DATE

PLEASE NOTE REMARKS ON REVERSE SIDE 886 Miller

LOG #

AREA #

23 04