

2804 Milo

L 18 B 15 RICHFIELD VILLAGE #4-A ZONE R-1

G. Gatewood December 4, 1979

1969
CITY OF LAS VEGAS, NEVADA

LOG NO. & AREA _____

CONST. VAL: \$ 148⁰⁰

DEPARTMENT OF BUILDING & SAFETY

APPLICATION & BUILDING PERMIT — for:
Fence, Wall, Retaining Wall.

ADDRESS OF
CONSTRUCTION: 2804 MILO WAY

OWNER: LADDIE ANTOSH

LOT(S) 18 BLOCK 15 SUBDIVISION RICHFIELD VILLAGE UNIT #4-A ZONE: R-1

Materials of Construction: Block ☐ Concrete ☐ Wire ☒ Wood ☐ Other ☐

Yes No

PLANS: ☐ ☒

ARCHITECT: _____

ENGINEER: _____

CALCS: ☐ ☒

CONTRACTOR: W. KINLEY ENT.

STATE
LICENSE # 7236 B


CITY
LICENSE # C11-3178

TOTAL SQUARE FEET: _____ TOTAL LINEAL FEET: 74'x6'

Remarks:

CONDITIONS OF THE PERMIT:

1. Any type of retaining wall must be engineered by a Civil or Structural Engineer.
2. If a home owner takes out the Building Permit and if the owner sublets the work to a Contractor, then the Contractor must take out the permit and pay for it.
3. No fence or wall can be built on City property or rights-of-way, but this is not intended to preclude construction within utility easements if utilities will not be damaged or made inaccessible.
4. The fence or wall shall not enclose any water meter, light standard, or fire alarm box and shall not come closer than 24" from the nearest fire hydrant outlet.
5. Department Inspectors must approve footings before concrete is poured and block wall reinforcing before grouting is done.
6. Maximum height of any wall or fence is 6', side and rear yards; 4' maximum in front yard with the vertical surface above the height of 2' — 50% open and further that fencing within 25' of the intersection of curb faces on corner and through lots is limited to a maximum height of 30".
7. I must not obstruct required onsite parking space (1 space for each dwelling unit) by the erection of this fence or wall.
8. By the signing of this application I herewith agree to the requirements outlined above.

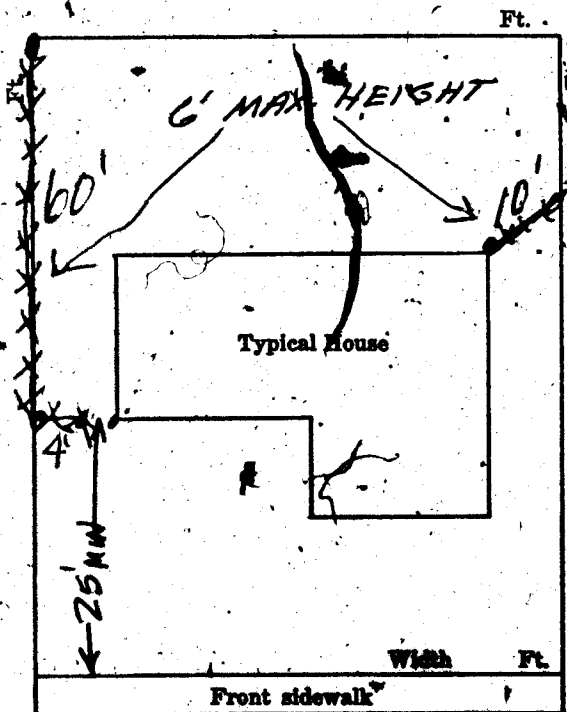

SIGNED: Lee Terry

CONTRACTOR ☐ AGENT ☒ OWNER ☐

DATE: 2/25/69

PLANNING DEPT: [Signature]

Date: 2-26-69

ENGINEERING DEPT: _____

Date: _____

BUILDING DEPT: [Signature]

Date: 2-26-69

#1245

PERMIT NO: 46109

PERMIT FEE: 400

RECEIPT

44 \$004.00 - 8

CITY OF LAS VEGAS
DEPT. OF
BUILDING & SAFETY

MUST BE MACHINE VALIDATED

26 FEB 69

G. Gatewood December 4, 1979

1970
CITY OF LAS VEGAS, NEVADA

LOG NO. & AREA

DEPARTMENT OF BUILDING & SAFETY

CONST. VAL. \$ 112

APPLICATION & BUILDING PERMIT — for:
Fence, Wall, Retaining Wall.

ADDRESS OF
CONSTRUCTION:

2804 Mills Way

OWNER:

L. Antosh

LOT(s)

18

BLOCK

15

SUBDIVISION

RICHFIELD VILLAGE UNIT 4-A ZONE: R-1

Materials of Construction:

Block ☐

Concrete ☐

Wire ☒

Wood ☐

Other ☐

Yes No

PLANS: ☐ ☐

CALCS: ☐ ☐

ARCHITECT:

ENGINEER:

CONTRACTOR:

Fencing Inc.

STATE

LICENSE #

4019

CITY

LICENSE #

400-9

TOTAL SQUARE FEET:


TOTAL LINEAL FEET:

56

Remarks:

CONDITIONS OF THE PERMIT:

1. Any type of retaining wall must be engineered by a Civil or Structural Engineer.
2. If a home owner takes out the Building Permit and if the owner sublets the work to a Contractor, then the Contractor must take out the permit and pay for it.
3. No fence or wall can be built on City property or rights-of-way, but this is not intended to preclude construction within utility easements, if utilities will not be damaged or made inaccessible.
4. The fence or wall shall not enclose any water meter, light standard, or fire alarm box and shall not come closer than 24" from the nearest fire hydrant outlet.
5. Department Inspectors must approve footings before concrete is poured and block wall reinforcing before grouting is done.
6. Maximum height of any wall or fence is 6', side and rear yards; 4' maximum in front yard with the vertical surface above the height of 2' — 50% open.
7. I must not obstruct required onsite parking space (1 space for each dwelling unit) by the erection of this fence or wall.
8. By the signing of this application I herewith agree to the requirements outlined above.

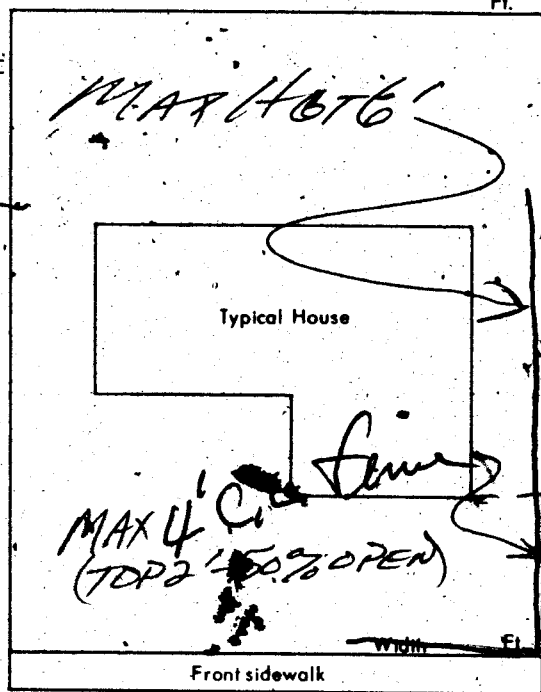

SIGNED:

CONTRACTOR ☒

AGENT ☐

OWNER ☐

DATE: 5-14-70

PLANNING DEPT.:

Date:

5-15-70

PUBLIC WORKS DEPT.:

Date:

BUILDING DEPT.:

Date:

5-18-70

#12850

PERMIT NO.:

53402

PERMIT FEE \$

5.00

RECEIPT

4255

\$005.00 — 8

CITY OF LAS VEGAS

DEPT. OF

BUILDING & SAFETY

MUST BE MACHINE VALIDATED

18 MAY 70

6. Gate word December 4, 1972

CITY OF LAS VEGAS, NEVADA

LOG NO. & AREA

DEPARTMENT OF BUILDING & SAFETY

CONST. VAL. \$

APPLICATION & BUILDING PERMIT - for:

Fence, Wall, Retaining Wall.

ADDRESS OF CONSTRUCTION:

2804 MILOWAY

OWNER:

LADDIE ANTOSH

LOT(s)

BLOCK

SUBDIVISION

Field Hills Village 9A

ZONE

R-1

Materials of Construction:

Block

Concrete

Wire

Wood

Other

Yes

No

ARCHITECT:

ENGINEER:

PLANS:

CALCS:

CONTRACTOR:

Fencing Inc

STATE

LICENSE #

4019

CITY

LICENSE #

100-9

Remarks:


TOTAL SQUARE FEET:

TOTAL LINEAL FEET:

97

CONDITIONS OF THE PERMIT:

1. Any type of retaining wall must be engineered by a Civil or Structural Engineer.
2. If a home owner takes out the Building Permit and if the owner subjects the work to a Contractor, then the Contractor must take out the permit and pay for it.
3. No fence or wall can be built on City property or rights-of-way, but this is not intended to preclude construction within utility easements, if utilities will not be damaged or made inaccessible.
4. The fence or wall shall not enclose any water meter, light standard, or fire alarm box and shall not come closer than 24" from the nearest fire hydrant outlet.
5. Department inspectors must approve footings before concrete is poured and block wall reinforcing before grouting is done.
6. Maximum height of any wall or fence is 6', side and rear yards; 4' maximum in front yard with the vertical surface above the height of 2' - 50% open.
7. I must not obstruct required onsite parking space (1 space for each dwelling unit) by the erection of this fence or wall.
8. By the signing of this application I herewith agree to the requirements outlined above.

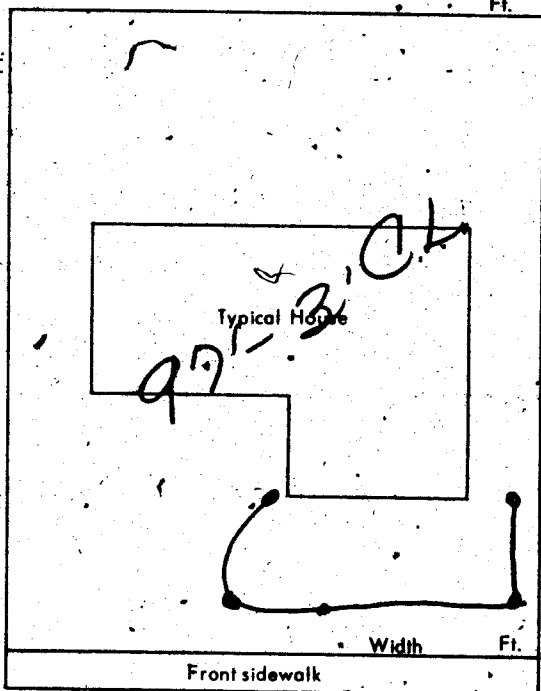

SIGNED:

Richard J. Jorgensen

DATE:

10/27/72

PLANNING DEPT.:

Dan Leary

Date:

11-3-72

PUBLIC WORKS DEPT.:

J. J. Miller

Date:

11-3-72

BUILDING DEPT.:

7759

Date:

11-3-72

#12850

PERMIT NO.:

7759

PERMIT FEE:

500

RECEIPT

5871 \$005.00 - 8

CITY OF LAS VEGAS
DEPT. OF
BUILDING & SAFETY

MUST BE MACHINE VALIDATED

- 6 NOV 72

Boia F. Riley 10-5-82

DEPARTMENT OF BUILDING & SAFETY
CITY OF LAS VEGAS, NEVADA

KARDEX CARD
FENCE & RETAINING
WALLS

OWNER Laddie Antosh ADDRESS 2804 Milo Way DATE 2/26/69

CONTRACTOR McKinley Enterprises PERMIT NO. 46109

LOT 18 BLOCK 15 SUBDIVISION Richfield Village 4-A

Fence (wire, wood, etc.) Wire fence Walls (masonry, rock, etc.)

Location _____
Final Inspection 2-2-69 Location _____
Footing _____
Wall Steel 1st _____ 2d _____ 3d _____
Final Inspection _____

Retaining Wall (masonry) Retaining Wall (concrete)

Location _____
Footing _____
Wall Steel 1st _____ 2d _____ 3d _____
Bond Beam 1st _____ 2d _____ 3d _____
Final Inspection _____

23.14 B ADDRESS 2804 Milo Way LOG NO. _____ AREA _____

DEPARTMENT OF BUILDING & SAFETY
CITY OF LAS VEGAS, NEVADA

KARDEX CARD
FENCE & RETAINING
WALLS

OWNER Laddie Antosh ADDRESS 2804 Milo Way DATE 11-3-72

CONTRACTOR Fencing Inc. PERMIT NO. 7759

LOT 18 BLOCK 15 SUBDIVISION Richfield Village 4 A wire fence

Fence (wire, wood, etc.) Walls (masonry, rock, etc.)

Location _____
Final Inspection 11-8-72 Location _____
Footing _____
Wall Steel 1st _____ 2d _____ 3d _____
Final Inspection _____

Retaining Wall (masonry) Retaining Wall (concrete)

Location _____
Footing _____
Wall Steel 1st _____ 2d _____ 3d _____
Bond Beam 1st _____ 2d _____ 3d _____
Final Inspection _____

23.14 B ADDRESS 2804 Milo Way LOG NO. _____ AREA _____

Bola H. Riley 10-5-82

DEPARTMENT OF BUILDING & SAFETY
CITY OF LAS VEGAS, NEVADA

KARDEX CARD
FENCE & RETAINING
WALLS

OWNER Laddie Antosh ADDRESS 2804 Milo Way DATE 2/26/69
CONTRACTOR McKinley Enterprise PERMIT NO. 46109
LOT 18 BLOCK 15 SUBDIVISION Richfield Village 4-A

Fence (wire, wood, etc.)	Walls (masonry, rock, etc.)
Location _____	Location _____
Final Inspection <u>2-2-3F-69</u>	Footings _____
	Wall Steel 1st _____ 2d _____ 3d _____
	Final Inspection _____
Retaining Wall (masonry)	Retaining Wall (concrete)
Location _____	Location _____
Footings _____	Footings _____
Wall Steel 1st _____ 2d _____ 3d _____	Wall Steel 1st _____ 2d _____ 3d _____
Bond Beam 1st _____ 2d _____ 3d _____	Final Inspection _____
Final Inspection _____	

23.14 B ADDRESS 2804 Milo Way LOG NO. _____ AREA _____

DEPARTMENT OF BUILDING & SAFETY
CITY OF LAS VEGAS, NEVADA

KARDEX CARD
FENCE & RETAINING
WALLS

OWNER Laddie Antosh ADDRESS 2804 Milo Way DATE 11-3-72
CONTRACTOR Fencing Inc. PERMIT NO. 7759
LOT 18 BLOCK 15 SUBDIVISION Richfield Village 4 A wire fence

Fence (wire, wood, etc.)	Walls (masonry, rock, etc.)
Location _____	Location _____
Final Inspection <u>2-11-8-72</u>	Footings _____
	Wall Steel 1st _____ 2d _____ 3d _____
	Final Inspection _____
Retaining Wall (masonry)	Retaining Wall (concrete)
Location _____	Location _____
Footings _____	Footings _____
Wall Steel 1st _____ 2d _____ 3d _____	Wall Steel 1st _____ 2d _____ 3d _____
Bond Beam 1st _____ 2d _____ 3d _____	Final Inspection _____
Final Inspection _____	

23.14 B ADDRESS 2804 Milo Way LOG NO. _____ AREA _____

Sona H. Halsey

10-5-82

DEPT. of BLDG & SAFETY— CITY of LAS VEGAS, NEVADA
 OWNER Alameda Homes Corp ADDRESS 2808 Milo Way DATE 8-22-62
 GEN. CONT. Same TYPE OF STRUCTURE SED
 PERMIT NO. 13433 LEGAL DESCRIPTION Lot 18 block 15 Richfield Village #4 A

BUILDING		MECHANICAL		ELECTRICAL	

 PLEASE NOTE REMARKS ON REVERSE SIDE

2804 Milo Way

DEPARTMENT OF BUILDING & SAFETY
 CITY OF LAS VEGAS, NEVADA

KARDEX CARD
 FENCE & RETAINING
 WALLS

OWNER L. A ntosh ADDRESS 2804 Milo Way DATE 5/18/70
 CONTRACTOR Fencing Inc PERMIT NO. 53402
 LOT 18 BLOCK 15 SUBDIVISION Richfield Village #4
Wire

Fence (wire, wood, etc.)	Walls (masonry, rock, etc.)

23.14 B ADDRESS 2804 Milo Way LOG NO. 61 AREA 21.04