

6340 Molino Road

L 16 B 5

TORREY PARK #2

ZONE R-1

Gloria Hotewood December 6, 1974

CITY OF LAS VEGAS, NEVADA

LOG NO. & AREA

DEPARTMENT OF BUILDING & SAFETY

CONST. VAL. \$

608-

APPLICATION & BUILDING PERMIT — for:
Dwellings, Duplexes, Misc. Residential Const.

ADDRESS OF
CONSTRUCTION:

6340 Molina

OWNER

Sidney Whitlock

LOT(s)

16

BLOCK

5

SUBDIVISION

ORDER

WORK WORK 2

ZONE:

121

Existing structure on lot: Dwelling

☐

Accessory bldg

☐

Vacant lot

☐

Other

☐

PROPOSED CONSTRUCTION:

Enclose Garage

USE:

Res

MATERIALS OF CONSTRUCTION:

Wood Frame

☐

Concrete Block

☐

Reinforced Concrete

☐

Steel Frame

☐

SQ. FEET OF FLOOR AREA

1st

2nd

3rd

Other

TOTAL SQ. FT.

200

FIRE ZONE: 1 2 3

Occupancy Group 1 J 1 - 2

CONST. TYPE

I II III IV V

ARCHITECT:

ENGINEER:

NO. OF UNITS

NO. OF STORIES

Plans Submitted:

Yes

☐

No

☐

Calculations Submitted

Yes

☐

No

☐

Sewer Fee Req'd.

Yes

☐

No

☐

CONTRACTOR:

Owner

STATE
LICENSE *

CITY
LICENSE *

ADD'L. PERMITS REQ'D:

Air Cond.

☐

Incinerators

☐

Elec.

☒

Plumbing

☐

Signs

☐

Paving

☐

Fence


☐

Public Works

☒

Curb-gutters

☐

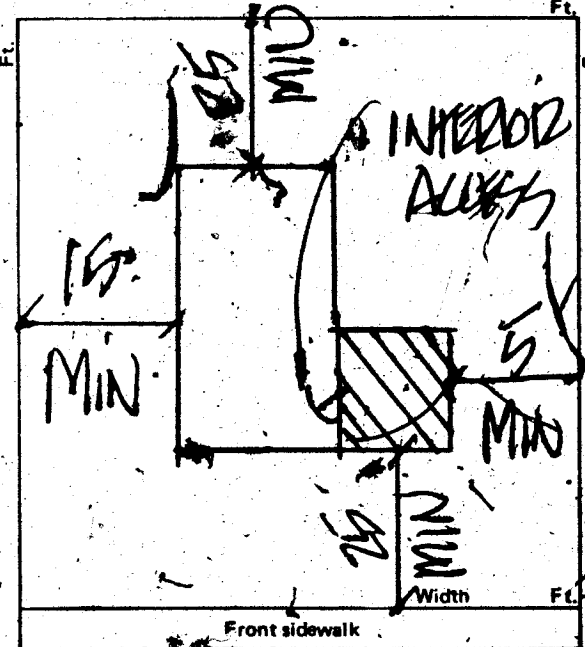

CONDITIONS OF THE PERMIT:

1. I agree to call the City Building Department for inspections before concrete is poured, before rough wiring, electrical, plumbing, framing is covered. Also for air conditioning, sheet-rock and sheathing inspection.
2. I agree that when the job is completed that I will call for final inspection before occupancy.
3. I agree to perform all construction in accordance with City Ordinances and Building Codes.
4. The Contractor's signature below denotes authority from the owner to sign in his behalf and that the owner is aware of all requirements of this application and permit. Separate permits must be taken out for work outlined above this agreement.
5. I have read and understand the contents of this application and permit; I hereby state that the information I have supplied on this application is true and correct.

Approval for the work under this permit will be given only after refuse and debris have been removed from job site and public right of way.

SIGNED:

Contractor

BY:

Mrs. Sidney Whitlock

Agent or Owner

CLARK COUNTY HEALTH DEPT.

Date

LAS VEGAS FIRE DEPARTMENT

Date

PLANNING DEPT.:

Date:

3/26/74

PUBLIC WORKS DEPT.:

Date:

3/26/74

BUILDING DEPT.:

Date:

800

12850

PERMIT NO.:

15638

PERMIT FEE \$

RECEIPT

\$08.00

YOUR RECEIPT
THANK YOU

MUST BE MACHINE VALIDATED

26 MAR 69

Gloria Gatewood December 6, 1974

CITY OF LAS VEGAS, NEVADA

DEPARTMENT OF BUILDING & SAFETY - ELECTRICAL APPLICATION & PERMIT

ADDRESS OF
CONSTRUCTION:

6340 Molino

OWNER'S
NAME:

Sidney Whitlock

CIRCLE: New Bldg.; Add'n.

Remodel

TYPE OF BLDG.: SFD

APT. PUBLIC COMM.

CONTRACTOR'S NAME:

Owner

STATE
LICENSE #

CITY
LICENSE #

NUMBER	FIXTURE OR INSTALLATION	UNIT PRICE	TOTAL
1	Rm addition, carport or garage enclosure	4.00	4.00
	Temporary power.	4.00	
	Light, receptacle or switch outlet	.20	
	Wall or ceiling space heater	.35	
	Garbage grinder outlet	.35	
	Dishwasher outlet	.35	
	Clothes dryer outlet	.35	
	Automatic clothes washer	.35	
	Electric range outlet	.35	
	Electric water heater outlet	.35	
	Special purpose outlet	.35	
	X-ray unit and its appurtenances	5.00	
	Watts of festoon lighting (Watts) First 3,000 watts for each additional thousand watts	4.00 1.50	
	Horsepower each motor first horsepower or less for each additional horsepower	1.75 .35	
	Electric service (including any single meter socket) for each additional socket	3.00 .35	
	Air conditioning service	1.50	
	Each KW(KVA) Generator (Transformer, Welder) First 100 KVA for each additional KW(KVA)	2.00 .01	
	Speaker, signal or alarm outlet	.15	
	Amplifiers	.50	
	Control panels	.25	
	Main control racks	1.00	
	T.V. and radio antennas-master system only	.75	
	Minimum fee for any permit	4.00	
	TOTAL FEE		40.00

Approval for the work under this permit will be given only after refuse and debris have been removed from job site and public right of way.

I hereby certify that I have carefully examined and read the above application; that the same is true and correct; and that the work herein described is to be done in accordance with all the provisions of the applicable Ordinances of the City of Las Vegas, Nevada and State laws whether herein specified or not.

SIGNED

Mrs. Sidney Whitlock
MASTER (ELECTRICIAN) (TECHNICIAN) (OWNER)

DATE

3/26/74

BUILDING DEPARTMENT

WRJ

DATE

3/26/74

#12860

PERMIT NO.

8969

PERMIT FEE

40.00

RECEIPT

\$04.00

YOUR RECEIPT
THANK YOU

RECEIPT MACHINE VALIDATED

26 MAR 69

Gloria Gatewood December 6, 1979

CITY OF LAS VEGAS, NEVADA

LOG NO. & AREA

DEPARTMENT OF BUILDING & SAFETY

CONST. VAL.

APPLICATION & BUILDING PERMIT — for:
Dwellings, Duplexes, Misc. Residential Const.

ADDRESS OF
CONSTRUCTION:

MOLINO RD.

OWNER:

TWIN LAKES VILLAGE, INC.

LOT(S)

BLOCK

SUBDIVISION

TORREY PINES PARK # 2

ZONE:

R-1

Existing structure on lot: Dwelling

☐

Accessory bldgs.

☐

Vacant lot

☒

Other

☐

PROPOSED CONSTRUCTION:

S. F. D.

USE:

MATERIALS OF CONSTRUCTION:

Wood Frame

☒

Concrete Block

☐

Reinforced Concrete

☐

Steel Frame

☐

SQ. FEET OF FLOOR AREAS: 1st

976

2nd

3rd

Other

TOTAL SQ. FT.

976

FIRE ZONE:

1 2 3

Occupancy Group

1 J 1 - 2

CONST. TYPE:

1 in ill. IV 2

ARCHITECT:

OWNER

ENGINEER:

NO. of UNITS

1

NO. of STORIES

Plans Submitted: Yes

☒

No

☐

Calculations Submitted

Yes

☒

No

☐

Sewer Fee Req'd.

Yes

☒

No

☐

CONTRACTOR:

OWNER

STATE

LICENSE #

9616-B

CITY

LICENSE #

7999

ADD'L. PERMITS REQ'D: Air Cond.

☒

Elec.

☒

Plumbing

☒

Signs

☐

Paving

☐

Fence

☐

Public Walks

☐

Cart-buffers

☐

Incinerators

☐

Fire Sprinkling System

☐

CONDITIONS OF THE PERMIT:

1. I agree to call the City Building Department for inspections before concrete is poured, before rough wiring, electrical, plumbing, framing is covered. Also for air conditioning, sheet-rock and sheathing inspection.
2. I agree that when the job is completed that I will call for final inspection before occupancy.
3. I agree to perform all construction in accordance with City Ordinances and Building Codes.
4. The Contractor's signature below denotes authority from the owner to sign in his behalf and that the owner is aware of all requirements of this application and permit. Separate permits must be taken out for work outlined above this agreement.
5. I have read and understand the contents of this application and permit; I hereby state that the information I have supplied on this application is true and correct.

SIGNED:

TWIN LAKES VILLAGE, INC.

Contractor

BY:

Agent or Owner

CLARK COUNTY HEALTH DEPT.

Date

LAS VEGAS FIRE DEPARTMENT

Date

PLANNING DEPT:

Date:

8-16-72

PUBLIC WORKS DEPT:

Date:

8-17

BUILDING DEPT:

Date:

8-22-72

PERMIT NO:

6875

PERMIT FEE \$

602

RECEIPT

2608

\$02.00 - 8

CITY OF LAS VEGAS
DEPT. OF
BUILDING & SAFETY

MUST BE MACHINE VALIDATED

23 AUG 72

Glenn Gatewood December 6, 1979

976-30

CITY OF LAS VEGAS, NEVADA
DEPARTMENT OF BUILDING & SAFETY
RECEIPT
FOR
SEWER CONNECTION FEE

JOB ADDRESS: 6340 MOLINO RD.

OWNER'S NAME: TWIN LAKES VILLAGE, INC.

LOT 16 BLOCK 5 SUBDIVISION TORREY PINES PARK # 2

QUANTITY	OCCUPANCY	UNIT FEE	AMOUNT
1	S. F. D.		150.00
1	POOL		37.50

PAID BY: T. L. V. INC.

TOTAL

Less Credit*

TOTAL FEE \$ 187.50 150.00

*Credit for existing sewer is applied to the new sewer connection fee based on previous type of occupancy and only when the new occupancy requires an additional fee.

This receipt does not authorize the owner or his representative to start any work without obtaining a plumbing permit.

DEPARTMENT OF BUILDING & SAFETY

DATE

RECEIPT NO. 6421

SEWER FEE \$ 150.00

75102

RECEIPT

1981 \$150.00 - 3

CITY OF LAS VEGAS
DEPT. OF
BUILDING & SAFETY
MUST BE MACHINE VALIDATED

Gloria Hatwood December 6, 1972

CITY OF LAS VEGAS, NEVADA

DEPARTMENT OF BUILDING & SAFETY - ELECTRICAL APPLICATION & PERMIT

ADDRESS OF
CONSTRUCTION: 6340 Moline St.

OWNER'S
NAME: Temple Construction

CIRCLE: New Bldg.; Add'n; Remodel; TYPE OF BLDG.: SFD. APT. PUBLIC COMM.

CONTRACTOR'S NAME: Roberts Electric

STATE
LICENSE: 4528

CITY
LICENSE #: 3392

NUMBER	FIXTURE OR INSTALLATION	UNIT PRICE	
81	Fixture or sockets	.15	120
41	Light, receptacle or switch outlet	.20	820
	Wall or ceiling space heater	.35	
	Blas coil heater per kilowatt	.35	
	Garbage grinder outlet	.35	
	Dishwasher outlet	.35	
	Clothes dryer outlet	.35	
	Automatic clothes washer	.35	
	Electric range outlet	.35	
	Electric water heater outlet	.35	
	Mercury arc lamp and equipment	.35	
	Special purpose outlet	.35	
	X-ray unit and its appurtenances	5.00	
	Watts of festoon lighting (Watts) First 3,000 watts	4.00	
	for each additional thousand watts	1.50	
	Horsepower — all motors first horsepower or less	1.75	
	for each additional horsepower	.35	
	Temporary power and lights (temporary pole)	4.00	
1	Electric service (including any single meter socket)	3.00	300
	for each additional socket	.35	
1	Air conditioning service	1.50	150
	amps		
	Each KW (KVA) Generator (Transformer) (Welder) KW (KVA)	2.00	
	First 100 KVA — For each additional KW (KVA)	.01	
	Special inspection per hour	4.00	
	Speaker outlets	.15	
	Signal or Alarm outlets	.15	
	Amplifiers	.50	
	Control panels	.25	
	T. V. outlets — master system only	.15	
	Radio outlets	.15	
	Main control racks	1.00	
	T. V. and Radio antennas — master system only	.75	
	Minimum fee for any permit	4.00	
	Total fee		1390

I hereby certify that I have carefully examined and read the above application; that the same is true and correct; and that the work herein described is to be done in accordance with all the provisions of the applicable Ordinances of the City of Las Vegas, Nevada and State laws whether herein specified or not.

SIGNED

MASTER (ELECTRICIAN) (TECHNICIAN) (OWNER)

DATE

9/11/72

BUILDING DEPARTMENT

DATE

#12880 PERMIT NO.

4168

PERMIT FEE

1390

RECEIPT

1519 \$013.90 - 6

CITY OF LAS VEGAS

DEPT. OF
BUILDING & SAFETY

MUST BE MACHINE VALIDATED

SEP 12 1972

Glenn Gatewood December 16, 1972

CITY OF LAS VEGAS, NEVADA

DEPARTMENT OF BUILDING & SAFETY — AIR CONDITIONING APPLICATION & PERMIT

ADDRESS OF CONSTRUCTION: 6340 Molino St.

OWNER'S NAME: Temple Construction

CIRCLE: Addition: Remodel: New Bldg: TYPE OF BLDG.: SFD APT. COMM. PUBLIC,

CONTRACTOR'S NAME: Oasis Air Cond.

STATE LICENSE 8454A CITY LICENSE 10371

UNITS	DESCRIPTION	FEE	TOTAL	UNITS	DESCRIPTION	FEE	TOTAL
	Unit heater — floor, wall or suspended	4.00			EVAPORATIVE COOLERS:		
	FOR EACH FORCED-AIR OR GRAVITY-TYPE FURNACE OR BURNER INCLUDING DUCTS AND VENT ATTACHED TO SUCH APPLIANCES:				5 outlets or under	3.00	
	Up to and including 100,000 B.t.u.'s	4.00			Over 5 and up to and including 10	5.00	
	Over 100,000 B.t.u.'s	6.00			Each additional outlet over 10	.25	
	FOR EACH HEATING APPLICATION, REFRIGERATION UNIT, COMFORT COOLING AND HEATING UNIT, ABSORPTION UNIT, COMPRESSOR OR BOILER:				VENTILATION:		
3	Up to and including 3 ton or horsepower, or absorption system up to and including 100,000 B.t.u.'s	4.00	4.00	2	For each fan connected to a single duct	1.00	2.00
	Over 3 ton or 3 horsepower up to and including 10, or absorption system over 100,000 B.t.u.'s up to and including 250,000 B.t.u.'s	7.00			For each commercial or industrial ventilation system	5.00	
	Over 10 ton or 10 horsepower up to and including 30, or absorption system over 250,000 B.t.u.'s up to and including 1,000,000 B.t.u.'s	12.00			For each commercial kitchen hood	5.00	
	Over 30 ton or 30 horsepower up to and including 50, or absorption system over 1,000,000 B.t.u.'s up to and including 1,700,000 B.t.u.'s	20.00			MISCELLANEOUS:		
	Over 50 ton or 50 horsepower, or absorption system over 1,700,000 B.t.u.'s	30.00			For each water cooling tower	8.00	
	FOR EACH AIR HANDLING UNIT INCLUDING DUCTS ATTACHED THERETO:				Duct work only — each opening	.25	
	Up to and including 10,000 CFM	2.00			For installation or relocation of each commercial or industrial incinerator	15.00	
	Over 10,000 CFM	4.00			Gas piping related to the air cond. work in single family dwelling only	3.00	
					For each appliance, piece of equipment, any mechanical work or alteration or replacement not included in this schedule, the permit fee shall be computed the same as building permit fees by using the cost of installation for the valuation amount.		
					FOR THE ISSUANCE OF EACH PERMIT	3.00	
					TOTAL PERMIT FEE \$	9.00	

I hereby certify that I have carefully examined and read the above application that the same is true and correct; and that the work herein described is to be done in accordance with all the provisions of the applicable Ordinances of the City of Las Vegas, Nevada and the State Laws, whether herein specified or not.

SIGNED

Richard Patton
Air Conditioning Contractor - Owner

Date

BUILDING DEPARTMENT

N.M. Mills

Date

10-10-72

PERMIT NO.

2556

PERMIT FEE \$

9.00

RECEIPT

4750 \$009.00 — 4

CITY OF LAS VEGAS
DEPT. OF
BUILDING & SAFETY

MUST BE MACHINE VALIDATED

10 OCT 72

12090

Yboris Gatewood December 6, 1977

CITY OF LAS VEGAS, NEVADA

DEPARTMENT OF BUILDING & SAFETY - APPLICATION AND PERMIT FOR PLUMBING

ADDRESS OF CONSTRUCTION: 6340 Molina St.

OWNER'S NAME: Heerls Bros.

CIRCLE: New Bldg.; Add'n; Remodel; TYPE OF BLDG.: SFD. APT. PUBLIC COMM

CONTRACTOR'S NAME: Pioneer Plumbing, Inc.

STATE LICENSE # 7507A

CITY LICENSE # 7677

UNITS	DESCRIPTION	FEE	TOTAL
1	Bathtub	1.00	1.00
1	Shower	1.00	1.00
2	Lavatory	1.00	2.00
2	Toilet	1.00	2.00
	Urinal	1.00	
	Floor Drain	1.00	
	Floor Sink	1.00	
	Wash Tray	1.00	
1	Sink	1.00	1.00
1	Garbage Disposal	1.00	1.00
	Garbage Disposal (comm.)	3.00	
	Clothes Dryer (gas)	1.00	
	Clothes Washer	1.00	
	Clothes Washer (comm.)	5.00	
	Dishwasher	1.00	
	Dishwasher (commercial)	5.00	
	Dental Unit	10.00	
	Drinking Fountain	1.00	
	Any Water using Equipment	1.00	
1	Water Heater (gas)(elect.)	1.00	1.00
1	Sewer System - New, Replacement, or any Drainage System	4.00	4.00
	Grease or Sand Trap	2.00	
	Trailer Trap	2.00	
	Septic Disposal System	4.00	
WATER SOFTENERS			
	Nonpermanent Type	4.00	
	Permanent Type (connected to Drainage)	5.00	
SWIMMING POOLS			
	Private or Wading Pool	10.00	
	Public or Semi-public	20.00	

UNITS	DESCRIPTION	FEE	TOTAL
WATER DISTRIBUTION SYSTEM			
1	Single Family Dwelling	4.00	4.00
	Multiple Family Dwelling plus each unit	4.00	
	Bldg. Group "A" thru "G" per each floor	2.00	
	Hotel or Motel plus each bath	6.00	
	Trailer Park plus each space	4.00	
	Irrigation	20.00	
		1.00	
		4.00	
GAS PIPING SYSTEM			
1	Single Family Dwelling	3.00	3.00
	Multiple Family Dwelling plus each unit	6.00	
	Commercial Bldg. per floor plus each unit	1.00	
	Gas Appliance (any type)	3.00	
		3.00	
		1.00	
AUTOMATIC FIRE EXTINGUISHING SYSTEM			
	Underground Piping	10.00	
	Distribution Piping ea. ft.	.01	
	Sprinkler Head each	.10	
	In Range Hood and Vent	5.00	
DRY STANDPIPE SYSTEM			
	Piping	50.00	
	Each Outlet	1.00	
WET STANDPIPE SYSTEM			
	Piping	5.00	
	Fire Hose Cabinet	1.00	
	MINIMUM PERMIT FEE	4.00	
PIPELINE CONTRACTOR; SECT. 14 B P F \$			
TOTAL PERMIT FEE \$20.00			

I hereby certify that I have carefully examined and read the above application; that the same is true and correct; and that the work herein described is to be done in accordance with all the provisions of the applicable Ordinances of the City of Las Vegas, Nevada and the State Laws, whether herein specified or not.

Signed [Signature] Date: _____
REGISTERED MASTER PLUMBER, SPEC. CONTR. OR OWNER

Building Department

12870

Permit No. 7477

Permit Fee \$ 20.00

RECEIPT

5733 \$020.00 - 7

CITY OF LAS VEGAS
DEPT. OF
BUILDING & SAFETY

MUST BE MACHINE VALIDATED

- 1 NOV 77

Gloria Gatewood December 6, 1972

CITY OF LAS VEGAS, NEVADA

LOG NO. & AREA

DEPARTMENT OF BUILDING & SAFETY

CONST. VAL. \$

APPLICATION & BUILDING PERMIT — for:
Fence, Wall, Retaining Wall.

ADDRESS OF CONSTRUCTION: 6340 Molina

OWNER: Twin Lakes Village

LOT(s) 16 BLOCK 5 SUBDIVISION Torrey Pines Park #2

ZONE R-1

Materials of Construction: Block ☐ Concrete ☐ Wire ☒ Wood ☐ Other ☐

PLANS: ☐ Yes ☐ No

ARCHITECT:

ENGINEER:

CALC: ☐ Yes ☐ No

CONTRACTOR: Bills Fence

STATE LICENSE # 9506A

CITY LICENSE # 10456


TOTAL SQUARE FEET:

TOTAL LINEAL FEET: 170

Remarks:

CONDITIONS OF THE PERMIT:

1. Any type of retaining wall must be engineered by a Civil or Structural Engineer.
2. If a home owner takes out the Building Permit and if the owner sublets the work to a Contractor, then the Contractor must take out the permit and pay for it.
3. No fence or wall can be built on City property or rights-of-way, but this is not intended to preclude construction within utility easements if utilities will not be damaged or made inaccessible.
4. The fence or wall shall not enclose any water meter, light standard, or fire alarm box and shall not come closer than 24" from the nearest fire hydrant outlet.
5. Department Inspectors must approve footings before concrete is poured and block wall reinforcing before grouting is done.
6. Maximum height of any wall or fence is 6', side and rear yards; 4' maximum in front yard with the vertical surface above the height of 2' — 50% open.
7. I must not obstruct required onsite parking space (2 spaces for each dwelling unit) by the erection of this fence or wall.
8. By the signing of this application I herewith agree to the requirements outlined above.

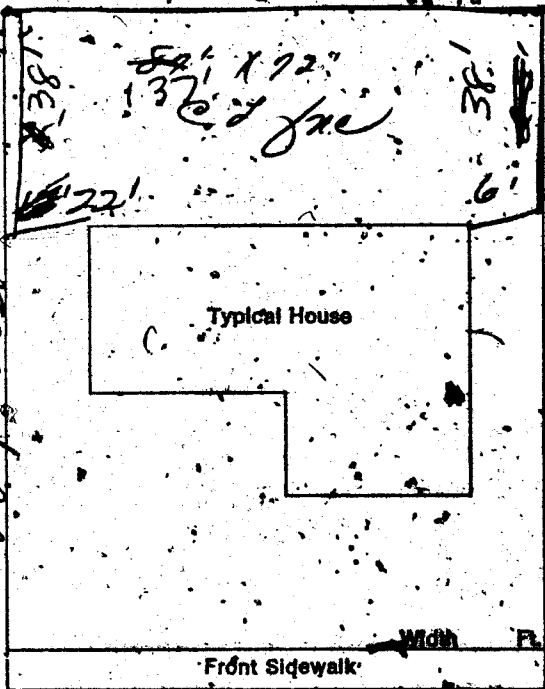

SIGNED: *[Signature]*

CONTRACTOR ☒

AGENT ☐

OWNER ☐

DATE: 1-29-73

PLANNING DEPT: *[Signature]*

Date: 1-31-73

PUBLIC WORKS DEPT: *[Signature]*

Date: 2/1/73

BUILDING DEPT: *[Signature]*

Date: 2/1/73

#12850

PERMIT NO: 9149

PERMIT FEE \$ 5.00

RECEIPT

\$005.00 - 8

CITY OF LAS VEGAS
DEPT. OF
BUILDING & SAFETY

NOT BE MACHINE VALIDATED

2 FEB 73

2. Las Vegas June 17, 1980

CITY OF LAS VEGAS, NEVADA

LOG NO. & AREA

DEPARTMENT OF PUBLIC SERVICES
DIVISION OF BUILDING AND SAFETY

CONST. VAL. \$

300⁰⁰

APPLICATION & BUILDING PERMIT - for:
Dwellings, Duplexes, Misc. Residential Const.

ADDRESS OF
CONSTRUCTION

6340 Molina

OWNER:

Erosky, D.

LOT(s)

16

BLOCK

5

SUBDIVISION

Spring Valley Sub #2 R-1

Existing structure on lot:

Dwelling ☒

Accessory Bldgs. ☐

Vacant Lot ☐

Other ☐

PROPOSED CONSTRUCTION:

Bay Windows

USE:

MATERIALS OF CONSTRUCTION:

Wood Frame ☐

Concrete Block ☐

Reinforced Concrete ☐

Steel Frame ☐

SQUARE FEET OF FLOOR AREAS: 1st

2nd

3rd

Other

TOTAL SQ. FT.

FIRE ZONE:

Occupancy Group

CONST. TYPE:

ARCHITECT:

ENGINEER:

NO. of UNITS

NO. of STORIES

Plans Submitted

Yes ☐ No ☒

Calculations Submitted

Yes ☐ No ☒

Sewer Fee Req'd.

Yes ☐ No ☒

CONTRACTOR:

Valparaiso

STATE
LICENSE #

CITY
LICENSE #

ADD'L PERMITS REQ'D:

Air Cond. ☐

Elec. ☐

Plumbing ☐

Signs ☐

Paving ☐

Fence ☐

Public Walks ☐

Curb-gutters ☐

Incinerators ☐

Fire Sprinkling System ☐

CONDITIONS OF THE PERMIT:

1. I agree to call the City Building Department for inspections before concrete is poured, before rough wiring, electrical, plumbing, framing is covered. Also for Air conditioning, drywall and sheathing inspection.
2. I agree that when the job is completed that I will call for final inspection before occupancy.
3. I agree to perform all construction in accordance with City Ordinances and Building Codes.
4. The Contractor's signature below denotes authority from the owner to sign in his behalf and that the owner is aware of all requirements of this application and permit. Separate permits must be taken out for work outlined above this agreement.
5. I have read and understand the contents of this application and permit; I hereby state that the information I have supplied on this application is true and correct.


Approval for the work under this permit will be given only after refuse and debris have been removed from job site and public right of way.

SIGNED:

Contractor

BY:

Agent or Owner

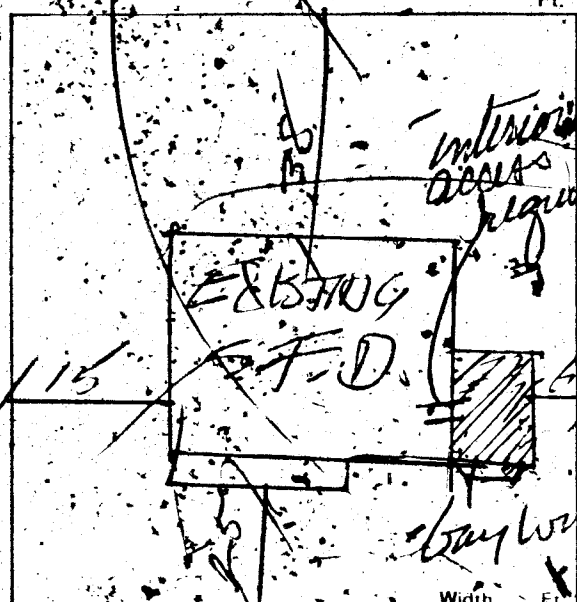

PLANNING DEPT:

Date:

6/6/80

PUBLIC WORKS DEPT:

Date:

6-6-80

BUILDING DIVISION:

Date:

6-6-80

PERMIT NO.:

3047

PERMIT FEE \$

750

1721-2401

RECEIPT	
DATE	6/6/80
TIME	7:50
BY	6/6/80
RECEIVED	6/6/80
MUST BE MACHINE VALIDATED	

Donk H. Halsey

10-8-82

DEPT. of BLDG. & SAFETY - CITY of LAS VEGAS, NEVADA

OWNER Sidney Whitlock ADDRESS 6340 Molino DATE 3-26-74
 GEN. CONT. Owner TYPE OF STRUCTURE Enc garage
 PERMIT NO. 15638 LEGAL DESCRIPTION L 16 B 5 Torrey Pines Park # 2

BUILDING	MECHANICAL	ELECTRICAL
Investigation	Plumbing Cont.	Temp. pole cont.
Location & Footing	Permit No. _____ Date _____	Permit No. _____ Date _____
Stem Wall	Heat & Vent. A/C Cont.	Inspection _____ Date _____
Concrete Slab Floor	Permit No. _____ Date _____	Electrical Cont. <u>Owner</u>
Floor Framing	Sewer Cont.	Permit No. <u>8969</u> Date _____
Fireplace Footing	Permit No. _____ Date _____	Fixtures Cont.
Chimney Steel	Rough Soil	Permit No. _____ Date _____
Vert. Steel Reinf.	Rough Water	Slab _____
Horiz. Steel Reinf.	Top-Out	Rough <u>VP 4-2-74</u>
Roof Sheathing	Rough Gas	Final Rough
Framing	A/C Rough Duct	Final Fixture
Backing for siding	Ref. Rough Piping	Final Electrical
Ext. Lath	Final Plumbing	Temporary Service
Ext. Scratch	Final Gas	MISCELLANEOUS
Ext. Brown	Final Air Cond.	Grading & Drainage
Int. Lath	Final Refrig.	On-Site Parking Spaces _____ App. _____
Int. Brown	Final Sewer	Eng. Approval of _____
Drywall	Final Septic Tank	Off-Site Improvements
Permit No. _____		
Final Building		
Appr. for Occu. _____		

INSPECTOR: _____

DATE _____

APPROVED FOR OCCUPANCY & METER 294-18-74

PLEASE NOTE REMARKS ON REVERSE SIDE

6340 Molino

LOG # _____

AREA # _____

OWNER Erosky D. ADDRESS 6340 Molino

DATE 6-6-80 GEN. CONT. Owner

TYPE OF STRUCTURE Bay Window PERMIT NO. 3047

LEGAL DESCRIPTION L 16 B 5 Torrey Pines Park # 2 FINAL INSPECTION

LOG # _____ AREA # _____

APPROVED FOR OCCUPANCY & METER

BUILDING	MECHANICAL
Investigation	Plumbing Cont.
Location & Footing	Permit No. _____ Date _____
Concrete Slab Floor	Heat & Vent. A/C Cont.
Fireplace Footing	Permit No. _____ Date _____
Chimney Steel	Sewer Cont.
Vert. Steel Reinf.	Permit No. _____ Date _____
Horiz. Steel Reinf.	Rough Soil
Framing <u>JK 6-11-80</u>	Rough Water
Ext. Lath	Top-Out
Ext. Brown	Rough Gas
Drywall	A/C Rough Duct
Final Building <u>JK 9-30-80</u>	Final Plumbing
Appr. for Occu. _____	Final Gas
ELECTRICAL	Final Air Cond.
Temp. Pole Cont.	Final Sewer
Permit No. _____ Date _____	REMARKS
Inspection _____ Date _____	
Electrical Cont.	
Permit No. _____ Date _____	
Rough	PLEASE NOTE: ADDITIONAL REMARKS ON REVERSE SIDE.
Final Rough	DIV. OF BLDG. & SAFETY
Final Electrical	CITY OF LAS VEGAS
Temporary Service	REV 10-78
	79-3-16

Sonia H. H. H.

10-8-82

Insulation JK 6-1-80

3047

DEPT. of BLDG & SAFETY—CITY of LAS VEGAS, NEVADA

OWNER Twin Lakes Village ADDRESS 6340 Molino Road DATE 8-23-72

GEN. CONT. Same TYPE OF STRUCTURE SED

PERMIT NO. 6875 LEGAL DESCRIPTION L16 B 5 Torrey Pines Park # 2

BUILDING		MECHANICAL	ELECTRICAL
LOCATION <u>BW 9-1-72</u>	PLUMBING CONT. <u>Plumber</u>	TEMP. POLE CONT.	
FIREPLACE FTS.	PERMIT NO. <u>7477</u> DATE <u>11-1-72</u>	PERMIT NO.	DATE
FOOTINGS <u>BW 9-4-72</u>	HEAT & VENT. AC CONT. <u>Plumber</u>	INSPECTION	DATE
FOUNDATION WALL <u>BW 9-6-72</u>	PERMIT NO. <u>2072</u> DATE <u>11-10-72</u>	ELECTRICAL CONT. <u>Robert</u>	DATE
FLOOR FRAMING	SEWER CONT. <u>Twin Lakes</u>	PERMIT NO. <u>4168</u>	DATE <u>9-13-72</u>
SLAB <u>BW 9-13-72</u>	PERMIT NO. <u>6421</u> DATE	FIXTURES CONT.	DATE
CHIMNEY STEEL (FIREPLACE)	ROUGH SOIL <u>408-31-72</u>	PERMIT NO.	DATE
WALL STEEL	ROUGH WATER <u>WS-31-72</u>	SLAB	
COLUMN STEEL	TOP-OUT <u>10-1-72</u>	ROUGH	
BEAM STEEL	ROUGH GAS <u>11-1-72</u>	FINAL ROUGH	
FRAMING <u>BW 11-11-72</u>	AC ROUGH DUCT <u>11-1-72</u>	FINAL FIXTURE	
ROOF SHEATHING <u>BW 1-27-72</u>	REF. ROUGH PIPING	FINAL ELECTRICAL <u>10-1-30-73</u>	
INTERIOR	FINAL PLUMBING <u>BW 1-31-73</u>	TEMPORARY SERVICE	
EXTERIOR	FINAL GAS <u>BW 1-31-73</u>		
DRYWALL	FINAL AIR COND. <u>BW 1-31-73</u>		
LATHING	FINAL REFRIG. <u>BW 3-20-73</u>		
BACKING (SIDING)	FINAL SEWER		
PLASTER SCRATCH	FINAL SEPTIC TANK		
PLASTER BROWN			
URBAN REDEVELOPMENT APPROVAL			
FINAL BLDG. DATE			

INSPECTOR _____ DATE _____

APPROVED FOR OCCUPANCY & METER BW 1-30-73

PLEASE NOTE REMARKS ON REVERSE SIDE

LOG # _____ AREA # _____

6340 Molino Road

T 39-3

Donna F. Haly

10-8-82

DEPARTMENT OF BUILDING & SAFETY
CITY OF LAS VEGAS, NEVADA

KARDEX CARD
FENCE & RETAINING
WALLS
DATE XX2-1-73

OWNER Twin Lakes Village ADDRESS 6340 Molino
CONTRACTOR Bills Fence PERMIT NO. 9149
LOT 16 BLOCK 5 SUBDIVISION Torrey Pines wire fence

Fence (wire, wood, etc.)	Walls (masonry, rock, etc.)
Location _____	Location _____
Final Inspection <u>09-23-73</u>	Footings _____
	Wall Steel 1st _____ 2d _____ 3d _____
	Final Inspection _____
Retaining Wall (masonry)	Retaining Wall (concrete)
Location _____	Location _____
Footings _____	Footings _____
Wall Steel 1st _____ 2d _____ 3d _____	Wall Steel 1st _____ 2d _____ 3d _____
Bond Beam 1st _____ 2d _____ 3d _____	Final Inspection _____
Final Inspection _____	

23.14 B

ADDRESS 6340 Molino LOG NO. _____ AREA _____