

402 NELLIS BLVD.

H. Waterwood December 19, 1979

CITY OF LAS VEGAS, NEVADA
DEPARTMENT OF BUILDING AND SAFETY
APPLICATION FOR PLUMBING PERMIT

PERMIT NO. 1914
TELEPHONE NO. _____
DATE: 12/19/79

ADDRESS OF INSTRUCTION 401 Nellis Blvd. OWNER'S NAME Paul R. Thompson
LOT (s) _____ BLOCK _____ SUBDIVISION _____ Type of bldg: SFD Apt. Comm.

Circle: New bldg., Old bldg., Addition, remodel, pool, water softener, lawn sprinkler, fire Sprinkler

CONTRACTOR'S NAME Quinn STATE LICENSE # _____ CITY LICENSE # _____

QUANTITY	FIXTURE OR INSTALLATION	Unit Price	AMOUNT
	Septic disposal system (Health Dept. approval required)	\$ 4.00	
	Sewer tap in fee or connection fee (ea. 4") (1 for ea. bldg.)	25.00	25
	Sewer tap in fee or connection fee (ea. 6") (1 for ea. bldg.)	20.00	
	Sewer replacement	4.00	
	Drainage piping	4.00	
	Water distribution system, single family dwelling	4.00	
	Water distribution system, multiple dwg. \$4+ea. unit	1.00	
	Water distribution system, Group "A" thru "G" per ea. floor	4.00	
	Water distribution system, Group "H" (Hotel) \$4+per bath *	2.50	
	Bath	1.00	
	Shower	1.00	
	Lavatory	1.00	
	Toilet	1.00	
	Sink (kitchen type)	1.00	
	Floor sink	1.00	
	Urinal	1.00	
	Dishwasher	1.00	
	Clothes washer	1.00	
	Grease trap	1.00	
	Floor drain	1.00	
	Wash tray	1.00	
	Dental unit	1.00	
	Drinking fountain	1.00	
	Water using equipment	1.00	
	Clothes dryer (gas)	1.00	
	Water heater (gas) (electric)	1.00	
	Gas appliance (any type)	1.00	
	Gas piping system, single family dwelling	3.00	
	Gas piping system, multiple family unit \$3 + per ea. unit	1.00	
	Gas piping system, commercial bldgs. per ea. floor	3.00	
	Water softener nonpermanent type	4.00	
	Water softener permanent (connected to drainage)	5.00	
	Swimming pool (private (wading pool))	8.00	
	Swimming pool (public) (semi-public)	12.00	
	Irrigation system	4.00	
	Fire sprinkling underground piping	5.00	
	Fire sprinkling distribution piping per each foot	.01	
	Fire sprinkling heads - per each head	1.10	
	Minimum fee for any permit	4.00	
	Total fee		

CITY OF LAS VEGAS
BUILDING AND SAFETY

I hereby certify that I have carefully examined and read the above application; that the same is true and correct, and the work herein described is to be done in accordance with all the provisions of the applicable Ordinances of the City of Las Vegas, Nevada and State Laws, whether herein specified or not, 1914/64 * as defined in Chapters 6 thru 15, Uniform Building Code.

Signed Paul R. Thompson
Registered Plumber, Spec.
Contractor, Owner

Waterwood December 19, 1979

CITY OF LAS VEGAS, NEVADA

LOG NO. & AREA

DEPARTMENT OF BUILDING & SAFETY

CONST. VAL. \$ 1128.70

APPLICATION FOR BUILDING PERMIT for: Fence, Wall, Retaining Wall.

ADDRESS OF CONSTRUCTION: 401 No. Nellis Blvd

OWNER: Mr. Woods

LOT(s): PT. OF N 1/2 NE 1/4, P.L. 32, 24, 021

ZONE: R-E

Materials of Construction: Block Concrete Wire Wood Other

PLANS: Yes No
CALCS: Yes No

ARCHITECT:

ENGINEER:

CONTRACTOR: PRE-FAB CONCRETE PRODUCTS

STATE LICENSE # 13859

CITY LICENSE # C-1-14635


TOTAL SQUARE FEET: 150.5

TOTAL LINEAL FEET: 150.5

Remarks:

CONDITIONS OF THE PERMIT:

1. Any type of retaining wall must be engineered by a Civil or Structural Engineer.
2. If a home owner takes out the Building Permit and if the owner subjects the work to a Contractor, then the Contractor must take out the permit and pay for it.
3. No fence or wall can be built on City property or rights-of-way, but this is not intended to preclude construction within utility easements if utilities will not be damaged or made inaccessible.
4. The fence or wall shall not enclose any water meter, light standard, or fire alarm box and shall not come closer than 24" from the nearest fire hydrant outlet.
5. Department Inspectors must approve footings before concrete is poured and block wall reinforcing before grout is done.
6. Maximum height of any wall or fence is 6' side and rear yards; 4' maximum in front yard with the vertical surface above the height of 2' - 50% open.
7. Must not obstruct required onsite parking space (2 spaces for each dwelling unit) by the erection of this fence or wall.
8. By the signing of this application I herewith agree to the requirements outlined above.

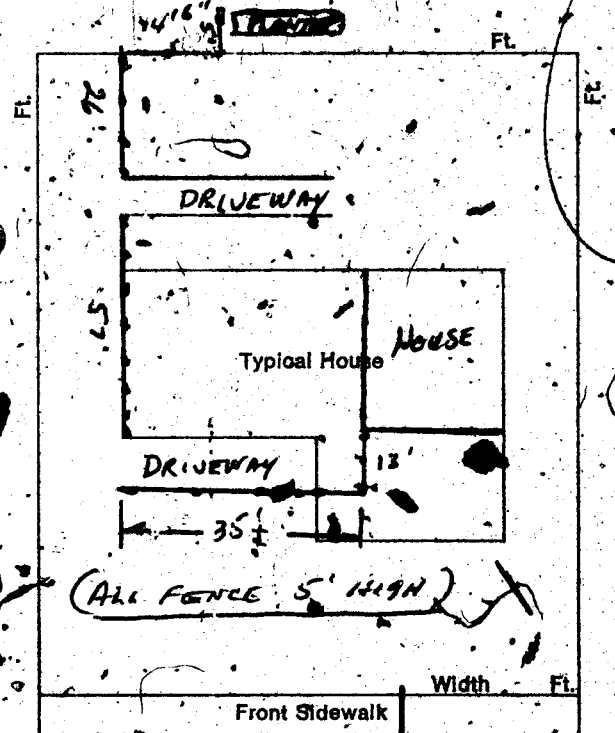

PRE-FAB CONCRETE PRODUCTS, INC.

Lloyd N. Skinner

SIGNED:

DATE: 3/14/77

CONTRACTOR AGENT OWNER

PLANNING DEPT.

Date: 3/14/77

PUBLIC WORKS DEPT.

Date:

BUILDING DEPT.

Date: 3-14-77

#12850

PERMIT NO: 1328

PERMIT FEE \$ 15

RECEIPT

6718 \$015.00 - 8

CITY OF LAS VEGAS

MUST BE MACHINE VALIDATED

15 APR 77

