

4104 Nightingale St.

— L-37 Blk. 2 Sub. Valley West Z-R1 —

11. Gatewood January 3, 1973

CITY OF LAS VEGAS, NEVADA

LOG NO. & AREA

733-3
DEPARTMENT OF BUILDING & SAFETY

CONST. VAL. \$

20406

APPLICATION & BUILDING PERMIT — for:
Dwellings, Duplexes, Misc. Residential Const.

ADDRESS OF
CONSTRUCTION:

4104 Nightingale Street

OWNER:

Lake Tree, A Partnership

LOT(s)

37

BLOCK

2

SUBDIVISION

Valley West

ZONE:

R-1

Existing structure on lot: Dwelling



Accessory bldgs.



Vacant lot



Other



PROPOSED CONSTRUCTION: (1) One single family dwelling - fireplace optional

USE:

Residential

MATERIALS OF CONSTRUCTION:

Wood Frame



Concrete Block



Reinforced Concrete



Steel Frame



SQ. FEET OF FLOOR AREAS:

1st

1345

2nd

3rd

Other

436

TOTAL SQ. FT.

1913

FIRE ZONE: 1 2 3

Occupancy Group 1 2

CONST. TYPE

I II III IV V

ARCHITECT:

L.C. Majors & Assoc.

ENGINEER:

S.E. & A.

NO. of UNITS

1

NO. of STORIES

1

Plans Submitted?

Yes



No



Calculations Submitted

Yes



No



Sewer Fee Req'd.

Yes



No



CONTRACTOR:

Cheger, Inc.

STATE

LICENSE #

11114

CITY

LICENSE #

7358

ADD'L. PERMITS REQ'D:

Air Cond.



Elec.



Plumbing



Signs



Paving



Fence



Public Walks



Curb-gutters



Incinerators



Fire Sprinkling System



CONDITIONS OF THE PERMIT:

1. I agree to call the City Building Department for inspections before concrete is poured, before rough wiring, electrical, plumbing, framing is covered. Also for air conditioning, sheet-rock and sheathing inspection.
2. I agree that when the job is completed that I will call for final inspection before occupancy.
3. I agree to perform all construction in accordance with City Ordinances and Building Codes.
4. The Contractor's signature below denotes authority from the owner to sign in his behalf and that the owner is aware of all requirements of this application and permit. Separate permits must be taken out for work outlined above this agreement.
5. I have read and understand the contents of this application and permit; I hereby state that the information I have supplied on this application is true and correct.

Approval for the work under this permit will be given only after refuse and debris have been removed from job site and public right of way.

SIGNED:

Cheger, Inc.

Contractor

BY:

James W. Hihlert

Agent or Owner

CLAY COUNTY HEALTH DEPT.

Date

LAS VEGAS FIRE DEPARTMENT

Date

PLANNING DEPT.:

Date:

11-24-73

PUBLIC WORKS DEPT.:

Date:

11-29-

BUILDING DEPT.:

Date:

11/29/73

#12850

PERMIT NO.:

14100

PERMIT FEE:

86-

RECEIPT

4674 \$086.00 - 8

CITY OF LAS VEGAS
DEPT. OF
BUILDING & SAFETY

MUST BE MACHINE VALIDATED

30 NOV 73

L. Gatewood January 3, 1979

CITY OF LAS VEGAS, NEVADA
DEPARTMENT OF BUILDING & SAFETY

**RECEIPT
FOR
(SEWER CONNECTION FEE**

JOB ADDRESS: 4104 Nightingale Street OWNER'S NAME: Laketree, A Partnership
LOT 37 BLOCK 2 SUBDIVISION Valley West Unit #1

QUANTITY	OCCUPANCY	UNIT FEE	AMOUNT
1	Single family dwelling	\$150.00	\$150.00

PAID BY: Chequer, Inc.

TOTAL \$150.00

Less Credit* --

TOTAL FEE \$ 150.00

*Credit for existing sewer is applied to the new sewer connection fee based on previous type of occupancy and only when the new occupancy requires an additional fee.

This receipt does not authorize the owner or his representative to start any work without obtaining a plumbing permit.

WRJ
DEPARTMENT OF BUILDING & SAFETY

1/24/73
DATE

RECEIPT NO. 11994 SEWER FEE \$ 150

73102

RECEIPT

4681 \$150.00 - 3

CITY OF LAS VEGAS
DEPT. OF
BUILDING & SAFETY

MUST BE MACHINE VALIDATED

30 NOV 73

4104 Nightingale January 3, 1974

CITY OF LAS VEGAS, NEVADA

DEPARTMENT OF BUILDING & SAFETY - APPLICATION AND PERMIT FOR PLUMBING

ADDRESS OF CONSTRUCTION: 4104 Nightingale St. OWNER'S NAME: McGill & Bailey

CIRCLE: New Bldg.; Add'n: Remodel; TYPE OF BLDG.: SFD APT. PUBLIC COMM.

CONTRACTOR'S NAME: Sterling Plumbing STATE LICENSE # 7119 CITY LICENSE # 910

UNITS	DESCRIPTION	FEE	TOTAL
1	Bathtub	1.00	100
1	Shower	1.00	100
2	Lavatory	1.00	200
2	Toilet	1.00	200
	Urinal	1.00	
	Floor Drain	1.00	
	Floor Sink	1.00	
	Wash Tray	1.00	
1	Sink	1.00	100
1	Garbage Disposal	1.00	100
	Garbage Disposal (comm.)	3.00	
	Clothes Dryer (gas)	1.00	
1	Clothes Washer	1.00	100
1	Clothes Washer (comm.)	5.00	
1	Dishwasher	1.00	100
	Dishwasher (commercial)	5.00	
	Dental Unit	10.00	
	Drinking Fountain	1.00	
	Any Water using Equipment	1.00	
1	Water Heater (gas/elect.)	1.00	100
1	Sewer System - New, Replacement, or any Drainage System	4.00	400
	Grease or Sand Trap	2.00	
	Trailer Trap	2.00	
	Septic Disposal System	4.00	
WATER SOFTENERS			
	Nonpermanent Type	4.00	
	Permanent Type (connected to Drainage)	5.00	
SWIMMING POOLS			
	Private or Wading Pool	10.00	
	Public or Semi-public	20.00	

UNITS	DESCRIPTION	FEE	TOTAL
WATER DISTRIBUTION SYSTEM			
1	Single Family Dwelling	4.00	200
	Multiple Family Dwelling plus each unit	4.00	
	Bldg. Group "A" thru "G" per each floor	2.00	
	Hotel or Motel plus each bath	6.00	
	Hotel or Motel plus each bath	4.00	
	Hotel or Motel plus each bath	1.50	
1	Trailer Park plus each space	20.00	
	Irrigation	4.00	
GAS PIPING SYSTEM			
1	Single Family Dwelling	3.00	300
	Multiple Family Dwelling plus each unit	6.00	
	Commercial Bldg. per floor plus each unit	1.00	
	Commercial Bldg. per floor plus each unit	3.00	
	Gas Appliance (any type)	3.00	
	Gas Appliance (any type)	1.00	
AUTOMATIC FIRE EXTINGUISHING SYSTEM			
	Underground Piping	10.00	
	Distribution Piping ea. ft.	.01	
	Sprinkler Head each	.10	
	In Range Hood and Vent	5.00	
DRY STANDPIPE SYSTEM			
	Piping	50.00	
	Each Outlet	1.00	
WET STANDPIPE SYSTEM			
	Piping	5.00	
	Fire Hose Cabinet	1.00	
MINIMUM PERMIT FEE			
TOTAL PERMIT FEE \$ 22.00			

I hereby certify that I have carefully examined and read the above application; that the same is true and correct; and that the work herein described is to be done in accordance with all the provisions of the applicable Ordinances of the City of Las Vegas, Nevada and the State Laws, whether herein specified or not.

Signed: [Signature] Date: 12-10-73
REGISTERED MASTER PLUMBER, SPEC. CONTR. OR OWNER

Building Department: [Signature] Date: 12-10-73

#12870 Permit No. 12096 Permit Fee \$ 22.00

RECEIPT
5142 \$022.00 - 7
CITY OF LAS VEGAS
DEPT. OF BUILDING & SAFETY
MUST BE MACHINE DATED
11 DEC 73

11. Gatewood January 3/1979

CITY OF LAS VEGAS, NEVADA

DEPARTMENT OF BUILDING & SAFETY - ELECTRICAL APPLICATION & PERMIT

ADDRESS OF CONSTRUCTION: 104 Nightengale Street OWNER'S NAME: McGah & Bailey

CIRCLE: New Bldg.; Add'n.; Remodel; TYPE OF BLDG.: SFD. APT. PUBLIC COMM.

CONTRACTOR'S NAME: Roberts Electric STATE LICENSE # 4528 CITY LICENSE # 3392

NUMBER	FIXTURE OR INSTALLATION	UNIT PRICE	TOTAL
	Rm addition, carport or garage enclosure	4.00	
	Temporary power	4.00	
60	Light, receptacle or switch outlet	.20	12.00
	Wall or ceiling space heater	.35	
1	Garbage grinder outlet	.35	.35
1	Dishwasher outlet	.35	.35
1	Clothes dryer outlet	.35	.35
	Automatic clothes washer	.35	
	Electric range outlet	.35	
	Electric water heater outlet	.35	
	Special purpose outlet	.35	
	X-ray unit and its appurtenances	5.00	
	Watts of festoon lighting (Watts) First 3,000 watts for each additional thousand watts	4.00 1.50	
	Horsepower each motor first horsepower or less for each additional horsepower	1.75 .35	
1	Electric service (including any single meter socket) for each additional socket	3.00 .35	3.00
1	Air conditioning service	1.50	1.50
	Each KW(KVA) Generator (Transformer, Welder) First 100 KVA for each additional KW(KVA)	2.00 .01	
	Speaker, signal or alarm outlet	.15	
	Amplifiers	.50	
	Control panels	.25	
	Main control racks	1.00	
	T.V. and radio antennas-master system only	.75	
	Minimum fee for any permit	4.00	
	TOTAL FEE		17.55

Approval for the work under this permit will be given only after refuse and debris have been removed from job site and public right of way.

I hereby certify that I have carefully examined and read the above application; that the same is true and correct; and that the work herein described is to be done in accordance with all the provisions of the applicable Ordinances of the City of Las Vegas, Nevada and State laws whether herein specified or not.

SIGNED

MASTER (ELECTRICIAN) (TECHNICIAN) (OWNER)

DATE 12/12/73

BUILDING DEPARTMENT

DATE

#12860

PERMIT NO.

PERMIT FEE: \$

RECEIPT

5294 \$017.55 - 6
CITY OF LAS VEGAS
DEPT. OF
BUILDING & SAFETY

MUST BE MACHINE VALIDATED

17 DEC 73

L. Gatewood January 3, 1979

CITY OF LAS VEGAS, NEVADA
DEPARTMENT OF BUILDING & SAFETY — AIR CONDITIONING APPLICATION & PERMIT

ADDRESS OF
CONSTRUCTION: 4104 Nightingale St.

OWNER'S
NAME: Mc Gah - Bailey

CIRCLE: Addition; Remodel; New Bldg;

TYPE OF BLDG.: SFD APT. COMM PUBLIC

CONTRACTOR'S NAME: Certified Air Conditioning Co. STATE LICENSE 11191 CITY LICENSE 11417 C11-900-2

UNITS	DESCRIPTION	FEE	TOTAL	UNITS	DESCRIPTION	FEE	TOTAL
	Unit heater — floor, wall or suspended	4.00			EVAPORATIVE COOLERS:		
	FOR EACH FORCED-AIR OR GRAVITY-TYPE FURNACE OR BURNER INCLUDING DUCTS AND VENT ATTACHED TO SUCH APPLIANCES:				5 outlets or under	3.00	
	Up to and including 100,000 B.t.u.'s	4.00			Over 5 and up to and including 10	5.00	
	Over 100,000 B.t.u.'s	6.00			Each additional outlet over 10	.25	
	FOR EACH HEATING APPLICATION, REFRIGERATION UNIT, COMFORT COOLING AND HEATING UNIT, ABSORPTION UNIT, COMPRESSOR OR BOILER:				VENTILATION:		
	Up to and including 3 ton or horsepower, or absorption system up to and including 100,000 B.t.u.'s	4.00			For each fan connected to a single duct	1.00	
(1) 4ton	Over 3 ton or 3 horsepower up to and including 10, or absorption system over 100,000 B.t.u.'s up to and including 250,000 B.t.u.'s	7.00	7.00		For each commercial or industrial ventilation system	5.00	
	Over 10 ton or 10 horsepower up to and including 30, or absorption system over 250,000 B.t.u.'s up to and including 1,000,000 B.t.u.'s	12.00			For each commercial kitchen hood	5.00	
	Over 30 ton or 30 horsepower up to and including 50, or absorption system over 1,000,000 B.t.u.'s up to and including 1,700,000 B.t.u.'s	20.00			MISCELLANEOUS:		
	Over 50 ton or 50 horsepower, or absorption system over 1,700,000 B.t.u.'s	30.00			For each water cooling tower	8.00	
	FOR EACH AIR HANDLING UNIT INCLUDING DUCTS ATTACHED THERETO:				Duct work only — each opening	.25	
	Up to and including 10,000 CFM	2.00			For installation or relocation of each commercial or industrial incinerator	15.00	
	Over 10,000 CFM	4.00			Gas piping related to the air cond. work in single family dwelling only	3.00	
					For each appliance, piece of equipment, any mechanical work or alteration or replacement not included in this schedule, the permit fee shall be computed the same as building permit fees by using the cost of installation for the valuation amount.		
					FOR THE ISSUANCE OF EACH PERMIT		
					TOTAL PERMIT FEE \$	10.00	

I hereby certify that I have carefully examined and read the above application; that the same is true and correct; and that the work herein described is to be done in accordance with all the provisions of the applicable Ordinances of the City of Las Vegas, Nevada and the State Laws, whether herein specified or not.

SIGNED

Air Conditioning Contractor - Owner

Date 12-21-73

BUILDING DEPARTMENT

Date

PERMIT NO. 4885

PERMIT FEE \$ 10.00

RECEIPT

5591 \$010.00 - 4

CITY OF LAS VEGAS

DEPT. OF BUILDING & SAFETY
MUST BE MACHINE VALIDATED

12890

11 DEC 73

L. Gatewood January 3, 1974

CITY OF LAS VEGAS, NEVADA

DEPARTMENT OF BUILDING & SAFETY - ELECTRICAL APPLICATION & PERMIT

ADDRESS OF
CONSTRUCTION:

4104 Nightingale

OWNER'S
NAME:

Jack Woodcock

CIRCLE: New Bldg.; Add'n.; Remodel; TYPE OF BLDG.: SFD. APT. PUBLIC COMM.

CONTRACTOR'S NAME:

owner

STATE
LICENSE #

CITY
LICENSE #

NUMBER	FIXTURE OR INSTALLATION	UNIT PRICE	TOTAL
	Rm addition, carport or garage enclosure	4.00	
	Temporary power	4.00	
1	Light, receptacle or switch outlet	.20	
	Wall or ceiling space heater	.35	
	Garbage grinder outlet	.35	
	Dishwasher outlet	.35	
	Clothes dryer outlet	.35	
	Automatic clothes washer	.35	
	Electric range outlet	.35	
	Electric water heater outlet	.35	
	Special purpose outlet	.35	
	X-ray unit and its appurtenances	5.00	
	Watts of festoon lighting (Watts) First 3,000 watts for each additional thousand watts	4.00 1.50	
	Horsepower each motor first horsepower or less for each additional horsepower	1.75 .35	
	Electric service (including any single meter socket) for each additional socket	3.00 .35	
	Air conditioning service	1.50	
	Each KW(KVA) Generator (Transformer, Welder) First 100 KVA for each additional KW(KVA)	2.00 .01	
	Speaker, signal or alarm outlet	.15	
	Amplifiers	.50	
	Control panels	.25	
	Main control racks	1.00	
	T.V. and radio antennas-master system only	.75	
	Minimum fee for any permit	4.00	
	TOTAL FEE		

Approval for the work under this permit will be given only after refuse
and debris have been removed from job site and public right of way.

I hereby certify that I have carefully examined and read the above application; that the same is true and correct; and that the work herein described is to be done in accordance with all the provisions of the applicable Ordinances of the City of Las Vegas, Nevada and State laws whether herein specified or not.

SIGNED

MASTER (ELECTRICIAN) (TECHNICIAN) (OWNER)

DATE

4 Feb 74

BUILDING DEPARTMENT

DATE

2-4-74

#12860

PERMIT NO.

8559

PERMIT FEE: \$

7.00

RECEIPT

6858

\$004.00 - 6

CITY OF LAS VEGAS

DEPT. OF
BUILDING & SAFETY

MUST BE MACHINE VALIDATED

4 FEB 74

21. Gatewood January 3, 1974

CITY OF LAS VEGAS, NEVADA

LOG NO. & AREA

DEPARTMENT OF BUILDING & SAFETY

CONST. VAL. \$

1574⁰⁰

APPLICATION & BUILDING PERMIT — for:
Fence, Wall, Retaining Wall.

ADDRESS OF
CONSTRUCTION:

4104 NIGHTINGALE ST.

OWNER:

JACK WOODCOCK

LOT(s)

BLOCK

SUBDIVISION

ZONE:

Materials of Construction:

Block

☒

Concrete

☐

Wire

☐

Wood

☒

Other

☐

Yes

No

PLANS:

☐

☐

ARCHITECT:

ENGINEER:

CALCS:

☐

☐

CONTRACTOR:

TOM L. YELEY

STATE

LICENSE #

10350

CITY

LICENSE #

311 346 200644

Remarks:

TOTAL SQUARE FEET:


1372

TOTAL LINEAL FEET:

282

CONDITIONS OF THE PERMIT:

1. Any type of retaining wall must be engineered by a Civil or Structural Engineer.
2. If a home owner takes out the Building Permit and if the owner sublets the work to a Contractor, then the Contractor must take out the permit and pay for it.
3. No fence or wall can be built on City property or rights-of-way, but this is not intended to preclude construction within utility easements if utilities will not be damaged or made inaccessible.
4. The fence or wall shall not enclose any water meter, light standard, or fire alarm box and shall not come closer than 24" from the nearest fire hydrant outlet.
5. Department Inspectors must approve footings before concrete is poured and block wall reinforcing before grouting is done.
6. Maximum height of any wall or fence is 6', side and rear yards: 4' maximum in front yard with the vertical surface above the height of 2' — 50% open.
7. I must not obstruct required onsite parking space (2 spaces for each dwelling unit) by the erection of this fence or wall.
8. By the signing of this application I herewith agree to the requirements outlined above.

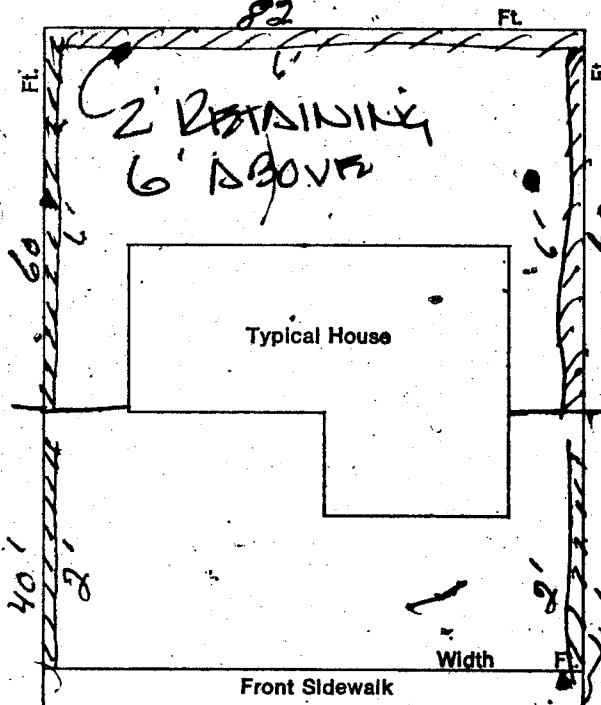

SIGNED:

Tom Yeley

DATE:

4-29-74

CONTRACTOR ☒

AGENT ☐

OWNER ☐

PLANNING DEPT:

Date:

4/29/74

PUBLIC WORKS DEPT:

Date:

BUILDING DEPT:

Date:

4-29-74

#12850

PERMIT NO:

10362

PERMIT FEE:

15.00

RECEIPT

1556 \$015.00 - 8

CITY OF LAS VEGAS
DEPT. OF
BUILDING & SAFETY

MUST BE MACHINE VALIDATED

2-7-74

L. Gatewood January 3, 1974

CITY OF LAS VEGAS, NEVADA

LOG NO. & AREA

DEPARTMENT OF BUILDING & SAFETY

CONST. VAL. \$

1574⁰⁰

APPLICATION & BUILDING PERMIT — for:
Fence, Wall, Retaining Wall.

ADDRESS OF
CONSTRUCTION:

4104 NIGHTINGALE ST.

OWNER: JACK WOODCOCK

LOT(s)

BLOCK

SUBDIVISION

ZONE:

Materials of Construction:

Block

☒

Concrete

☐

Wire

☐

Wood

☒

Other

☐

Yes

No

PLANS:

☐

☐

ARCHITECT:

ENGINEER:

CALCS:

☐

☐

CONTRACTOR:

TOM J. YELEY

STATE

LICENSE #

10350

CITY

LICENSE #

311 346 20064

Remarks:

TOTAL SQUARE FEET:


1372

TOTAL LINEAL FEET:

282

CONDITIONS OF THE PERMIT:

1. Any type of retaining wall must be engineered by a Civil or Structural Engineer.
2. If a home owner takes out the Building Permit and if the owner sublets the work to a Contractor, then the Contractor must take out the permit and pay for it.
3. No fence or wall can be built on City property or rights-of-way, but this is not intended to preclude construction within utility easements if utilities will not be damaged or made inaccessible.
4. The fence or wall shall not enclose any water meter, light standard, or fire alarm box and shall not come closer than 24" from the nearest fire hydrant outlet.
5. Department Inspectors must approve footings before concrete is poured and block wall reinforcing before grouting is done.
6. Maximum height of any wall or fence is 6', side and rear yards: 4' maximum in front yard with the vertical surface above the height of 2' — 50% open.
7. I must not obstruct required onsite parking space (2 spaces for each dwelling unit) by the erection of this fence or wall.
8. By the signing of this application I herewith agree to the requirements outlined above.

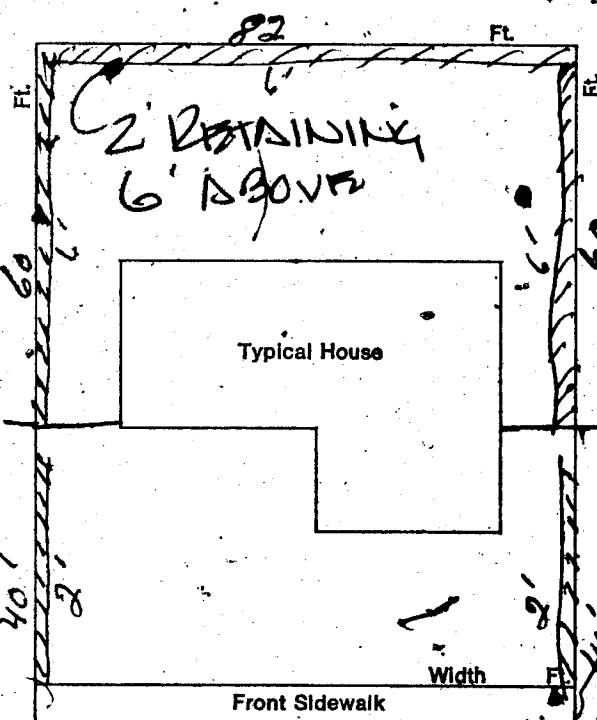

SIGNED:

Tom J. Yeley

DATE:

4-29-74

CONTRACTOR ☒

AGENT ☐

OWNER ☐

PLANNING DEPT:

Date:

4/29/74

PUBLIC WORKS DEPT:

Date:

BUILDING DEPT:

Date:

4-29-74

#12850

PERMIT NO:

10362

PERMIT FEE \$

15.00

RECEIPT

1556 \$015.00 - 8

CITY OF LAS VEGAS
DEPT. OF
BUILDING & SAFETY

MUST BE MACHINE VALIDATED

2-7-74

11. Gatewood - Sunday 3, 1976

318 / CITY OF LAS VEGAS, NEVADA

LOG NO. & AREA _____ CONST. VAL. \$1728

DEPARTMENT OF BUILDING & SAFETY APPLICATION & BUILDING PERMIT — for:
Dwellings, Duplexes, Misc. Residential Const.

ADDRESS OF CONSTRUCTION: 4104 Nightingale OWNER: Jack Woodcock

LOT(s) 37 BLOCK 2 SUBDIVISION URBAN WEST ZONE: R-1

Existing structure on lot: Dwelling ☒ Accessory bldgs. ☐ Vacant lot ☐ Other ☐

PROPOSED CONSTRUCTION: Room Addition Enc. patio USE: Family room

MATERIALS OF CONSTRUCTION: Wood Frame ☐ Concrete Block ☐ Reinforced Concrete ☐ Steel Frame ☐

SQ. FEET OF FLOOR AREAS: 1st _____ 2nd _____ 3rd _____ Other _____ TOTAL SQ. FT. 288


FIRE ZONE: 1 2 3 Occupancy Group I J 1-2 CONST. TYPE: I II III IV V

ARCHITECT: _____ ENGINEER: _____ NO. of UNITS 1 NO. of STORIES _____

Plans Submitted: Yes ☐ No ☐ Calculations Submitted: Yes ☐ No ☐ Sewer Fee Req'd: Yes ☐ No ☐

CONTRACTOR: OWNER STATE LICENSE # _____ CITY LICENSE # _____

ADD'L. PERMITS REQ'D: Air Cond. ☐ Elec. ☐ Plumbing ☐ Signs ☐ Paving ☐ Fence ☐ Public Walks ☐ Curb-gutters ☐
Incinerators ☐ Fire Sprinkling System ☐

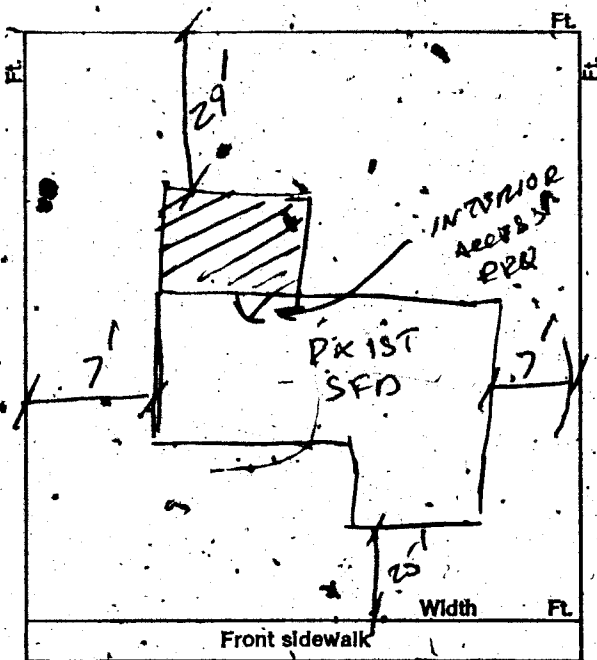

- CONDITIONS OF THE PERMIT:
1. I agree to call the City Building Department for inspections before concrete is poured, before rough wiring, electrical, plumbing, framing is covered. Also for air conditioning, sheet-rock and sheathing inspection.
 2. I agree that when the job is completed that I will call for final inspection before occupancy.
 3. I agree to perform all construction in accordance with City Ordinances and Building Codes.
 4. The Contractor's signature below denotes authority from the owner to sign in his behalf and that the owner is aware of all requirements of this application and permit. Separate permits must be taken out for work outlined above this agreement.
 5. I have read and understand the contents of this application and permit; I hereby state that the information I have supplied on this application is true and correct.

SIGNED: _____ Contractor

BY: Jack Woodcock Agent or Owner

CLARK COUNTY HEALTH DEPT. _____ Date _____

LAS VEGAS FIRE DEPARTMENT _____ Date _____

PLANNING DEPT. _____ Date: 6/3/76

PUBLIC WORKS DEPT. _____ Date: _____

BUILDING DEPT.: H. T. Blake Date: 4-3-76

PERMIT NO. 2947 PERMIT FEE \$1500

RECEIPT

2934 \$015.00 - 8

CITY OF LAS VEGAS
DEPT. OF BUILDING & SAFETY

MUST BE MACHINE VALIDATED

- JAN 76

L. Gatewood January 3, 1974

CITY OF LAS VEGAS, NEVADA

DEPARTMENT OF BUILDING & SAFETY - ELECTRICAL APPLICATION & PERMIT

ADDRESS OF
CONSTRUCTION:

4104 Nightingale

OWNER'S
NAME:

Jack Woodcock

CIRCLE: New Bldg.; Add'n.; Remodel; TYPE OF BLDG.: SFD. APT. PUBLIC COMM.

CONTRACTOR'S NAME:

Owner

STATE
LICENSE #

CITY
LICENSE #

NUMBER	FIXTURE OR INSTALLATION	UNIT PRICE	TOTAL
	Rm addition, carport or garage enclosure	4.00	
	Temporary power	4.00	
	Light, receptacle or switch outlet	.20	
	Wall or ceiling space heater	.35	
	Garbage grinder outlet	.35	
	Dishwasher outlet	.35	
	Clothes dryer outlet	.35	
	Automatic clothes washer	.35	
	Electric range outlet	.35	
	Electric water heater outlet	.35	
	Special purpose outlet	.35	
	X-ray unit and its appurtenances	5.00	
	Watts of festoon lighting (Watts) First 3,000 watts for each additional thousand watts	4.00 1.50	
	Horsepower each motor first horsepower or less for each additional horsepower	1.75 .35	
	Electric service (including any single meter socket) for each additional socket	3.00 .35	
	Air conditioning service	1.50	
	Each KW(KVA) Generator (Transformer, Welder) First 100 KVA for each additional KW(KVA)	2.00 .01	
	Speaker, signal or alarm outlet	.15	
	Amplifiers	.50	
	Control panels	.25	
	Main control racks	1.00	
	T.V. and radio antennas-master system only	.75	
	Minimum fee for any permit	4.00	
	TOTAL FEE		

Approval for the work under this permit will be given only after refuse
and debris have been removed from job site and public right of way.

I hereby certify that I have carefully examined and read the above application; that the same is true and correct; and that the work herein described is to be done in accordance with all the provisions of the applicable Ordinances of the City of Las Vegas, Nevada and State laws whether herein specified or not.

SIGNED

MASTER (ELECTRICIAN) (TECHNICIAN) (OWNER)

DATE

BUILDING DEPARTMENT

DATE

#12860

PERMIT NO.

PERMIT FEE: \$

RECEIPT

2935 \$004.00 - 6

CITY OF LAS VEGAS

BUILDING & SAFETY

MUST BE MACHINE VALIDATED

JAN 14 1974

Dona Healey 10-20-72

DEPARTMENT OF BUILDING & SAFETY
CITY OF LAS VEGAS, NEVADA

KARDEX CARD
FENCE & RETAINING
WALLS
DATE 4-29-74

OWNER Jack Woodcock ADDRESS 4104 Nightingale
CONTRACTOR Tom Yeley PERMIT NO. 16363
LOT BLOCK SUBDIVISION block fence

Fence (wire, wood, etc.)	Walls (masonry, rock, etc.)
Location	Location <u>ER 4-30-74</u>
Final Inspection	Footing <u>ER 4-30-74</u>
	Wall Steel 1st <u>ER 4-30-74</u> 2d <u>ER 4-30-74</u> 3d <u>ER 4-30-74</u>
	Final Inspection <u>ER 4-30-74</u>
Retaining Wall (masonry)	Retaining Wall (concrete)
Location	Location
Footings	Footings
Wall Steel 1st <u>ER 4-30-74</u> 2d <u>ER 4-30-74</u> 3d <u>ER 4-30-74</u>	Wall Steel 1st <u>ER 4-30-74</u> 2d <u>ER 4-30-74</u> 3d <u>ER 4-30-74</u>
Bond Beam 1st <u>ER 4-30-74</u> 2d <u>ER 4-30-74</u> 3d <u>ER 4-30-74</u>	Final Inspection <u>ER 4-30-74</u>
Final Inspection	

23.14 B ADDRESS 4104 Nightingale LOG NO. AREA

DEPT. of BLDG. & SAFETY - CITY of LAS VEGAS, NEVADA

OWNER Laketree ADDRESS 4104 Nightingale St. DATE 11-29-73
GEN. CONT. Chequer Inc. TYPE OF STRUCTURE SFD
PERMIT NO. 14100 LEGAL DESCRIPTION L 37 B 2 Valley West

BUILDING	MECHANICAL	ELECTRICAL
Investigation	Plumbing Cont. <u>Stirling</u>	Temp. pole cont.
Location & Footing <u>ER 12-5-73</u>	Permit No. <u>12094</u> Date <u>12-11-73</u>	Permit No. Date
Stem Wall <u>ER 12-14-73</u>	Heat & Vent. A/C Cont. <u>Outfitter</u>	Inspection Date
Concrete Slab Floor <u>ER 12-21-73</u>	Permit No. <u>4885</u> Date <u>12-26-73</u>	Electrical Cont. <u>Robert Owen</u>
Floor Framing	Sewer Cont. <u>Chequer Inc.</u>	Permit No. <u>8243-8538</u> Date <u>73</u>
Fireplace Footing <u>ER 3-20-74</u>	Permit No. <u>11994</u> Date	Fixtures Cont.
Chimney Steel <u>ER 3-20-74</u>	Rough Soil <u>KW 12-18-73</u>	Permit No. Date
Vert. Steel Reinf.	Rough Water	Slab
Horiz. Steel Reinf.	Top-Out <u>KW 25-74</u>	Rough <u>ER 2-4-74</u>
Roof Sheathing <u>ER 1-25-74</u>	Rough Gas	Final Rough
Framing <u>ER 1-29-74</u>	A/C Rough Duct <u>KW 2-5-74</u>	Final Fixture
Backing for siding <u>ER 2-4-74</u>	Ref. Rough Piping	Final Electrical <u>ER 3-29-74</u>
Ext. Lath	Final Plumbing <u>KW 3-29-74</u>	Temporary Service
Ext. Scratch <u>ER 2-8-74</u>	Final Gas <u>KW 3-29-74</u>	MISCELLANEOUS
Ext. Brown <u>ER 2-14-74</u>	Final Air Cond. <u>KW 3-29-74</u>	Grading & Drainage
Int. Lath	Final Refrig.	On-Site Parking Spaces - App.
Int. Brown	Final Sewer <u>WER 1-17-74</u>	Eng. Approval of
Drywall <u>ER 2-8-74</u>	Final Septic Tank	Off-Site Improvements
Permit No.		
Final Building		
Appr. for Occu.		

INSPECTOR:

DATE

APPROVED FOR OCCUPANCY & METER

PLEASE NOTE REMARKS ON REVERSE SIDE

ER 3-29-74

4104 Nightingale St. LOG # AREA # T 33-3

Don Hooley

10-20-76

DEPT. of BLDG. & SAFETY - CITY of LAS VEGAS, NEVADA		
OWNER	Jack Woodcock	ADDRESS
GEN. CONT.	Owner	4104 Nightingale
PERMIT NO.	2947	DATE
		6-3-76
LEGAL DESCRIPTION		TYPE OF STRUCTURE
L 37 B 2 Valley West		Enc patio
BUILDING	MECHANICAL	ELECTRICAL
Investigation	Plumbing Cont.	Temp/pole cont.
Location & Footing	Permit No.	Permit No.
Stem Wall	Heat & Vent. A/C Cont.	Inspection
Concrete Slab Floor	Permit No.	Electrical Cont.
Floor Framing	Sewer Cont.	Permit No.
Fireplace Footing	Permit No.	Fixtures Cont.
Chimney Steel	Rough Soil	Permit No.
Vert. Steel Reinf.	Rough Water	Slab
Horiz. Steel Reinf.	Top Out	Bough
Roof Sheathing	Rough Gas	Final Rough
Framing	A/C Rough Duct	Final Fixture
Backing for siding	Ref. Rough Piping	Final Electrical
Ext. Lath	Final Plumbing	
Ext. Scratch	Final Gas	
Ext. Brown	Final Air Cond.	
Int. Lath	Final Refrig.	
Int. Brown	Final Sewer	
Drywall	Final Septic Tank	
Permit No.		
Final Building		
Appr. for Occu.		
		MISCELLANEOUS
		Grading & Drainage
		On-Site Parking Spaces
		Eng. Approval of
		Off-Site Improvements

APPROVED FOR OCCUPANCY & METER

INSPECTOR:

DATE

PLEASE NOTE REMARKS ON REVERSE SIDE 4104 Nightingale

LOG #

AREA #