



7451 O'Bannon

NOTE:
 ALL COR BOLTS:
 SW 1 and SW 2 USE $\frac{1}{2}$ " ϕ A3, J 48' OC
 SW 2 and SW 5 USE $\frac{1}{2}$ " ϕ A3, J 32' OC
 SW 7 USE $\frac{1}{2}$ " ϕ A3, J 16' OC
 SW 8 USE $\frac{1}{2}$ " ϕ A3, J 24' OC
 ALL OTHER WALLS USE $\frac{1}{2}$ " ϕ A3, J 16' OC

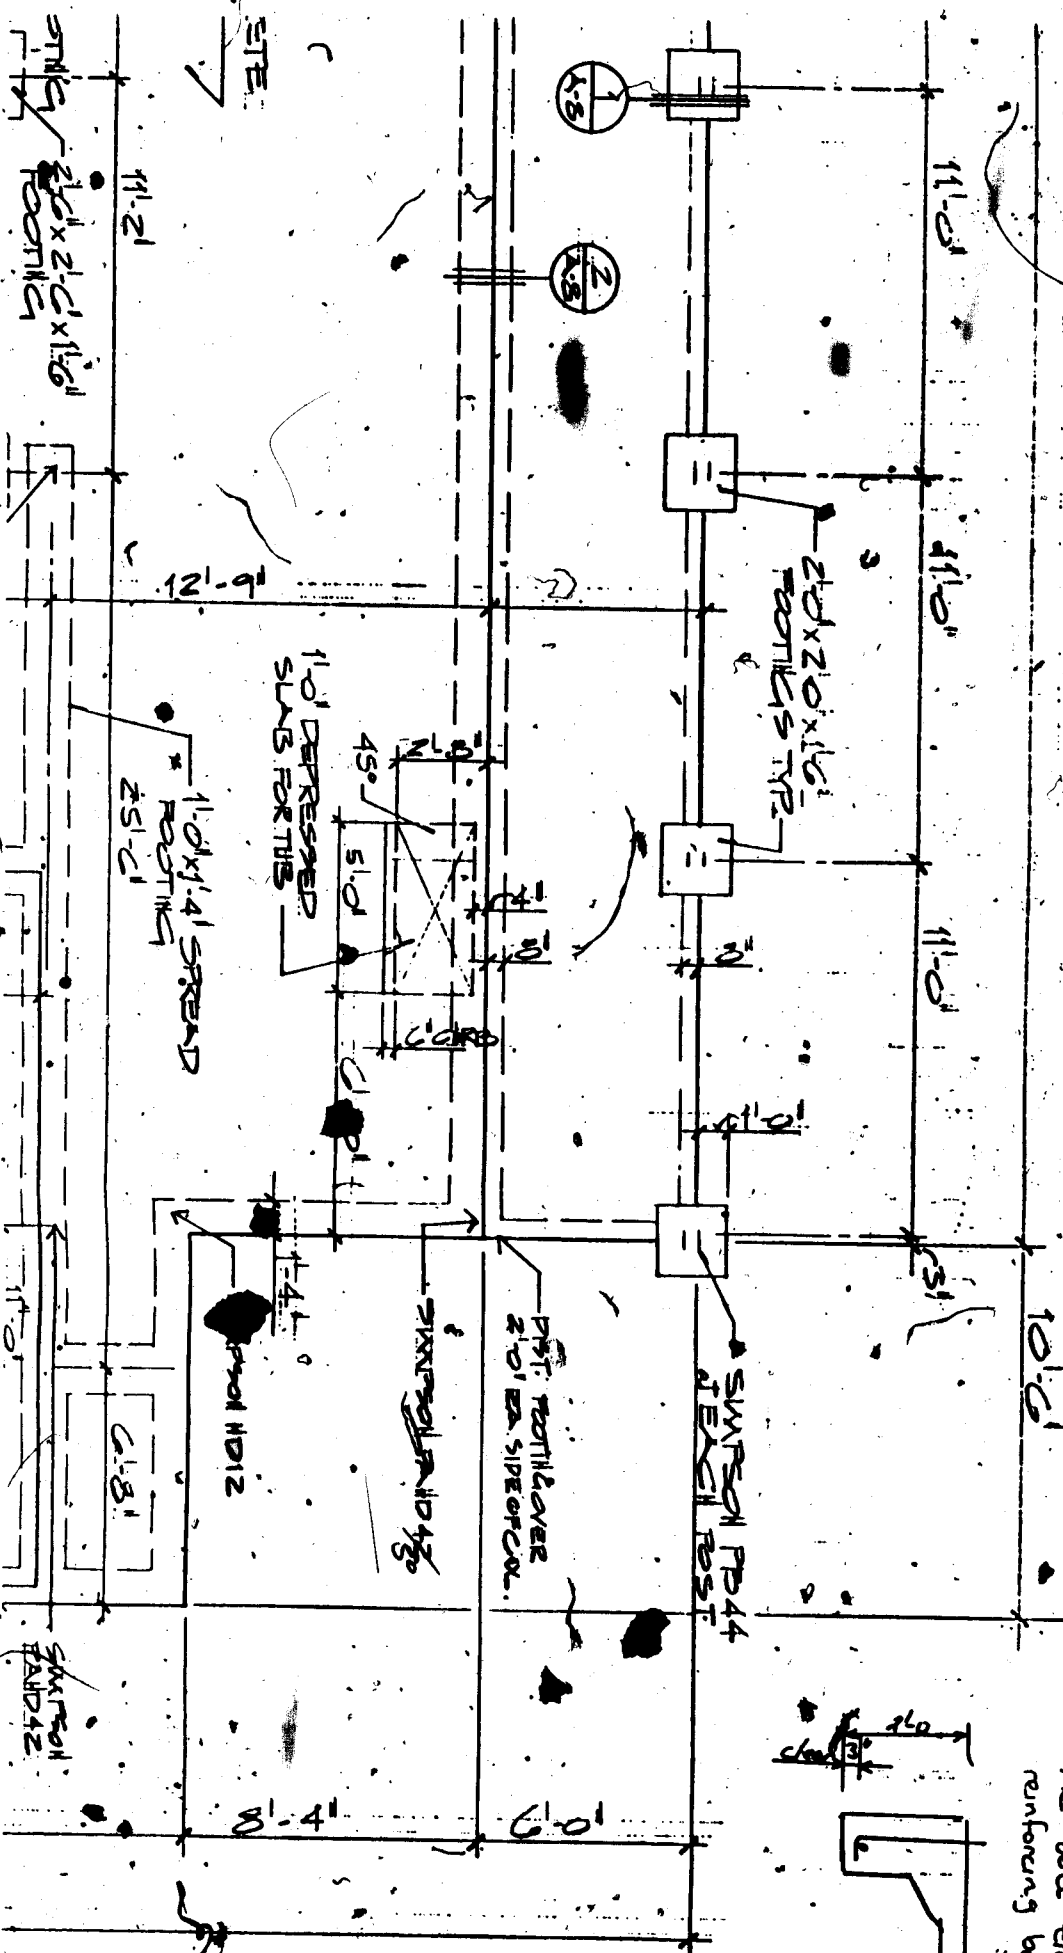

Anchore Bolt- For SIMPSON HOD DOWD
HD12 is acceptable with an embedment
length of 21" at shear wall 7 with
the bolt tied to the horizontal steel
reinforcing bar.

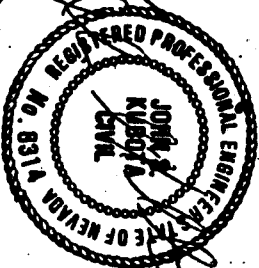

7451. *O. B. Anderson*

PLANS APPROVED CONSTRUCTION

JUN 8 1985

Make No Change Without Approval Of Plant/Field Agent To Visiting Agent