

A 6321 PARSIFAL PL

B 6323 PARSIFAL PL

— L 25

B 9

CHARLESTON HEIGHTS #29-A

ZONE R-1 —

154 Dated: January 29, 1980

CITY OF LAS VEGAS, NEVADA

LOG NO. & AREA
DEPARTMENT OF BUILDING & SAFETY

CONST. VAL. 1560
APPLICATION & BUILDING PERMIT for:
Dwellings, Duplexes, Misc. Residential Const.

ADDRESS OF
CONSTRUCTION:

321 PARISIAN RD. OWNER: DANIEL S. HELLMAN
LOT(S) 25 BLOCK 9 SUBDIVISION Charleston Heights 29A ZONE R-1

Existing structure on lot: Dwelling ☐ Accessory bldgs. ☐ Vacant lot ☐ Other ☐

PROPOSED CONSTRUCTION: REMODEL EXIST. 9 FIREPLACE DIVE IN

MATERIALS OF CONSTRUCTION: Wood Frame ☐ Concrete Block ☐ Reinforced Concrete ☐ Steel Frame ☐

SQ. FEET OF FLOOR AREAS: 1st 2nd 3rd Other TOTAL SQ. FT. 1560


FIRE ZONE: 1 2 3 Occupancy Group: I J 1-2 CONST. TYPE: I II III IV V

ARCHITECT: ENGINEER: NO. of UNITS NO. of STORIES

Plans Submitted: Yes ☐ No ☐ Calculations Submitted: Yes ☐ No ☐ Sewer Fee Req'd: Yes ☐ No ☐

CONTRACTOR: OWNER STATE LICENSE # CITY LICENSE #

ADD'L. PERMITS REQ'D: Air Cond. ☐ Elec. ☒ Plumbing ☐ Signs ☐ Paving ☐ Fence ☐ Public Walks ☐ Curb-gutters ☐
Incinerators ☐ Fire Sprinkling System ☐

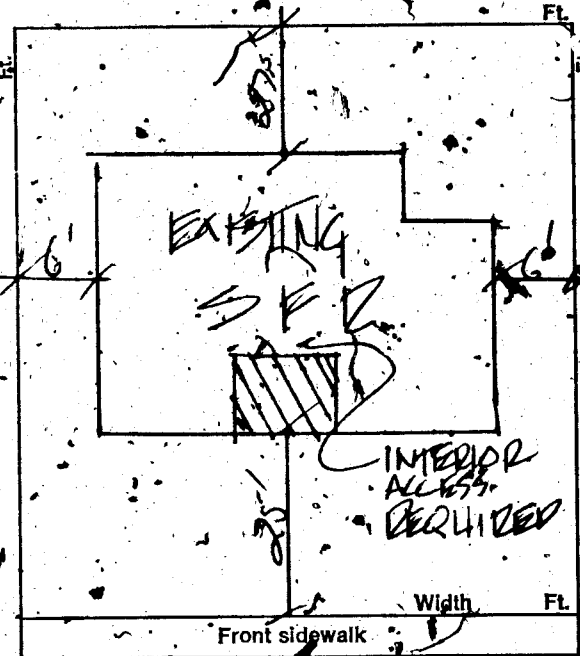

CONDITIONS OF THE PERMIT

- I agree to call the City Building Department for inspections before concrete is poured, before rough wiring, electrical, plumbing, framing is covered. Also for air conditioning, sheet-rock and sheathing inspection.
- I agree that when the job is completed that I will call for final inspection before occupancy.
- I agree to perform all construction in accordance with City Ordinances and Building Codes.
- The Contractor's signature below denotes authority from the owner to sign in his behalf and that the owner is aware of all requirements of this application and permit. Separate permits must be taken out for work outlined above this agreement.
- I have read and understand the contents of this application and permit; I hereby state that the information I have supplied on this application is true and correct.

SIGNED: Contractor

BY: Daniel S. Hellman Agent or Owner

CLARK COUNTY HEALTH DEPT. Date

LAS VEGAS FIRE DEPARTMENT Date

PLANNING DEPT. Date: 7-5-72

PUBLIC WORKS DEPT. Date:

BUILDING DEPT. Date: 7-5-72

#12850 PERMIT NO. 6001 PERMIT FEE \$ 1500

RECEIPT

9801 \$015.00 - 8

CITY OF LAS VEGAS
DEPT. OF
BUILDING & SAFETY

MUST BE MACHINE VALIDATED

- 6 JUL 72

4-4-1982 January 29, 1982

CITY OF LAS VEGAS, NEVADA

DEPARTMENT OF BUILDING & SAFETY — ELECTRICAL APPLICATION & PERMIT

ADDRESS OF
CONSTRUCTION:

6321 PARISAL R

OWNER'S
NAME:

DANIEL HEIM

CIRCLE: New Bldg.; Add'n; Remodel; TYPE OF BLDG.: SFD. APT. PUBLIC COMM.

CONTRACTOR'S NAME:

OWNEX

STATE
LICENSE #

CITY
LICENSE #

NUMBER	FIXTURE OR INSTALLATION	UNIT PRICE
	Fixture or sockets	.15
	Light, receptacle or switch outlet	.20
	Wall or ceiling space heater	.35
	Base coil heater per kilowatt	.35
	Garbage grinder outlet	.85
	Dishwasher outlet	.35
	Clothes dryer outlet	.35
	Automatic clothes washer	.35
	Electric range outlet	.35
	Electric water heater outlet	.35
	Mercury arc lamp and equipment	.35
	Special purpose outlet	.35
	X-ray unit and its appurtenances	5.00
	Watts of festoon lighting (Watts) First 3,000 watts for each additional thousand watts	4.00 1.50
	Horsepower — all motors first horsepower or less for each additional horsepower	1.75 .35
	Temporary power and lights (temporary pole)	4.00
	Electric service (including any single meter socket) for each additional socket	3.00 .35
	Air conditioning service amps	1.50
	Each KW (KVA) Generator (Transformer) (Welder) KW (KVA) First 100 KVA — For each additional KW (KVA)	2.00 .01
	Special inspection per hour	4.00
	Speaker outlets	.15
	Signal or Alarm outlets	.15
	Amplifiers	.50
	Control panels	.25
	T. V. outlets — master system only	.15
	Radio outlets	.15
	Main control rack	1.00
	T. V. and Radio antennas — master system only	.75
	Minimum fee for any permit	4.00
	Total fee	

I hereby certify that I have carefully examined and read the above application; that the same is true and correct; and that the work herein described is to be done in accordance with all the provisions of the applicable Ordinances of the City of Las Vegas, Nevada and State laws, whether herein specified or not.

SIGNED

MASTER (ELECTRICIAN) (TECHNICIAN) (OWNER)

DATE

BUILDING DEPARTMENT

DATE

#12860 PERMIT NO.

3541

PERMIT FEE:

400

RECEIPT

9802 \$004.00 - 6

CITY OF LAS VEGAS
DEPT. OF
BUILDING & SAFETY

MUST BE MACHINE VALIDATED

JUL 82

14, Haterwood January 29, 1980

CITY OF LAS VEGAS, NEVADA
DEPARTMENT OF BUILDING & SAFETY — AIR CONDITIONING APPLICATION & PERMIT

ADDRESS OF CONSTRUCTION: 6321 Pershing OWNER'S NAME: Daniel S. Helmer
CIRCLE: Addition; Remodel; New Bldg; TYPE OF BLDG.: SFD APT. COMM. PUBLIC
CONTRACTOR'S NAME: STATE LICENSE CITY LICENSE

UNITS	DESCRIPTION	FEE	TOTAL	UNITS	DESCRIPTION	FEE	TOTAL
	Unit heater — floor, wall or suspended	4.00			EVAPORATIVE COOLERS:		
FOR EACH FORCED-AIR OR GRAVITY-TYPE FURNACE OR BURNER INCLUDING DUCTS AND VENT ATTACHED TO SUCH APPLIANCES:					5 outlets or under	3.00	
	Up to and including 100,000 B.t.u.'s	4.00			Over 5 and up to and including 10	5.00	
	Over 100,000 B.t.u.'s	6.00			Each additional outlet over 10	.25	
FOR EACH HEATING APPLICATION, REFRIGERATION UNIT, COMFORT COOLING AND HEATING UNIT, ABSORPTION UNIT, COMPRESSOR OR BOILER:					VENTILATION:		
	Up to and including 3 ton or horsepower, or absorption system up to and including 100,000 B.t.u.'s	4.00			For each fan connected to a single duct	1.00	
	Over 3 ton or 3 horsepower up to and including 10, or absorption system over 100,000 B.t.u.'s up to and including 250,000 B.t.u.'s	7.00			For each commercial or industrial ventilation system	5.00	
	Over 10 ton or 10 horsepower up to and including 30, or absorption system over 250,000 B.t.u.'s up to and including 1,000,000 B.t.u.'s	12.00			For each commercial kitchen hood	5.00	
	Over 30 ton or 30 horsepower up to and including 50, or absorption system over 1,000,000 B.t.u.'s up to and including 1,700,000 B.t.u.'s	20.00			MISCELLANEOUS:		
	Over 50 ton or 50 horsepower, or absorption system over 1,700,000 B.t.u.'s	30.00			For each water cooking tower	8.00	
FOR EACH AIR HANDLING UNIT INCLUDING DUCTS ATTACHED THERETO:					Duct work only — each opening	.25	50
	Up to and including 10,000 CFM	2.00			For installation or relocation of each commercial or industrial incinerator	15.00	
	Over 10,000 CFM	4.00			Gas piping related to the air cond. work in single family dwelling only	3.00	
					For each appliance, piece of equipment, any mechanical work or alteration or replacement not included in this schedule, the permit fee shall be computed the same as building permit fees by using the cost of installation for the valuation amount.		
FOR THE ISSUANCE OF EACH PERMIT							3.00
TOTAL PERMIT FEE \$							3.50

I hereby certify that I have carefully examined and read the above application; that the same is true and correct; and that the work herein described is to be done in accordance with all the provisions of the applicable Ordinances of the City of Las Vegas, Nevada and the State Laws, whether herein specified or not.

SIGNED: Daniel S. Helmer Date: _____
Air Conditioning Contractor - Owner

BUILDING DEPARTMENT: H.T. Keller Date: 3-9-73

PERMIT NO.: 30523 PERMIT FEE \$ 3.50

12890

RECEIPT
2209 \$003.50 - 4
CITY OF LAS VEGAS
DEPT. OF BUILDING & SAFETY
MUST BE MACHINE VALIDATED
- 9 MAR 73

Waterwood January 29, 1980


CITY OF LAS VEGAS, NEVADA

LOG-NO. & AREA _____
DEPARTMENT OF BUILDING & SAFETY
ADDRESS OF CONSTRUCTION: 6321 Parafal OWNER: James S. Nelson
LOT(s) 25 BLOCK 9 SUBDIVISION CHAR WATER 29-A ZONE: R1
Materials of Construction: Block ☒ Concrete ☐ Wire ☐ Wood ☐ Other ☐
ARCHITECT: _____ ENGINEER: _____
CONTRACTOR: OWNER STATE LICENSE # _____ CITY LICENSE # _____
TOTAL SQUARE FEET: _____ TOTAL LINEAL FEET: 90

Remarks:

CONDITIONS OF THE PERMIT:

1. Any type of retaining wall must be engineered by a Civil or Structural Engineer.
2. If a home owner takes out the Building Permit and if the owner sublets the work to a Contractor, then the Contractor must take out the permit and pay for it.
3. No fence or wall can be built on City property or right-of-way, but this is not intended to preclude construction within utility easements, if utilities will not be damaged or made inaccessible.
4. The fence or wall shall not enclose any water meter, light standard, or fire alarm box and shall not come closer than 24" from the nearest fire hydrant outlet.
5. Department Inspectors must approve footings before concrete is poured and block wall reinforcing before grouting is done.
6. Maximum height of any wall or fence is 6', side and rear yards; 4' maximum in front yard with the vertical surface above the height of 2'—50% open.
7. I must not obstruct required onsite parking space (2 spaces for each dwelling unit) by the erection of this fence or wall.
8. By the signing of this application I herewith agree to the requirements outlined above.

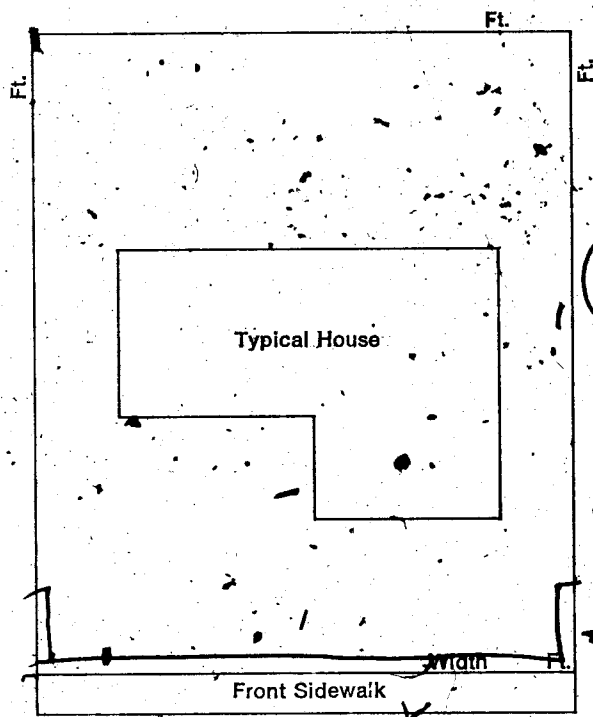

4' MAX HGT TOP 2'
50% OPEN

SIGNED: [Signature] DATE: _____
CONTRACTOR ☐ AGENT ☐ OWNER ☒

PLANNING DEPT.: _____ Date: 7/30/73
PUBLIC WORKS DEPT.: _____ Date: 7/30-73
BUILDING DEPT.: [Signature] Date: 7-30-73
#12850 PERMIT NO.: 12369 PERMIT FEE \$ 5.00

RECEIPT
9862 \$005.00 - 8
CITY OF LAS VEGAS
DEPT. OF
BUILDING & SAFETY
MUST BE MACHINE VALIDATED
30 JUL 73

Don't forget 11-18-82

DEPARTMENT OF BUILDING & SAFETY
CITY OF LAS VEGAS, NEVADA

KARDEX CARD
FENCE & RETAINING
WALLS

OWNER Daniel S. Helm ADDRESS 6321 Parsifal DATE 7-30-73
CONTRACTOR Owner PERMIT NO. 12369
LOT 25 BLOCK 9 SUBDIVISION Char Hgts 29-A block fence

Fence (wire, wood, etc.)	Walls (masonry, rock, etc.)
Location _____	Location <u>BWS-3-73</u>
Final Inspection _____	Footings <u>BWS-3-73</u>
	Wall Steel 1st _____ 2d _____ 3d _____
	Final Inspection _____
Retaining Wall (masonry)	Retaining Wall (concrete)
Location _____	Location _____
Footings _____	Footings _____
Wall Steel 1st _____ 2d _____ 3d _____	Wall Steel 1st _____ 2d _____ 3d _____
Bond Beam 1st _____ 2d _____ 3d _____	Final Inspection _____
Final Inspection _____	

Pulled 6-19-74

23.14 B ADDRESS 6321 Parsifal LOG NO. _____ AREA _____

Department of Building & Safety
City of Las Vegas, Nevada

Special Kardex
Elec. only, Plbg. only, A.C. only

Owner Daniel Helm Address 6321 Parsifal Date: 3/9/73
Contractor _____ Permit No. _____
Lot _____ Block _____ Subdivision _____

Electric Only	Plumbing Only	Heat & Vent. A. C. Only
Contractor _____	Contractor _____	Contractor <u>Owner</u>
Permit No. _____	Permit No. _____	Permit No. <u>3523</u>
Plab _____	Rough Soil _____	A.C. Rough Duct _____
Rough Elect _____	Rough Water _____	Ref. Ro. Piping _____
Final Rough _____	Top Out _____	Rough Gas _____
Final Fixture _____	Rough Gas _____	Final Refrig _____
Final Elec _____	Final Plbg. _____	Final Air Cond <u>NEP-3-13-73</u>
Temp. Service _____	Final Gas _____	Final Gas _____
	Final Sewer _____	
	Final Septic Tank _____	

23.06 D Address 6321 Parsifal Log No. _____ Duct _____ Area _____

Done Today 11-18-82

DEPT. of BLDG & SAFETY - CITY of LAS VEGAS, NEVADA

OWNER Sprout Homes ADDRESS 6321 Parsifal Place DATE 3/26/63

GEN. CONT. owner TYPE OF STRUCTURE SFD

PERMIT NO. 17842 LEGAL DESCRIPTION lot 25, block 9, 29-A

BUILDING		MECHANICAL		ELECTRICAL	
URBAN REDEVELOPMENT APPROVAL					
FINAL BLDG	<u>5-1-63</u>				

152 APPROVED FOR OCCUPANCY & METER 7/11/63 INSPECTOR 7/11/63 DATE 7/11/63

PLEASE NOTE REMARKS ON REVERSE SIDE

LOG: # 7 AREA: # 23.04

6321 Parsifal Place T-35 4

DEPT. of BLDG & SAFETY - CITY of LAS VEGAS, NEVADA

OWNER Daniel S. Helm ADDRESS 6321 Parsifal Place DATE 7/6/72

GEN. CONT. Owner TYPE OF STRUCTURE Encl patio

PERMIT NO. 6001 LEGAL DESCRIPTION Lot 25 Blk 9 Chas Hgts 29A

BUILDING		MECHANICAL		ELECTRICAL	
LOCATION	<u>8-30-72</u>	PLUMBING CONT.		TEMP. POLE CONT.	
FIREPLACE FTS.	<u>8-30-72</u>	PERMIT NO.		PERMIT NO.	
FOOTINGS		HEAT & VENT. AC CONT.		INSPECTION	
FOUNDATION WALL		PERMIT NO.		ELECTRICAL CONT.	<u>3541</u> DATE <u>7/6/72</u>
FLOOR FRAMING		SEWER CONT.		PERMIT NO.	<u>3541</u> DATE <u>7/6/72</u>
SLAB	<u>8-30-72</u>	PERMIT NO.		FIXTURES CONT.	
CHIMNEY STEEL (FIREPLACE)		ROUGH SOIL		PERMIT NO.	
WALL STEEL		ROUGH WATER		SLAB	<u>8-11-72</u>
COLUMN STEEL		TOP-OUT		ROUGH	<u>8-11-72</u>
BEAM STEEL		ROUGH GAS		FINAL ROUGH	
FRAMING	<u>8-11-72</u>	AC ROUGH DUCT	<u>8-11-72</u>	FINAL FIXTURE	
ROOF SHEATHING		REF. ROUGH PIPING		FINAL ELECTRICAL	
INTERIOR	<u>8-11-72</u>	FINAL PLUMBING		TEMPORARY SERVICE	
EXTERIOR		FINAL GAS		MISCELLANEOUS	
DRYWALL	<u>8-11-72</u>	FINAL AIR COND.		GRADING & DRAINAGE	
LATHING		FINAL REFRIG.		ON-SITE PARKING SPACES	
BACKING (SIGNS)		FINAL SEWER		ENG. APPROVAL OF	
PLASTER		FINAL SEPTIC TANK		OFF-SITE IMPROVEMENTS	
URBAN REDEVELOPMENT APPROVAL					
FINAL BLDG					

APPROVED FOR OCCUPANCY & METER 8-9-72 INSPECTOR 8-9-72 DATE 8-9-72

PLEASE NOTE REMARKS ON REVERSE SIDE

LOG: # 7 AREA: # 23.04

6321 Parsifal Pl

Don't forget to fill out 82

DEPT. of BLDG & SAFETY—CITY of LAS VEGAS, NEVADA	
OWNER <u>Jay Terlitzky</u>	ADDRESS <u>6323 Parsifal</u>	DATE <u>10-25-63</u>	
GEN. CONT. <u>Desert Building & Fencing</u>	TYPE OF STRUCTURE <u>Wood frame</u>	
PERMIT NO. <u>2229A</u>	LEGAL DESCRIPTION <u>Lot 23 Blk9 Chas Hts 29A</u>	
<table border="1"><thead><tr><th colspan="2">BUILDING</th><th>MECHANICAL</th><th>ELECTRICAL</th></tr></thead><tbody><tr><td>LOCATION</td><td></td><td>PLUMBING CONT.</td><td>TEMP. POLE CONT.</td></tr><tr><td>FIREPLACE FTS</td><td></td><td>PERMIT NO. _____ DATE _____</td><td>PERMIT NO. _____ DATE _____</td></tr><tr><td>FOOTINGS</td><td></td><td>HEAT & VENT. AC CONT.</td><td>INSPECTION _____ DATE _____</td></tr><tr><td>FOUNDATION WALL</td><td></td><td>PERMIT NO. _____ DATE _____</td><td>ELECTRICAL CONT.</td></tr><tr><td>FLOOR FRAMING</td><td></td><td>SEWER CONT.</td><td>PERMIT NO. _____ DATE _____</td></tr><tr><td>SLAB</td><td></td><td>PERMIT NO. _____ DATE _____</td><td>FIXTURES CONT.</td></tr><tr><td>CHIMNEY STEEL (FIREPLACE)</td><td></td><td>ROUGH SOIL</td><td>PERMIT NO. _____ DATE _____</td></tr><tr><td>WALL STEEL</td><td></td><td>ROUGH WATER</td><td>SLAB _____</td></tr><tr><td>COLUMN STEEL</td><td></td><td>TOP-OUT</td><td>ROUGH _____</td></tr><tr><td>BEAM STEEL</td><td></td><td>ROUGH GAS</td><td>FINAL ROUGH _____</td></tr><tr><td>FRAMING</td><td></td><td>AC ROUGH DUCT</td><td>FINAL FIXTURE _____</td></tr><tr><td>ROOF SHEATHING</td><td></td><td>REF. ROUGH PIPING</td><td>FINAL ELECTRICAL _____</td></tr><tr><td>INTERIOR</td><td>EXTERIOR</td><td>FINAL PLUMBING _____</td><td>TEMPORARY SERVICE _____</td></tr><tr><td>DRYWALL</td><td></td><td>FINAL GAS _____</td><td></td></tr><tr><td>LATHING</td><td></td><td>FINAL AIR COND. _____</td><td>MISCELLANEOUS</td></tr><tr><td>BACKING (SIDING)</td><td></td><td>FINAL REFRIG. _____</td><td>GRADING & DRAINAGE _____</td></tr><tr><td>PLASTER</td><td></td><td>FINAL SEWER _____</td><td>ON-SITE PARKING SPACES _____ APP _____</td></tr><tr><td>URBAN REDEVELOPMENT APPROVAL</td><td></td><td>FINAL SEPTIC TANK _____</td><td>ENG. APPROVAL OF _____</td></tr><tr><td>FINAL BLDG <u>11-12-63</u></td><td></td><td></td><td>OFF-SITE IMPROVEMENTS _____</td></tr>

APPROVED FOR OCCUPANCY & METER

INSPECTOR

DATE

PLEASE NOTE REMARKS ON REVERSE SIDE

6323 Parsifal

LOG #

AREA #

2204