

· 6532 STARCREST ·

· LOT 16 BLK 1 TR 58-A CHARLESTON HGTS ZONE R-1 ·

21. Hatawood. May 30, 1981

CITY OF LAS VEGAS, NEVADA

20-19
LOT NO. & AREA

T-13-3/79

CONST. VAL. \$ 33,998.00

DEPARTMENT OF PUBLIC SERVICES
DIVISION OF BUILDING AND SAFETY

APPLICATION & BUILDING PERMIT - for:
Dwellings, Duplexes, Misc. Residential Const.

ADDRESS OF
CONSTRUCTION

6532 Starcrest

OWN -

Becker Butler

LOT(S)

16

BLOCK

1

SUBDIVISION

TRACT 58-A Charleston Heights

ZONE

R-1

Existing structure on lot:

Dwelling ☐

Accessory Bldgs. ☐

Vacant Lot ☒

Other ☐

PROPOSED CONSTRUCTION, Single Family Dwelling, Unit 7981B

USE: Res.

MATERIALS OF CONSTRUCTION:

Wood Frame ☒

Concrete Block ☐

Reinforced Concrete ☐

Steel Frame ☐

SQUARE FEET OF FLOOR AREAS: 1st

462

2nd

96

Other

Garage 483

TOTAL SQ. FT.

1746

FIRE ZONE:

3

Occupancy Group

R1

CONST. TYPE:

V-N

ARCHITECT:

Gilbert Aja

ENGINEER:

NO. of UNITS

1

NO. of STORIES

1

Plans Submitted:

Yes ☒

No ☐

Calculations Submitted

Yes ☒

No ☐

Sewer Fee Req'd.

Yes ☒

No ☐

CONTRACTOR:

Butler Housing Corporation

STATE

LICENSE #

16006

CITY

LICENSE #

188-42

ADD'L. PERMITS REQ'D.:

Air Cond. ☒

Elec. ☒

Plumbing ☒

Signs ☐

Paving ☐

Fence ☐

Public Walks ☐

Curb-gutters ☐

Incinerators ☐

Fire Sprinkling System ☐

CONDITIONS OF THE PERMIT:

1. I agree to call the City Building Department for inspections before concrete is poured, before rough wiring, electrical, plumbing, framing is covered. Also for Air conditioning, drywall and sheathing inspection.
2. I agree that when the job is completed that I will call for final inspection before occupancy.
3. I agree to perform all construction in accordance with City Ordinances and Building Codes.
4. The Contractor's signature below denotes authority from the owner to sign in his behalf and that the owner is aware of all requirements of this application and permit. Separate permits must be taken out for work outlined above this agreement.
5. I have read and understand the contents of this application and permit; I hereby state that the information I have supplied on this application is true and correct.

Approval for the work under this permit will be given only after refuse and debris have been removed from job site and public right of way.

SIGNED:

Contractor

BY:

Agent or Owner

Model 8.1-B
See Plans

Front property line

PLANNING DEPT. *[Signature]*

Date:

5-18-79

PUBLIC WORKS DEPT. *[Signature]*

Date:

5-21-79

BUILDING DIVISION *[Signature]*

Date:

5-31-79

PERMIT NO.:

4593-10

PERMIT FEE \$

\$144.00

154-01-220

RECEIPT

MUST BE MACHINE VALIDATED

21. Material May 30, 1979

CITY OF LAS VEGAS, NEVADA

DEPARTMENT OF PUBLIC SERVICES—APPLICATION AND PERMIT FOR PLUMBING DIVISION OF BUILDING AND SAFETY

ADDRESS OF
CONSTRUCTION: **6532 Starcrest Dr.**

OWNER'S
NAME: **Butler Housing**

CIRCLE: New Bldg. Add'n. Remodel. TYPE OF BLDG. SFD. APT. PUBLIC COMM.

CONTRACTOR'S NAME: **Big Town Plumbing**

STATE
LICENSE # **3241A** CITY
LICENSE # **01201**

UNITS	DESCRIPTION	FEE	TOTAL
1	Bath/tub	1.00	1.00
1	Shower	1.00	1.00
2	Lavatory	1.00	2.00
2	Toilet	1.00	2.00
	Urinal	1.00	
	Floor Drain	1.00	
	Floor Sink	1.00	
	Wash Tray	1.00	
1	Sink	1.00	1.00
1	Garbage Disposal	1.00	1.00
	Garbage Disposal (comm.)	3.00	
	Clothes Dryer (gas)	1.00	
1	Clothes Washer	1.00	1.00
	Clothes Washer (comm.)	5.00	
1	Dishwasher	1.00	1.00
	Dishwasher (commercial)	5.00	
	Dental Unit	10.00	
	Drinking Fountain	1.00	
	Any Water Using Equipment	1.00	
1	Water Heater (gas) (elect.)	1.00	1.00
	Sewer System—New, Replacement; or any Drainage System	4.00	4.00
1	Grease or Sand Trap	2.00	
	Trailer Trap	2.00	
	Septic Disposal System	4.00	
WATER SOFTENERS			
	Non-permanent Type	4.00	
	Permanent Type (connected to drainage)	5.00	
SWIMMING POOLS			
	Private or Wading Pool	1.00	
	Public or Semi-public	20.00	

UNITS	DESCRIPTION	FEE	TOTAL
WATER DISTRIBUTION SYSTEM			
1	Single Family Dwelling	4.00	4.00
	Multiple Family Dwelling plus each unit	4.00 2.00	
	Commercial Bldg. per floor	6.00	
	Hotel or Motel plus each bath	4.00 1.50	
	Trailer Park plus each space	20.00 1.00	
	Irrigation	4.00	
GAS PIPING SYSTEM			
1	Single Family Dwelling	3.00	3.00
	Multiple Family Dwelling plus each unit	6.00 1.00	
	Commercial Bldg. per floor plus each unit	3.00 3.00	
	Gas Appliance (any type)	1.00	
AUTOMATIC FIRE EXTINGUISHING SYSTEM			
	Underground Piping	10.00	
	Distribution Piping ea. ft.	.01	
	Sprinkler Head each	.10	
	In Range Hood and Vent	5.00	
DRY STANDPIPE SYSTEM			
	Piping	50.00	
	Each Outlet	1.00	
WET STANDPIPE SYSTEM			
	Piping	5.00	
	Fire Hose Cabinet	1.00	
	MINIMUM PERMIT FEE	4.00	
PIPELINE CONTRACTOR, SECT. 14 L.P.F.S.			
TOTAL PERMIT FEE \$ 22.00			

I hereby certify that I have carefully read and read the above application; that the same is true and correct, and that the work herein described is to be done in accordance with the provisions of the applicable Ordinances of the City of Las Vegas, Nevada and the State Laws, whether herein specified or not.

Approval for the work under this permit will be given only after refuse and debris has been removed from job site and public right of way.

Signed [Signature]
Registered Master Plumber, Spec. Contr. or Owner

Date: 7/20/79

Building Division: M.S.

Date: 7/23/79

Permit No. 5757-13

Permit Fee \$ 22.00

154-01 222

RECEIPT

MUST BE MACHINE VALIDATED

21. Water odd May 30, 1938

CITY OF LAS VEGAS, NEVADA

DEPARTMENT OF PUBLIC SERVICES - AIR CONDITIONING APPLICATION & PERMIT
DIVISION OF BUILDING AND SAFETY


CIRCLE: Addition; Remodel; New Bldg. TYPE OF BLDG.: SFD APT. COMM. PUBLIC

CONTRACTOR'S NAME: Four Windows Corp. STATE LICENSE # 015844 CITY LICENSE # 11-461209638

UNITS	DESCRIPTION	FEE	TOTAL	UNITS	DESCRIPTION	FEE	TOTAL
	Unit heater - floor, wall or suspended	4.00			EVAPORATIVE COOLERS:		
	FOR EACH FORCED-AIR OR GRAVITY-TYPE FURNACE OR BURNER INCLUDING DUCTS AND VENT ATTACHED TO SUCH APPLIANCES:				5 outlets or under	3.00	
	Up to and including 100,000 B.t.u.'s	4.00			Over 5 and up to and including 10	5.00	
	Over 100,000 B.t.u.'s	6.00			Each additional outlet over 10	.25	
	FOR EACH HEATING APPLICATION, REFRIGERATION UNIT, COMFORT COOLING AND HEATING UNIT, ABSORPTION UNIT, COMPRESSOR OR BOILER:				VENTILATION:		
	Up to and including 3 ton or horsepower, or absorption system up to and including 100,000 B.t.u.'s	4.00		2	For each fan connected to a single duct	1.00	2.00
1	Over 3 ton or 3 horsepower up to and including 10, or absorption system over 100,000 B.t.u.'s up to and including 250,000 B.t.u.'s	7.00	7.00		For each commercial or industrial ventilation system	5.00	
	Over 10 ton or 10 horsepower up to and including 30, or absorption system over 250,000 B.t.u.'s up to and including 1,000,000 B.t.u.'s	12.00			For each commercial-kitchen hood	5.00	
	Over 30 ton or 30 horsepower up to and including 50, or absorption system over 1,000,000 B.t.u.'s up to and including 1,700,000 B.t.u.'s	20.00			MISCELLANEOUS:		
	Over 50 ton or 50 horsepower, or absorption system over 1,700,000 B.t.u.'s	30.00			For each water cooling tower	8.00	
	FOR EACH AIR HANDLING UNIT INCLUDING DUCTS ATTACHED THERETO:				Duct work only - each opening	.25	
	Up to and including 10,000 CFM	2.00			For installation or relocation of each commercial or industrial incinerator	15.00	
	Over 10,000 CFM	4.00			Gas piping related to the air cond. work in single family dwelling only	3.00	
					For each appliance, piece of equipment, any mechanical work or alteration or replacement not included in this schedule, the permit-fee shall be computed the same as building permit fees by using the cost of installation for the valuation amount.		
					FOR THE ISSUANCE OF EACH PERMIT		3.00
					TOTAL PERMIT FEE \$	12.00	

I hereby certify that I have carefully examined and read the above application; that the same is true and correct; and that the work herein described is to be done in accordance with all the provisions of the applicable Ordinances of the City of Las Vegas, Nevada and the State Laws, whether herein specified or not.

Approval for the work under this permit will be given only after refuse and debris have been removed from job site and public right of way.

SIGNED: Walter Linn Date: 8-08-79
Air Conditioning Contractor - Owner

BUILDING DIVISION Wm Date: 8-30-79

PERMIT NO. 6625-13 PERMIT FEE \$ 12.00

#12890

RECEIPT

MUST BE MACHINE VALIDATED

21 Gatewood May 30, 1980

CITY OF LAS VEGAS, NEVADA

DEPARTMENT OF PUBLIC SERVICES - ELECTRICAL APPLICATION & PERMIT
DIVISION OF BUILDING AND SAFETY

ADDRESS OF CONSTRUCTION: 6532 Starcrest Dr.

OWNER'S NAME: Butler Housing Corp.

CIRCLE: New Bldg; Add'n.; Remodel; TYPE OF BLDG.: SFD. APT. PUBLIC COMM.

CONTRACTOR'S NAME: Denton Electric Co., Inc. STATE LICENSE # 9750-A CITY LICENSE # C11-249

NUMBER	FIXTURE OR INSTALLATION	UNIT PRICE	TOTAL
	Rm addition, carport or garage enclosure	4.00	
	Temporary power	4.00	
56	Light, receptacle or switch outlet	.20	11.20
	Wall or ceiling space heater	.35	
1	Garbage grinder outlet	.35	.35
1	Dishwasher outlet	.35	.35
1	Clothes dryer outlet Gas	.35	.35
1	Automatic clothes washer	.35	.35
1	Electric range outlet Gas	.35	.35
	Electric water heater outlet Gas	.35	.35
	Special purpose outlet	.35	
	X-ray unit and its appurtenances	5.00	
	Watts of festoon lighting (Watts) First 3,000 watts for each additional thousand watts	4.00 1.50	
	Horsepower-each motor first horsepower or less for each additional horsepower	1.75 .35	
1	Electric service (including any single meter socket) for each additional socket	3.00 .35	3.00
1	Air conditioning service 60 amp. Gas	1.50	1.50
	Each KW(KVA) Generator (Transformer, Welder) First 100 KVA for each additional KW(KVA)	2.00 .01	
	Speaker, signal or alarm outlet	.15	
	Amplifiers	.50	
	Control panels	.25	
	Main control racks	1.00	
	T.V. and radio antennas-master system only	.75	
	Minimum fee for any permit	4.00	
TOTAL FEE			17.45

100 amp. Service used

Approval for the work under this permit will be given only after refuse and debris have been removed from job site and public right of way.

I hereby certify that I have carefully examined and read the above application; that the same is true and correct; and that the work herein described is to be done in accordance with all the provisions of the applicable Ordinances of the City of Las Vegas, Nevada and State laws whether herein specified or not.

SIGNED EH Denton DATE 8-20-79
MASTER (ELECTRICIAN) (TECHNICIAN) (OWNER)

BUILDING DIVISION M.S. DATE 8/21/79

PERMIT NO. 0423-8 PERMIT FEE: \$ 17.45

RECEIPT

MUST BE MACHINE VALIDATED

J. Mateu 06 June 23, 1980

CITY OF LAS VEGAS, NEVADA

LOG NO. & AREA

DEPARTMENT OF BUILDING & SAFETY

CONST. VAL. \$

1260

APPLICATION & BUILDING PERMIT for:
Fence, Wall, Retaining Wall.

ADDRESS OF
CONSTRUCTION:

6532 Starcrest Dr

OWNER: KASTELIC, Floyd

LOT(s)

1/6

BLOCK

1

SUBDIVISION

Charleston Dpts 58-A

ZONE:

R-1

Materials of Construction:

Block ☐

Concrete ☐

Wire ☒

Wood ☐

Other ☐

Yes No

PLANS:

☐ ☐

ARCHITECT:

ENGINEER:

CALCS:

☐ ☐

CONTRACTOR:

Owner

STATE
LICENSE #

CITY
LICENSE #

TOTAL SQUARE FEET:


TOTAL LINEAL FEET:

315

Remarks:

CONDITIONS OF THE PERMIT:

1. Any type of retaining wall must be engineered by a Civil or Structural Engineer.
2. If a home owner takes out the Building Permit and if the owner sublets the work to a Contractor, then the Contractor must take out the permit and pay for it.
3. No fence or wall can be built on City property or right-of-way, but this is not intended to preclude construction within utility easements, if utilities will not be damaged or made inaccessible.
4. The fence or wall shall not enclose any water meter, light standard, or fire alarm box and shall not come closer than 24" from the nearest fire hydrant outlet.
5. Department Inspectors must approve footings before concrete is poured and block wall reinforcing before grouting is done.
6. Maximum height of any wall or fence is 6' side and rear yards; 4' maximum in front yard with the vertical surface above the height of 2' — 50% open.
7. I must not obstruct required onsite parking space (1 space for each dwelling unit) by the erection of this fence or wall.
8. By the signing of this application I herewith agree to the requirements outlined above.

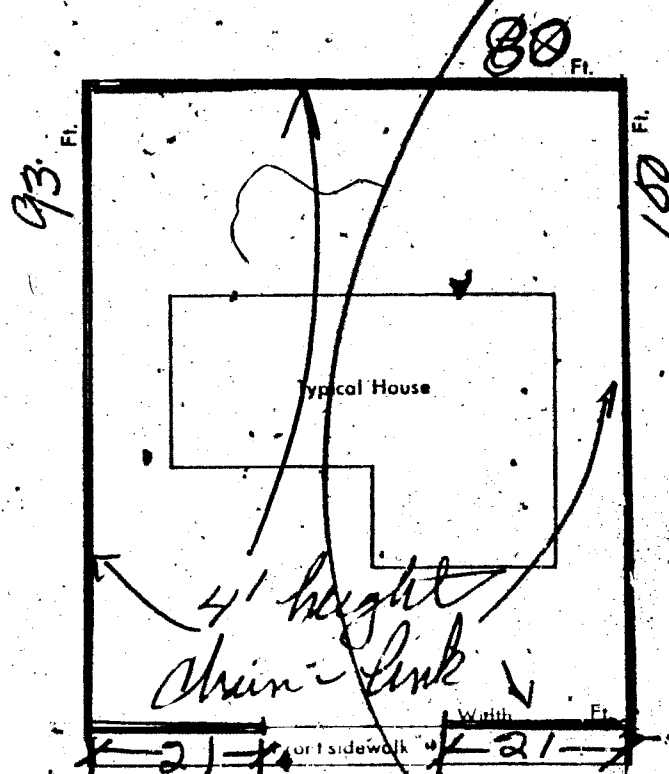

6532 Starcrest Dr

SIGNED

S. K. KASTELIC

CONTRACTOR ☒ AGENT ☐

PLANNING DEPT.:

J. K. KASTELIC

Date:

7/2/80

PUBLIC WORKS DEPT.:

Date:

4/2/80

BUILDING DEPT.:

Date:

1500

#12850

PERMIT NO.:

7438

PERMIT FEE \$

1500

11.00

15.00

15.00

15.00

15.00

RECEIVED

#1438

CITY - LAS VEGAS

BLDG. & SAFETY

04/02/80

MUST BE MACHINE VALIDATED

CITY OF LAS VEGAS, NEVADA

LOG NO. & AREA

DEPARTMENT OF PUBLIC WORKS
DIVISION OF BUILDING & SAFETY

APPLICATION FOR BUILDING PERMIT - For:
Fence, Wall, Retaining Wall

COUNTY VAL: 3.00 ⁰⁰

ADDRESS OF
CONSTRUCTION:

6532 Street

OWNER:

Deshae Bonnie Kastelic

LOT(s)

16

BLOCK

1

SUBDIVISION

Clinton Heights 587

ZONE:

4

Materials of Construction:

Block ☒

Concrete ☐

Wire ☐

Wood ☐

Other ☐

Yes No

PLANS: ☐ ☐

CALCS: ☐ ☐

ARCHITECT:

ENGINEER:

CONTRACTOR:

Owner

STATE
LICENSE #

CITY
LICENSE #

TOTAL SQUARE FEET:

1200


TOTAL LINEAL FEET:

800

Remarks:

CONDITIONS OF THE PERMIT:

1. Any type of retaining wall must be engineered by a Civil or Structural Engineer.
2. If a home owner takes out the Building Permit and if the owner sublets the work to a Contractor, then the Contractor must take out the permit and pay for it.
3. No fence or wall can be built on City property or rights-of-way, but this is not intended to preclude construction within utility easements if utilities are not damaged or made inaccessible.
4. The fence or wall shall not enclose any water meter, light standard, or fire alarm box and shall not come closer than 24" from the nearest fire hydrant outlet.
5. Department inspectors must approve footings before concrete is poured and block wall reinforcing before grouting is done.
6. Maximum height of any wall or fence is 6' side and rear yards; 4' maximum in front yard with the vertical surface above the height of 2' - 50% open.
7. I must not obstruct required onsite parking space (2 spaces for each dwelling unit) by the erection of this fence or wall.
8. By the signing of this application I herewith agree to the requirements outlined above.

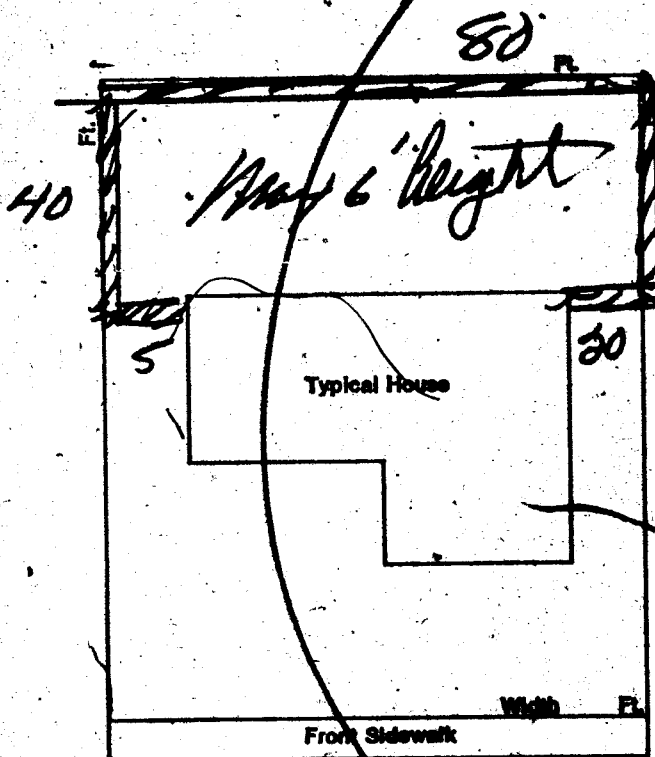

SIGNED:

Bonnie Kastelic

CONTRACTOR ☐

AGENT ☐

OWNER ☒

PLANNING DEPT:

J. Robinson

Date:

6/5/81

PUBLIC WORKS DEPT:

Nash

Date:

6-5-81

BUILDING DIVISION:

Oni

Date:

6/5/81

PERMIT NO:

1833

PERMIT FEE \$

38.50

1 FUND \$.00
MILL \$ 38.50
STL \$ 38.50
TOTAL \$ 38.50
CASH \$ 39.00
CHRG \$.50
AMOUNT \$ 39.50
CITY OF LAS VEGAS
BLDG. & SAFETY
06/05/81

MUST BE MACHINE VALIDATED

Done: *Freely*

7-7-83

FENCES (Name, Address, City, State, Zip)










OWNER **Becker Butler** ADDRESS **6532 Starcrest**
DATE **5-31-9** GEN. CONT. **Butler Housing**
TYPE OF STRUCTURE **SFD** PERMIT NO. **4593-10** FINAL INSPECTION **Corp**
LEGAL DESCRIPTION **L16 B1** LOG # **T13-3-78A**
Char Hqts 58-A
APPROVED FOR OCCUPANCY & METER

BUILDING	MECHANICAL
Investigation	Plumbing Cont. <i>Becker Butler</i>
Temporary Service	

PLEASE NOTE ADDITIONAL REMARKS ON REVERSE SIDE.
DIV. OF BLDG. & SAFETY
CITY OF LAS VEGAS
REV. 10-78
79-3-16

 

Dona Finley

7-7-8

223M A
Stem wall 7c 8-3-29
Roof sheathing 7c 9-14-29
Insulation 7c 10-15-29

4593-10