


·3205 W. Washington ·

Aloria Ealy August 14, 1980

CITY OF LAS VEGAS, NEVADA
Department of Building and Safety

CERTIFICATE OF INSPECTION

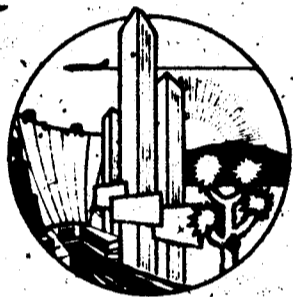

Address 3505 W. WASHINGTON RON RUDIN
Legal LOT 11 BLK 1 Date 8-15-77
TWIN LKS. EST

This certificate issued pursuant to the requirements of Section 308 of the
UNIFORM BUILDING CODE certifying that at the time of this issuance
the improvements on this property were in compliance with CITY OF LAS
VEGAS, HOUSING, BUILDING, ELECTRICAL, PLUMBING and MECH-
ANICAL CODES

DIRECTOR
Department of Building & Safety

Alon Jackson

This Certificate does not include conditions subject to normal maintenance.


No. 288182 Fee \$ 10

12850

RECEIPT
Must be machine validated
paid 8-12-77
A.J.

Gloria - Ealy August 14, 1980

MAYOR BILL BRIARE
COMMISSIONERS
PAUL J. CHRISTENSEN
RON LURIE
MYRON E. LEAVITT
ROY WOOFER
CITY ATTORNEY
CARL E. LOVELL, JR.
CITY MANAGER
WILLIAM E. ADAMS, P.E.

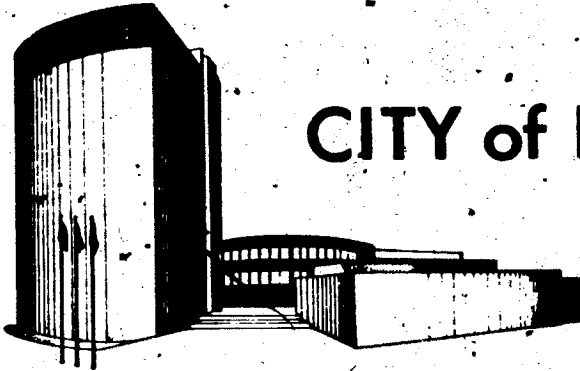

CITY of LAS VEGAS



DEPARTMENT BUILDING & SAFETY
BUILDING INSPECTION REPORT OF REQUIREMENTS FOR COMPLIANCE WITH CITY OF LAS VEGAS
BUILDING CODES AND ZONING ORDINANCE


ADDRESS 3505 W Washington
OWNER Ron Rudin
DATE 8-15-77

PERMITS REQUIRED

BLDG. _____
ELEC. _____
PLBG. _____
A.C. _____
none

CORRECTIONS TO BE MADE

BLDG. _____
ELEC. _____
PLBG. _____
A.C. _____
MISC. _____
none

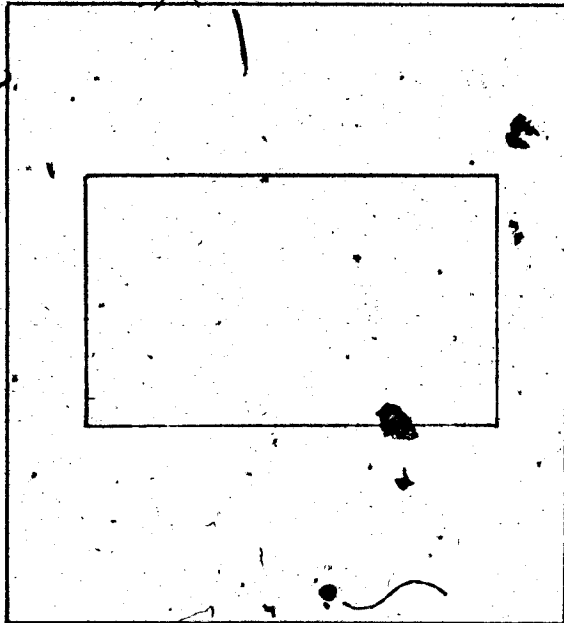


CERTIFICATE OF INSPECTION
APPROVED WR DATE 8/15/77

NOT APPROVED - CALL FOR
REINSPECTION.
386 6251

REMARKS _____

BLDG. INSPECTOR WR

Maria Ealy August 14, 1980

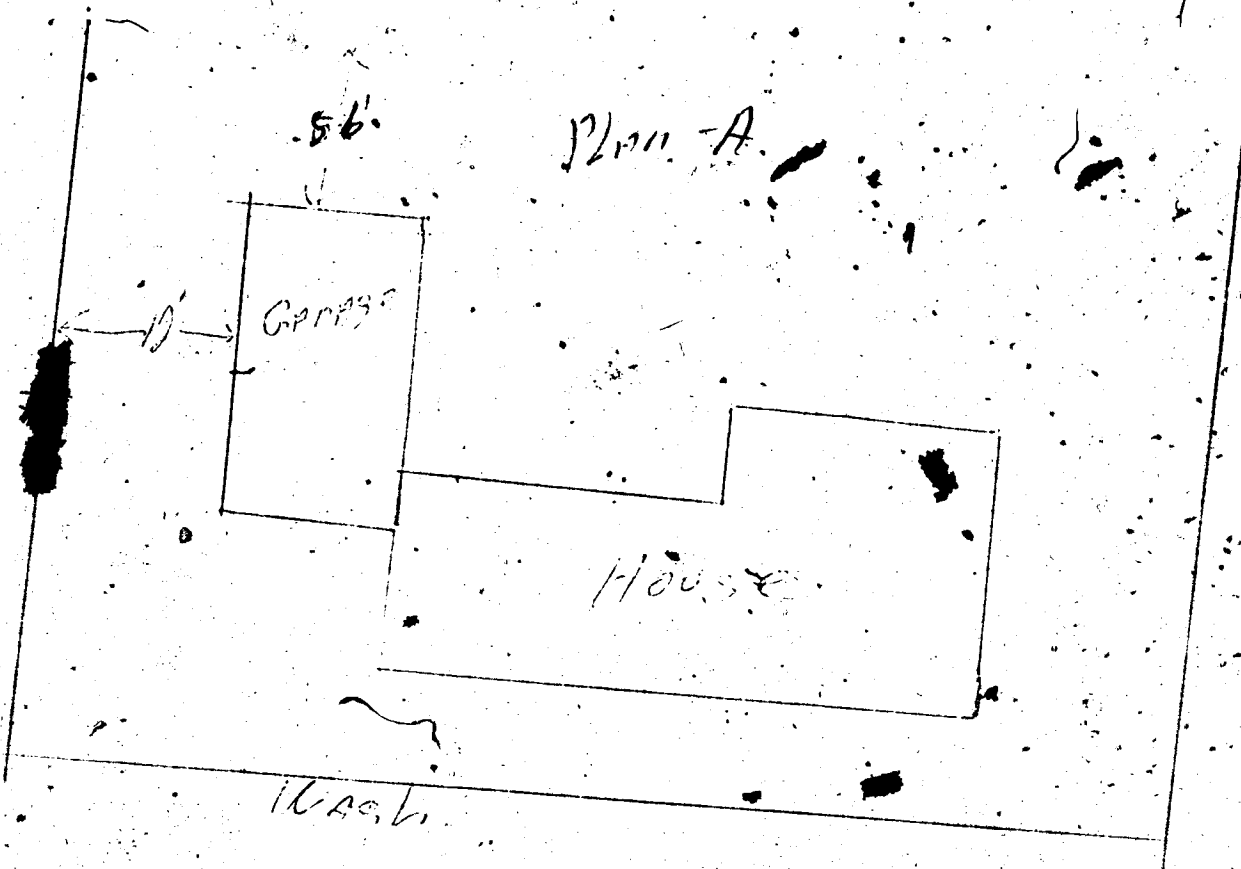

PLOT PLAN APPROVED
 BY: *[Signature]* 1-11-77
 COMMUNITY PLANNING & DEVELOPMENT
 City of Las Vegas

file 3205
 W. Washington