

5700 W. WYOMING

NONE



**DO IT YOURSELF
ELECTRIC**

Sales & Service

2310 INDUSTRIAL ROAD • LAS VEGAS, NEVADA 89102

(702) 382-3310

City of Las Vegas

August 22 1980

Dept. of Building & Safety

Att: Bob Wagoner

Chief Electrical Inspector

400 Stewart Ave.

Las Vegas, Nev. 89101

file 5700 w Wyoming


Dear Bob,

This is to inform you DO IT YOURSELF ELECTRIC INC. is no longer the electrical contractor for Las Vegas Food and Deli, Permit #2887 dated July 17 1980.

We have installed all of the conduit and pulled most of the wire for the gas pumps, but we have not done any finish work. Below is a drawing of our work.

Sincerely,

Calvin Logan
Calvin Logan

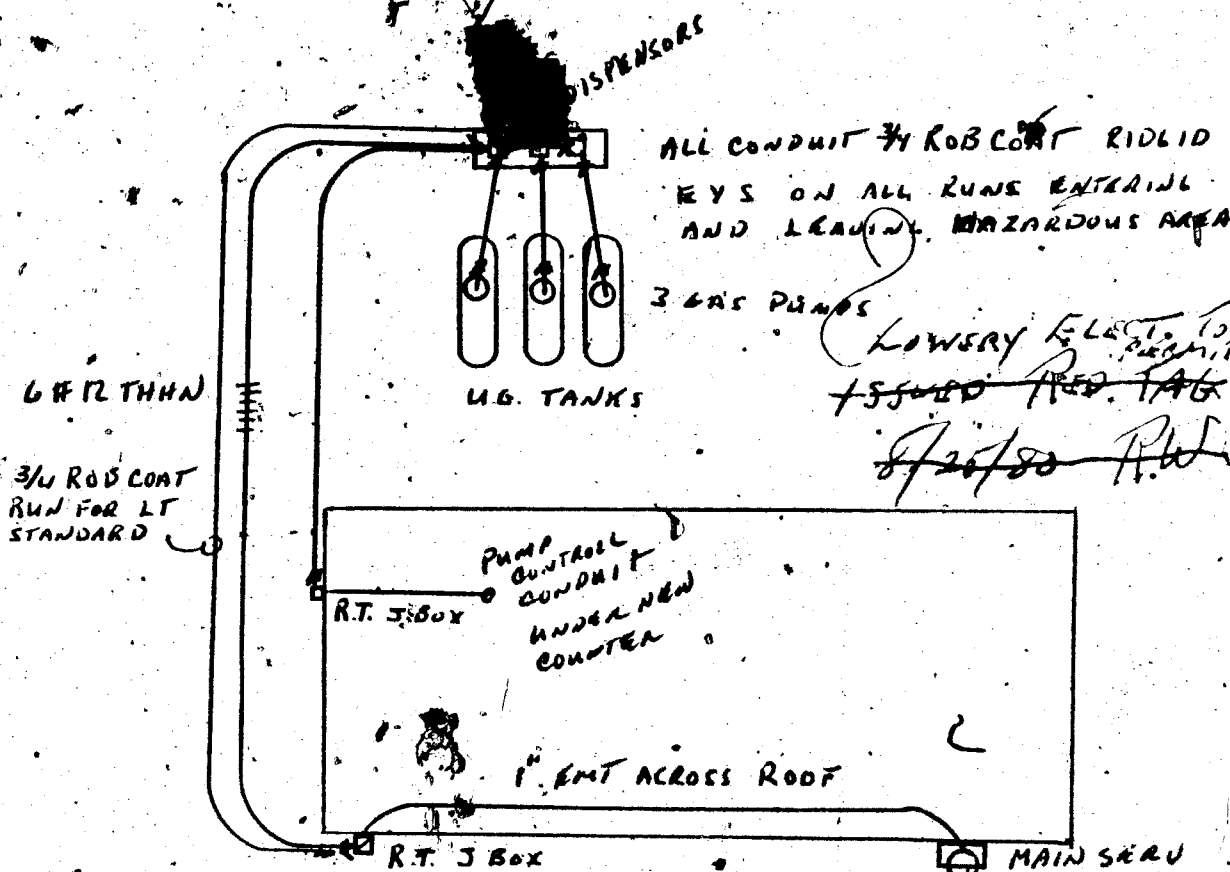

CITY OF LAS VEGAS, NEVADA

DEPARTMENT OF PUBLIC SERVICES—ELECTRICAL APPLICATION & PERMIT DIVISION OF BUILDING AND SAFETY

ADDRESS OF CONSTRUCTION: 5700 W. Charleston

OWNER'S NAME: Las Vegas Road & Bell

CIRCLE: Addition; Remodel; New Bldg. TYPE OF BLDG.: SFD APT. COMM. PUBLIC

CONTRACTOR'S NAME: Do L. Murrell Electric, Inc. STATE LICENSE # 117280 CITY LICENSE # 14380

UNITS	DESCRIPTION	FEE	TOTAL
	Receptacles Outlets Switches	.30	
	Wall or Ceiling Space Heaters	.50	
	Blast Coil Heaters (per kilowatt)	.35	
	Garbage Grinder Outlet	.50	
	Trash Compactor	.35	
	Dishwasher Outlet	.50	
	Clothes Dryer Outlet	.50	
	Automatic Clothes Washer Outlet	.50	
	Electric Range	.50	
	Electric Water Heater	.50	
	Each Fixture or Socket	.15	
	Each Mercury Arc Lamp and Equipment (sodium)	.50	
	Each Special Purpose Outlet	.50	
	Each X-ray Unit and its Appurtenances	7.50	
1	Area Lighting—First 3000 Watts For Each Additional 1000 Watts	6.00 .25	6.00
1	Total Horsepower Each Motor—Generator, Transformer, Welder First Horsepower or KVA For Each Additional Horsepower up to 50 For Each Horsepower over 50	2.50 .40 .15	2.50
	Temporary Power and Lights — Temporary Pole	5.00	
	Electric Service, Including First Meter Socket For Each Additional Meter Socket Services over 200 to 600 Amperes 600 to 1200 Amperes over 1200 Amperes Sub Panel	4.50 .40 6.25 12.50 25.00 .15	
	Permanently Connected Air Conditioning Service (Heating/Cooling)	2.25	
	Speaker Outlets	.20	
	Signal or Alarm Outlets	.25	
	Amplifiers	1.25	
	Control Panels	.35	
	T.V. Outlets — Master System Only	.30	
	Fee for issuing Each Permit	2.00	

Other inspections and fees:

1. Inspections outside of normal business hours = \$7.50 per hour (minimum charge two hours).
2. Re-inspection fee assessed under provisions of Section 305(h) of the Uniform Building Code = \$7.50 per hour.
3. Inspections for which no fee is specifically indicated = \$7.50 per hour (minimum charge one half hour).
4. Additional plan review required by changes, additions or revisions to approved plans = \$7.50 per hour (minimum charge one half hour).

I hereby certify that I have carefully examined and read the above application; that the same is true and correct; and that the work herein described is to be done in accordance with all the provisions of the applicable Ordinances of the City of Las Vegas, Nevada and the State Laws, whether herein specified or not.

SIGNED Calvin M. Logan Master (Electrician) (Technician) (Owner) 7/16/80

BUILDING DIVISION 5711 Date 7-17-80

PERMIT NO. 2885 PERMIT FEE \$ 17.80

#1721-2402 - (REV. 3/80)

Approval for the work under this permit will be given only if the use and debris have been removed from the site and public right of way.

#1721-2402 - (REV. 3/80)

BLDG. & SAFETY

07/17/80 RECEIPT

MUST BE MACHINE VALIDATED