

3005 Woodland

Lot 9 Blk 1 Hollydale Tr #1 Zone R1

W. Ealy 8-27-80

CITY OF LAS VEGAS, NEVADA
DEPARTMENT OF BUILDING & SAFETY - AIR CONDITIONING APPLICATION & PERMIT

ADDRESS OF CONSTRUCTION: 3005 Woodland OWNER'S NAME: Pete Papanikis
CIRCLE: New bldg. ☒ Old bldg. ☐ Add'n ☐ Remodel ☐ TYPE OF BLDG. SFD ☐ APT ☐ COMM. ☐
CONTRACTOR'S NAME: Valley Air STATE: 9412 CITY: 12225
LICENSE # 9412 LICENSE # 12225

UNITS	HEATERS	PRICE	FEE	UNITS	GAS	PRICE	FEE
	Unit Heaters (floor, suspended & wall)	\$2.00			Gas piping system 1 to 5 outlets	\$3.00	
	Floor Furnace	\$3.00			Gas piping system over 5 outlets (per outlet)	.20	
	Forced Air or Gravity Type under 100,000 BTU's	\$7.00			Swimming pool heater	\$4.00	
	Steam or hot water heating system under 15 outlets (Boiler Excluded)	\$8.00			VENTS		
	Steam or hot water heating system 15 to 30 outlets (Boiler Excluded)	\$10.00			Combustion products vent other than a chimney	\$1.00	
	Each outlet over 30"	.50			Residential kitchen or bathroom vent each	.25	
	Radiant type heating system under 1000 sq. ft. to be heated	\$8.00			Commercial Hood	\$4.00	
	Radiant type heating system 1000 to 2000 sq. ft. to be heated	\$10.00			Ventilation system not a portion of any heating or air conditioning system up to \$1,000 valuation	\$5.00	
	Each additional 500 sq. ft. over 2000 sq. ft.	.50			BOILER		
AIR CONDITIONING					Boiler installation 15 H.P. and under	\$5.00	
	Heat pump or refrigerant 3 tons or less	\$4.00			Boiler installation over 15 H.P.	\$10.00	
	Heat pump or refrigerant 3 tons to 10 tons	\$6.00			REPAIR		
	Each addn. ton over 10 ton	.50			Inspection of alteration or replacement of any mechanical cooling equipment which is a portion of any air conditioning system	\$3.00	
	Refrigeration system 3 ton or less	\$5.00			DUCT WORK ONLY (each opening)	.25	
	Refrigeration system 3 to 10 ton	\$7.00			WATER TOWER	\$4.00	
	Each addn. ton over 10 ton	.50			MINIMUM PERMIT FEE	\$4.00	
	Evaporative cooler 5 outlets and under	\$3.00			TOTAL PERMIT FEE		
	Evaporative cooler 5 to 10 outlets	\$5.00					6.00
	Each addn. outlet over 10	.25					

I hereby certify that I have carefully examined and read the above application; that the same is true and correct, and that the work herein described is to be done in accordance with all the provisions of the applicable Ordinances of the City of Las Vegas, Nevada and the State laws, whether herein specified or not.

SIGNED Lawson Gore Date 3/31/67
AIR CONDITIONING CONTRACTOR - OWNER
BUILDING DEPARTMENT 9. Wright Date 3-31-67
#1289 PERMIT NO. 145-25 PERMIT FEE \$ 6.00

RECEIPT
659 \$006.00 - 4
CITY OF LAS VEGAS
DEPT. OF BUILDING & SAFETY
MUST BE MACHINE VALIDATED
- 3 APR 67

W. Ealy 8-27-80

CITY OF LAS VEGAS, NEVADA
DEPARTMENT OF BUILDING & SAFETY

PERMIT FEE \$
APPLICATION & PERMIT FOR
PLUMBING

JOB ADDRESS: 3005 W. Wadsworth OWNER'S NAME: Pat & Patricia

LOT BLOCK SUBDIVISION Bldg. type: SFD APT COMM

Circle: New bldg; Old bldg; Add'n; Remodel; Pool; Wtr. Sftner; Lawn Sprkr; Other

CONTRACTOR: Super Plumbing State Lic. # 4410 City Lic. # 919

QUANTITY	FIXTURE OR INSTALLATION	Unit Price	AMOUNT
	Bathtub	1.00	
	Clothes dryer (gas)	1.00	
	Clothes washer	1.00	
	Dental unit	1.00	
	Dishwasher	1.00	
	Drinking fountain	1.00	
	Fire sprinkling - underground piping	5.00	
	Fire sprinkling - distribution piping per each foot	.01	
	Fire sprinkling heads - per each head	.10	
	Floor drain \$1.00 Floor sink	1.00	
	Gas appliance (any type) <u>to building gas line</u>	1.00	
	Gas piping system - single family dwelling	3.00	
	Gas piping system - multiple family \$3 per each unit plus	1.00	
	Gas piping system - commercial bldg. per each floor	3.00	
	Grease trap	1.00	
	Irrigation system	4.00	
	Lavatory	1.00	
	Minimum fee for any permit	4.00	
	Piping, Drainage	4.00	
	Sewer replacement	4.00	
	Septic disposal system - Health Dept. approval required	4.00	
	Shower	1.00	
	Sink - kitchen type	1.00	
	Swimming pool - private - wading pool	8.00	
	Swimming pool - public - semi-public	12.00	
	Toilet	1.00	
	Urinal	1.00	
	Water distribution system, single family dwelling	4.00	
	Water distribution system multiple dwg. \$4 + each unit	1.00	
	Water distribution system Group "A" thru "G" per each floor	4.00	
	Water distribution system Group "H" (hotel) \$4 + per bath	.50	
	Water heater (gas) (electric)	1.00	
	Water using equipment	1.00	
	Water softener nonpermanent type	4.00	
	Water softener permanent (connected to drainage)	5.00	
	Wash tray	1.00	

TOTAL FEE \$ 4.00

I hereby certify that I have carefully examined & read the above application; that the same is true & correct; and the work herein described is to be done in accordance with the provisions of City of Las Vegas Ordinances & State Laws, whether herein specified or not. * As defined in City Code and Ordinances.

SIGNED: Jack Tugano Date: 4-7-67
Registered Plumber, Spec. Cont'r, Owner

Engineering Dept. Date Building Department Date
Sewer Conn. Fee \$
Paid in Engr. Dept. PERMIT NO 2083 / PERMIT FEE \$ 4.00
23.10. #1287

RECEIPT
226 \$004.00 - 7
CITY OF LAS VEGAS
DEPT. OF
BUILDING & SAFETY
Must be machine validated
- 7 APR 67

Y. Ealy 8-27-80

CITY OF LAS VEGAS, NEVADA

LOG NO. & AREA

DEPARTMENT OF BUILDING & SAFETY

CONST. VAL. \$ 6000

APPLICATION & BUILDING PERMIT - for:
Dwellings, Duplexes, Misc. Residential Const.

ADDRESS OF CONSTRUCTION: 3005 Woodland Avenue

OWNER: Pete Poperakis

LOT(s)

BLOCK 1

SUBDIVISION

Hollydab Tr. #1

ZONE: R-1

Existing structure on lot: Dwelling ☐ Accessory bldgs. ☐ Vacant lot ☐ Other ☐

enlarge kitchen &

PROPOSED CONSTRUCTION: Encl. carport - Living & Dining Rm.

USE: Living room

MATERIALS OF CONSTRUCTION: Wood Frame ☐ Concrete Block ☐ Reinforced Concrete ☐ Steel Frame ☐

SQUARE FEET OF FLOOR AREAS: 1st 2nd 3rd Other TOTAL SQ. FT. 200

FIRE ZONE: 1 2 3 Occupancy Group A B C D E F G H I J-1-2-3-4-5

CONST. TYPE: I II III IV V

ARCHITECT: ENGINEER: NO. of UNITS NO. of STORIES


Plans Submitted: Yes ☐ No ☐ Calculations Submitted: Yes ☐ No ☐ Sewer Fee Req'd. Yes ☐ No ☐

CONTRACTOR: OWNER

STATE LICENSE #

CITY LICENSE #

ADD'L. PERMITS REQ'D: Air Cond. ☐ Elec. ☒ Plumbing ☐ Signs ☐ Paving ☐ Fence ☐ Public Walks ☐ Curb-gutters ☐
Incinerators ☐ Fire Sprinkling System ☐

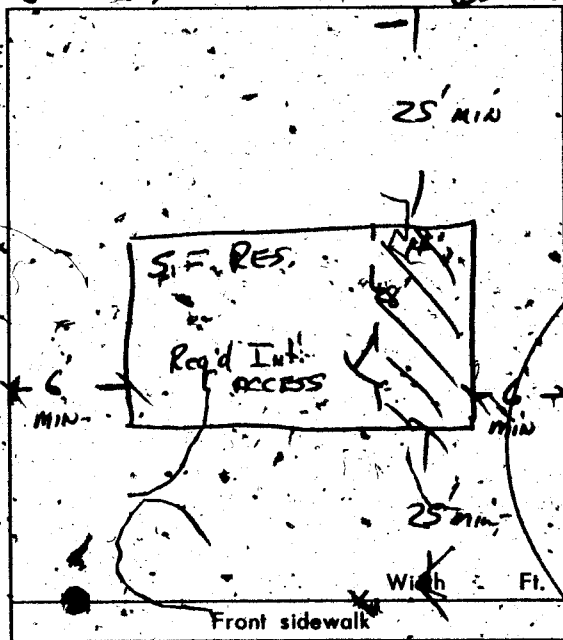

CONDITIONS OF THE PERMIT:

- I agree to call the City Building Department for inspections before concrete is poured, before rough wiring, electrical, plumbing, framing is covered. Also for Air conditioning, sheet-rock and sheathing inspection.
- I agree that when the job is completed that I will call for final inspection before occupancy.
- I agree to perform all construction in accordance with City Ordinances and Building Codes.
- The Contractor's signature below denotes authority from the owner to sign in his behalf and that the owner is aware of all requirements of this application and permit. Separate permits must be taken out for work outlined above this agreement.
- I have read and understand the contents of this application and permit; I hereby state that the information I have supplied on this application is true and correct.

SIGNED: [Signature] Contractor

BY: PETE PEPERAKIS Agent or Owner

CLARK COUNTY HEALTH DEPT.

LAS VEGAS FIRE DEPARTMENT

PLANNING DEPT. [Signature] Date: 8/8/69

PUBLIC WORKS DEPT. [Signature] Date: 8/8/69

BUILDING DEPT. [Signature] Date: 8/8/69

*12850 PERMIT NO. 48903 PERMIT FEE \$ 600

RECEIPT

562 \$006.00 - 8

CITY OF LAS VEGAS
DEPT. OF
BUILDING & SAFETY

MUST BE MACHINE VALIDATED

11 AUG 69

W. Ealy 8-27-80

CITY OF LAS VEGAS, NEVADA

DEPARTMENT OF BUILDING & SAFETY - ELECTRICAL APPLICATION & PERMIT

ADDRESS OF CONSTRUCTION: 3005 Woodland

OWNER'S NAME: Pete Peperakis

CIRCLE: New Bldg.; Add'n; Remodel; TYPE OF BLDG.: SFD. APT. PUBLIC COMM.

CONTRACTOR'S NAME: Owner

STATE LICENSE #

CITY LICENSE #

NUMBER	FIXTURE OR INSTALLATION	UNIT PRICE	
2	Fixture or sockets	.15	.30
10	Light, receptacle or switch outlet	.20	2.00
	Wall or ceiling space heater	.35	
	Blast coil heater per kilowatt	.35	
	Garbage grinder outlet	.35	
	Dishwasher outlet	.35	
	Clothes dryer outlet	.35	
	Automatic clothes washer	.35	
	Electric range outlet	.35	
	Electric water heater outlet	.35	
	Mercury arc lamp and equipment	.35	
	Special purpose outlet	.35	
	X-ray unit and its appurtenances	5.00	
	Watts of festoon lighting (Watts) First 3,000 watts	4.00	
	for each additional thousand watts	1.50	
	Horsepower - all motors first horsepower or less	1.75	
	for each additional horsepower	.35	
	Temporary power and lights (temporary pole)	4.00	
X	Electric service (including any single meter socket)	3.00	3.00
	for each additional socket	.35	
	Air conditioning service amps	1.50	
	Each KW (KVA) Generator (Transformer) (Welder) KW (KVA)	2.00	
	First 100 KVA For each additional KW (KVA)	.91	
	Special inspection per hour	4.00	
	Speaker outlets	.15	
	Signal or Alarm outlets	.15	
	Amplifiers	.50	
	Control panels	.25	
	T.V. outlets - master system only	.15	
	Radio outlets	.15	
	Main control racks	1.00	
	T.V. and Radio antennas - master system only	.75	
	Minimum fee for any permit	4.00	
	Total fee		5.30

I hereby certify that I have carefully examined and read the above application; that the same is true and correct and that the work herein described is to be done in accordance with all the provisions of the applicable Ordinances of the City of Las Vegas, Nevada and State laws whether herein specified or not.

SIGNED Pete Peperakis DATE 8/11/69
MASTER (ELECTRICIAN) (TECHNICIAN) (OWNER)

BUILDING DEPARTMENT

DATE 8/11/69

#12860

PERMIT NO. 28578

PERMIT FEE: \$5.30

RECEIPT

563 \$005.30 - 6

CITY OF LAS VEGAS
DEPT. OF BUILDING & SAFETY
MUST BE MACHINE VALIDATED

11 AUG 69

H. Ealy 8-27-80

CITY OF LAS VEGAS, NEVADA

LOG NO. & AREA

DEPARTMENT OF BUILDING & SAFETY

CONST. VAL. \$ 264

APPLICATION & BUILDING PERMIT for:
Fence, Wall, Retaining Wall.

ADDRESS OF
CONSTRUCTION:

3005 Woodland

OWNER:

Pete Papadakis

LOT(S)

BLOCK

1

SUBDIVISION

HOLLYDALE #1

ZONE:

A1

Materials of Construction:

Block ☒

Concrete ☐

Wire ☒

Wood ☐

Other ☐

Yes No

ARCHITECT:

ENGINEER:

PLANS

☒

CALCS

☐

CONTRACTOR:

Fencing Inc

STATE

LICENSE #

4019

CITY

LICENSE #

100-9

TOTAL SQUARE FEET:


TOTAL LINEAL FEET:

1327

Remarks:

CONDITIONS OF THE PERMIT:

1. Any type of retaining wall must be engineered by a Civil or Structural Engineer.
2. If a home owner takes out the Building Permit and if the owner sublets the work to a Contractor, then the Contractor must take out the permit and pay for it.
3. No fence or wall can be built on City property or rights-of-way, but this is not intended to preclude construction within utility easements, if utilities will not be damaged or made inaccessible.
4. The fence or wall shall not enclose any water meter, light standard, or fire alarm box and shall not come closer than 24" from the nearest fire hydrant outlet.
5. Department inspectors must approve footings before concrete is poured and block wall reinforcing before grouting is done.
6. Maximum height of any wall or fence is 6' side and rear yards; 4' maximum in front yard with the vertical surface above the height of 2' — 50% open.
7. I must not obstruct required onsite parking space (1 space for each dwelling unit) by the erection of this fence or wall.
8. By the signing of this application I herewith agree to the requirements outlined above.

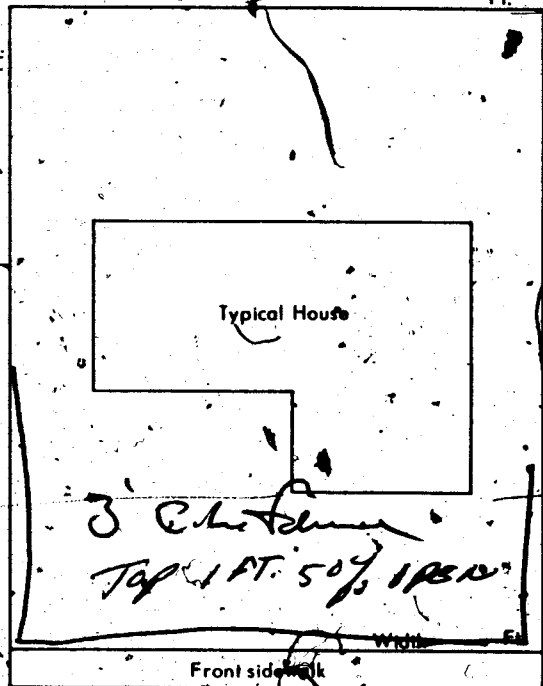

SIGNED:

[Signature]

DATE:

4-3-70

CONTRACTOR ☒

AGENT ☐

OWNER ☐

PLANNING DEPT.

[Signature]

Date:

4-3-70

PUBLIC WORKS DEPT.:

Date:

BUILDING DEPT.:

[Signature]

Date:

4-3-70

#12850

PERMIT NO.:

51878

PERMIT FEE \$

500

RECEIPT

1606 \$005.00 - 8

CITY OF LAS VEGAS

DEPT. OF

BUILDING & SAFETY

MUST BE MACHINE VALIDATED

- 3 APR 70

Hona Hously

1-24-84

DEPT. of BLDG & SAFETY—CITY of LAS VEGAS, NEVADA

OWNER Pete PeperakisADDRESS 3005 WoodlandDATE 8/11/69GEN. CONT. SamePERMIT NO. 48903LEGAL DESCRIPTION Lot 9 Blk 1 Hollydale #1TYPE OF STRUCTURE Encl airport

BUILDING	MECHANICAL	ELECTRICAL
LOCATION	PLUMBING CONT.	TEMP. POLE CONT.
FIREPLACE PTC.	PERMIT NO. _____ DATE _____	PERMIT NO. _____ DATE _____
FOOTINGS <u>W 21 8-14-69</u>	HEAT VENT. AC CONT.	INSPECTION _____ DATE _____
FOUNDATION WALL	PERMIT NO. _____ DATE _____	ELECTRICAL CONT. <u>Pete Peperakis</u>
FLOOR FRAMING	SEWER CONT.	PERMIT NO. <u>28575</u> DATE <u>8/11/69</u>
SLAB <u>W 21 8-14-69</u>	PERMIT NO. _____ DATE _____	FIXTURES CONT.
CHIMNEY STEEL (FIREPLACE)	ROUGH SOIL	PERMIT NO. _____ DATE _____
WALL STEEL	ROUGH WATER	SLAB
COLUMN STEEL	TOP-OUT	ROUGH <u>W 21 8-14-69</u>
BEAM STEEL	ROUGH GAS	FINAL ROUGH
FRAMING	AC ROUGH DUCT	FINAL FIXTURE
ROOF SHEATHING <u>W 21 8-14-69</u>	REF. ROUGH PIPING	FINAL ELECTRICAL
DRYWALL <u>W 21 8-14-69</u>	FINAL PLUMBING	TEMPORARY SERVICE
LATHING <u>W 21 8-14-69</u>	FINAL GAS	
BACKING (SHIMS)	FINAL AIR COND.	
PLASTER SCRATCH <u>W 21 8-14-69</u>	FINAL REFRIG.	
PLASTER BROWN <u>W 21 8-14-69</u>	FINAL SEWER	
URBAN-REDEVELOPMENT APPROVAL	FINAL SEPTIC TANK	
FINAL BLDG <u>W 21 8-14-69</u> DATE <u>9-23-69</u>		

APPROVED FOR OCCUPANCY & METER

INSPECTOR

DATE

PLEASE NOTE REMARKS ON REVERSE SIDE. 3005 Woodland

LOG #

AREA #

23.04

Department of Building & Safety
City of Las Vegas, NevadaSpecial Kardex
Elec. only, Plbg. only, A.C. onlyOwner Pete PeperakisAddress 3005 WoodlandDate: 11/3/67

Contractor

Permit No.

Lot

Block

Subdivision

Electric Only	Plumbing Only	Heat & Vent. A. C. Only
Contractor	Contractor <u>Leigmon Olmy</u>	Contractor <u>Valley Aire</u>
Permit No.	Permit No. <u>20831 4-7-67</u>	Permit No.
Slab	Rough Soil	A.C. Rough Duct
Rough Elect.	Rough Water	Ref. Ro. Piping
Final Rough	Top Out	Rough Gas
Final Fixture	Rough Gas	Final Refrig
Final Elec	Final Plbg.	Final Air Cond <u>W 21 8-14-69</u>
Temp. Service	Final Gas <u>W 21 8-14-69</u>	Final Gas
	Final Sewer	
	Final Septic Tank	

23.06 D

Address

3005 Woodland

Log No.

Area

Donna H. H. H.

6-24-84

DEPT. of BLDG. & SAFETY - CITY of LAS VEGAS, NEVADA

OWNER: HOLLYDALE MUT. HOMES #1, INC. ADDRESS: 3005 Woodland Ave. DATE: 7-8-57

GEN. CONT. ARDEN BLDG. CORP. TYPE OF STRUCTURE DWELLING

PERMIT NO. 29195 LEGAL DESCRIPTION: Lot 9, Bl. 1, Hollydale Tr. #1.

LOCATION & FLOOR ELEVATION	PLUMBING CONT. Ferguson	TEMP. POLE CONT.
FOOTING <i>Found without inspection</i>	PERMIT NO. 27255 DATE 9-3-57	PERMIT NO. DATE
FOUND & PIERS	HEAT & VENT. CONT.	INSPECTION DATE
WALL STEEL	PERMIT NO. DATE	ELECTRICAL CONT. <i>Acme</i>
BOND BEAM STEEL	SEWER CONT. <i>Same</i>	PERMIT NO. 21396 DATE 10-7-57
FRAMING & ROOF SHEATHING	ROUGH SOIL <i>Battery 9-5-57</i>	OUTLETS
STEEL FABRICATION	ROUGH WATER <i>Battery 9-5-57</i>	MOTORS
CONNECTIONS & PAINTING	SEWER OR SEPTIC TANK <i>Battery 9-5-57</i>	SLAB
LATHING	TOP-OUT <i>Battery 10-3-57</i>	ROUGH <i>Quaker 3-57</i>
PLASTER	ROUGH GAS <i>Battery 10-3-57</i>	FINAL, ROUGH
SCRATCH	ROUGH DUCT <i>Battery 10-3-57</i>	FIXTURE CONT. <i>Acme</i>
BROWN	FINAL PLUMBING <i>Smith 1-31-58</i>	PERMIT NO. 21396 DATE 10-7-57
FINAL BLDG. <i>ELDER</i>	FINAL HEATING	FIXTURES
GRASS & DRAINAGE	FINAL GAS <i>Smith 2-4-58</i>	FINAL FIXTURE
ON-SITE PARKING		APPROVED FOR METER <i>Jo. 1/21/58</i>
ENG. APPROVAL OF OFF-SITE IMPROVEMENTS		

APPROVED for OCCUPANCY: H. ELDER INSPECTOR

2/6/58 DATE

* PLEASE NOTE REMARKS ON REVERSE SIDE

3005 Woodland Ave.

DWELLING

7/8/57

28.04

DEPARTMENT OF BUILDING & SAFETY
CITY OF LAS VEGAS, NEVADA

KARDEX CARD
FENCE & RETAINING
WALLS

OWNER Pete Peperakis ADDRESS 3005 Woodland DATE 4/3/70

CONTRACTOR Fencing Inc. PERMIT NO. 51878

LOT 9 BLOCK 1 SUBDIVISION Hollydale #1 Wire

Fence (wire, wood, etc.)	Walls (masonry, rock, etc.)
Location	Location
Final Inspection <i>OB 7-2-70</i>	Footings
	Wall Steel 1st 2d 3d
	Final Inspection
Retaining Walls (masonry)	Retaining Wall (concrete)
Location	Location
Footings	Footings
Wall Steel 1st 2d 3d	Wall Steel 1st 2d 3d
Bond Beam 1st 2d 3d	Final Inspection
Final Inspection	

23:14 B

ADDRESS 3005 Woodland

LOG NO.

AREA