

905 N. 22nd St. /s

LOT 9 BLK 1 G.L.V. ADDN. 3 UNIT 5-A ZONE R-1

Theresa Kyriakos 10/16/80

CITY OF LAS VEGAS, NEVADA

LOG NO. & AREA T-15/2

CONST. VAL. \$ 13,060.00

DEPARTMENT OF BUILDING & SAFETY

APPLICATION & BUILDING PERMIT

Dwellings, Duplexes, Other Residential Units

ADDRESS OF CONSTRUCTION: 905 - 22nd Street North

OWNER: Nevada Western Development Corp.
Formerly Mortgage Services, Inc.

LOT(s) 9 BLOCK 1 SUBDIVISION Greater Las Vegas Addn. 3, Unit 3-A ZONE R-1

Existing structure on lot: Dwelling ☒ Accessory bldg. ☐ Vacant lot ☐ Other ☐

PROPOSED CONSTRUCTION: Single family dwelling with garage USE: Residence

MATERIALS OF CONSTRUCTION: Wood Frame ☒ Concrete Block ☐ Reinforced Concrete ☐ Steel Frame ☐

SQUARE FEET OF FLOOR AREAS: 1st 2nd 3rd Other TOTAL 1,112


FIRE ZONE: 1 2 3 Occupancy Group A B C D E F G H I J 1-2-3-4-5 CONST. TYPE: 1 2 3 4 5 6 7 8 9 10 11 12

ARCHITECT: None ENGINEER: Voorhees-Triadle NO. of UNITS NO. of STORIES

Plans Submitted: Yes ☒ No ☐ Calculations Submitted: Yes ☒ No ☐ Sewer Fee Req'd: Yes ☐ No ☒

CONTRACTOR: Robert Shaw STATE LICENSE # B 9440 CITY LICENSE # 013-916-4-1111

ADD'L. PERMITS REQ'D: Air Cond. ☒ Elec. ☒ Plumbing ☒ Signs ☐ Pave. ☐ Fence ☐ Public Works ☐ Cart-gutters ☐ Incinerators ☐ Fire Sprinkling System ☐

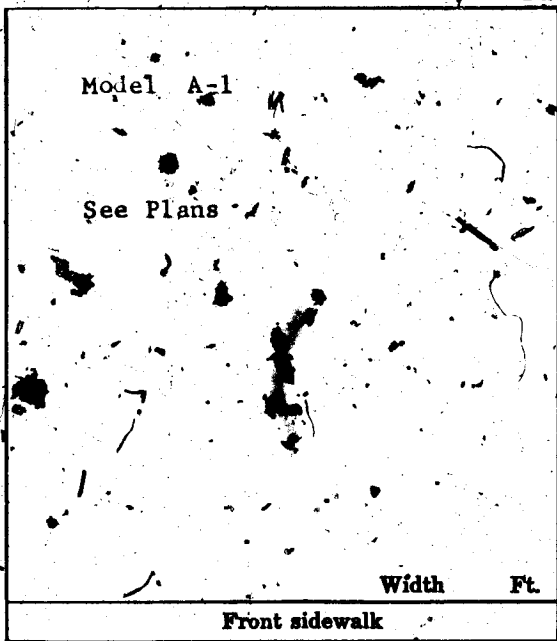

CONDITIONS OF THE PERMIT:

- I agree to call the City Building Department for inspection before concrete is poured, before rough finish, electrical plumbing, framing is covered. Also for Air conditioning sheetrock and sheathing inspection.
- I agree that when the job is complete, I will call for final inspection before occupancy.
- I agree to perform all construction in accordance with City Ordinances and Building Codes.
- The Contractor's signature below denotes authority from the owner to sign in his behalf and that the owner is aware of all requirements of this application and permit. Separate permits must be taken out for work outlined above this agreement.
- I have read and understand the contents of this application and permit. I hereby state that the information I have supplied on this application is true and correct.

SIGNED: Robert Shaw Contractor

BY: R. Shaw Agent or Owner

Date

CLARK COUNTY HEALTH DEPT.

Date

LAS VEGAS FIRE DEPARTMENT

PLANNING DEPT:

Date: 5-24-68

ENGINEERING DEPT:

Date: 5-24

BUILDING DEPT:

Date: 5-24-68

#1285

PERMIT NO: 42011

PERMIT FEE \$ 48.00

RECEIPT

094 \$048.00 - 8

CITY OF LAS VEGAS
DEPT. OF
BUILDING & SAFETY

MUST BE MACHINE VALIDATED

24 MAY 68

Theresa Kyriakos 10/16/80

SEWER CONNECTION FEE: \$

For
SEWER FEE

2nd St. North
OWNER'S NAME Nevada Western Development Corp.
SUBDIVISION Greater Las Vegas Addn. 3, Unit 5-A

OCCUPANCY	UNIT FEE	AMOUNT
	150.00	150.00
TOTAL 150.00		
Less Credit*		
TOTAL FEE \$ 150.00		

*Credit for existing sewer is applied to the new sewer connection fee based on previous type of occupancy and only when the new occupancy requires an additional fee.

This receipt does not authorize the owner or his representative to start any work without obtaining a plumbing permit.

DEPARTMENT OF BUILDING & SAFETY

DATE

5-24-80

#12870 RECEIPT NO. 23915 SEWER FEE \$ 150.00

23.30

73102

Receipt

095 \$150.00 - 3

CITY OF LAS VEGAS

DEPT. OF
BUILDING & SAFETY

Must be machine validated

Theresa Kyriakos 10/6/80

CITY OF LAS VEGAS, NEVADA
DEPARTMENT OF BUILDING & SAFETY

PERMIT FEE \$
APPLICATION & PERMIT FOR
PLUMBING

JOB ADDRESS: 919 Brady OWNER'S NAME: Robert Shurt

LOT 9 BLOCK 1 SUBDIVISION SP Bldg. type: SP APT COMM
Circle: New bldg Old bldg; Add'n; Remodel; Pool; Wtr. Sftner; Lawn Sprkr; Other

CONTRACTOR: Cos Plumbing State Lic. # 7596 City Lic. # 10700

QUANTITY	FIXTURE OR INSTALLATION	Unit Price	AMOUNT
	Bathtub	1.00	1.00
	Clothes dryer (gas)	1.00	
	Clothes washer	1.00	1.00
	Dental unit	1.00	
	Dishwasher	1.00	
	Drinking Fountain	1.00	
	Fire sprinkling - underground piping	5.00	
	Fire sprinkling - distribution piping per each foot	.01	
	Fire sprinkling heads - per each head	.10	
	Floor drain \$1.00 Floor sink	1.00	
	Gas appliance (any type)	1.00	
	Gas piping system - single family dwelling	3.00	3.00
	Gas piping system - multiple family \$3 per each unit plus	1.00	
	Gas piping system - commercial bldg. per each floor	3.00	
	Grease trap	1.00	
	Irrigation system	4.00	
	Lavatory	1.00	2.00
	Minimum fee for any permit	4.00	
	Piping, Drainage	4.00	4.00
	Sewer replacement	4.00	
	Septic disposal system - Health Dept. approval required	4.00	
	Shower	1.00	1.00
	Sink - kitchen type	1.00	1.00
	Swimming pool - private - wading pool	8.00	
	Swimming pool - public - semi-public	12.00	
	Toilet	1.00	2.00
	Urinal	1.00	
	Water distribution system, single family dwelling	4.00	4.00
	Water distribution system multiple dwg. \$4 + each unit	1.00	
	Water distribution system Group "A" thru "G" per each floor	4.00	
	Water distribution system Group "H" (Hotel) \$4 + per bath*	.50	
	Water heater (gas) (electric)	1.00	1.00
	Water using equipment	1.00	
	Water softener nonpermanent type	4.00	
	Water softener permanent (connected to drainage)	5.00	
	Washbasin	1.00	

I hereby certify that I have carefully examined & read the above application; that the same is true & correct; and the work herein described is to be done in accordance with the provisions of City of Las Vegas Ordinances & State Laws, whether herein specified or not. * As defined in City Code and Ordinances.

TOTAL FEE \$ 20.00

SIGNED: Dr. E. Cos Date: 6-25-68
Registered Plumber Spec. Cont'r Owner
Engineering Dept. Date 6-25-68
Sewer Conn. Fees 23.10 #12870
Paid in Engr. Dept. PERMIT NO 24218 PERMIT FEE \$ 20.00

RECEIPT
1347 \$020.00 - 7
CITY OF LAS VEGAS
DEPT. OF BUILDING & SAFETY
Must be machine validated
24 JUN 68

Theresa: Kynakas 10/6/80

CITY OF LAS VEGAS, NEVADA
DEPARTMENT OF BUILDING & SAFETY - AIR CONDITIONING APPLICATION & PERMIT

ADDRESS OF CONSTRUCTION: 905 N. 22nd St., Las Vegas, Nevada
OWNER'S NAME: Mortgage Services, Inc.
CIRCLE: New bldg. Old bldg. Add'n. Remodel. TYPE OF BLDG. SFD APT. COMM.
CONTRACTOR'S NAME: Clark County Air Conditioning STATE LICENSE # 8133A CITY LICENSE # 1655

UNITS	HEATERS	PRICE	FEE	UNITS	GAS	PRICE	FEE
	Unit Heaters (floor, suspended & wall)	\$2.00			Gas piping system, 1 to 5 outlets	\$3.00	
	Floor Furnace	\$3.00			Gas piping system over 5 outlets (per outlet)	.20	
	Forced Air or Gravity Type under 100,000 BTU's	\$7.00			Swimming pool heater	\$4.00	
	Steam or hot water heating system under 15 outlets (Boiler Excluded)	\$8.00		VENTS			
	Steam or hot water heating system 15 to 30 outlets (Boiler Excluded)	\$10.00			Combustion products vent other than a chimney	\$1.00	
	Each outlet over 30	.50			Residential kitchen or bathroom vent each	.25	
	Radiant type heating system under 1000 sq. ft. to be heated	\$8.00			Commercial Hood	\$4.00	
	Radiant type heating system 1000 to 2000 sq. ft. to be heated	\$10.00			Ventilation system not a portion of any heating or air conditioning system up to \$1,000 valuation	\$5.00	
	Each additional 500 sq. ft. over 2000 sq. ft.	.50		BOILER			
AIR CONDITIONING					Boiler installation 15 H.P. and under	\$5.00	
	Heat pump or refrigerant 3 tons or less.	\$4.00			Boiler installation over 15 H.P.	\$10.00	
	Heat pump or refrigerant 3 tons to 10 tons	\$6.00		REPAIR			
	Each addn. ton over 10 ton	.50			Inspection of alteration or replacement of any mechanical cooling equipment which is a portion of any air conditioning system	\$3.00	
1	Refrigeration system 3 ton or less	\$5.00	5.00		DUCT WORK ONLY (each opening)	.25	2.00
	Refrigeration system 3 to 10 ton	\$7.00			WATER TOWER	\$4.00	
	Each addn. ton over 10 ton	.50			MINIMUM PERMIT FEE	\$4.00	
	Evaporative cooler 5 outlets and under	\$3.00		TOTAL PERMIT FEE \$7.00			
	Evaporative cooler 5 to 10 outlets	\$5.00					
	Each addn. outlet over 10	.25					

I hereby certify that I have carefully examined and read the above application; that the same is true and correct; and that the work herein described is to be done in accordance with all the provisions of the applicable Ordinances of the City of Las Vegas, Nevada and the State laws, whether herein specified or not.

SIGNED A. J. Lawton AIR-CONDITIONING CONTRACTOR - OWNER

Date 7/17/68

BUILDING DEPARTMENT G. Wenzel

Date 7-17-68

#1289

PERMIT NO. 16346 PERMIT FEE \$ 7.00

RECEIPT

2476 \$007.00 - 4

CITY OF LAS VEGAS
DEPT. OF
BUILDING & SAFETY

Theresa Kynakas 10/6/80

CITY OF LAS VEGAS, NEVADA

DEPARTMENT OF BUILDING & SAFETY - ELECTRICAL APPLICATION & PERMIT

ADDRESS OF
CONSTRUCTION: 905 No. 22nd St.

OWNER'S
NAME: Nevada Western

LOT(S) BLOCK SUBDIVISION Type of bldg. SFD ☒ Apt. ☐ Comm. ☐

Check Proper Construction: New Bldg. ☒ Addn. ☐ Remodel ☐ Temporary Pole ☐ Old Bldg. ☐

CONTRACTOR'S NAME: Cadenbach Electric

STATE
LICENSE # 8016 CITY
LICENSE # 09013

NUMBER	FIXTURE OR INSTALLATION	UNIT PRICE	
10	Fixture or sockets	115	1.50
47	Light, receptacle or switch outlet	.20	8.20
	Wall or ceiling space heater	.35	
	Blast coil heater per kilowatt	.35	
1	Garbage grinder outlet	.35	.35
1	Dishwasher outlet	.35	.35
	Clothes dryer outlet	.35	
1	Automatic clothes washer	.35	.35
	Electric range outlet	.35	
	Electric water heater outlet	.35	
	Mercury arc lamp and equipment	.35	
2	Special purpose outlet	.35	.70
	X-ray unit and its appurtenances	5.00	
	Watts of festoon lighting (Watts) First 3,000 watts	4.00	
	for each additional thousand watts	1.50	
	Horsepower - all motors first horsepower or less	1.75	
	for each additional horsepower	.35	
	Temporary power and lights (temporary pole)	4.00	
1	Electric service (including any single meter socket)	3.00	3.00
	for each additional socket	.35	
1	Air conditioning service	1.50	1.50
	amps		
	Each KW (KVA) Generator (Transformer) (Welder) KW (KVA)	2.00	
	First 100 KVA - For each additional KW (KVA)	.01	
	Special inspection per hour	4.00	
	Speaker outlets	.15	
	Signal or Alarm outlets	.15	
	Amplifiers	.50	
	Control panels	.25	
	T. V. outlets - master system only	.15	
	Radio outlets	.15	
	Main control racks	1.00	
	T. V. and Radio antennas - master system only	.75	
	Minimum fee for any permit	4.00	
	Total fee		15.95

I hereby certify that I have carefully examined and read the above application; that the same is true and correct; and that the work herein described is to be done in accordance with all the provisions of the applicable Ordinances of the City of Las Vegas, Nevada and State laws whether herein specified or not.

SIGNED Theresa Kynakas Date 8/19/68

MASTER (ELECTRICIAN) (TECHNICIAN) (OWNER)

BUILDING DEPARTMENT

Date 8/20/68

#1286

PERMIT NO. 26140

PERMIT FEE: \$ 15.95

RECEIPT

3857 \$015.95 - 6

CITY OF LAS VEGAS

DEPT. OF
BUILDING & SAFETY

MUST BE MATCHED & VALIDATED

20 AUG 68

Theresa Kynakas 10/16/80

CITY OF LAS VEGAS, NEVADA

LOG NO. & AREA _____ CONST. VAL. \$ 135.00
DEPARTMENT OF BUILDING & SAFETY APPLICATION & BUILDING PERMIT — for:
Fence, Wall, Retaining Wall.

ADDRESS OF CONSTRUCTION: 905 - 22nd Street OWNER: Nevada Western Development Corp.

LOT(s) 9 BLOCK 1 SUBDIVISION Greater Las Vegas Add'n. 3, Unit 5-A ZONE: R-1

Materials of Construction: Block ☒ Concrete ☐ Wire ☐ Wood ☐ Other ☐ Yes No
PLANS: ☐ ☒

ARCHITECT: _____ ENGINEER: _____ CALCS: ☐ ☒


CONTRACTOR: Ernie Black STATE LICENSE # 9721 CITY LICENSE # C11197

TOTAL SQUARE FEET: _____ TOTAL LINEAL FEET: 40
(40" High)

Remarks:

CONDITIONS OF THE PERMIT:

1. Any type of retaining wall must be engineered by a Civil or Structural Engineer.
2. If a home owner takes out the Building Permit and if the owner sublets the work to a Contractor, then the Contractor must take out the permit and pay for it.
3. No fence or wall can be built on City property or rights-of-way, but this is not intended to preclude construction within utility easements if utilities will not be damaged or made inaccessible.
4. The fence or wall shall not enclose any water meter, light standard, or fire alarm box and shall not come closer than 24" from the nearest fire hydrant outlet.
5. Department Inspectors must approve footings before concrete is poured and block wall reinforcing before grouting is done.
6. Maximum height of any wall or fence is 6', side and rear yards; 4' maximum in front yard with the vertical surface above the height of 2' — 50% open and further that fencing within 25' of the intersection of curb faces on corner and through lots is limited to a maximum height of 30".
7. I must not obstruct required onsite parking space (1 space for each dwelling unit) by the erection of this fence or wall.
8. By the signing of this application I herewith agree to the requirements outlined above.

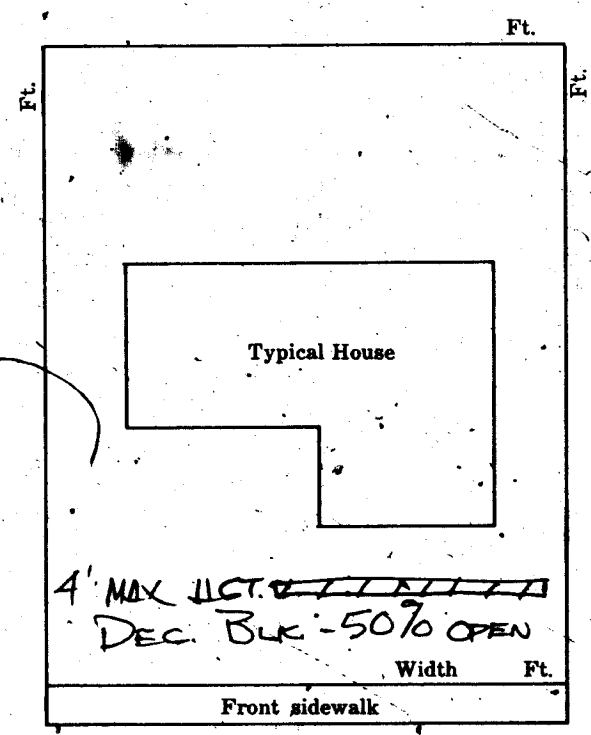

SIGNED: [Signature] DATE: _____
CONTRACTOR ☒ AGENT ☐ OWNER ☐

PLANNING DEPT: [Signature] Date: 10-15-68
ENGINEERING DEPT: _____ Date: _____
BUILDING DEPT: [Signature] Date: 10-16-68
PERMIT NO: 44862 PERMIT FEE \$: 4.00

RECEIPT
6578 \$004.00 — 8
CITY OF LAS VEGAS
DEPT. OF
BUILDING & SAFETY
MUST BE MACHINE VALIDATED
16 OCT 68

Theresa Kynakas 10/6/80

CITY OF LAS VEGAS, NEVADA

LOG NO. & AREA: 11-11

CONST. VAL. \$ 3000.00

DEPARTMENT OF PUBLIC SERVICES
DIVISION OF BUILDING AND SAFETY

APPLICATION & BUILDING PERMIT — for:
Dwellings, Duplexes, Misc. Residential Const.

ADDRESS OF CONSTRUCTION: 905 N. 22nd St.

OWNER: Tony Phillips

LOT(s) 9 BLOCK 1 SUBDIVISION CARATON LAS VEGAS ZONE UNIT 5-A 12-1

Existing structure on lot: Dwelling ☒ Accessory Bldgs. ☐ Vacant Lot ☐ Other ☐

PROPOSED CONSTRUCTION: Ins. Alum. Siding

USE: _____

MATERIALS OF CONSTRUCTION: Wood Frame ☐ Concrete Block ☐ Reinforced Concrete ☐ Steel Frame ☐

SQUARE FEET OF FLOOR AREAS: 1st _____ 2nd _____ 3rd _____ Other _____ TOTAL SQ. FT. _____

FIRE ZONE: _____ Occupancy Group _____ CONST. TYPE: _____

ARCHITECT: _____ ENGINEER: _____ NO. of UNITS: _____ NO. of STORIES: _____

Plans Submitted: Yes ☐ No ☐ Calculations Submitted: Yes ☐ No ☐ Sewer Fee Req'd: Yes ☐ No ☐

CONTRACTOR: Dura-Kool Alum. Prod. Inc. STATE LICENSE # 11488-A CITY LICENSE # 10254

ADD'L. PERMITS REQ'D.: Air Cond. ☐ Elec. ☐ Plumbing ☐ Signs ☐ Paving ☐ Fence ☐ Public Walks ☐ Curb-gutters ☐
Incinerators ☐ Fire Sprinkling System ☐


CONDITIONS OF THE PERMIT:

1. I agree to call the City Building Department for inspections before concrete is poured, before rough wiring, electrical, plumbing, framing is covered. Also for Air conditioning, drywall and sheathing inspection.
2. I agree that when the job is completed that I will call for final inspection before occupancy.
3. I agree to perform all construction in accordance with City Ordinances and Building Codes.
4. The Contractor's signature below denotes authority from the owner to sign in his behalf and that the owner is aware of all requirements of this application and permit. Separate permits must be taken out for work outlined above this agreement.
5. I have read and understand the contents of this application and permit; I hereby state that the information I have supplied on this application is true and correct.

Approval for the work under this permit will be given only after refuse and debris have been removed from job site and public right of way.

SIGNED: Dura-Kool Alum. Prod. Inc. Contractor

BY: Betty Cohen Agent or Owner
Betty Cohen Sec-Treas

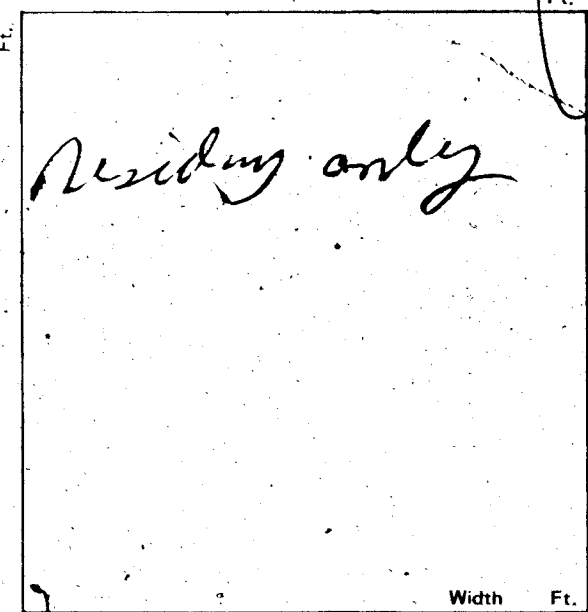

PLANNING DEPT.: [Signature] Date: 6-15-79

PUBLIC WORKS DEPT.: [Signature] Date: 6-15-79

BUILDING DIVISION: [Signature] Date: 6-15-79

PERMIT NO. 4865-3 PERMIT FEE \$ 18.00

154-01-220

RECEIPT

MUST BE MACHINE VALIDATED

DEPT. of BLDG & SAFETY—CITY of LAS VEGAS, NEVADA
OWNER NEV. WESTERN DEV. CORP. ADDRESS 905 N. 22ND. ST. DATE 5-24-68
GEN. CONT. ROBERT SHAW TYPE OF STRUCTURE S.F.D. WITH
PERMIT NO. 2011 LEGAL DESCRIPTION Lot 9, Blk. 1, GLV. ADDN. #3, Unit 5-A CAR

BUILDING		MECHANICAL		ELECTRICAL	
LOCATION <u>4-12-68</u>		PLUMBING CONT. <u>24218</u>	DATE <u>5-24-68</u>	TEMP. POLE CONT.	
FIREPLACE ETC.		PERMIT NO. <u>24218</u>	DATE <u>5-24-68</u>	PERMIT NO. <u>24218</u>	DATE <u>5-24-68</u>
FOUNDINGS <u>4-12-68</u>		HEAT & VENT. AC CONT. <u>Thick Co. Co.</u>		INSPECTION	DATE
FOUNDATION WALL		PERMIT NO. <u>16346</u>	DATE <u>7-17-68</u>	ELECTRICAL CONT. <u>Calderwood</u>	
FLOOR FRAMING		SEWER CONT. <u>NEV. WESTERN DEV. CORP.</u>		PERMIT NO. <u>24218</u>	DATE <u>5-24-68</u>
SLAB <u>4-12-68</u>		PERMIT NO. <u>23915</u>	DATE <u>5-24-68</u>	FIXTURES CONT.	
CHIMNEY STEEL (FIREPLACE)		ROUGH SOIL		PERMIT NO. <u>24218</u>	DATE <u>5-24-68</u>
WALL STEEL		ROUGH WATER		SLAB	
COLUMN STEEL		TOP-OUT <u>W & F-68</u>		ROUGH	<u>W & F-68</u>
BEAM STEEL		ROUGH GAS <u>W & F-68</u>		FINAL ROUGH	
FRAMING <u>4-12-68</u>		AC ROUGH DUCT		FINAL FIXTURE	
ROOF SHEATHING		REF. ROUGH PIPING		FINAL ELECTRICAL <u>Presented 5-3-68</u>	
INTERIOR		FINAL PLUMBING <u>W & F-68</u>		TEMPORARY SERVICE	
DRYWALL <u>4-26-68</u>		FINAL GAS <u>W & F-68</u>			
LATHING		FINAL AIR COND. <u>W & F-68</u>			
BACKING (SIDING)		FINAL REFRIG			
PLASTER		FINAL SEWER <u>W & F-68</u>			
SCRATCH		FINAL SEPTIC TANK			
BROWN					
URBAN REDEVELOPMENT APPROVAL					
FINAL BLDG <u>4-12-68</u>					
DATE <u>4-12-68</u>					

APPROVED FOR OCCUPANCY & METER 4-26-68 INSPECTOR 4-26-68 DATE 4-26-68
PLEASE NOTE REMARKS ON REVERSE SIDE 905 N. 22ND. ST. Log # T-15/2 AREA # 23.06

Department of Building & Safety
City of Las Vegas, Nevada

Special Kardex
Elec. only, Plbg. only, A.C. only

Owner Tony Phillips Address 905 No. 22d Date 3/11/69
Contractor Las Vegas Water Cond. Permit No. 26030
Lot Block Subdivision

Electric Only	Plumbing Only	Heat & Vent. A. C. Only
Contractor	Contractor	Contractor
Permit No.	Permit No.	Permit No.
Slab	Rough Soil	A.C. Rough Duct
Rough Elect	Rough Water	Ref. Ro. Piping
Final Rough	Top Out	Rough Gas
Final Fixture	Rough Gas	Final Refrig
Final Elec	Final Plbg. <u>W & F-68</u>	Final Air Cond
Temp. Service	Final Gas	Final Gas
	Final Sewer	
	Final Septic Tank	

23.06 D Address 905 No. 22d Log No. Area Softener

Don't Haul

2-27-84

OWNER TONY PHILLIPS		ADDRESS 905 N. 22ND ST.	
DATE 6/15/79		GEN. CONT. KURA KOOL	
ALUM SIDING		4865-3	
TYPE OF STRUCTURE		PERMIT NO.	
LEGAL DESCRIPTION L9 BL. GREATER LAS VEGAS #3		FINAL INSPECTION	
APPROVED FOR OCCUPANCY & METER			
BUILDING		MECHANICAL	
Investigation		Plumbing Cont.	
Location & Footing		Permit No. Date	
Concrete Slab Floor		Heat & Vent. A/C Cont.	
Fireplace Footing		Permit No. Date	
Chimney Steel		Sewer Cont.	
Vert. Steel Reinf.		Permit No. Date	
Horiz. Steel Reinf.		Rough Soil	
Framing		Rough Water	
Ext. Lath		Top Out	
Ext. Brown		Rough Gas	
Drywall		A/C Rough Duct	
Final Building 4-22-80-4		Final Plumbing	
Appr. for Occu.		Final Gas	
ELECTRICAL		Final Air Cond.	
Temp. Pole Cont.		Final Sewer	
Permit No. Date		REMARKS	
Inspection Date			
Electrical Cont.			
Permit No. Date			
Rough		PLEASE NOTE ADDITIONAL REMARKS ON REVERSE SIDE.	
Final Rough		DIV. OF BLDG. & SAFETY	
Final Electrical		CITY OF LAS VEGAS	
Temporary Service		REV 10-78	

DEPARTMENT OF BUILDING & SAFETY
CITY OF LAS VEGAS, NEVADA

KARDEX CARD
FENCE & RETAINING
WALLS

OWNER Nevada Western Dev. ADDRESS 905 N. 22nd St. DATE 10/16/68

CONTRACTOR Ernie Black PERMIT NO. 44862

LOT 9 BLOCK 1 SUBDIVISION Gr. L. V. Add. #3

Fence (wire, wood, etc.)		Walls (masonry, rock, etc.)	
Location		Location <u>Q A 10-24-68</u>	
Final Inspection		Footing <u>Q A 10-24-68</u>	
		Wall Steel 1st <u>Q A 11-24-68</u> 2d <u>3d</u>	
		Final Inspection <u>Q A 11-24-68</u>	
Retaining Wall (masonry)		Retaining Wall (concrete)	
Location		Location	
Footing		Footing	
Wall Steel 1st <u>2d</u> <u>3d</u>		Wall Steel 1st <u>2d</u> <u>3d</u>	
Bond Beam 1st <u>2d</u> <u>3d</u>		Final Inspection	
Final Inspection			

23.14 B

ADDRESS 905 N. 22nd St.

AREA