



DESERT DREAM ESTATES - UNIT 2
BOOK 49, PAGE 87

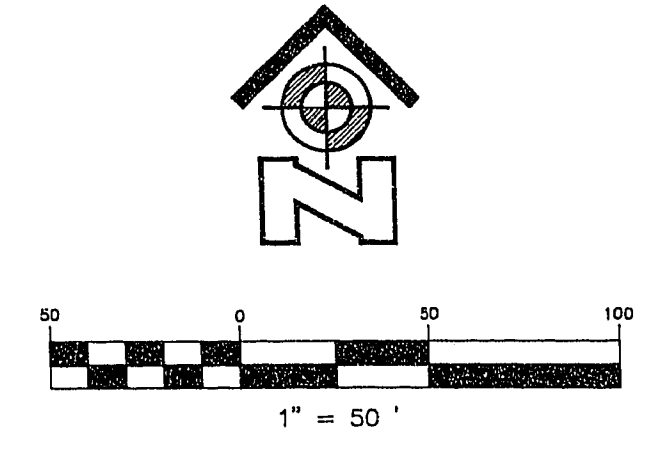

- FOUND REFERENCE CAP AS DESCRIBED
- ⊙ FOUND MONUMENT AS DESCRIBED
- ⊙ SET TYPE II ALCAP PLS #7169
- SET 1-3/8" DIA. BRASS CAP IN CONCRETE CURB



FD. TYPE II MONUMENT
PLS NO. 7008

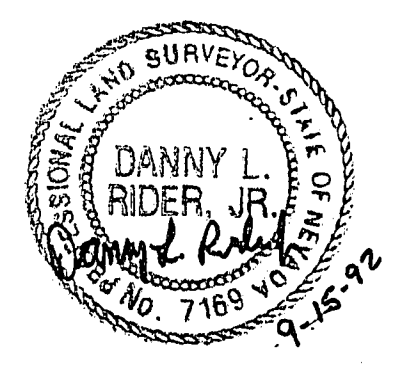

I, DANNY L. RIDER, JR., A PROFESSIONAL LAND SURVEYOR IN THE STATE OF NEVADA DO HEREBY CERTIFY THAT THE MONUMENTS HAVE BEEN SET, AND THE DISTANCES HAVE BEEN ESTABLISHED AS SHOWN HEREON. THIS SURVEY WAS COMPLETED ON SEPTEMBER 2, 1992

Danny L. Rider, Jr.
DANNY L. RIDER, JR., P.L.S.
NEVADA CERTIFICATE NO. 7169

REVISIONS

SCALE	1" = 50'
DRAWN BY	CA
FIELD BK.	PC
SE CTR.	SEC 35, T19 S, R60 E, M.D.M.

GREAT WEST SURVEYING, INC.
2245 NORTH DECATUR BOULEVARD SUITE D
LAS VEGAS, NEVADA 89108
(702) 646-4941 FAX: 646-3393

CENTERLINE TIE PLAN
DESERT DREAM ESTATES - UNIT 1
BOOK 49, PAGE 87
CITY OF LAS VEGAS, CLARK COUNTY, NEVADA

JOB TITLE
JOB NO. 33010792
SHEET NO. 1 OF 1

058-4090-1

9-6-9