SURVEYOR'S CERTIFICATE

I, GERALD L. WIRTHLIN, A PROFESSIONAL LAND SURVEYOR IN THE STATE OF NEVADA, DO HEREBY CERTIFY THAT THE MONUMENTS HAVE BEEN SET AND THE TIE DISTANCES ESTABLISHED AS SHOWN HEREON. THIS SURVEY WAS COMPLETED ON MARCH 15, 1995.

GERALD L. WIRTHLIN
PROFESSIONAL LAND SURVEYOR
NEVADA CERTIFICATE No. 7008

3/27/95

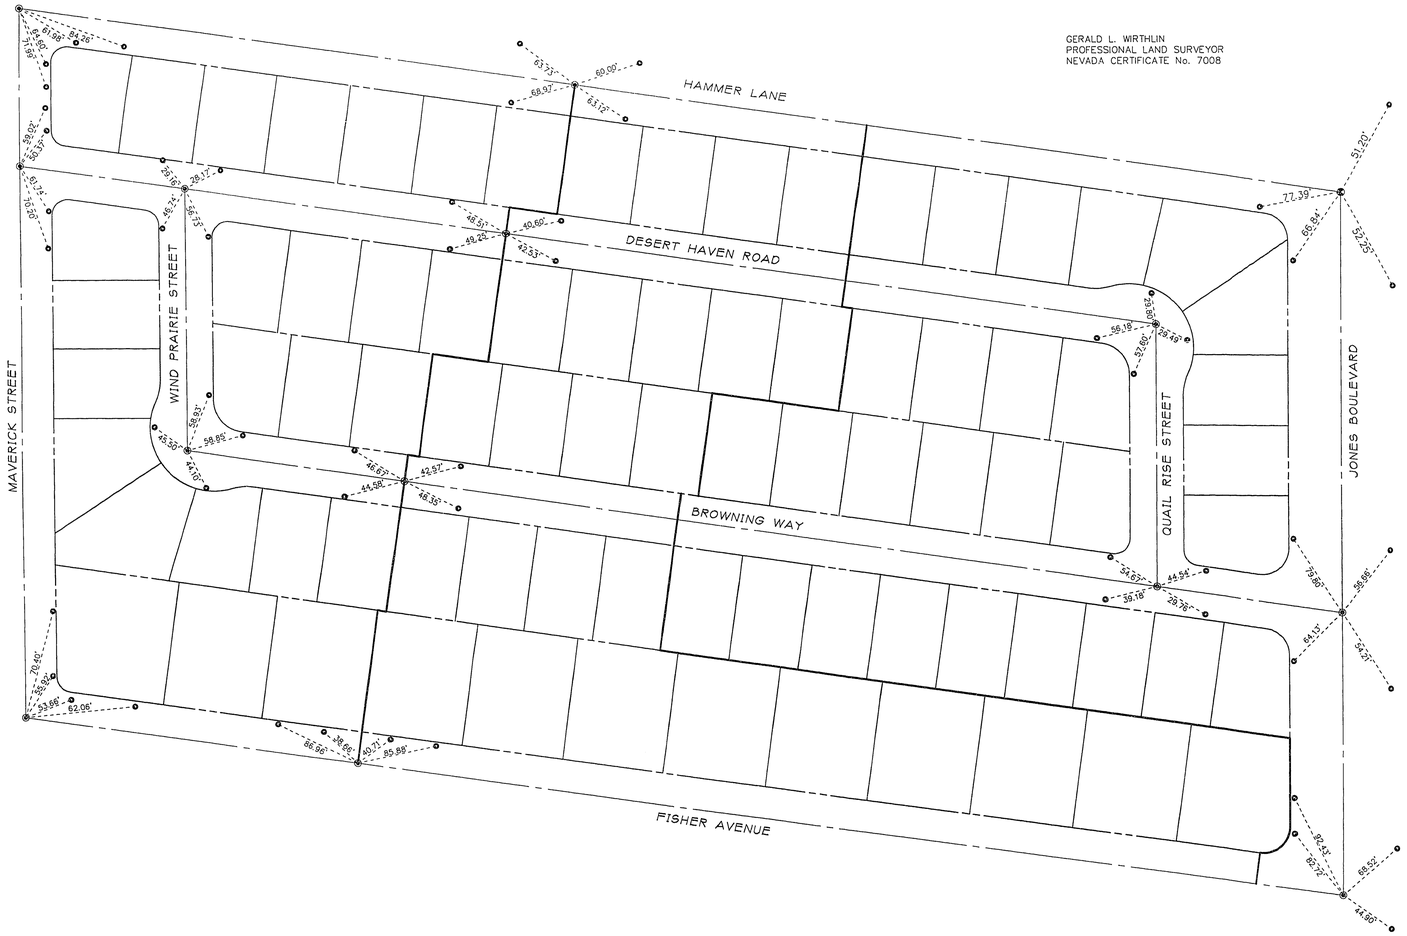

LEGEND

- SET ALUM. CAP STAMPED PLS 7008
- SET 3" BRASS CAP IN CONC. STAMPED PLS 7008
- SET 1 1/2" REFERENCE MON. IN T/C STAMPED PLS 7008 WITH TIE DISTANCE
- TIE DISTANCE LINE
- CENTERLINE
- BOUNDARY LINE
- UNIT BOUNDARY

MONUMENTATION / TIE MAP

NORTH HALF (N 1/2) OF THE SOUTH EAST QUARTER (S/E 1/4)
OF THE NORTH EAST QUARTER (N/E 1/4) OF SECTION 35
TOWNSHIP 19 SOUTH RANGE 60 EAST M.D.M.
CLARK COUNTY, NEVADA

DESERT ROSE SUBDIVISION (UNITS 1, 2, and 3)

SOUTHWEST SURVEYING, INC.
GERALD "CROCKETT" WIRTHLIN
PLS #7008

369-5064 OFFICE
379-5362 MOBILE

058-4273-1,2,3

11-6-43