

**DURANGO DRIVE
PUBLIC**

BASIS OF BEARINGS

SOUTH 88°55'31" WEST, BEING THE SOUTH LINE OF THE SOUTHWEST QUARTER (SW 1/4) OF SECTION 21, T. 19 S., R. 60 E., M.D.M., CLARK COUNTY, NEVADA, COINCIDENT WITH THE CENTERLINE OF CENTENNIAL PARKWAY, AS SHOWN ON THAT CERTAIN MAP ON FILE IN THE OFFICE OF THE COUNTY RECORDER IN FILE 81 OF PARCEL MAPS AT PAGE 28.




BENCHMARK

CLARK COUNTY BM # 0C90 - 21NWS
RIVET AND SQUARE ALUMINUM PLATE IN TOP OF CENTER OF HEAD WALL ON THE WEST SIDE OF HIGHWAY - 95, NEAR MILE MARKER 88.95
ELEVATION = 764.787 METERS (NAVD'88)
ELEVATION = 2509.14 U.S. SURVEY FEET (NAVD'88)


utility lines. It's costly.
Call before you Dig
1-800-227-2600

BACK OF CURB TABLE

CURVE	RADIUS	LENGTH	TANGENT	DELTA
1	30.00'	47.93'	30.82'	91°23'24"
2	30.00'	46.32'	29.20'	88°27'28"

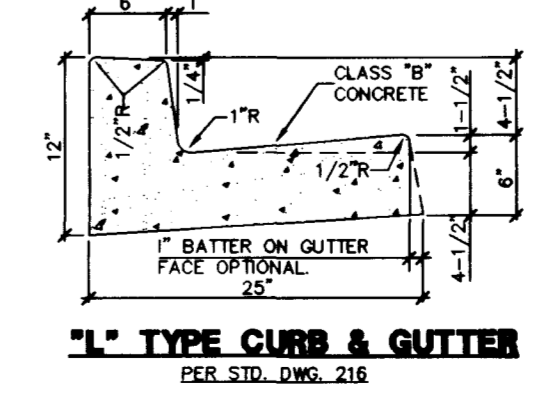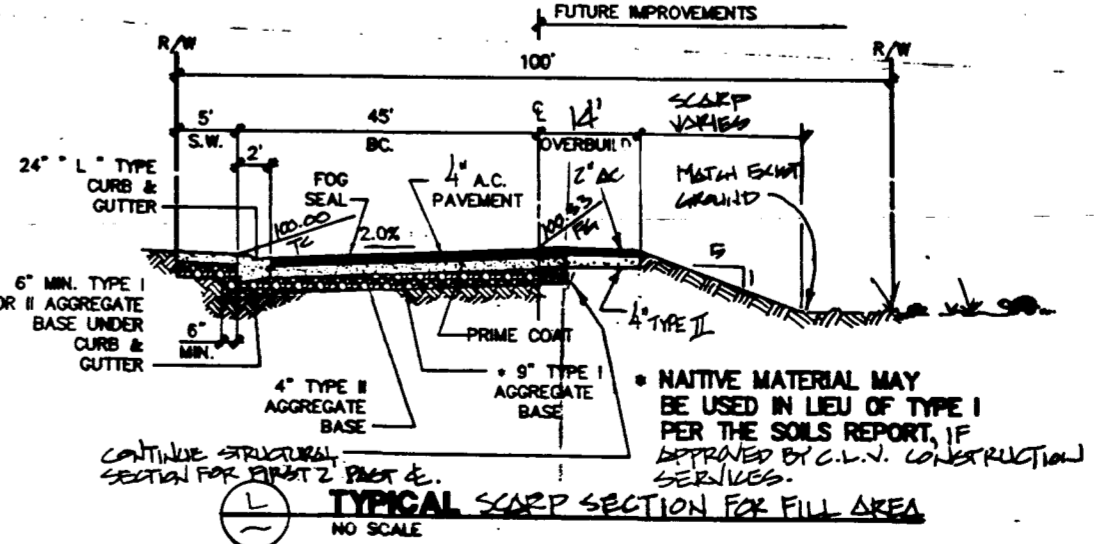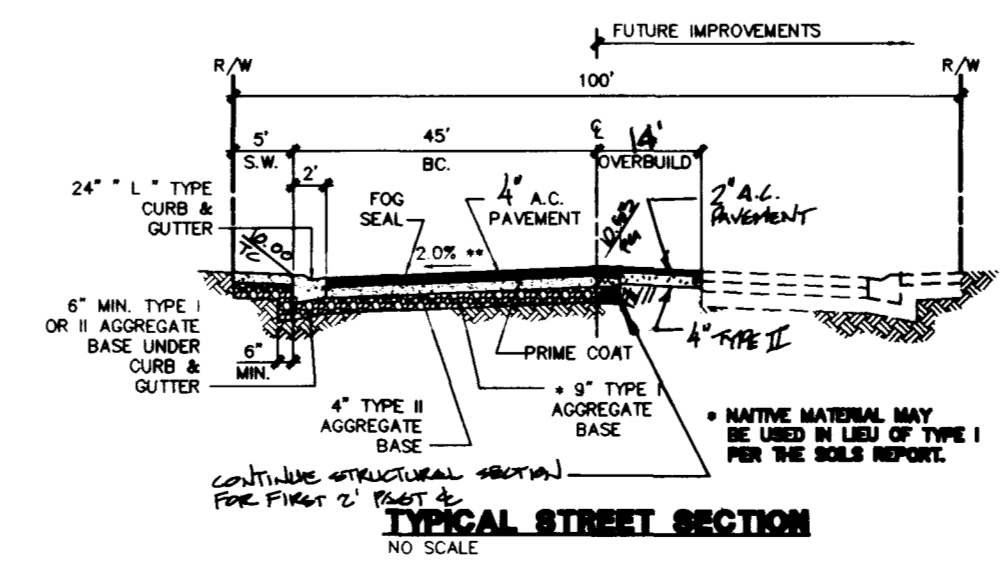


AMERICAN WEST HOMES, INC.
CITY OF LAS VEGAS, NEVADA

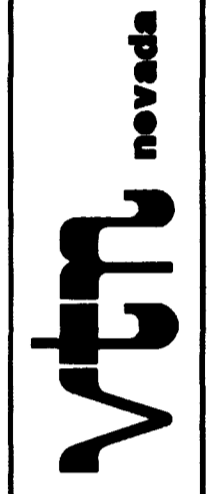

CONSULTING ENGINEERS • PLANNERS • LAND SURVEYORS
2727 SOUTH RAINBOW BOULEVARD
LAS VEGAS, NEVADA 89102-5148 PHONE (702) 873-7550 FAX (702) 362-2597

STREET PLAN - PROFILE
DURANGO DRIVE
DEER SPRINGS RANCH
UNIT - 2

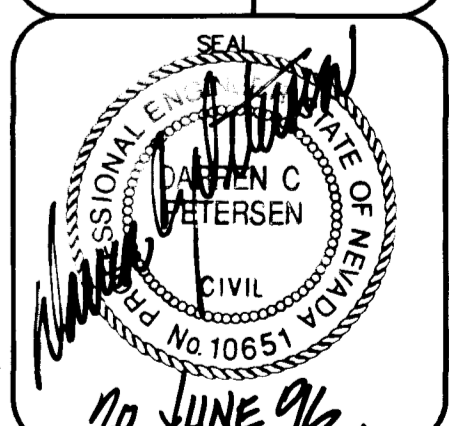

NO. 4884-2
BY CKH/RDM
DATE MAR, '96
SCALE: HORIZ. 1"=40'
VERT. 1"=4'
SHEET 9 OF 28 SHEETS




**DURANGO DRIVE
 PUBLIC**


Call
 before you
 Dig
 1-800-227-2800







STREET PLAN - PROFILE
 DURANGO DRIVE
 DEER SPRINGS RANCH


